

Map No. 1

T S R S
39 S 8 E 36



- Place of Use
- Klamath County Taxlot
- QQ Sections and Gov't Lots
- Map Series Sections
- Canal

Received
JUL 07 2025




1,320
Feet

OWRD

DISCLAIMER
This map is not intended to
provide legal dimensions or
locations of property
ownership lines


WATERSOLVING
johnw@watersolving.com

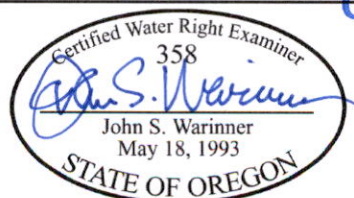

CLAIM OF BENEFICIAL USE MAP
APPLICATION G-16030
PERMIT G-18797
06/23/2025

Map No. 5

T S 39 R 9 S 28

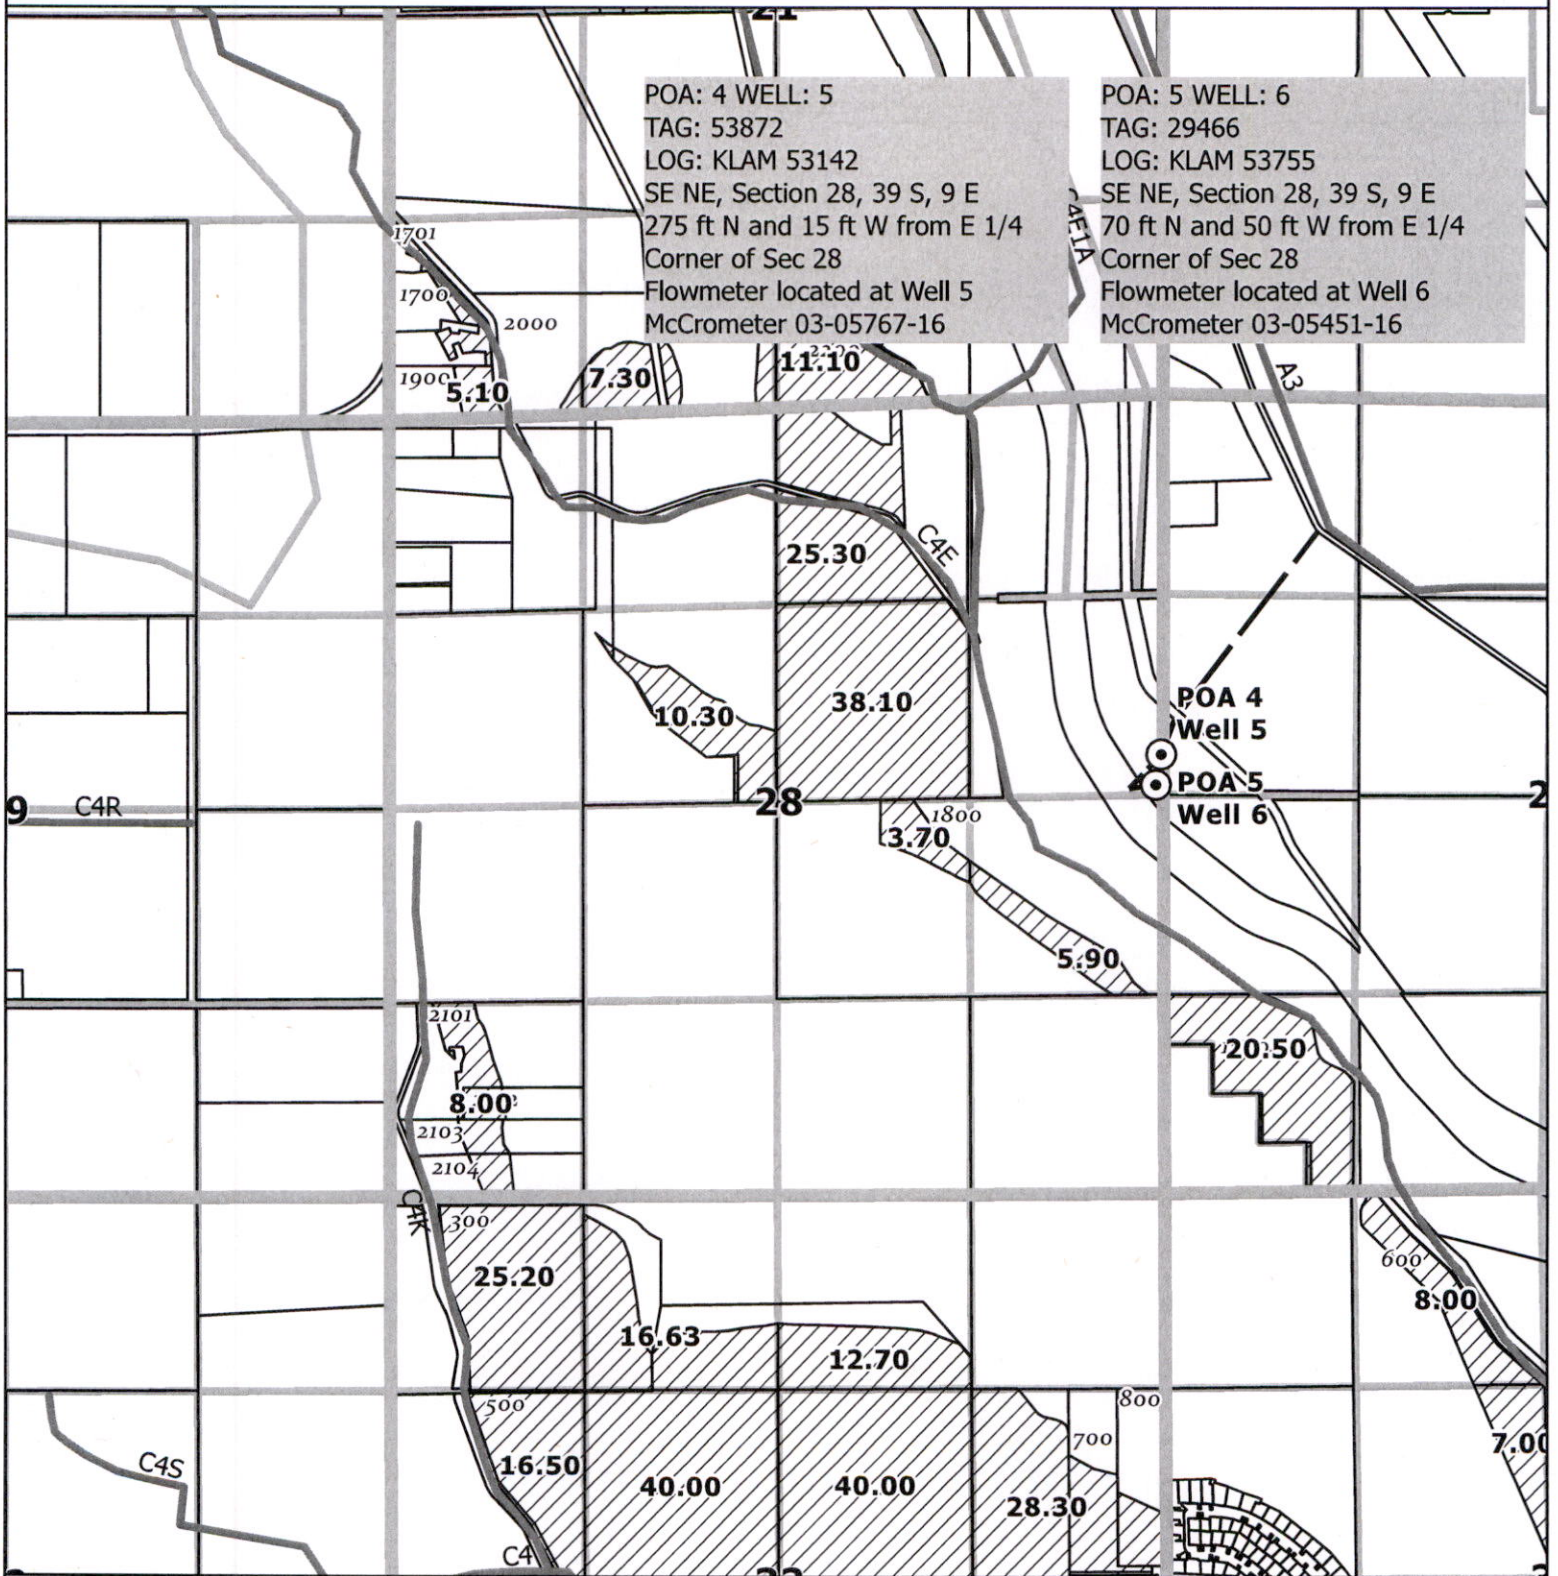


- Place of Use
- Klamath County Taxlot
- QQ Sections and Gov't Lots
- Map Series Sections
- Point of Appropriation
- Pipelines
- Canal

Received
JUL 07 2025

1,320
Feet

DISCLAIMER
This map is not intended to
provide legal dimensions or
locations of property
ownership lines

WATERSOLVING
johnw@watersolving.com

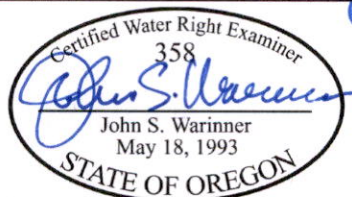


OWRD

CLAIM OF BENEFICIAL USE MAP
APPLICATION G-16030
PERMIT G-18797
06/23/2025


Map No. 6

T S R S
39 S 9 E 29

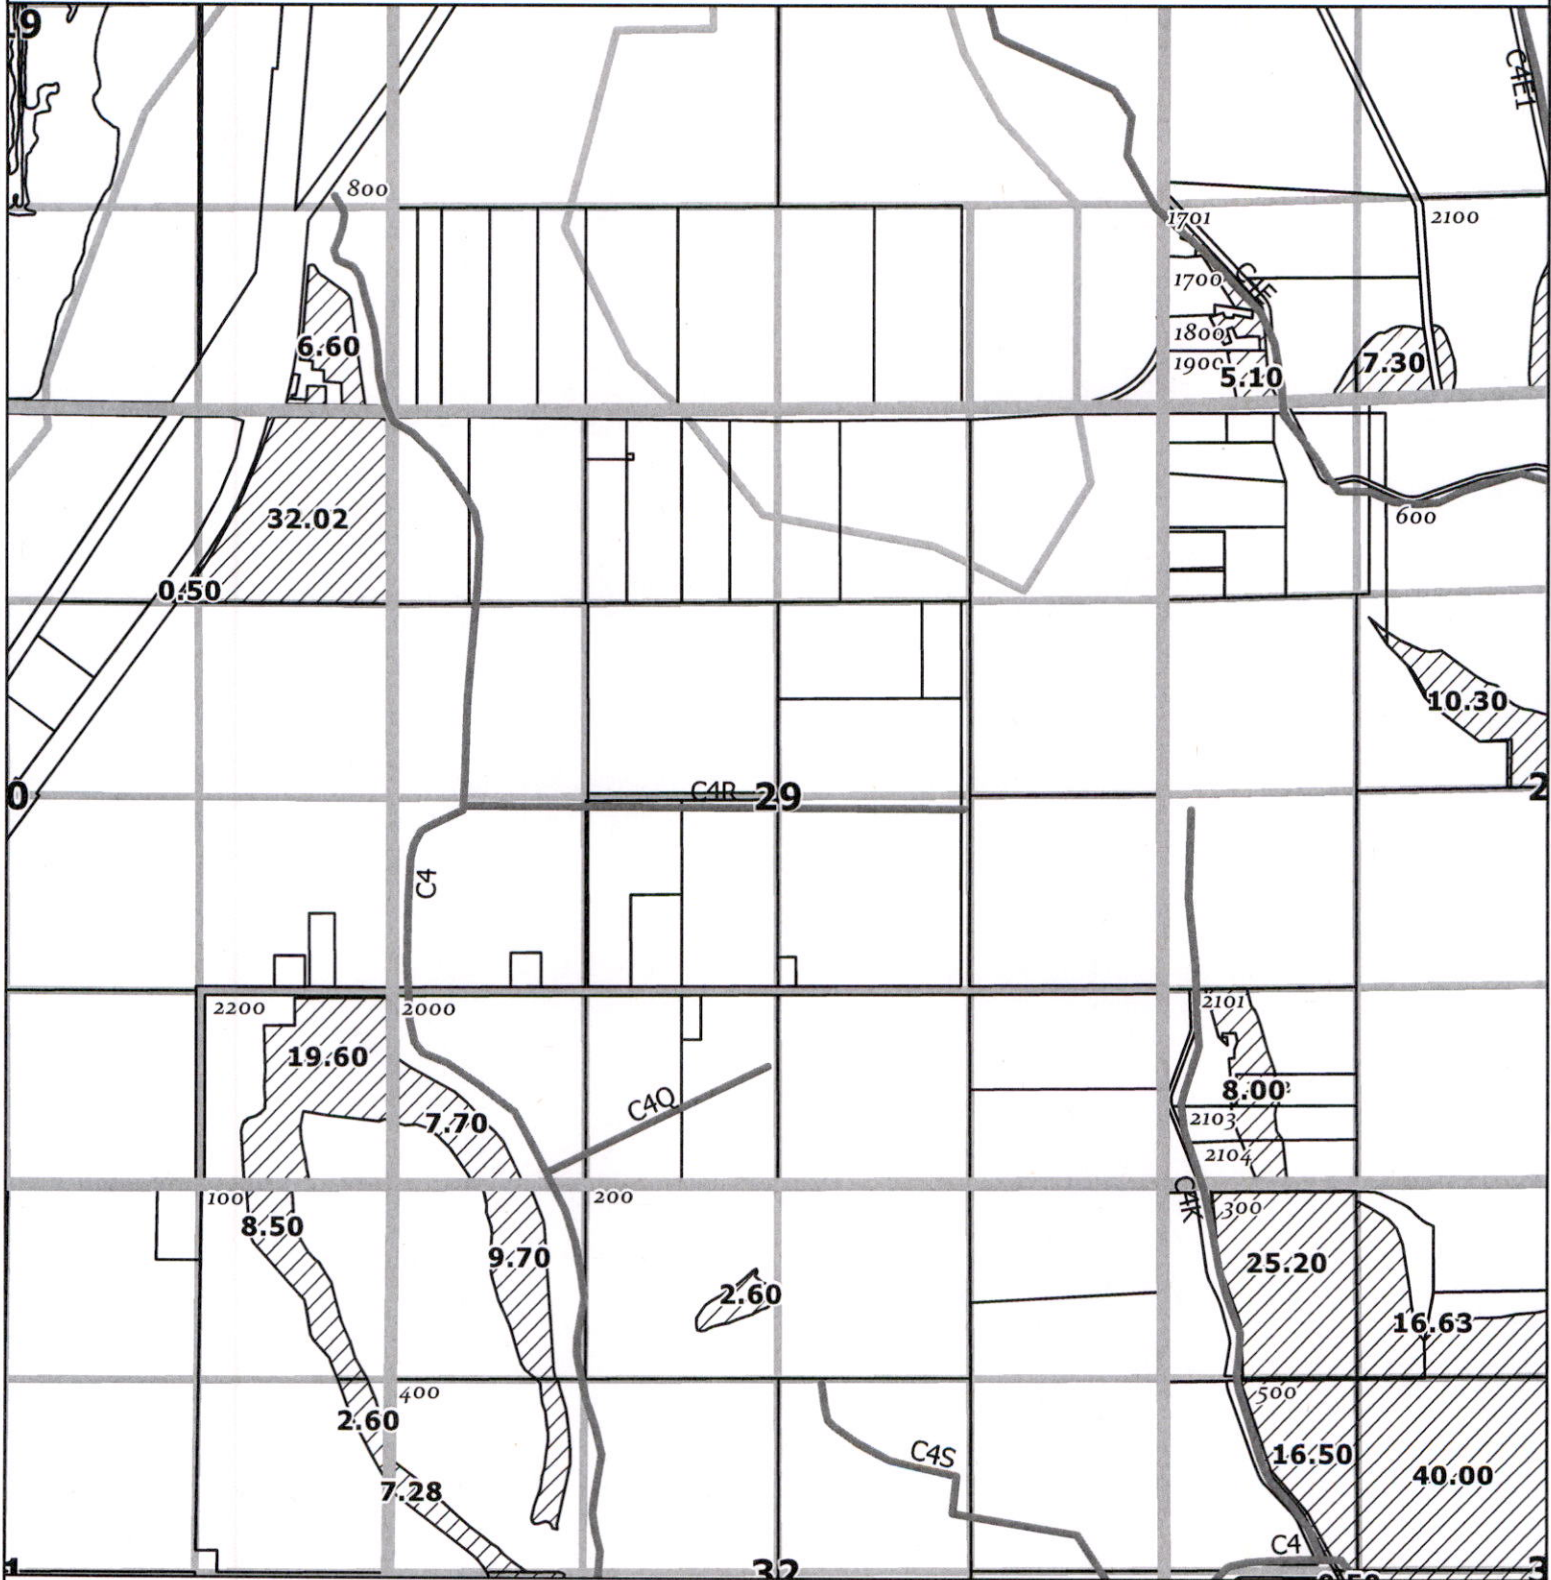


- Place of Use
- Klamath County Taxlot
- QQ Sections and Gov't Lots
- Map Series Sections
- Canal

Received
JUL 07 2025
OWRD

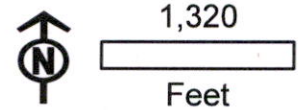

DISCLAIMER
This map is not intended to
provide legal dimensions or
locations of property
ownership lines


WATERSOLVING
johnw@watersolving.com

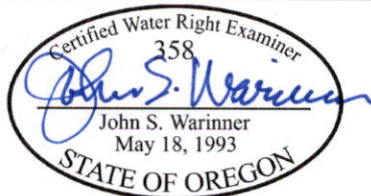

CLAIM OF BENEFICIAL USE MAP
APPLICATION G-16030
PERMIT G-18797
06/23/2025

Map No. 7

T S R S
39 S 9 E 30

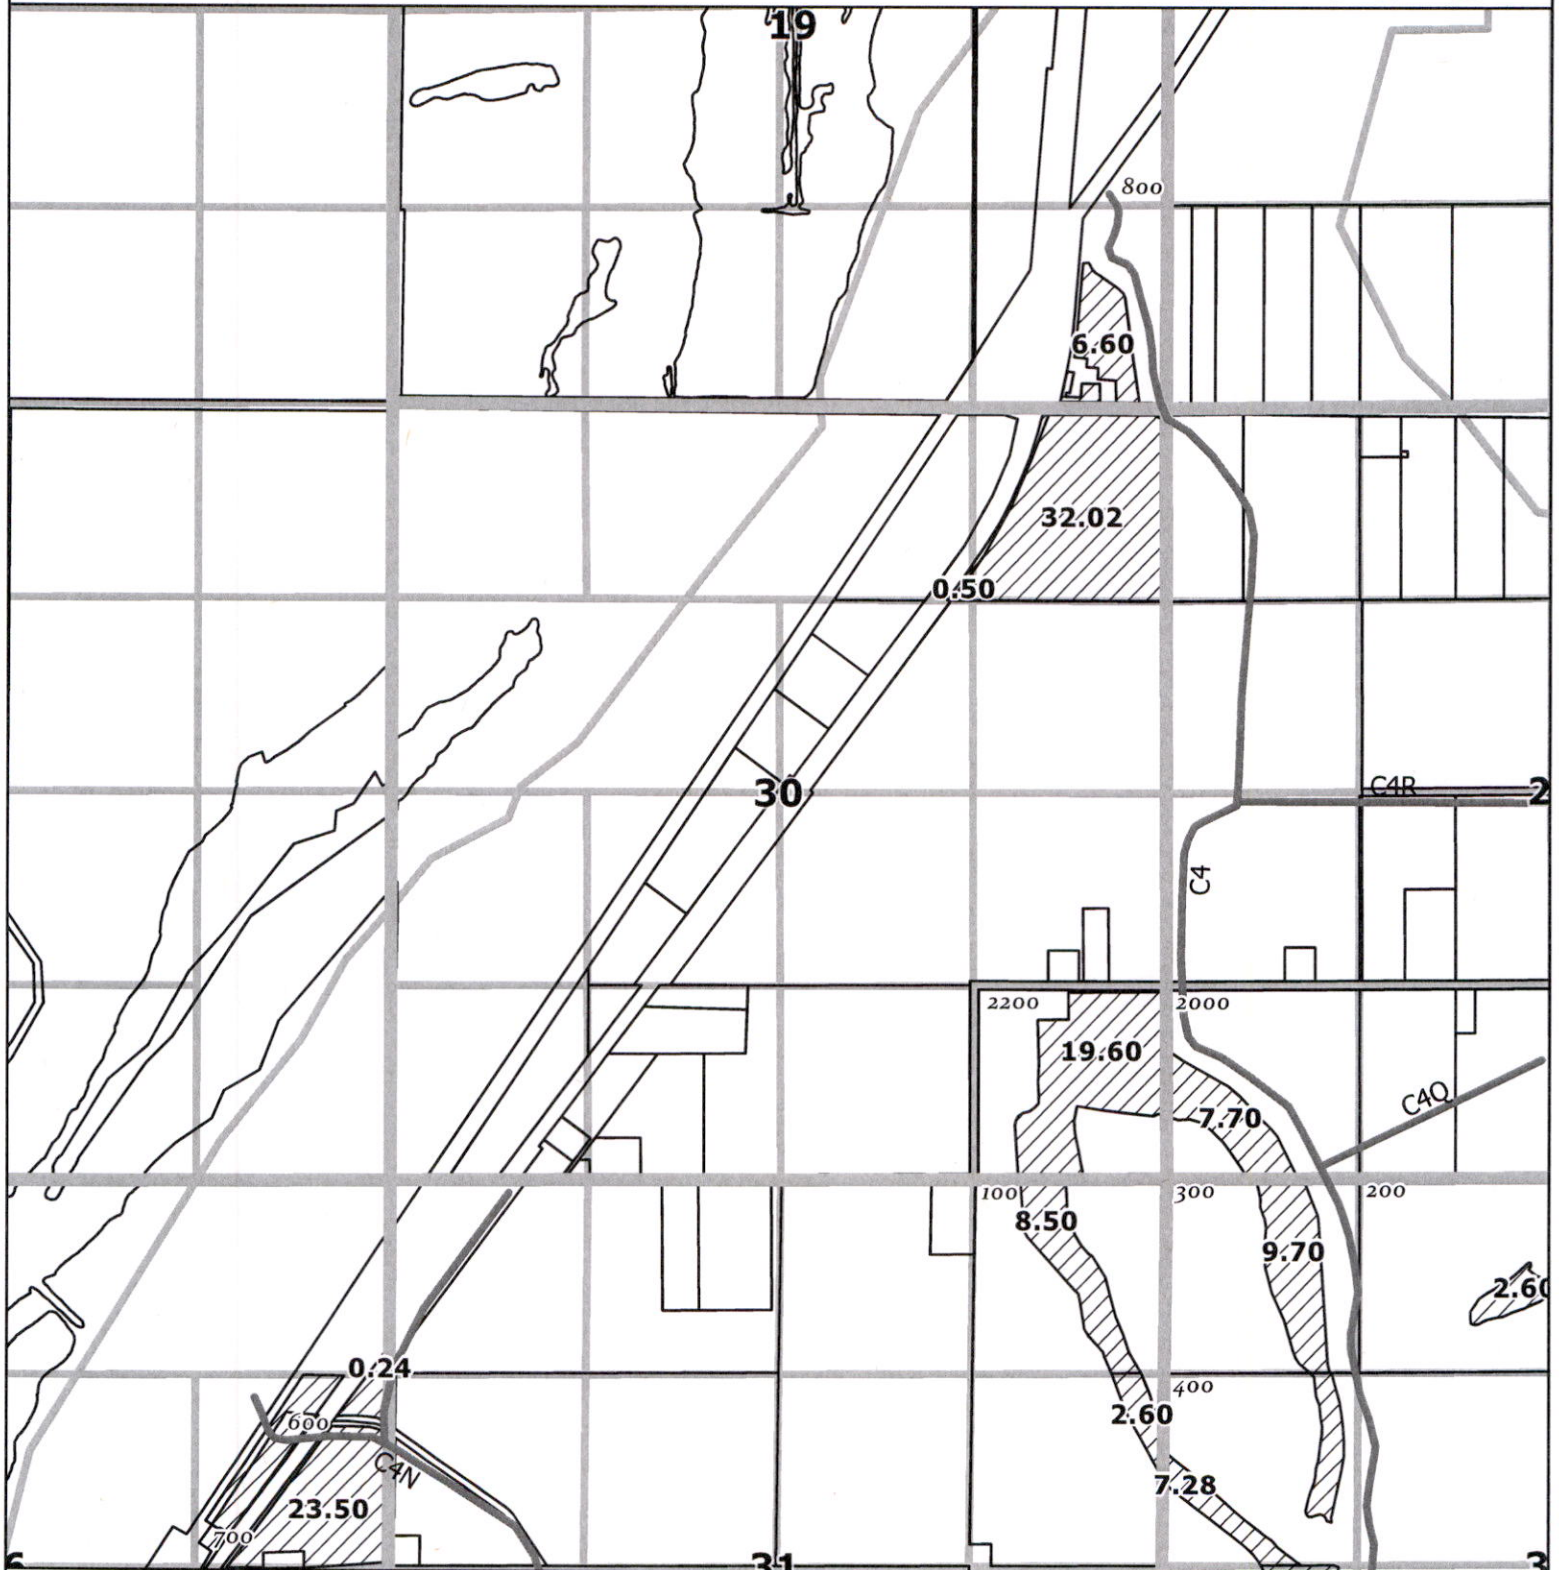

- Place of Use
- Klamath County Taxlot
- QQ Sections and Gov't Lots
- Map Series Sections
- Canal


Received
JUL 07 2025



1,320
Feet

DISCLAIMER
This map is not intended to
provide legal dimensions or
locations of property
ownership lines


WATERSOLVING
johnw@watersolving.com

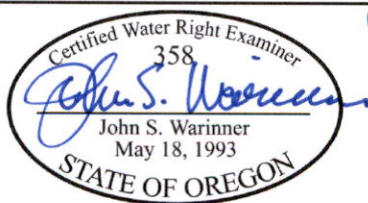

OWRD
CLAIM OF BENEFICIAL USE MAP
APPLICATION G-16030
PERMIT G-18797
06/23/2025


Map No. 9

T S 39 R 9 S 32

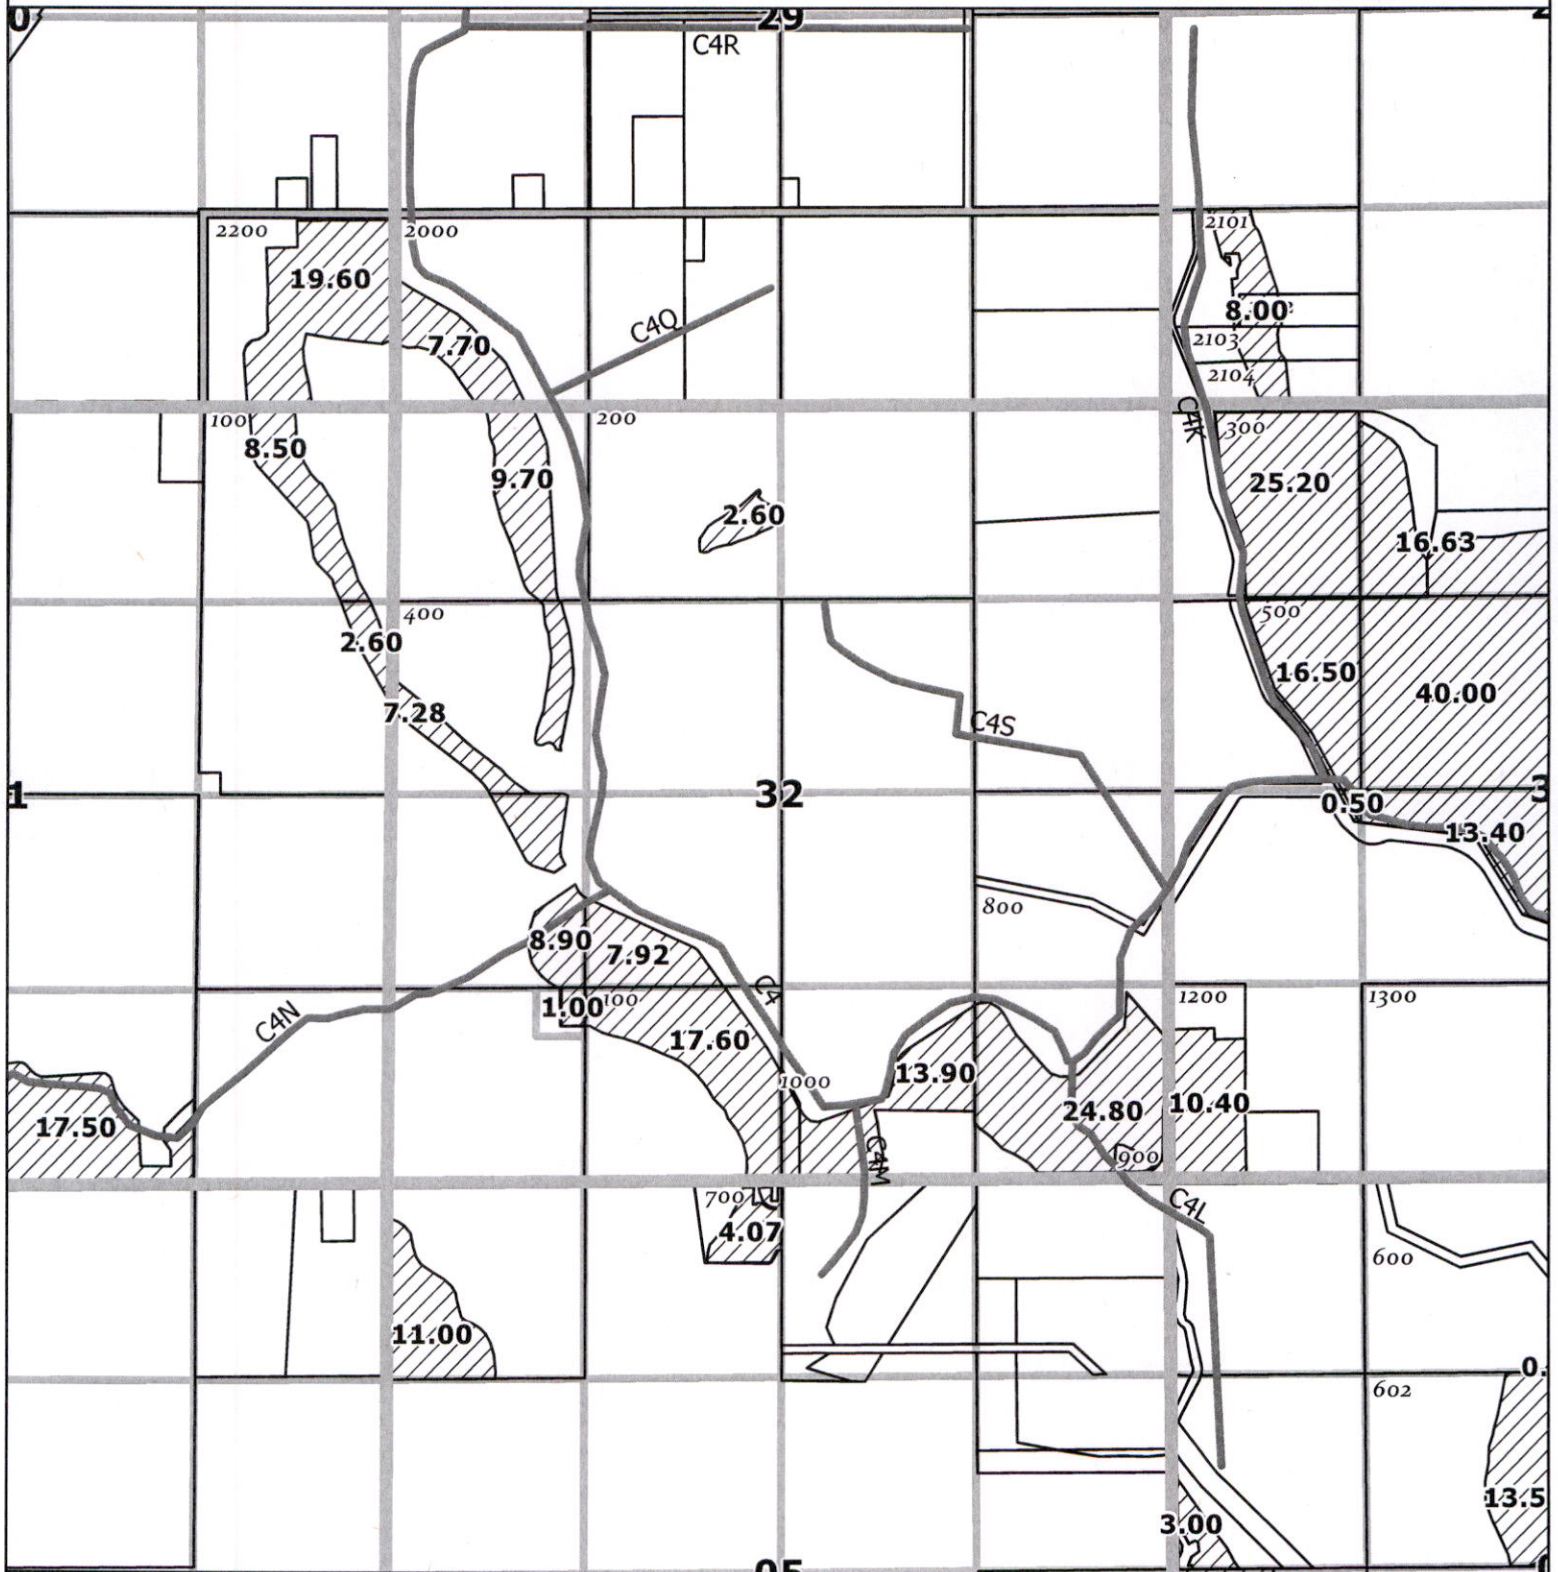


- Place of Use
- Klamath County Taxlot
- QQ Sections and Gov't Lots
- Map Series Sections
- Canal

Received
JUL 07 2025
OWRD

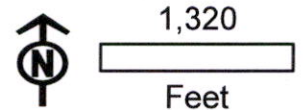


DISCLAIMER
This map is not intended to
provide legal dimensions or
locations of property
ownership lines

WATERSOLVING
johnw@watersolving.com

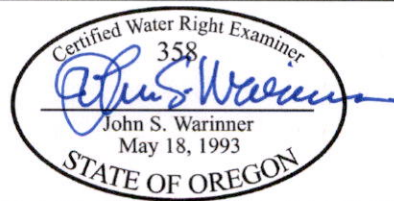

CLAIM OF BENEFICIAL USE MAP
APPLICATION G-16030
PERMIT G-18797
06/23/2025

T		R		S
39	S	9	E	33

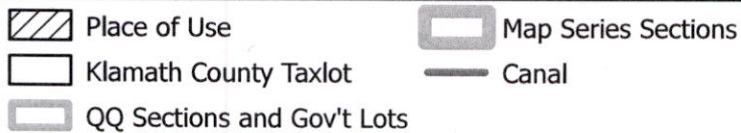


1,320
Feet


**CLAIM OF BENEFICIAL USE MAP
APPLICATION G-16030
PERMIT G-18797
06/23/2025**

DISCLAIMER
This map is not intended to
provide legal dimensions or
locations of property
ownership lines

WATERSOLVING
johnw@watersolving.com

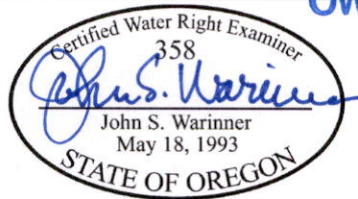


T		R		S
39	S	9	E	34

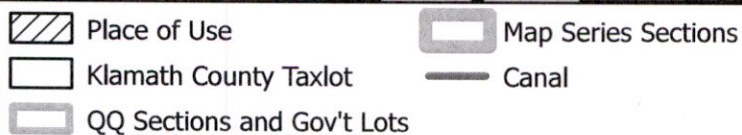


1,320
Feet

WATERSOLVING
johnw@watersolving.com

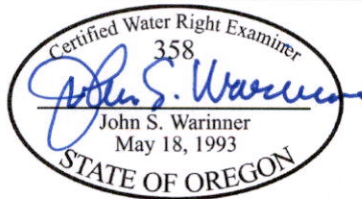

**CLAIM OF BENEFICIAL USE MAP
APPLICATION G-16030
PERMIT G-18797
06/23/2025**

T	R	S
39 S	9 E	35

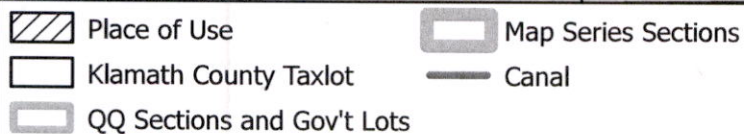

JUL 07 2025




Feet

~~OWRD~~

**CLAIM OF BENEFICIAL USE MAP
APPLICATION G-16030
PERMIT G-18797
06/23/2025**

DISCLAIMER
This map is not intended to
provide legal dimensions or
locations of property
ownership lines

WATERSOLVING
johnw@watersolving.com

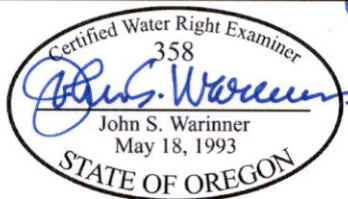


Map No. 13

T S 39 R 10 S 07 E




- Place of Use
- Klamath County Taxlot
- QQ Sections and Gov't Lots
- Map Series Sections
- Canal

Received
JUL 07 2025
OWRD

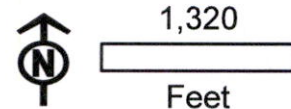

DISCLAIMER
This map is not intended to
provide legal dimensions or
locations of property
ownership lines

WATERSOLVING
johnw@watersolving.com

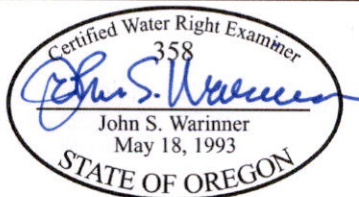


CLAIM OF BENEFICIAL USE MAP
APPLICATION G-16030
PERMIT G-18797
06/23/2025

Map No. 14

T S 39 R 10 S 08 E

POA: 3 WELL: 3
TAG: 29466
LOG: KLAM 53755
NW SW, Section 08, 39 S, 10 E
45 ft S and 45 ft W from E 1/4
Corner of Sec 17
Flowmeter located at Well 3
McCrometer 03-04187A-14

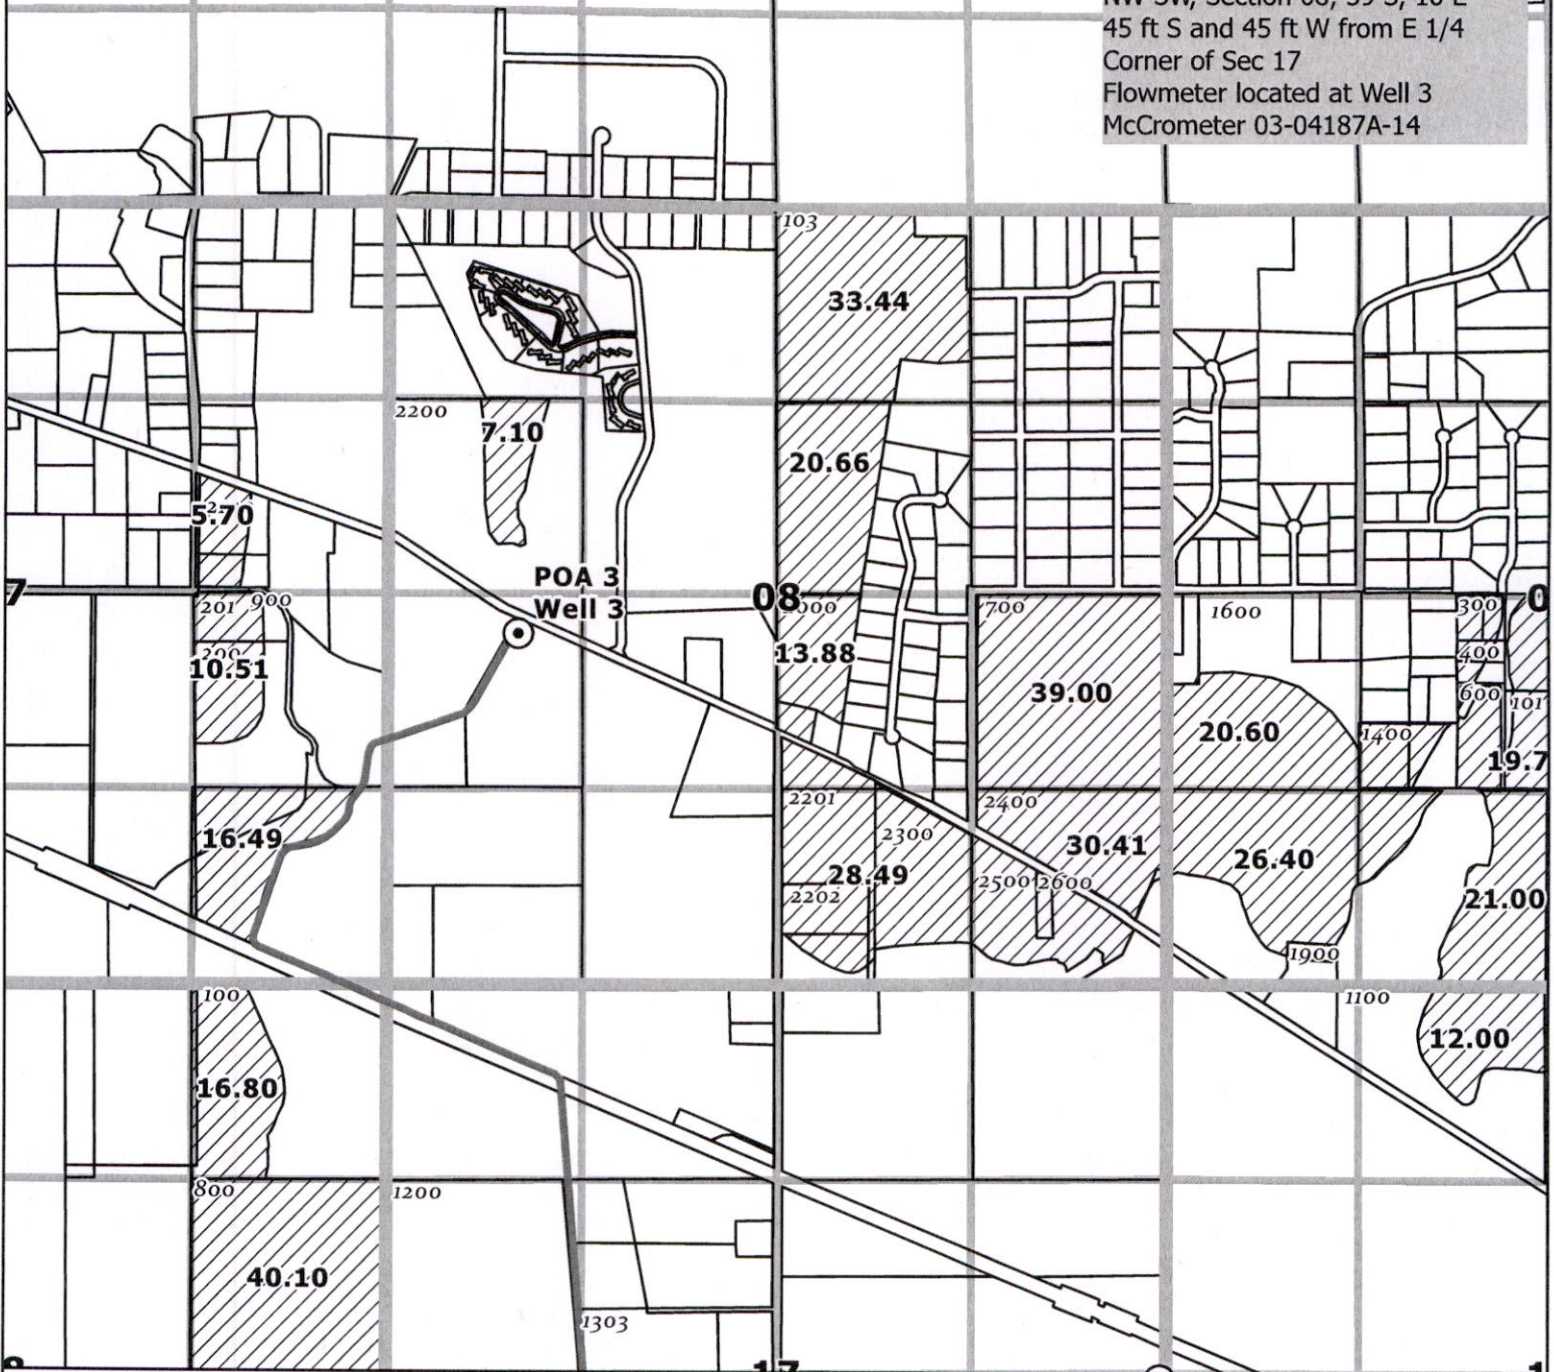

- Place of Use
- Klamath County Taxlot
- QQ Sections and Gov't Lots
- Map Series Sections
- Point of Appropriation
- Pipelines
- Canal


Received
JUL 07 2025

1,320
Feet

OWRD

DISCLAIMER
This map is not intended to
provide legal dimensions or
locations of property
ownership lines


WATERSOLVING
johnw@watersolving.com

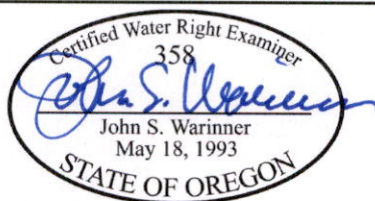

CLAIM OF BENEFICIAL USE MAP
APPLICATION G-16030
PERMIT G-18797
06/23/2025

Map No. 15

T S 39 R 10 S 09 E 09

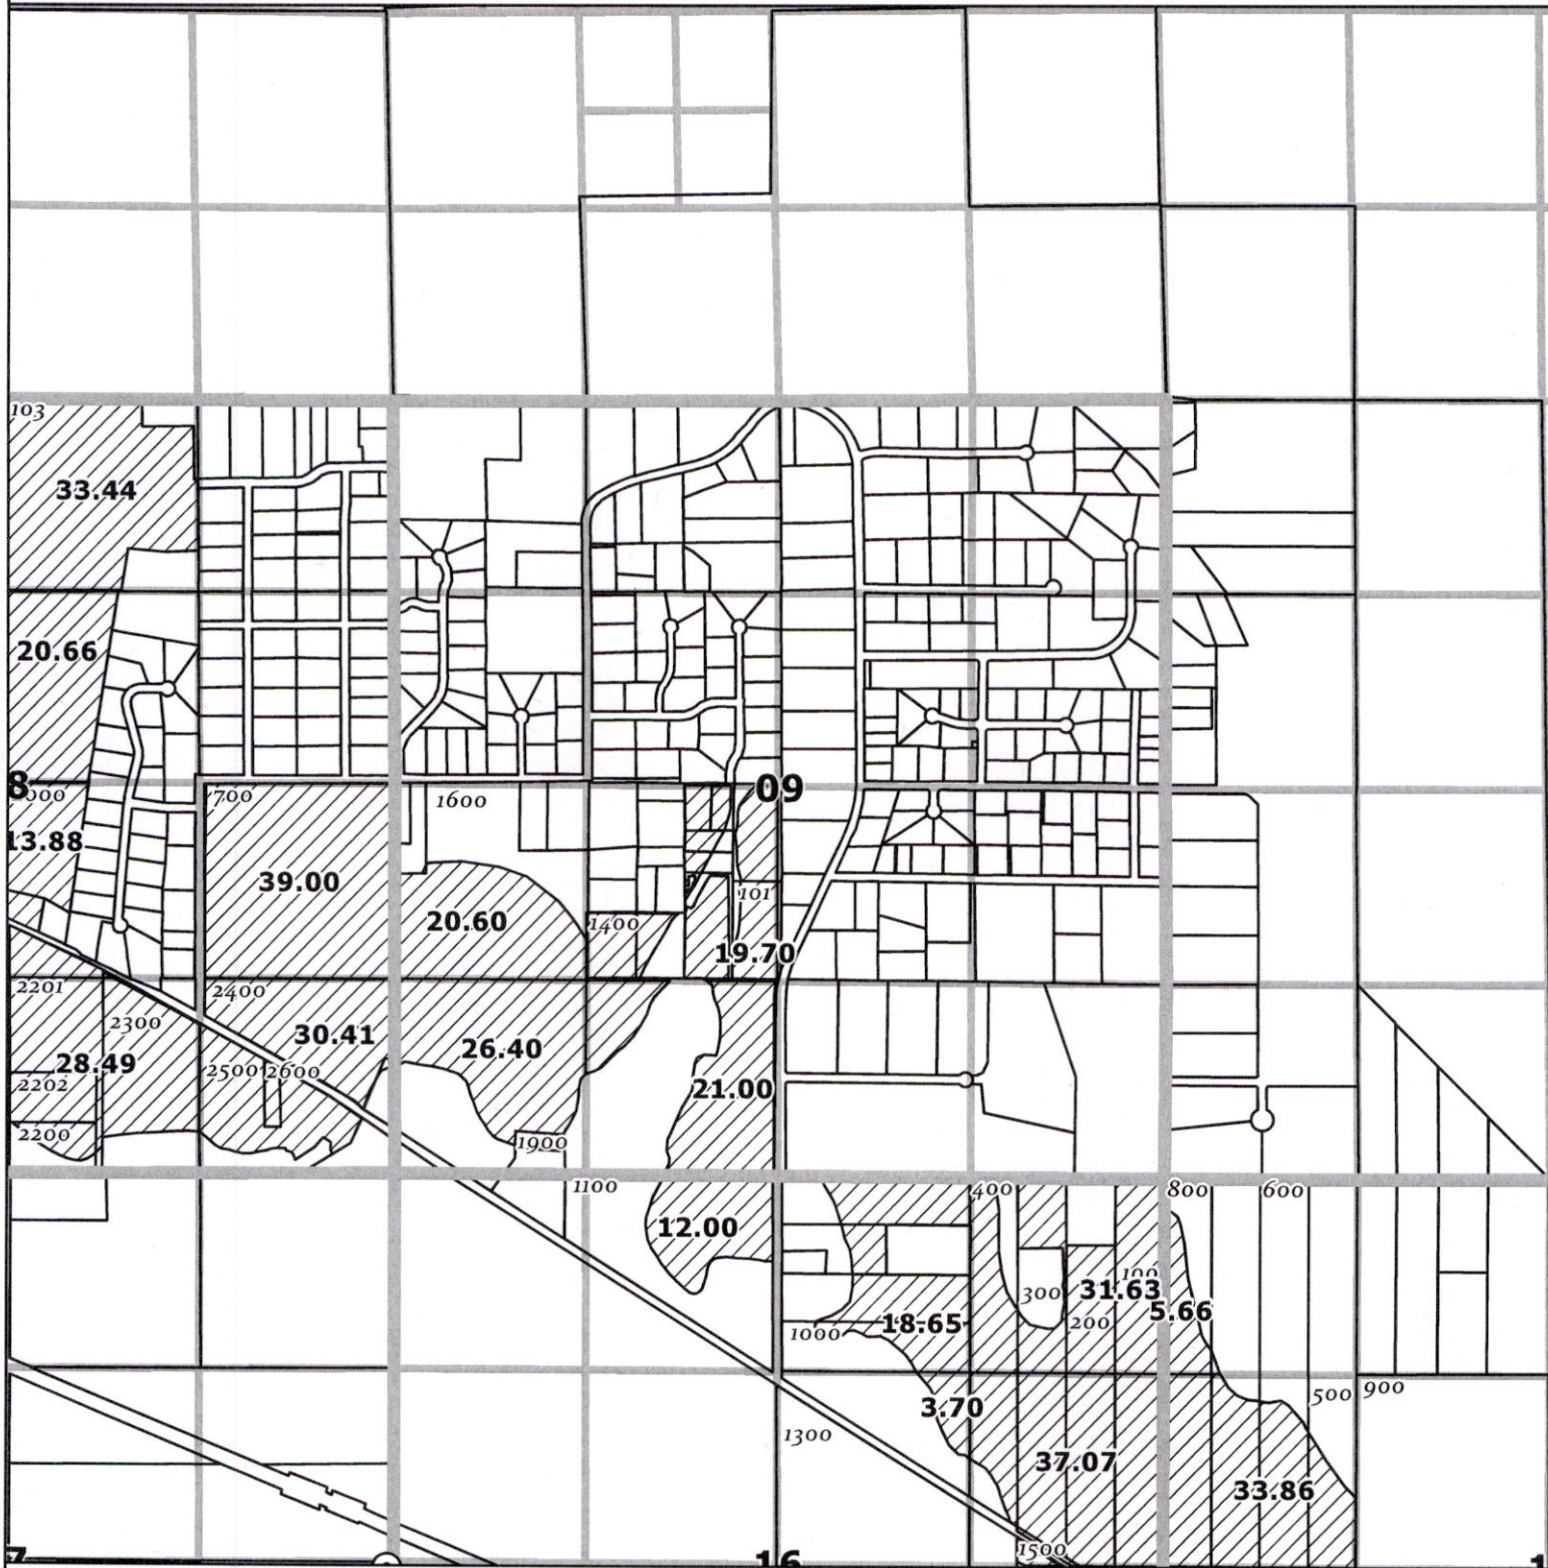

- Place of Use
- Klamath County Taxlot
- QQ Sections and Gov't Lots
- Map Series Sections
- Canal


Received
JUL 07 2025



1,320
Feet

DISCLAIMER
This map is not intended to
provide legal dimensions or
locations of property
ownership lines

WATERSOLVING
johnw@watersolving.com

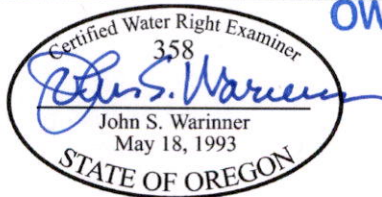


OWRD

CLAIM OF BENEFICIAL USE MAP
APPLICATION G-16030
PERMIT G-18797
06/23/2025

Map No. 16

T 39 S 10 E S 12

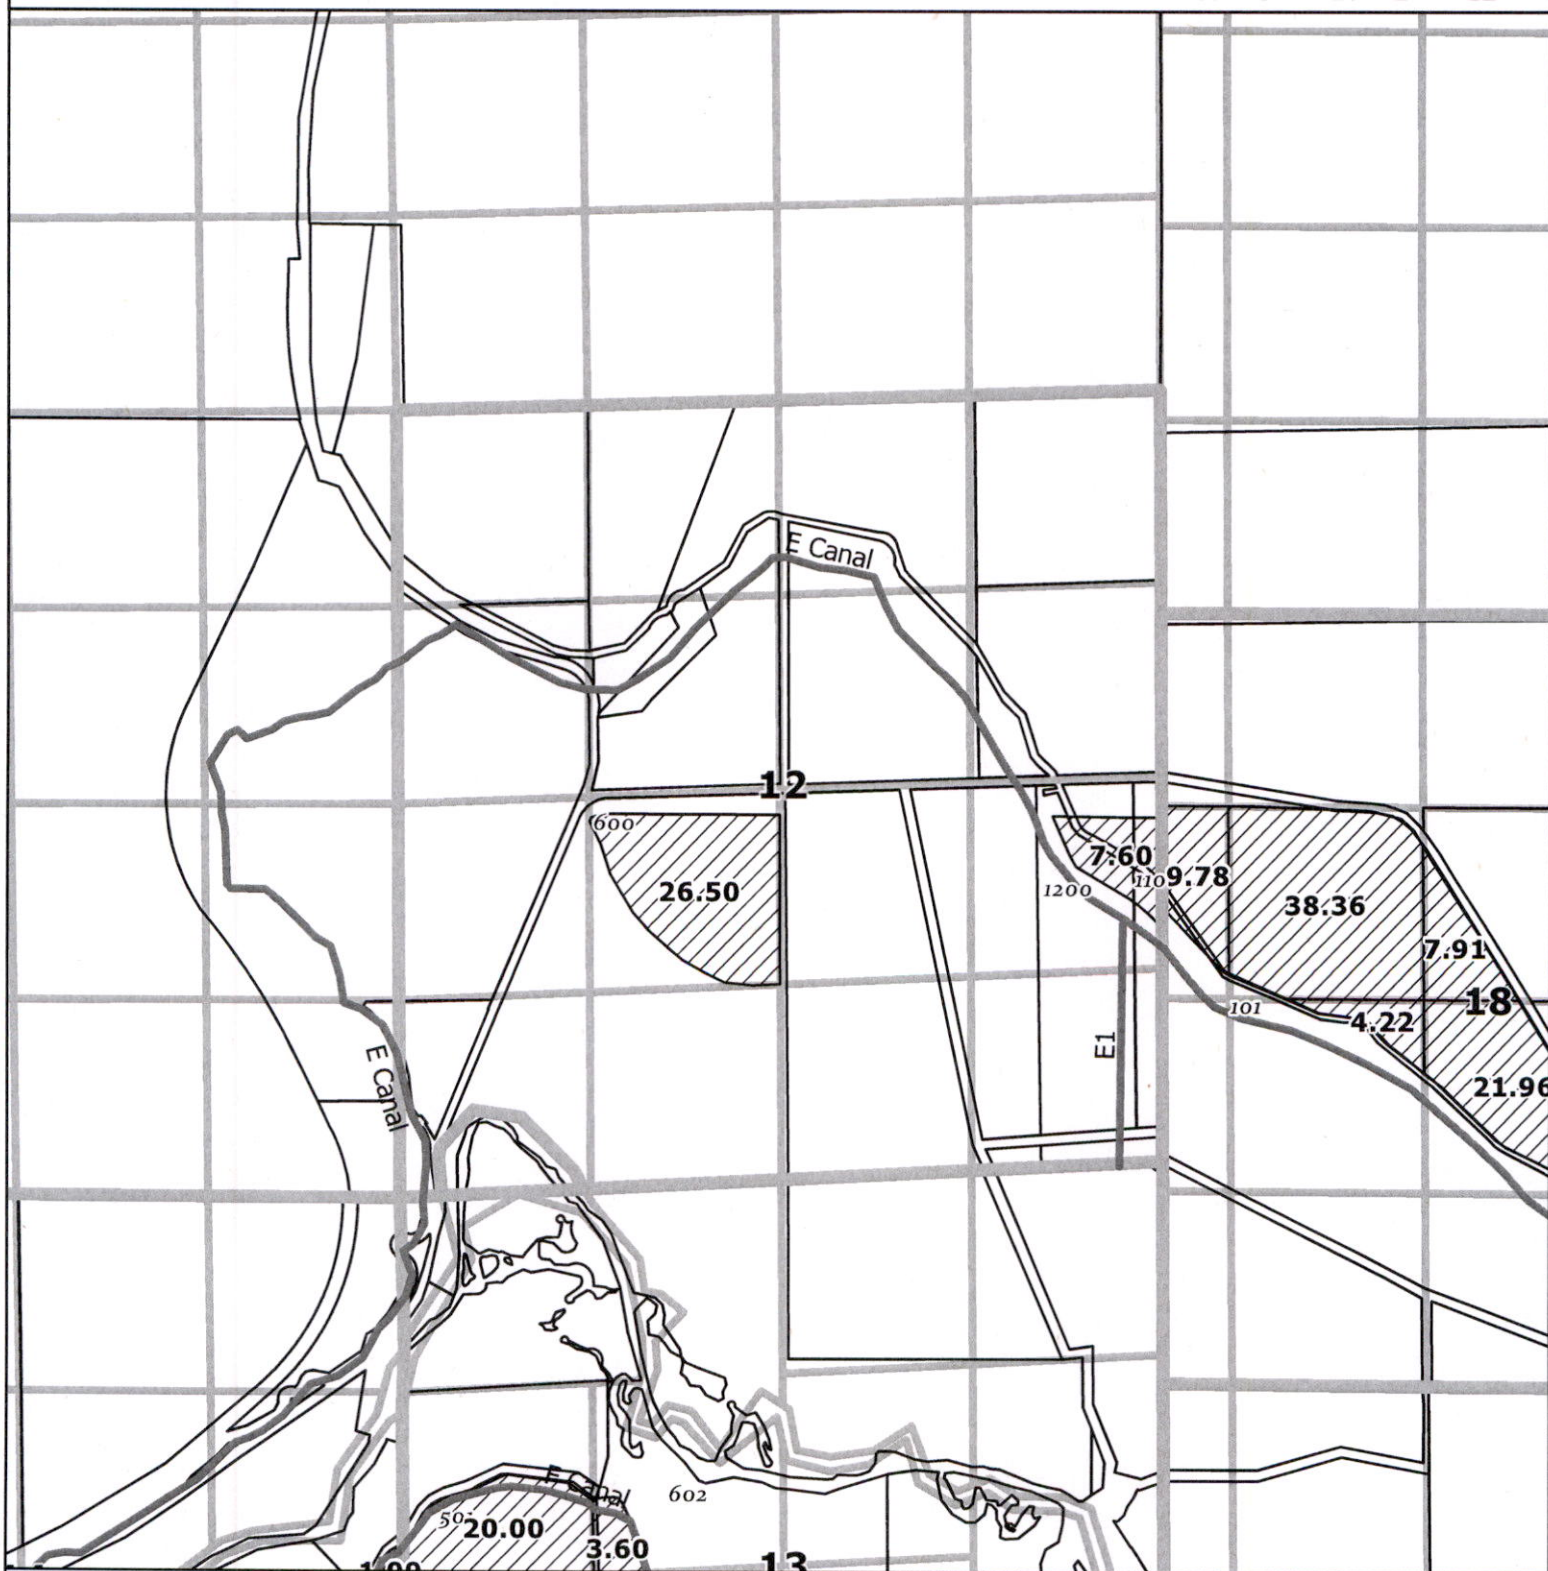

- Place of Use
- Klamath County Taxlot
- QQ Sections and Gov't Lots
- Map Series Sections
- Canal

Received
JUL 07 2025




1,320
Feet

OWRD

DISCLAIMER
This map is not intended to
provide legal dimensions or
locations of property
ownership lines


WATERSOLVING
johnw@watersolving.com

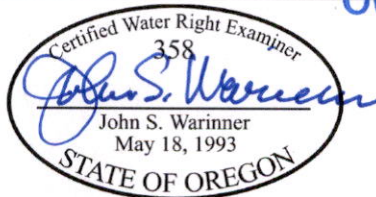

CLAIM OF BENEFICIAL USE MAP
APPLICATION G-16030
PERMIT G-18797
06/23/2025


Map No. 17

T R S
39 S 10 E 13

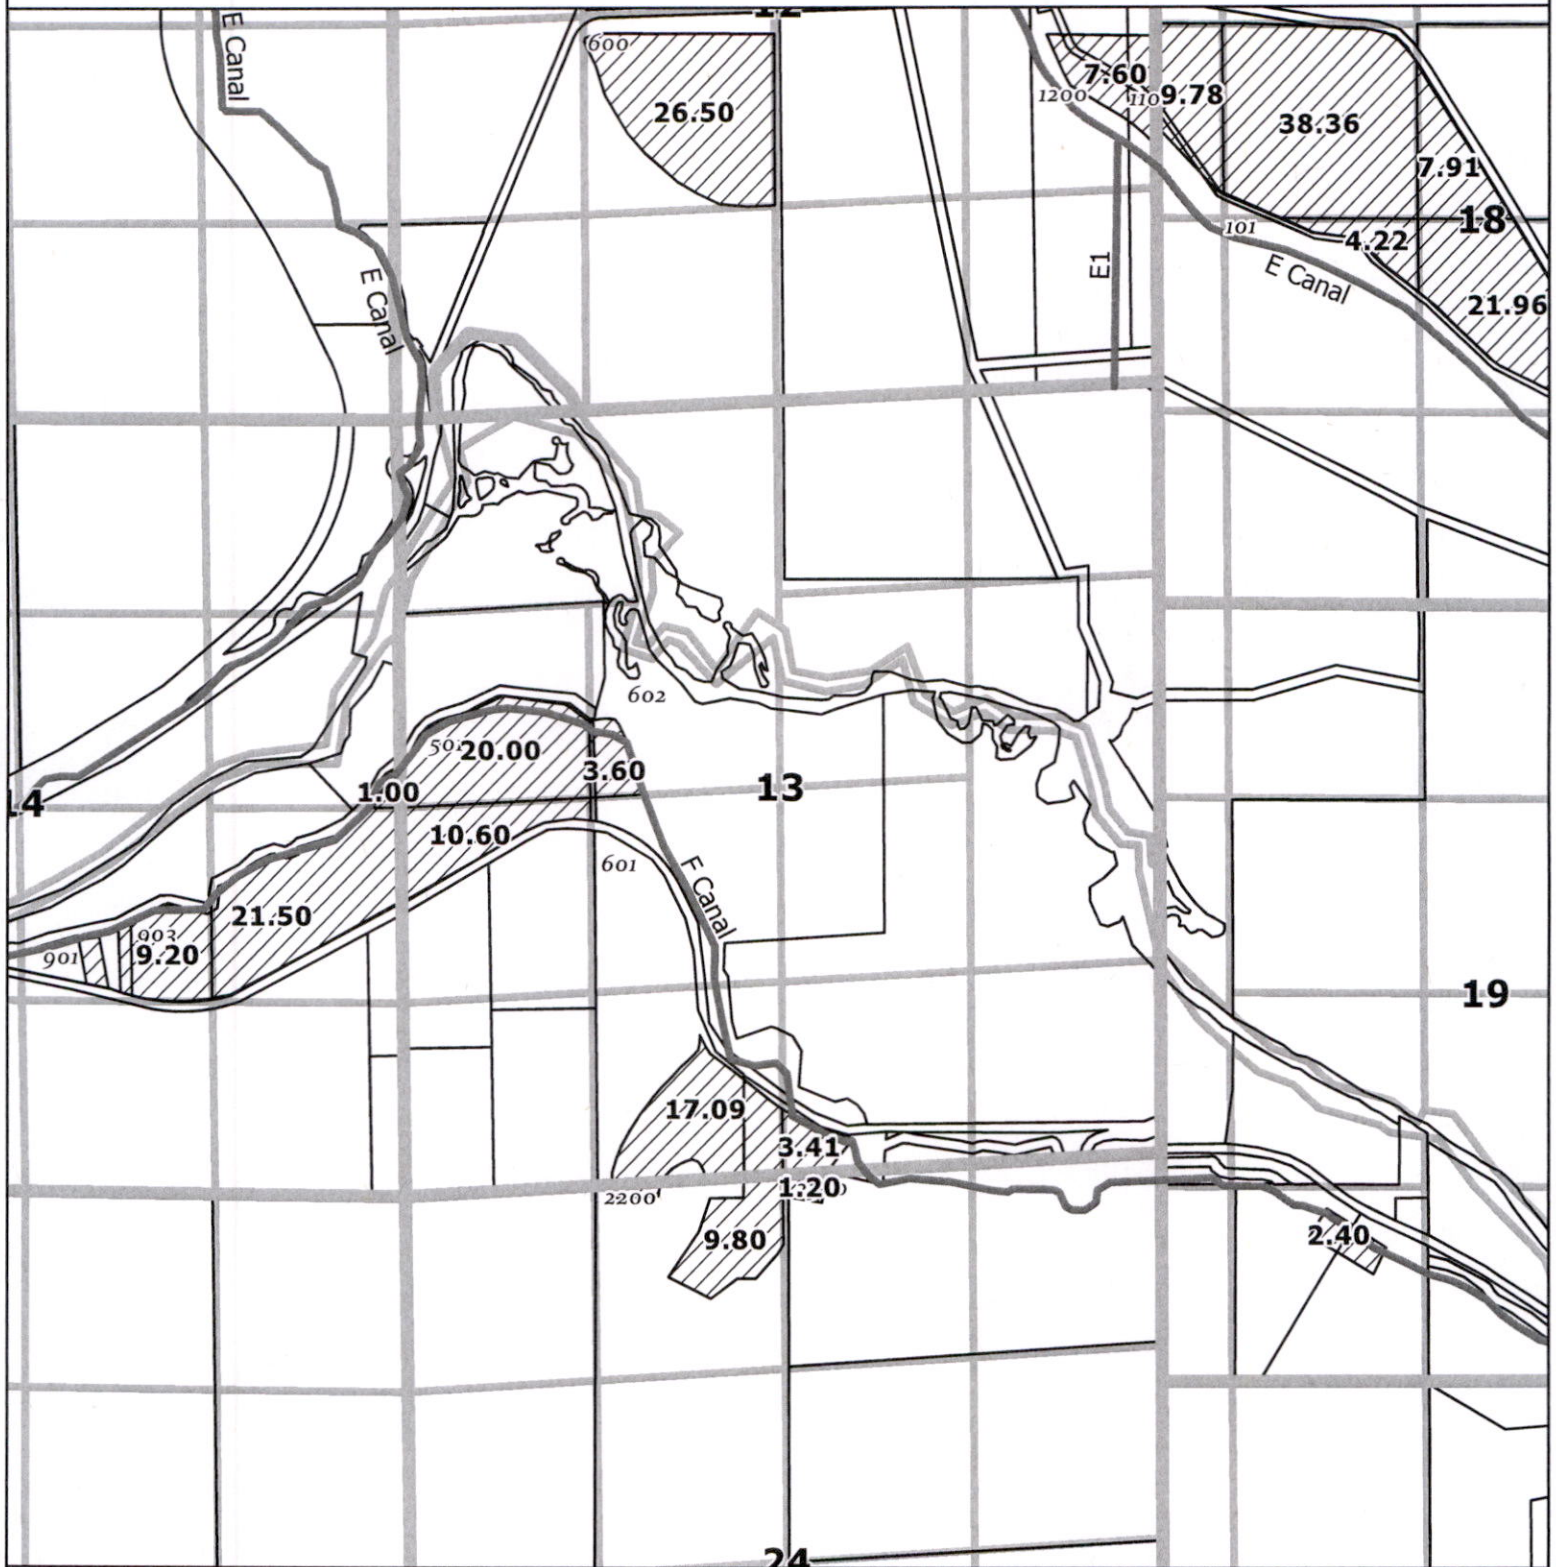

- Place of Use
- Klamath County Taxlot
- QQ Sections and Gov't Lots
- Map Series Sections
- Canal


Received
JUL 07 2025

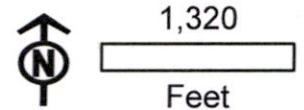

OWRD

DISCLAIMER
This map is not intended to
provide legal dimensions or
locations of property
ownership lines


WATERSOLVING
johnw@watersolving.com

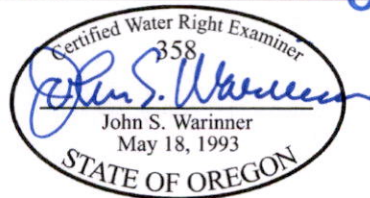

CLAIM OF BENEFICIAL USE MAP
APPLICATION G-16030
PERMIT G-18797
06/23/2025


Map No. 18

T 39 S 10 E S 14

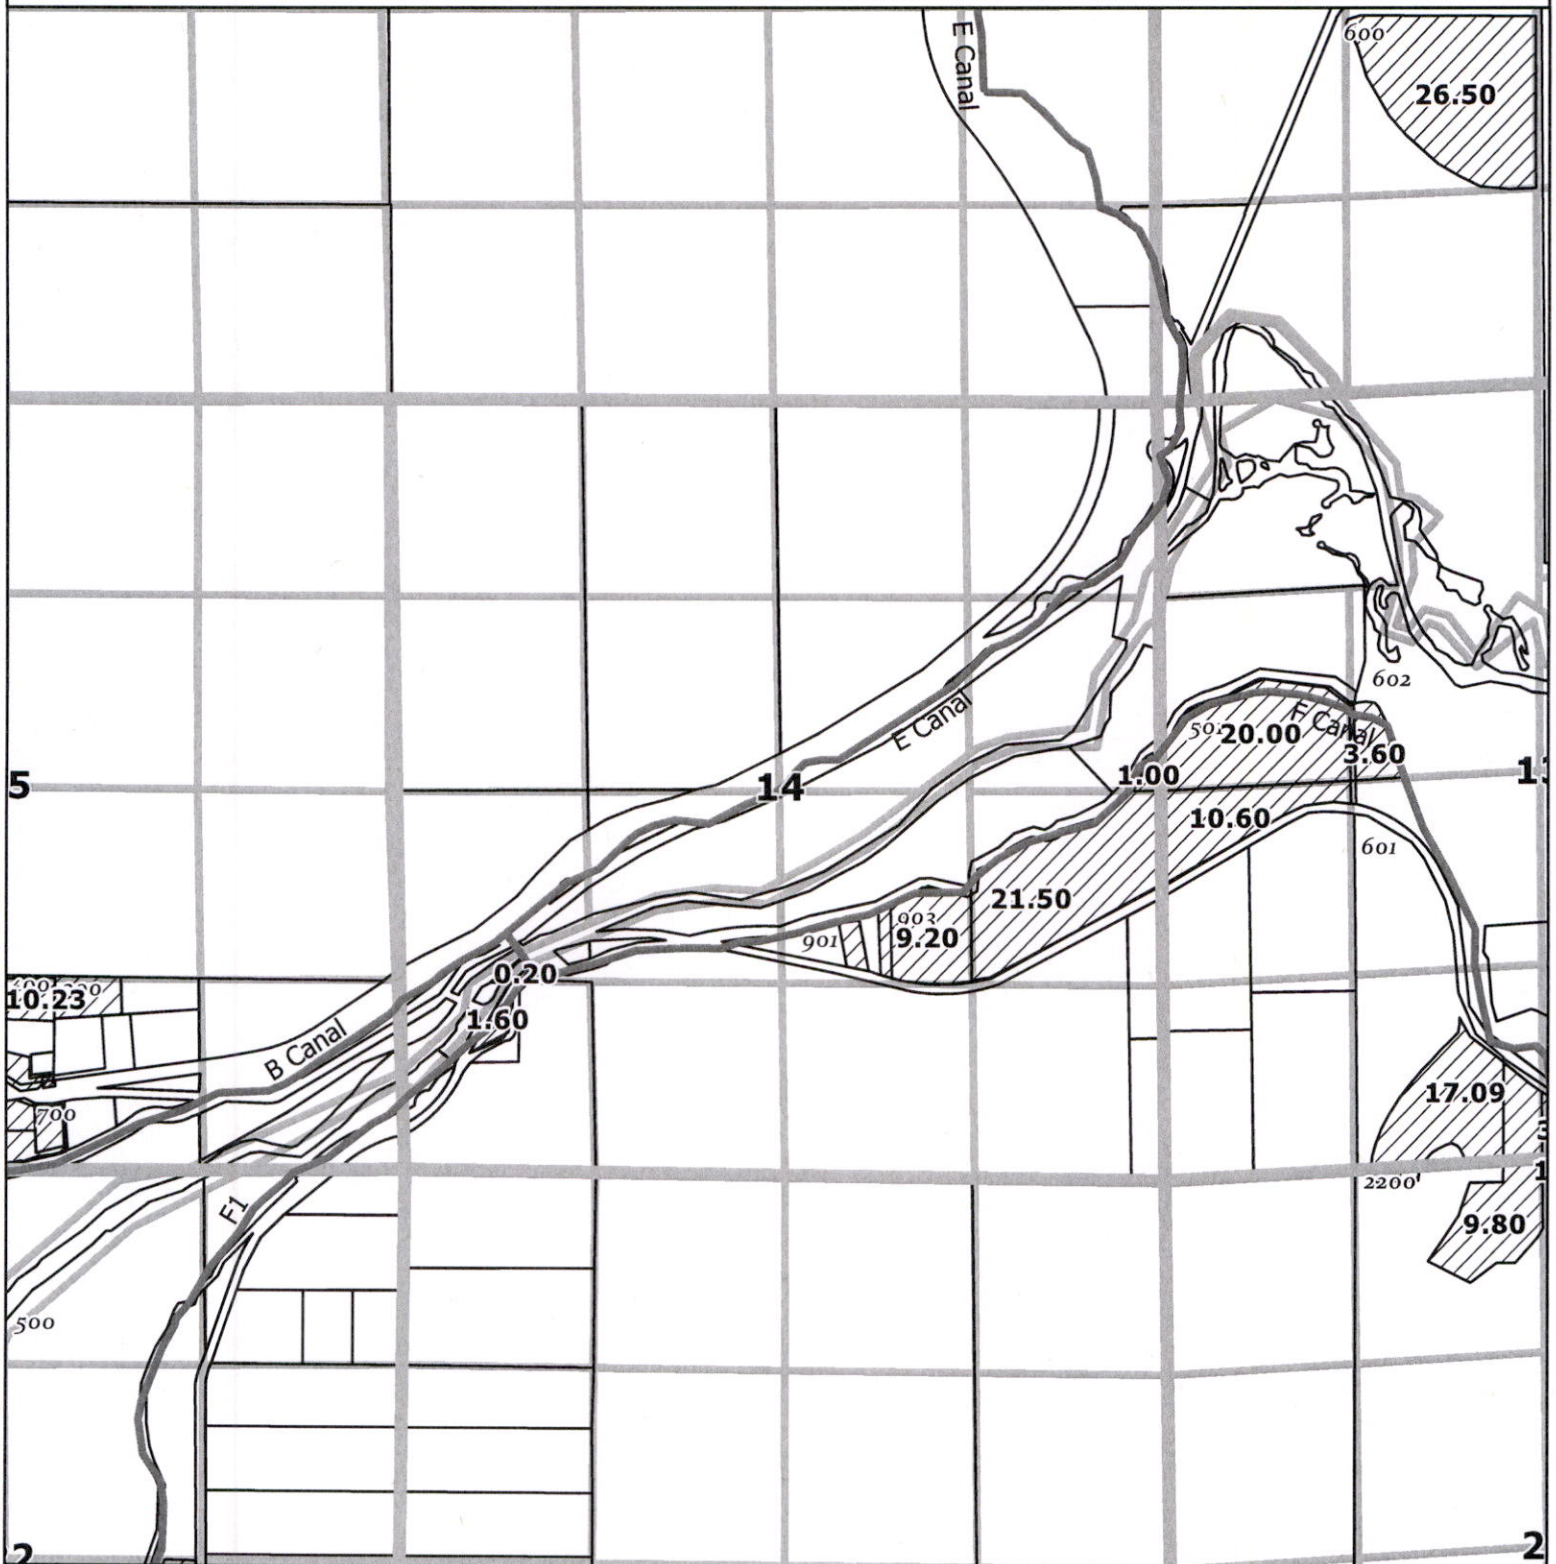

- Place of Use
- Klamath County Taxlot
- QQ Sections and Gov't Lots
- Map Series Sections
- Canal


Received
JUL 07 2025

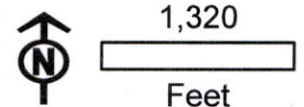

OWRD

DISCLAIMER
This map is not intended to
provide legal dimensions or
locations of property
ownership lines


WATERSOLVING
johnw@watersolving.com

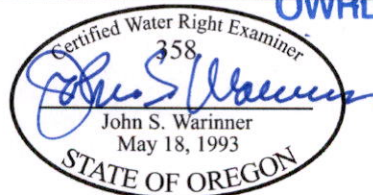

CLAIM OF BENEFICIAL USE MAP
APPLICATION G-16030
PERMIT G-18797
06/23/2025

Map No. 19

T 39 S 10 E S 15

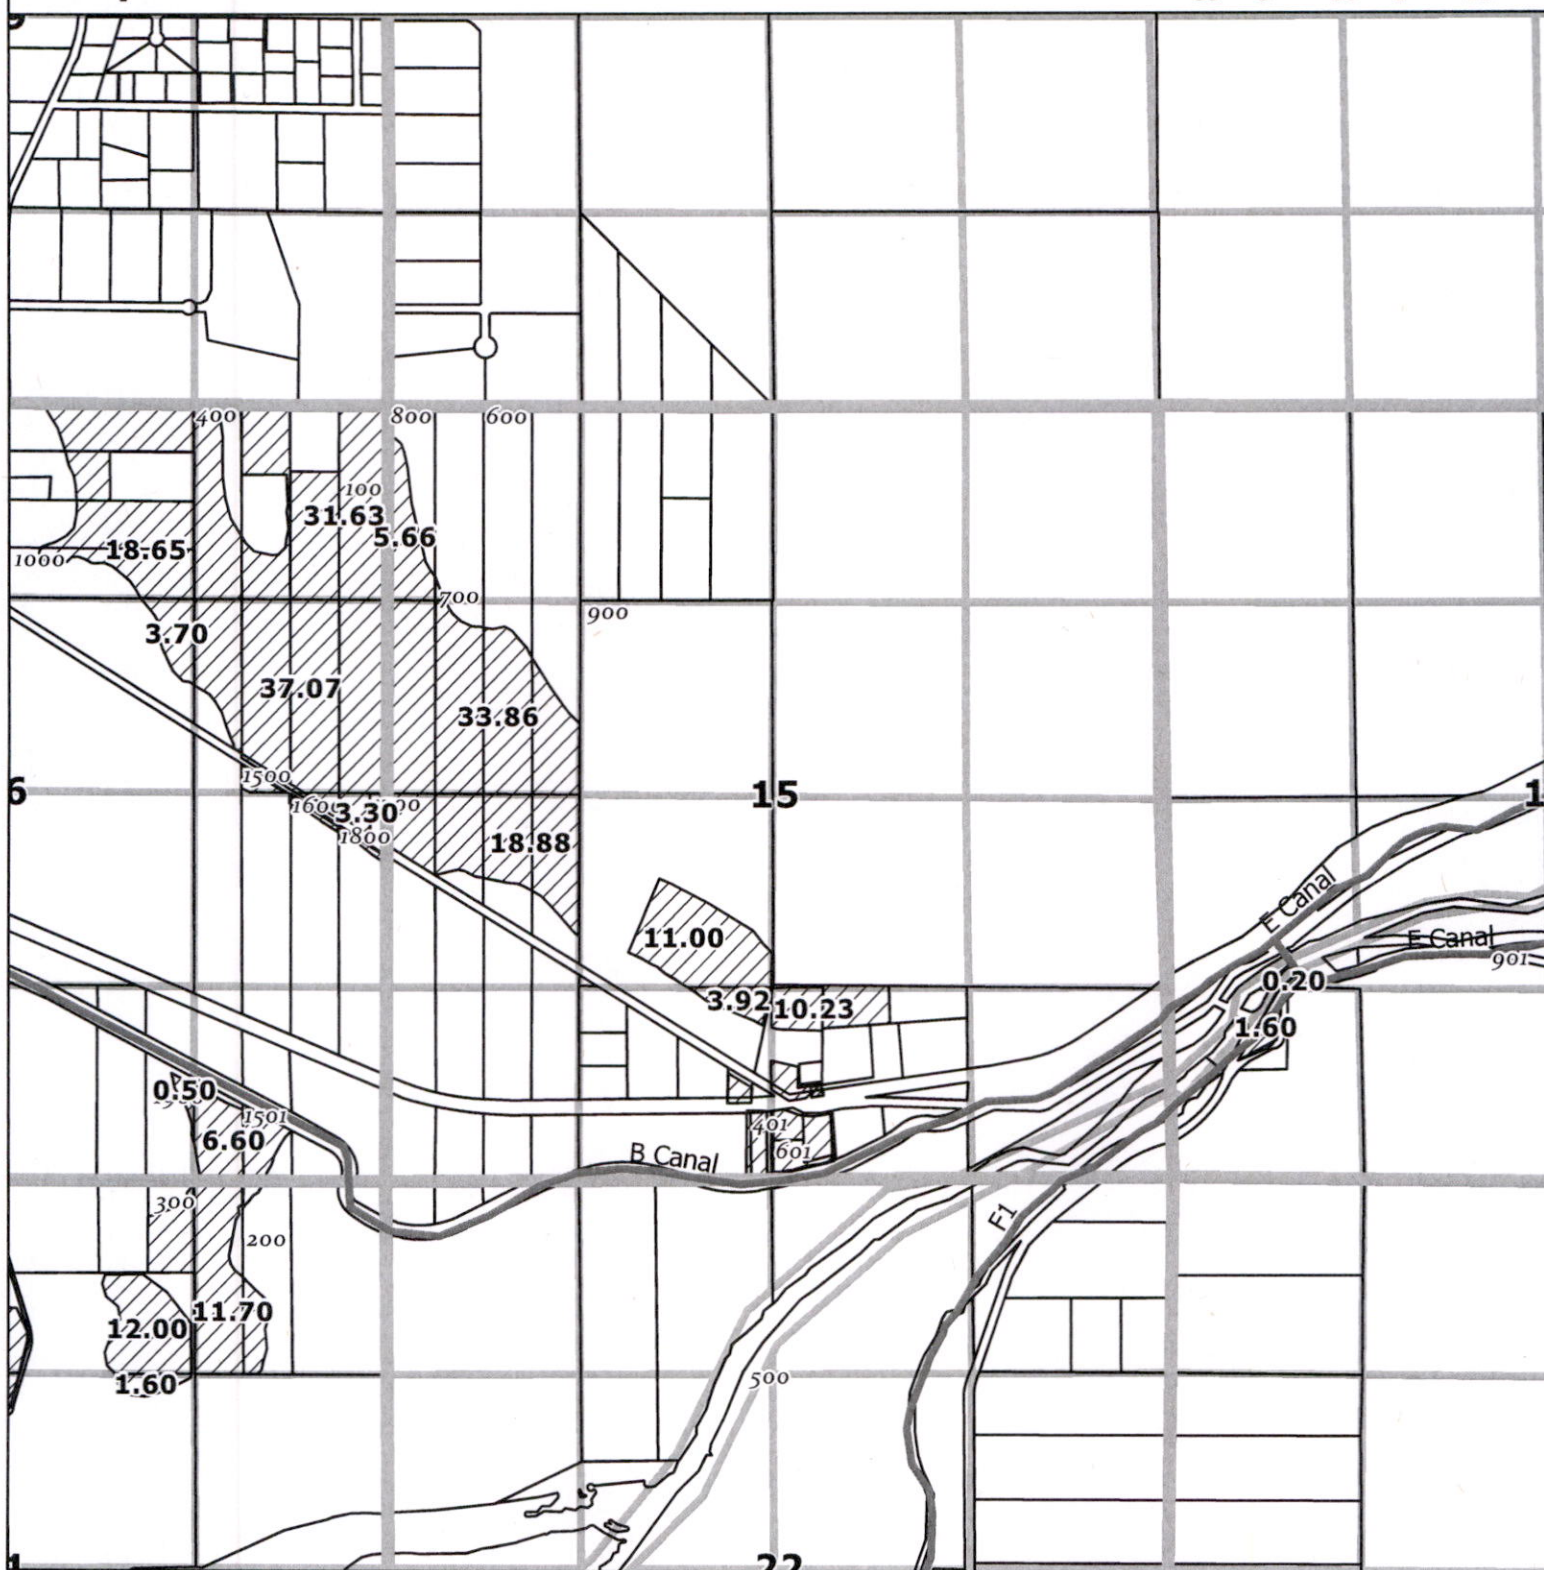

- Place of Use
- Klamath County Taxlot
- QQ Sections and Gov't Lots
- Map Series Sections
- Canal

Received

JUL 07 2025

OWRD




1,320

Feet

DISCLAIMER


This map is not intended to provide legal dimensions or locations of property ownership lines

WATERSOLVING
johnw@watersolving.com

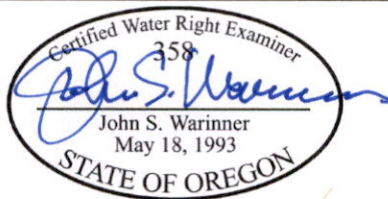

CLAIM OF BENEFICIAL USE MAP
APPLICATION G-16030
PERMIT G-18797
06/23/2025

T		R		S
39	S	10	E	16

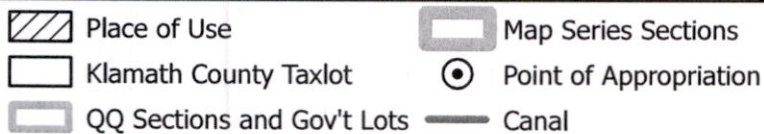


1,320
Feet

Certified Water Right Examiner
358
John S. Warinner
John S. Warinner
May 18, 1993
STATE OF OREGON

**CLAIM OF BENEFICIAL USE MAP
APPLICATION G-16030
PERMIT G-18797
06/23/2025**

T		R		S
39	S	10	E	17

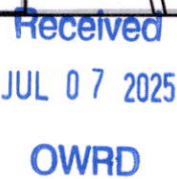


- 1,320
Feet



CLAIM OF BENEFICIAL USE MAP
APPLICATION G-16030
PERMIT G-18797
06/23/2025


Map No. 22

T S 39 R 10 S 18 E 18

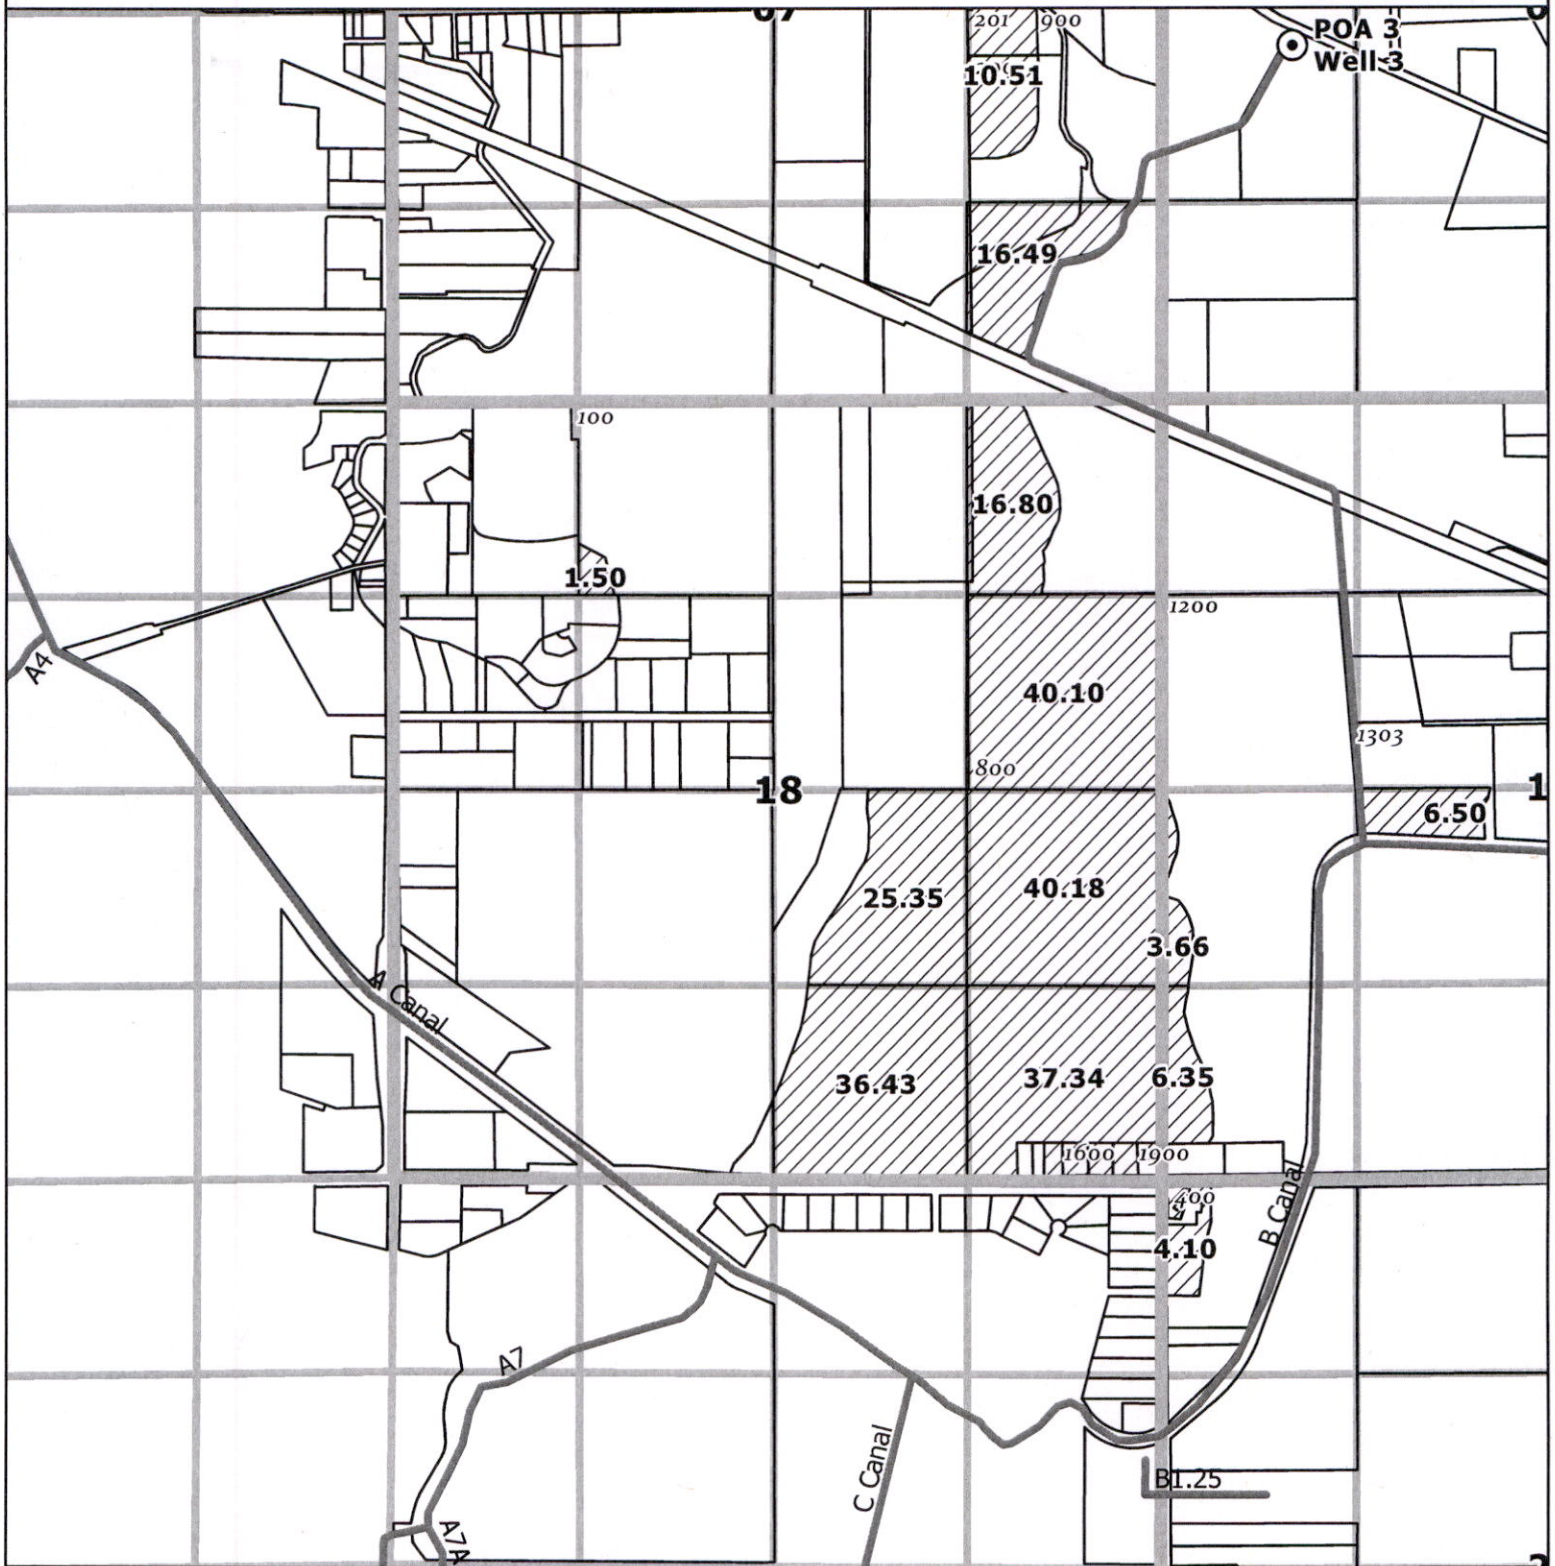


- Place of Use
- Klamath County Taxlot
- QQ Sections and Gov't Lots
- Map Series Sections
- Canal

Received
JUL 07 2025

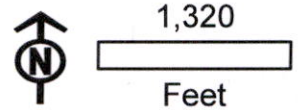

DISCLAIMER
This map is not intended to
provide legal dimensions or
locations of property
ownership lines


WATERSOLVING
johnw@watersolving.com

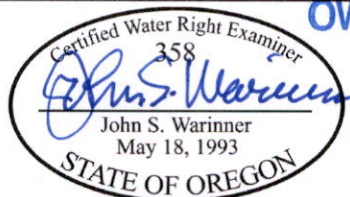

OWRD
CLAIM OF BENEFICIAL USE MAP
APPLICATION G-16030
PERMIT G-18797
06/23/2025


Map No. 23

T 39 S 10 E S 20

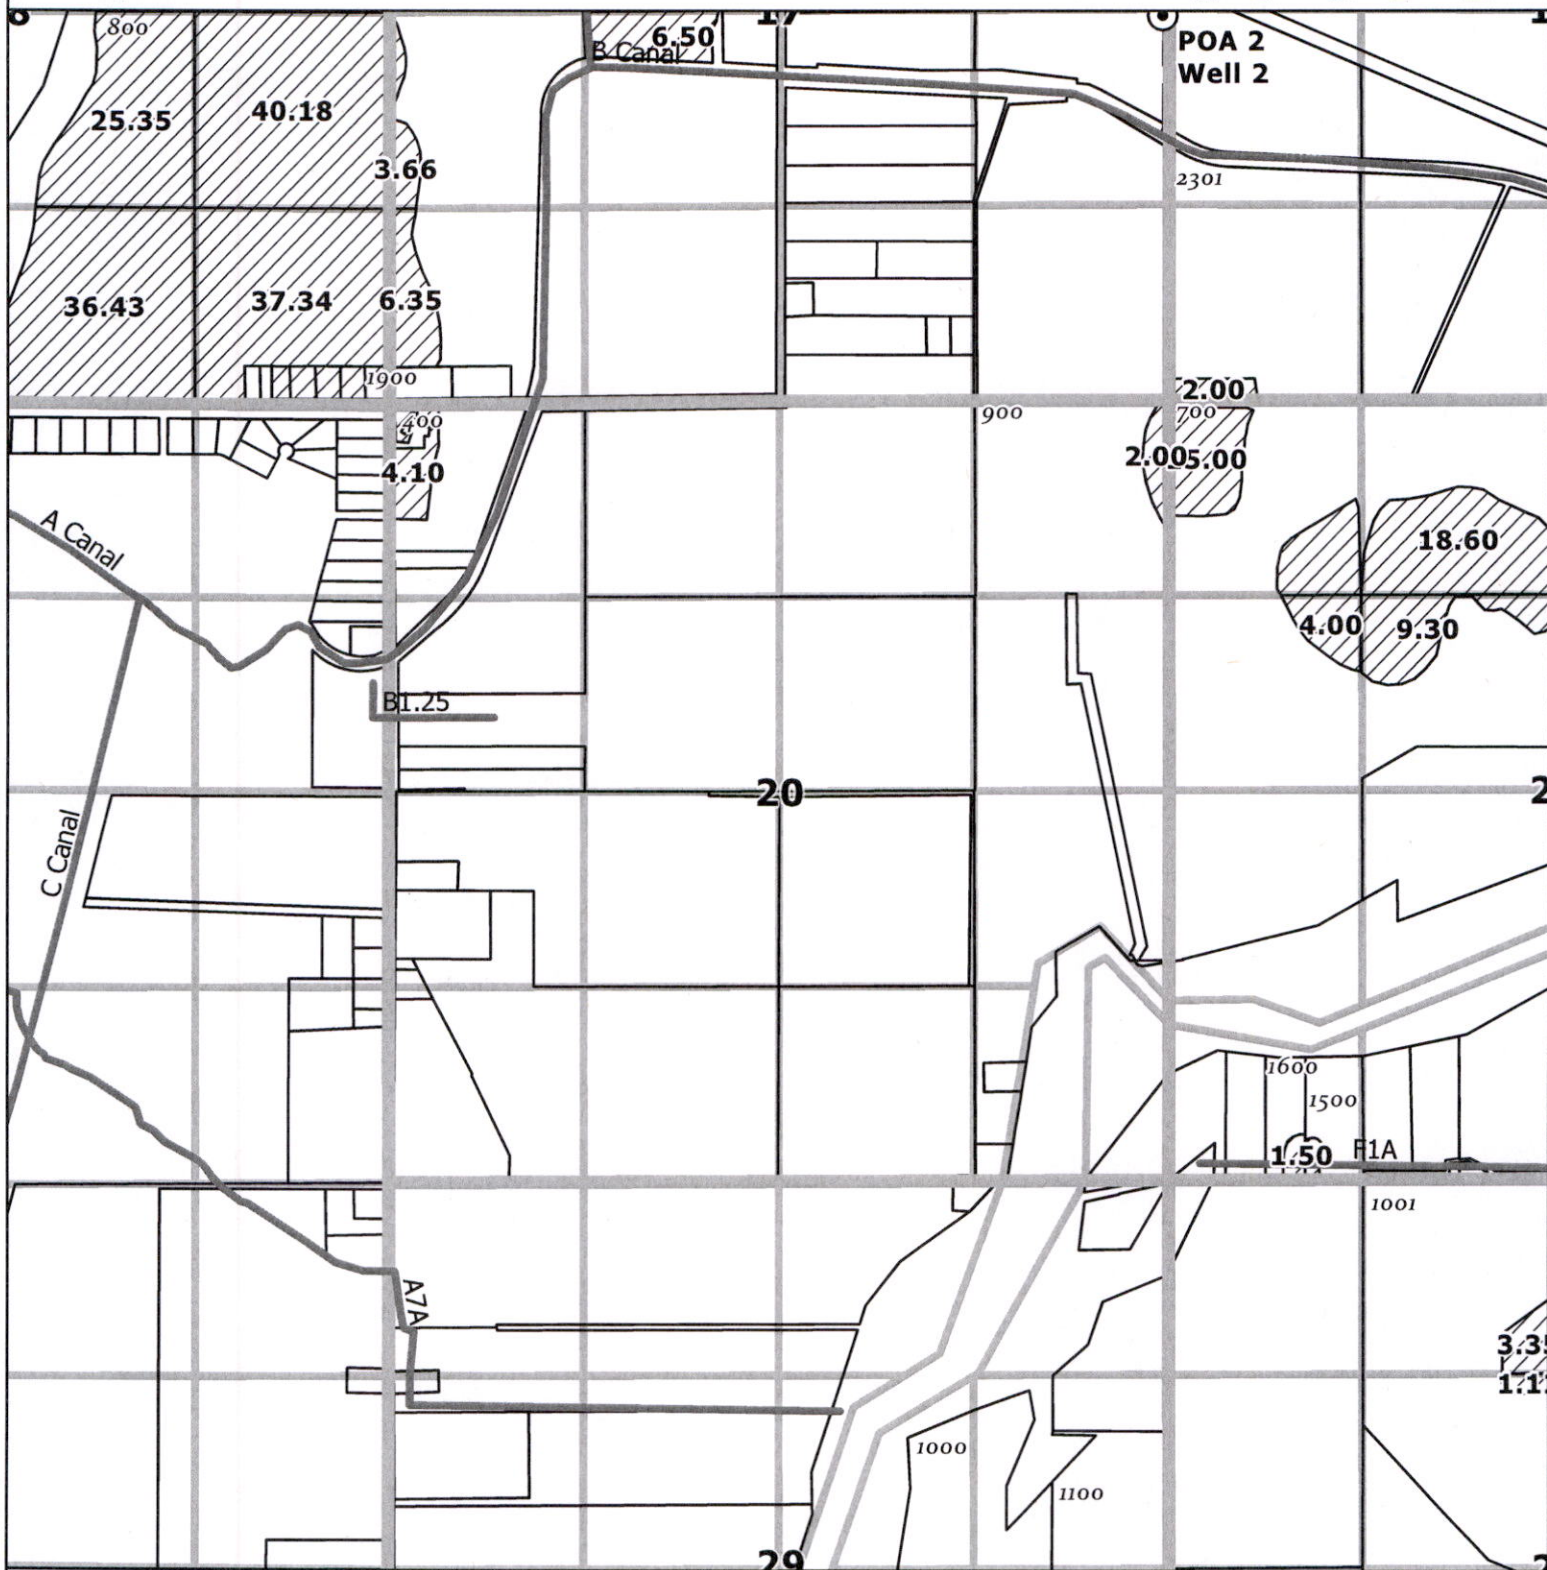


- Place of Use
- Klamath County Taxlot
- QQ Sections and Gov't Lots
- Map Series Sections
- Canal

Received
JUL 07 2025
OWRD

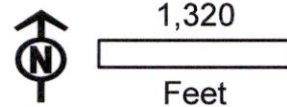

DISCLAIMER
This map is not intended to
provide legal dimensions or
locations of property
ownership lines


WATERSOLVING
johnw@watersolving.com

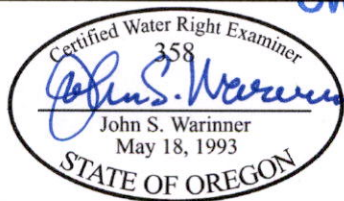

CLAIM OF BENEFICIAL USE MAP
APPLICATION G-16030
PERMIT G-18797
06/23/2025

Map No. 25

T S 39 R 10 S 22 E

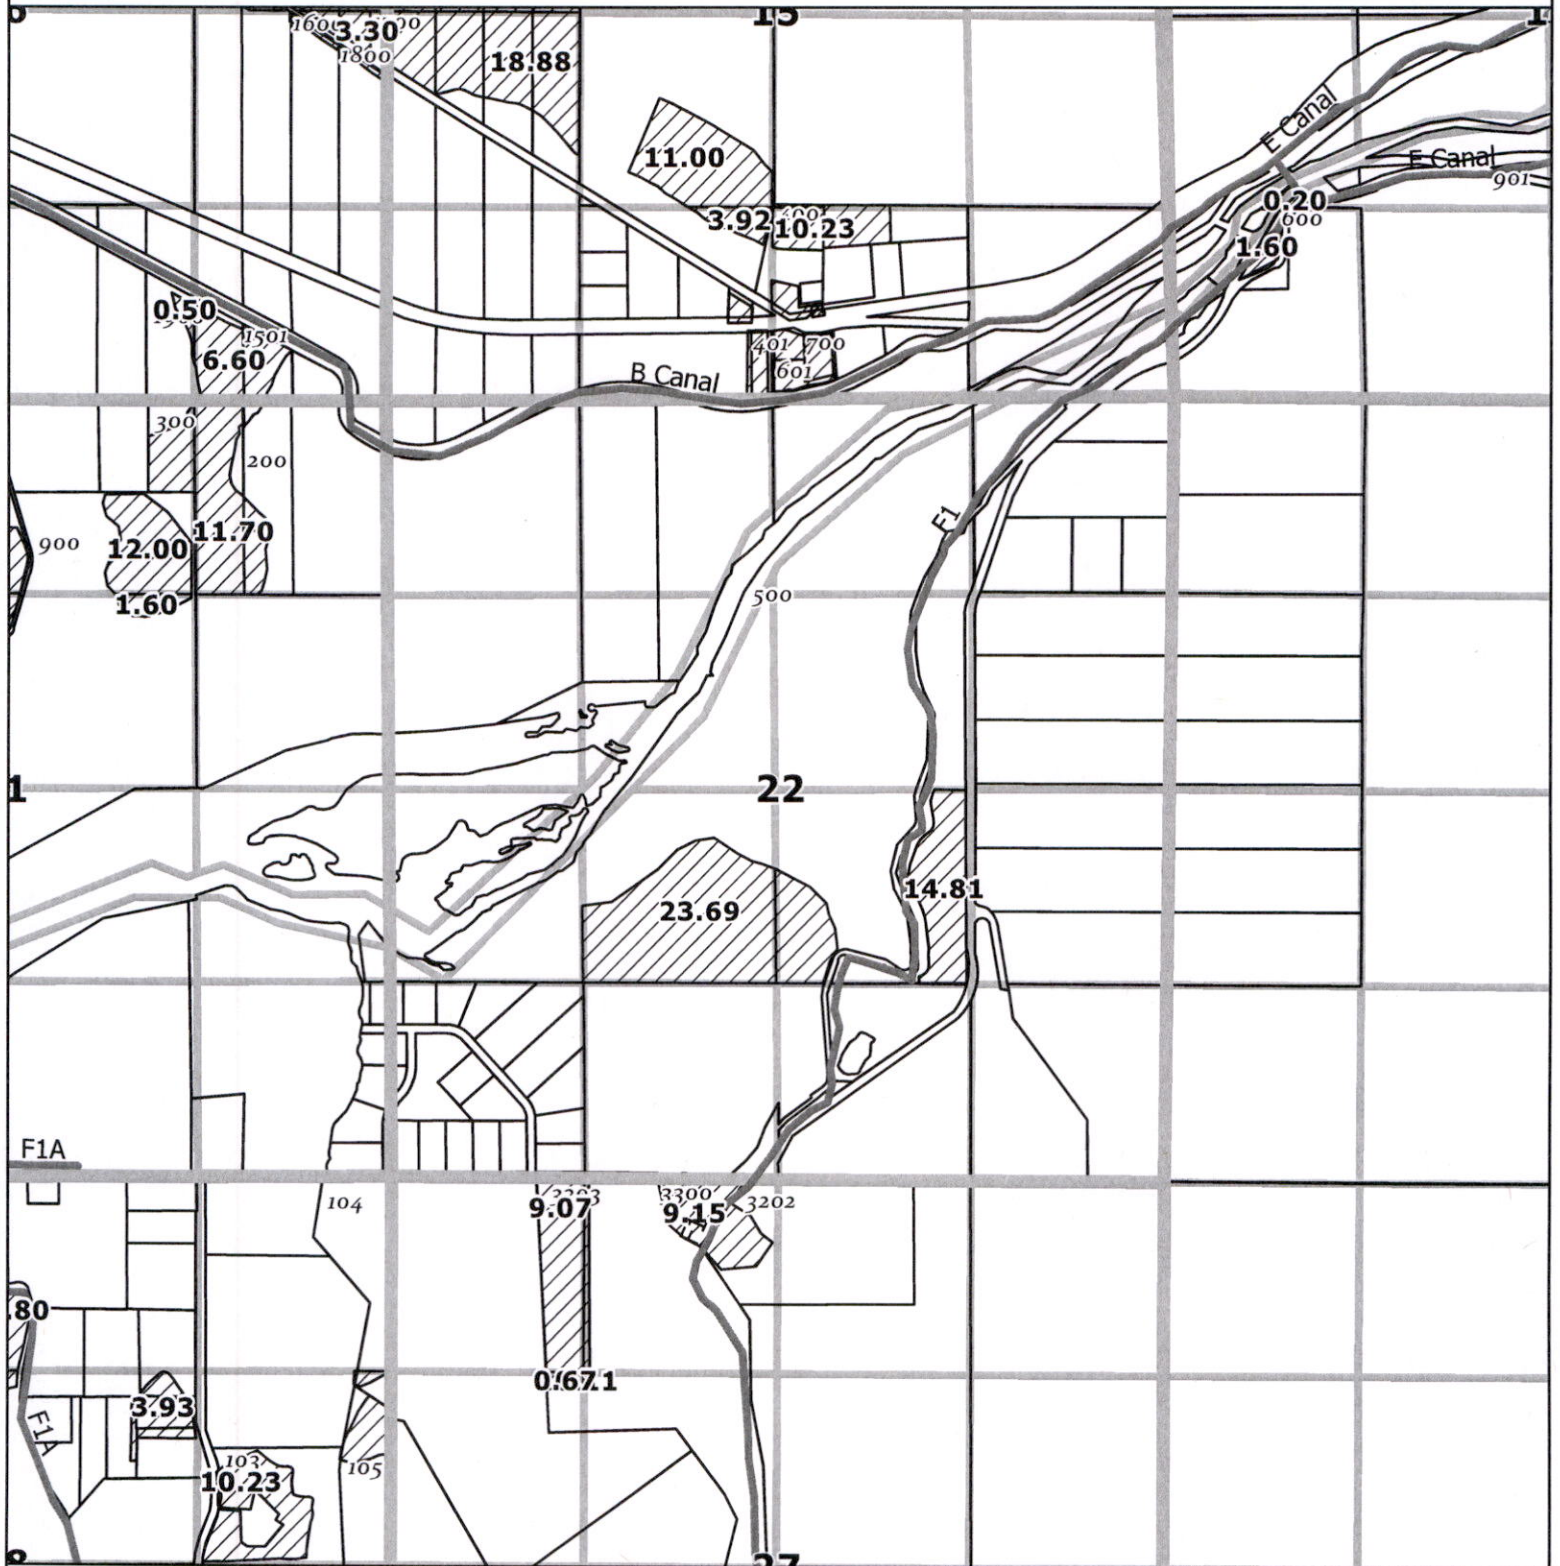

- Place of Use
- Klamath County Taxlot
- QQ Sections and Gov't Lots
- Map Series Sections
- Canal

Received
JUL 07 2025




1,320
Feet

OWRD

DISCLAIMER
This map is not intended to
provide legal dimensions or
locations of property
ownership lines


WATERSOLVING
johnw@watersolving.com

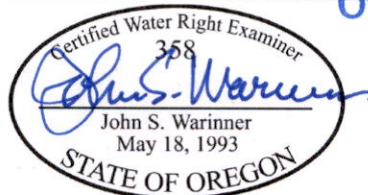

CLAIM OF BENEFICIAL USE MAP
APPLICATION G-16030
PERMIT G-18797
06/23/2025

Map No. 26

T 39 S 10 E S 24

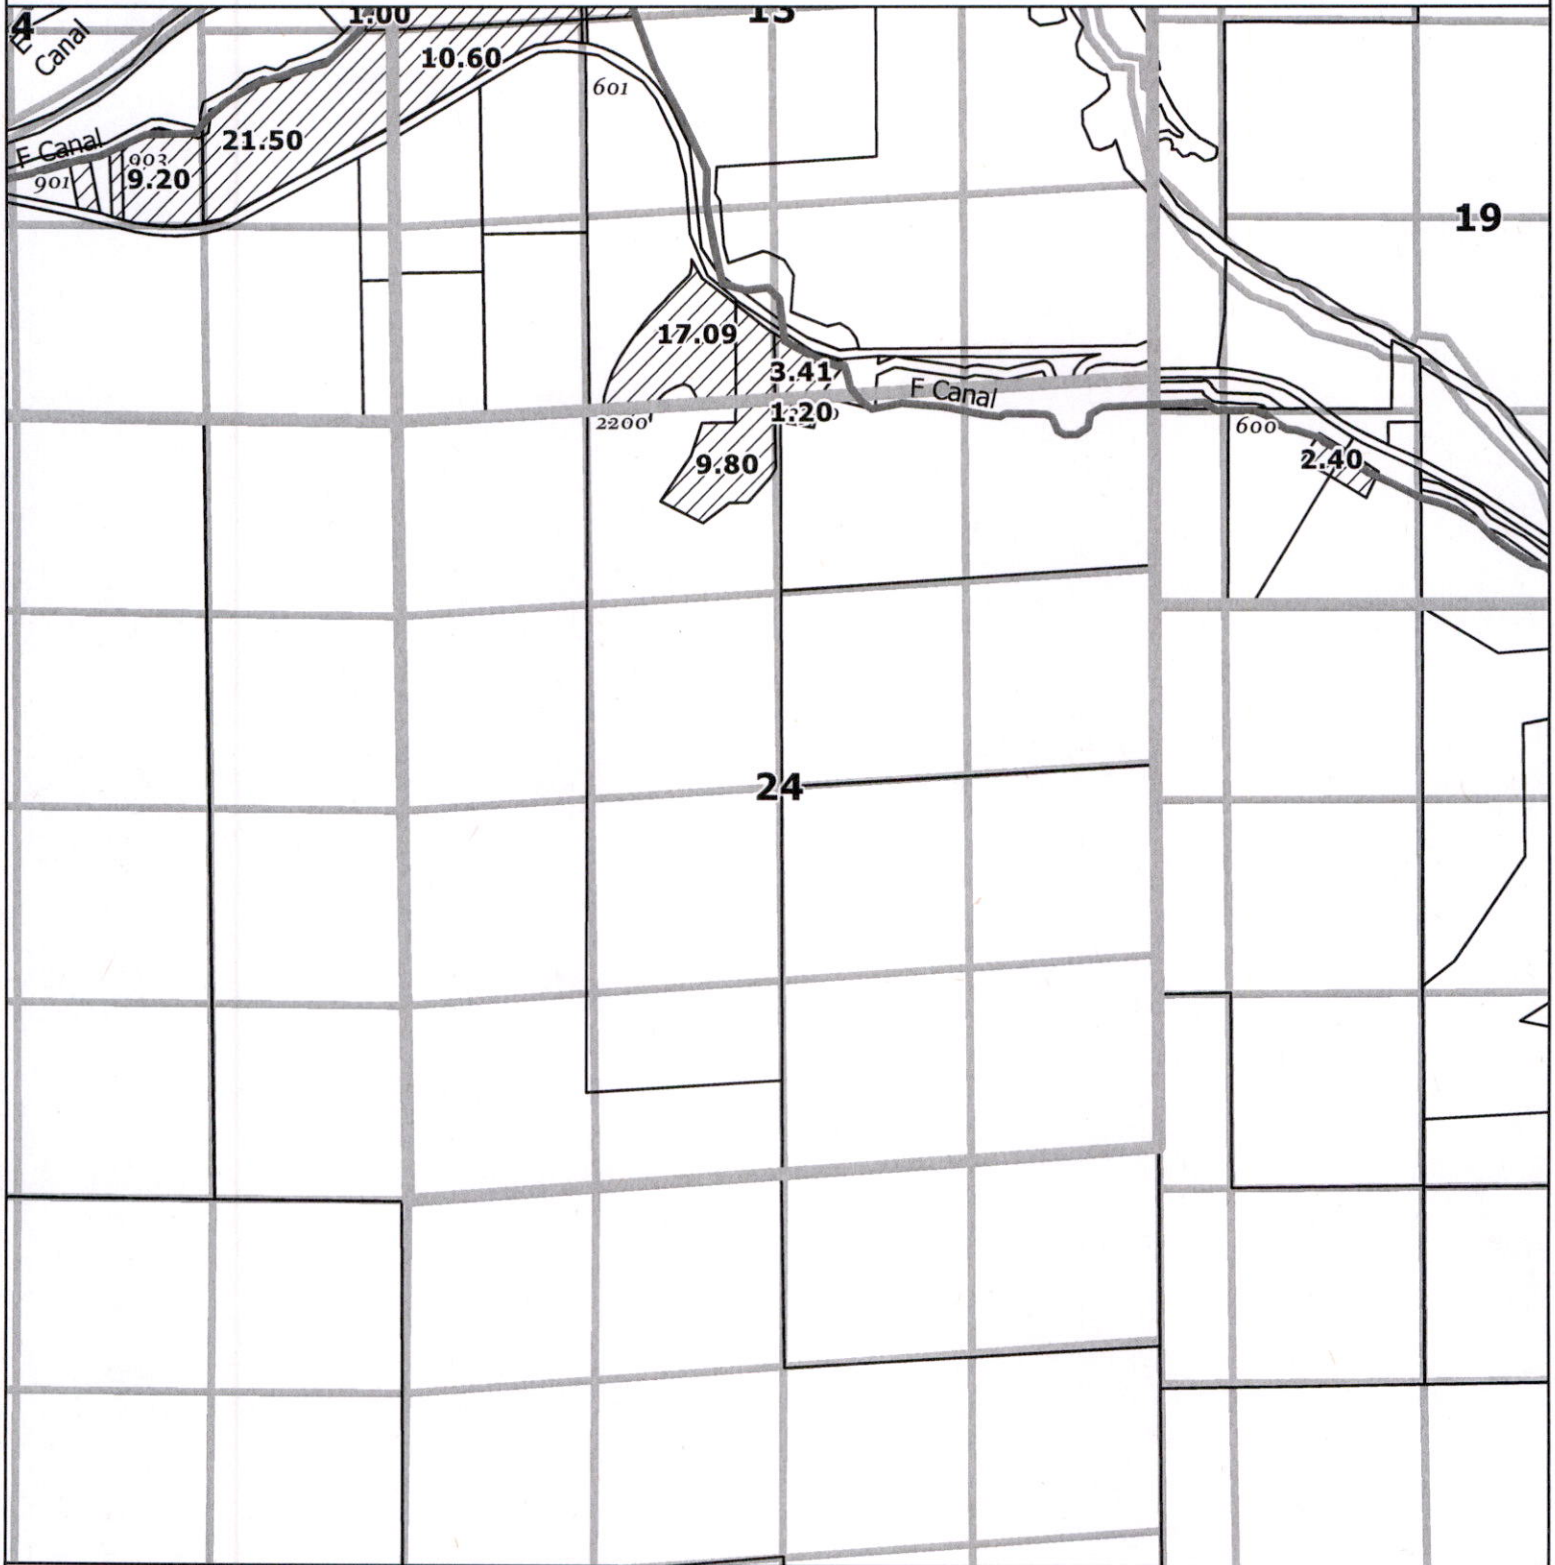

- Place of Use
- Klamath County Taxlot
- QQ Sections and Gov't Lots
- Map Series Sections
- Canal

Received
JUL 07 2025




1,320
Feet

OWRD

DISCLAIMER
This map is not intended to
provide legal dimensions or
locations of property
ownership lines


WATERSOLVING
johnw@watersolving.com

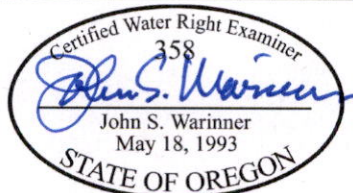

CLAIM OF BENEFICIAL USE MAP
APPLICATION G-16030
PERMIT G-18797
06/23/2025

Map No. 27


T 39 S 10 E S 27

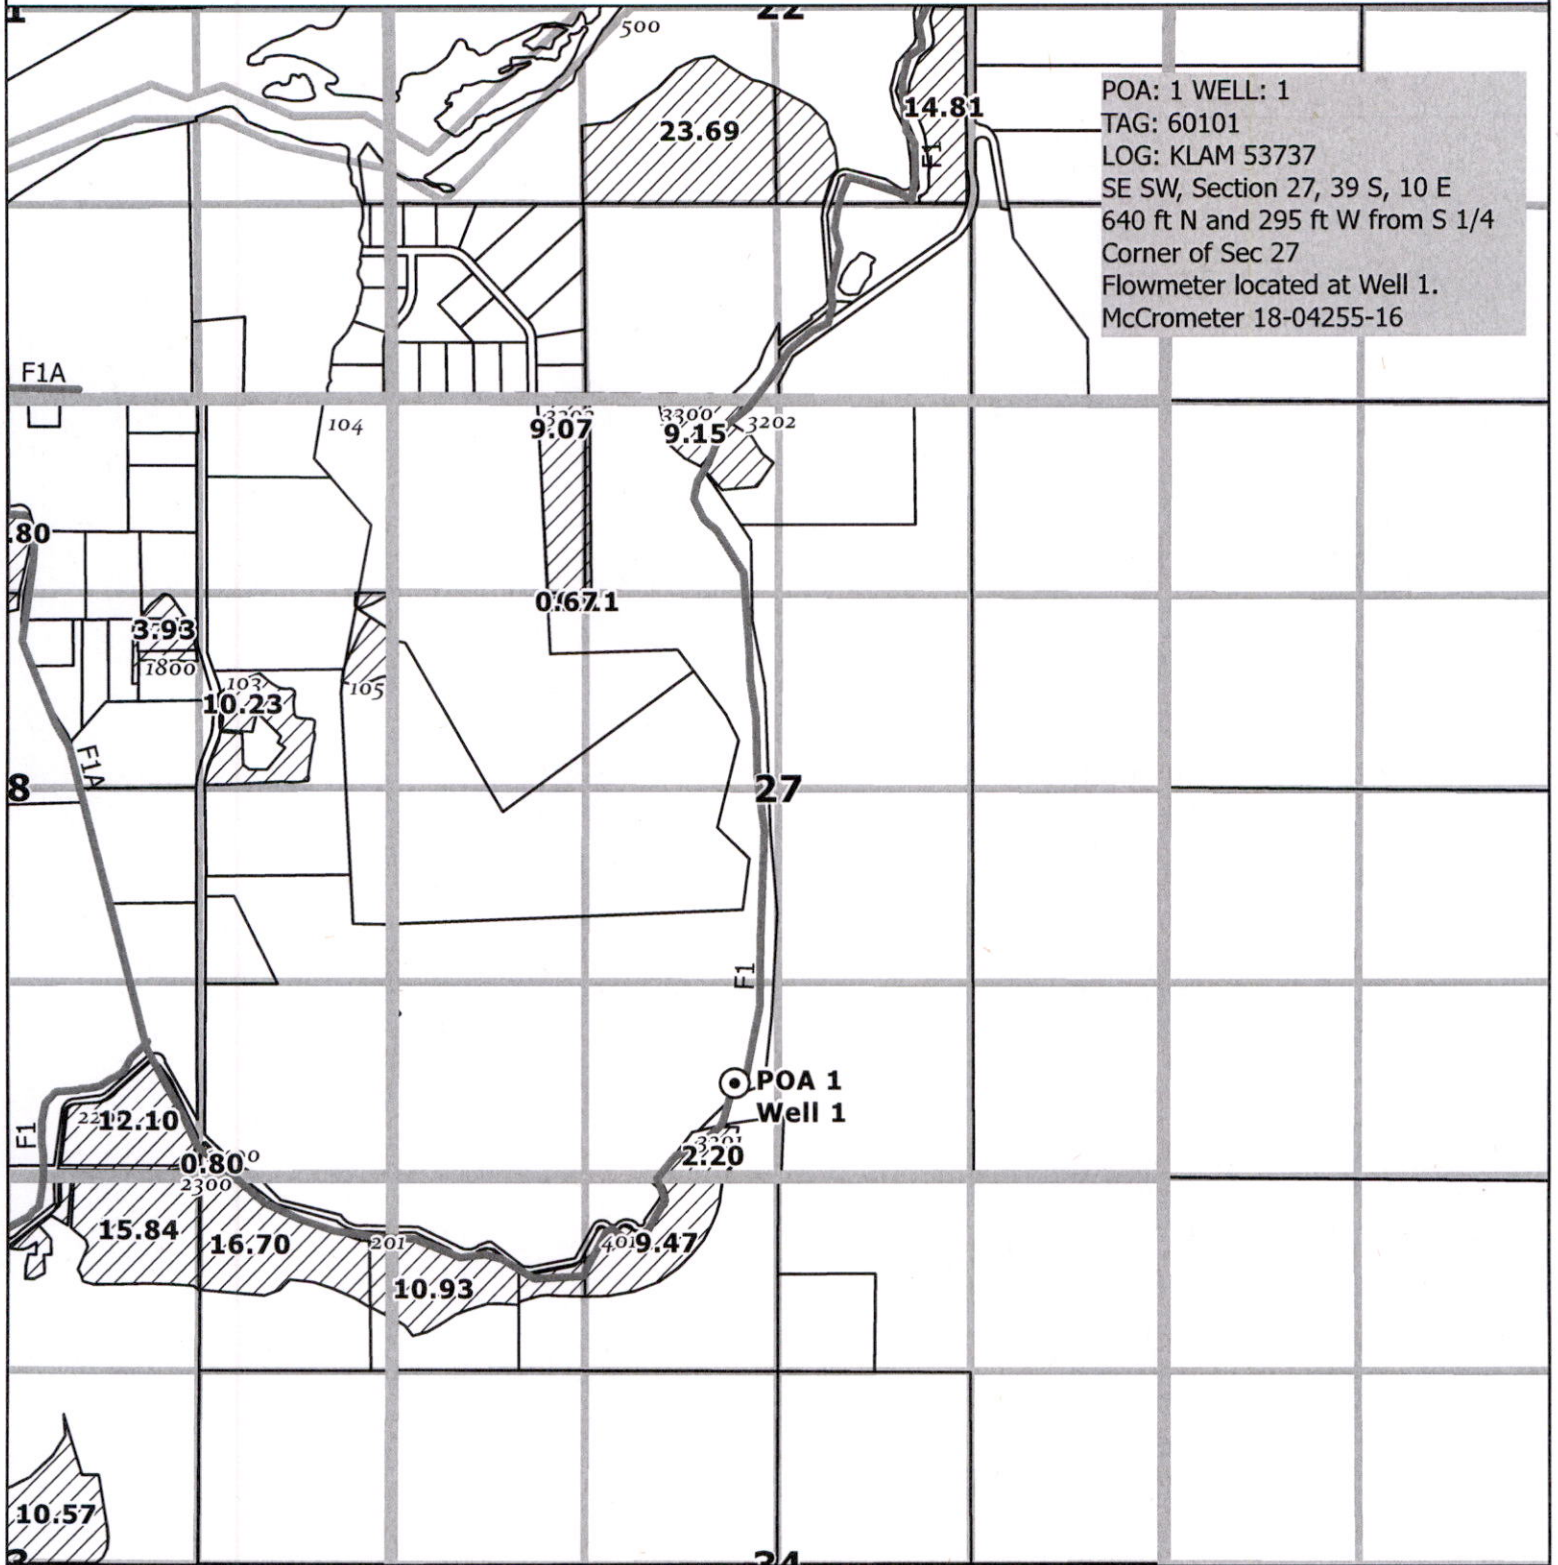

POA: 1 WELL: 1
TAG: 60101
LOG: KLAM 53737
SE SW, Section 27, 39 S, 10 E
640 ft N and 295 ft W from S 1/4
Corner of Sec 27
Flowmeter located at Well 1.
McCrometer 18-04255-16


- Place of Use
- Klamath County Taxlot
- QQ Sections and Gov't Lots
- Map Series Sections
- Point of Appropriation
- Pipelines
- Canal

Received
JUL 07 2025
OWRD

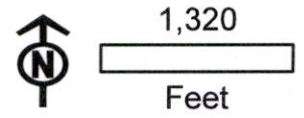

DISCLAIMER
This map is not intended to
provide legal dimensions or
locations of property
ownership lines


WATERSOLVING
johnw@watersolving.com

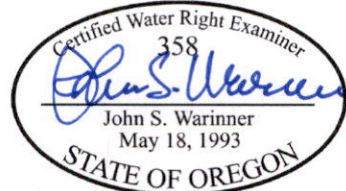

CLAIM OF BENEFICIAL USE MAP
APPLICATION G-16030
PERMIT G-18797
06/23/2025

Map No. 28

T S 39 R 10 S 28 E

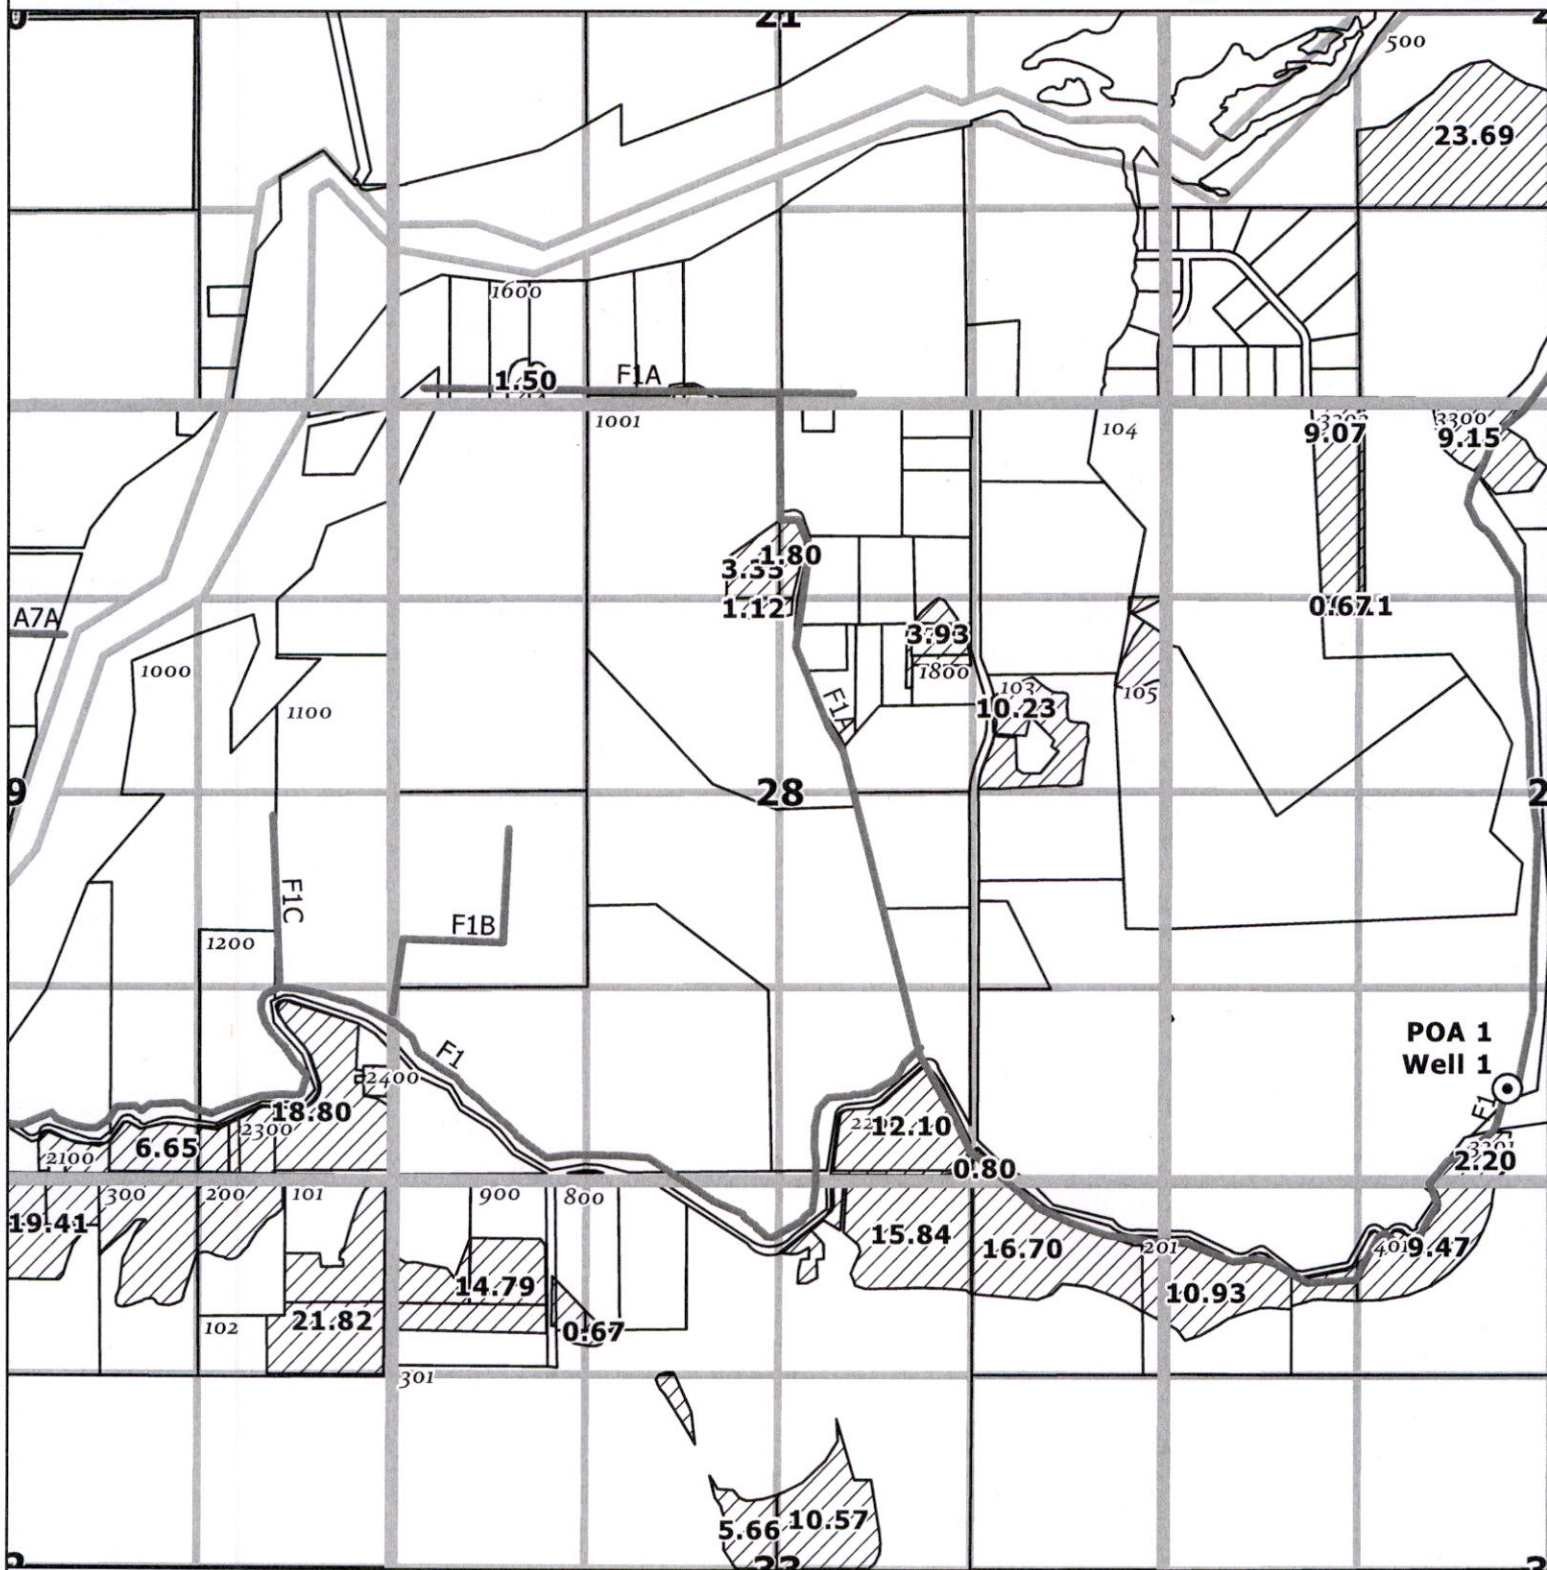

- Place of Use
- Klamath County Taxlot
- QQ Sections and Gov't Lots
- Map Series Sections
- Canal

Received

JUL 07 2025

OWRD




1,320

Feet

DISCLAIMER


This map is not intended to provide legal dimensions or locations of property ownership lines

WATERSOLVING
johnw@watersolving.com

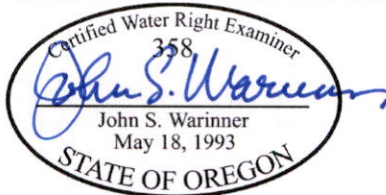


CLAIM OF BENEFICIAL USE MAP
APPLICATION G-16030
PERMIT G-18797
06/23/2025


T		R		S
39	S	10	E	29

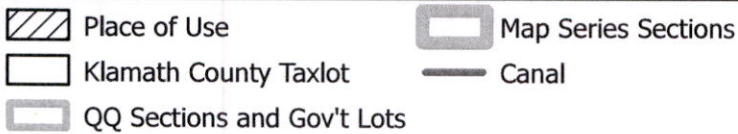

Received
JUL 07 2025
OWRD

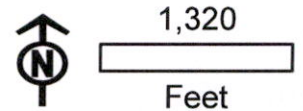


WATERSOLVING
johnw@watersolving.com

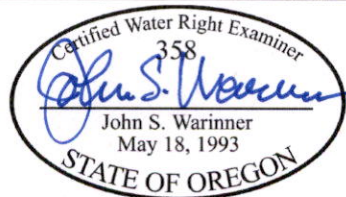

**CLAIM OF BENEFICIAL USE MAP
APPLICATION G-16030
PERMIT G-18797
06/23/2025**

Map No. 30


T S R E S
39 S 10 E 31

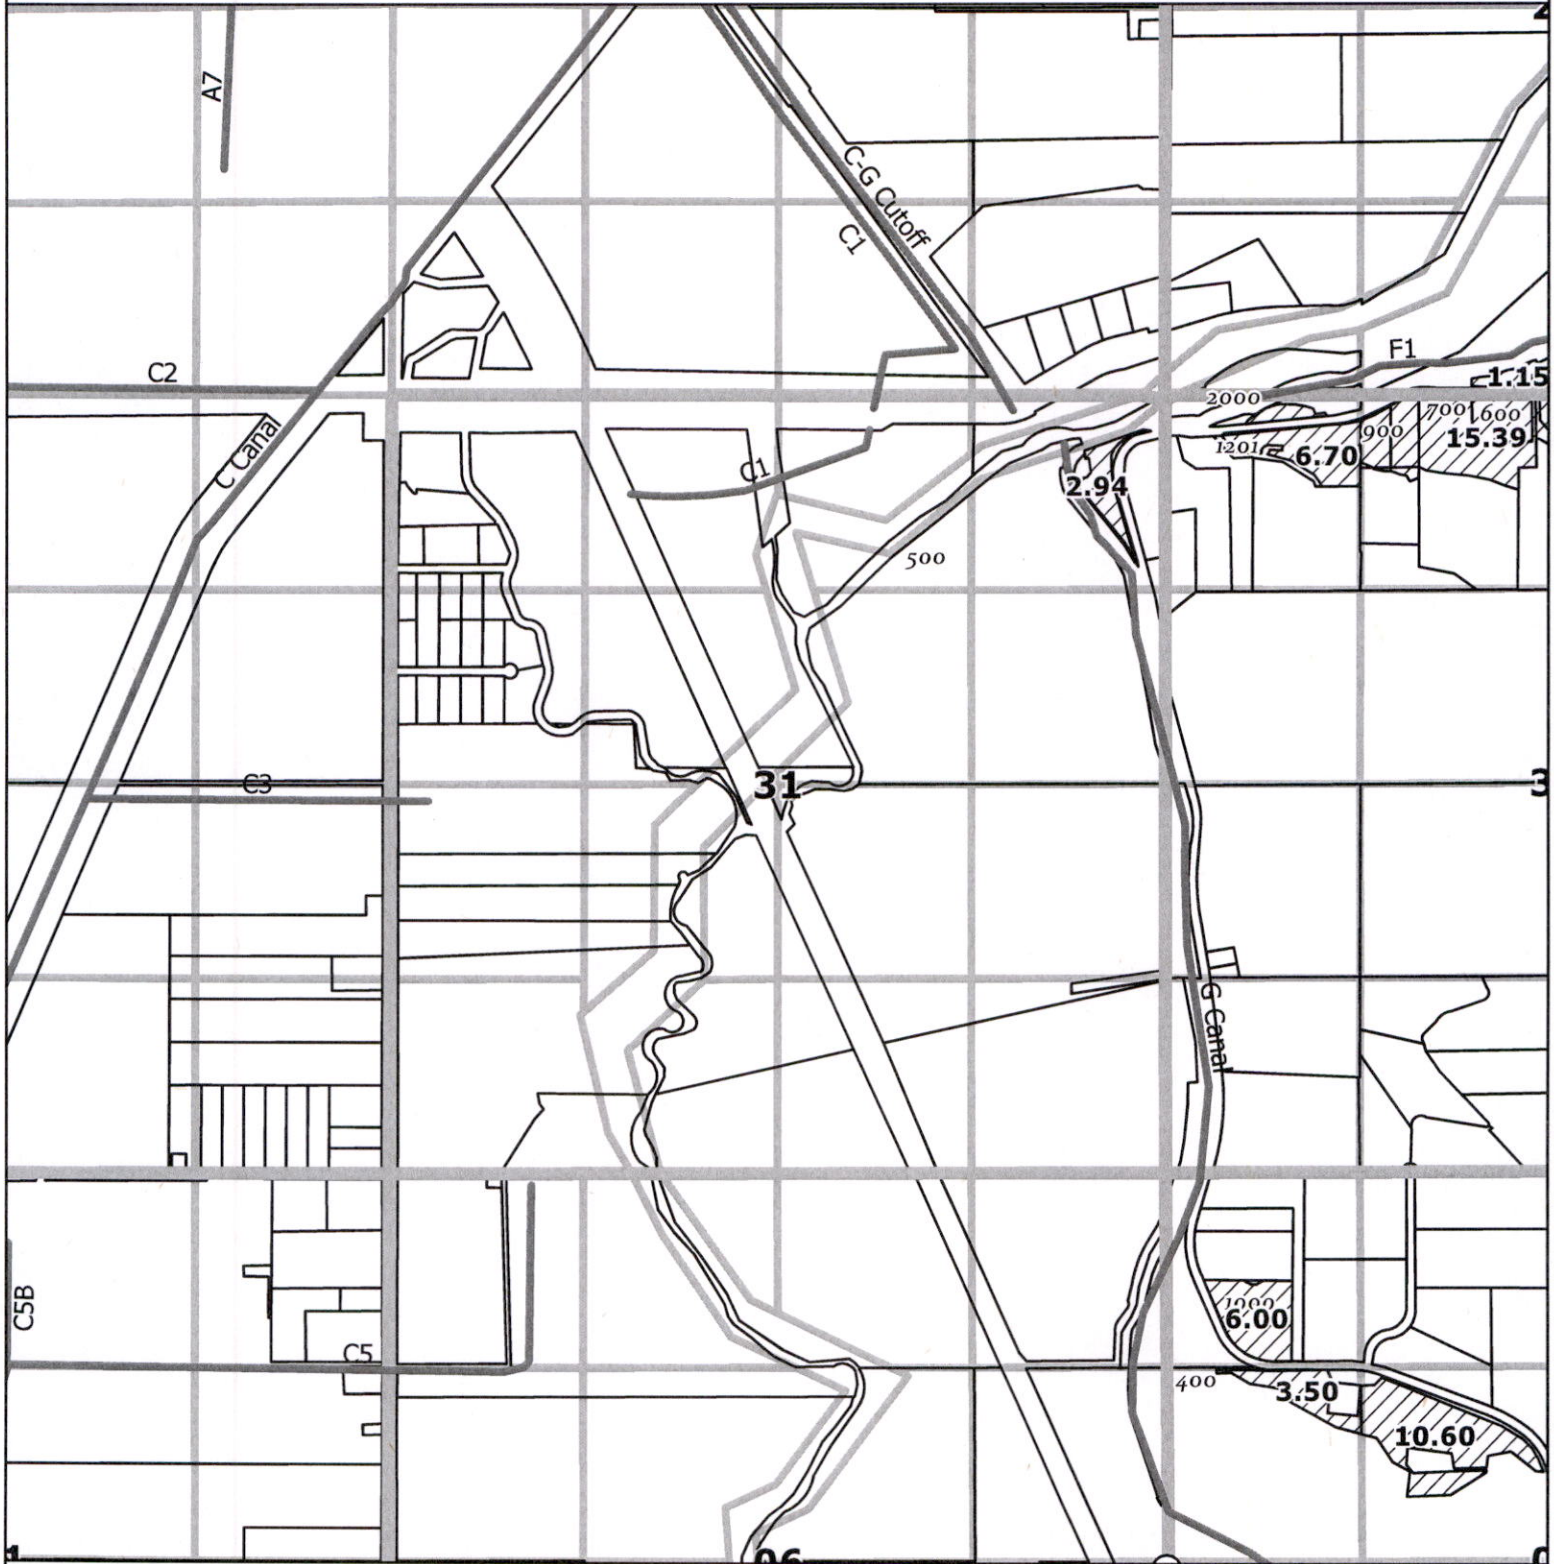

- Place of Use
- Klamath County Taxlot
- QQ Sections and Gov't Lots
- Map Series Sections
- Canal


Received
JUL 07 2025

OWRD

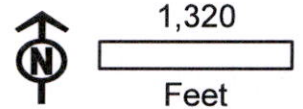

DISCLAIMER
This map is not intended to
provide legal dimensions or
locations of property
ownership lines


WATERSOLVING
johnw@watersolving.com

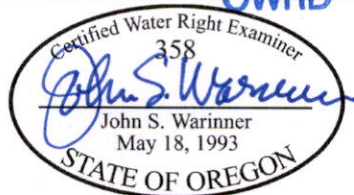

CLAIM OF BENEFICIAL USE MAP
APPLICATION G-16030
PERMIT G-18797
06/23/2025


Map No. 31


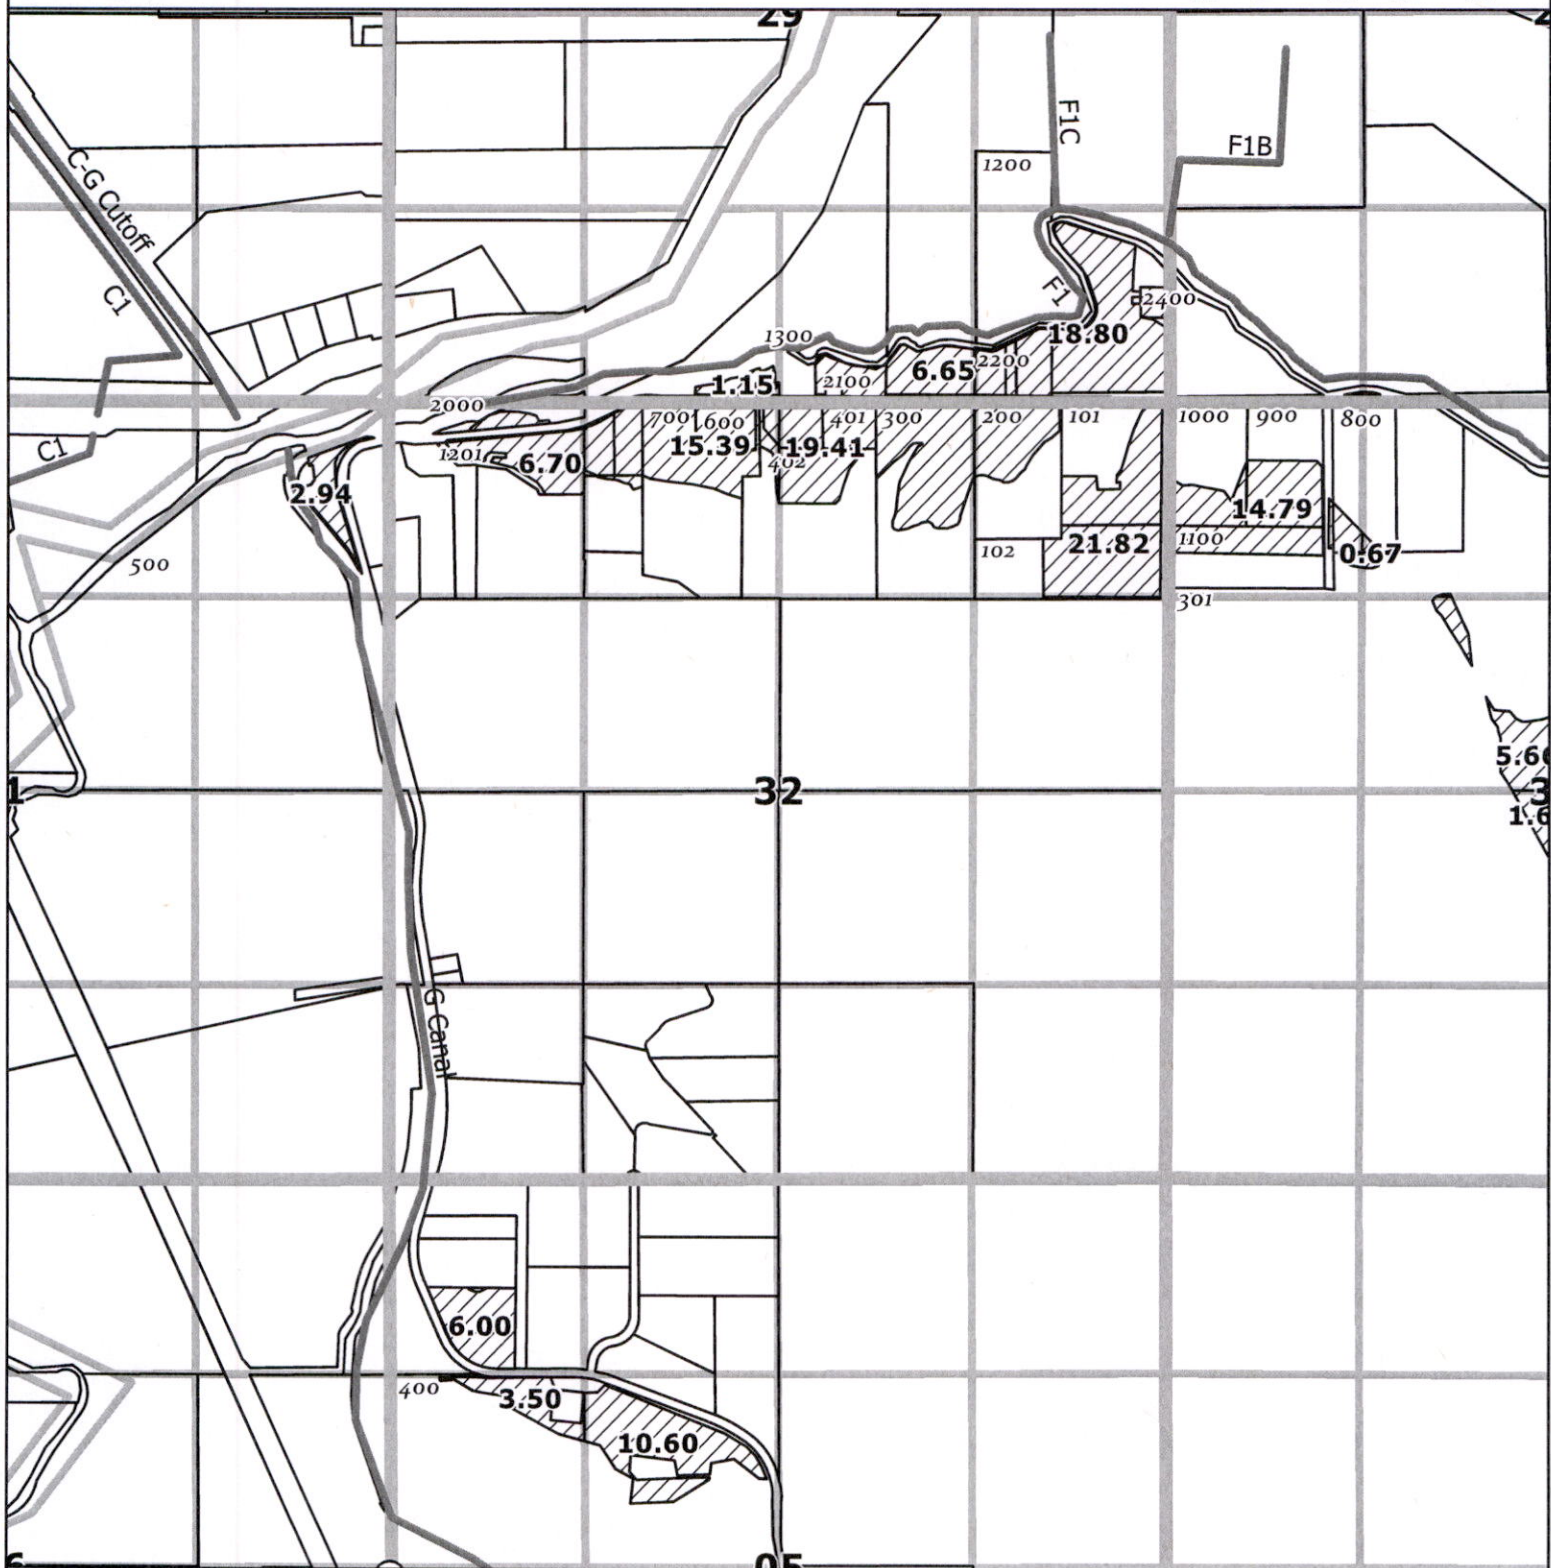


- Place of Use
- Klamath County Taxlot
- QQ Sections and Gov't Lots
- Map Series Sections
- Canal

Received
JUL 07 2025
OWRD

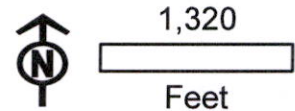

DISCLAIMER
This map is not intended to provide legal dimensions or locations of property ownership lines


WATERSOLVING
johnw@watersolving.com

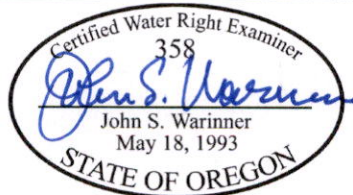

CLAIM OF BENEFICIAL USE MAP
APPLICATION G-16030
PERMIT G-18797
06/23/2025

Map No. 32


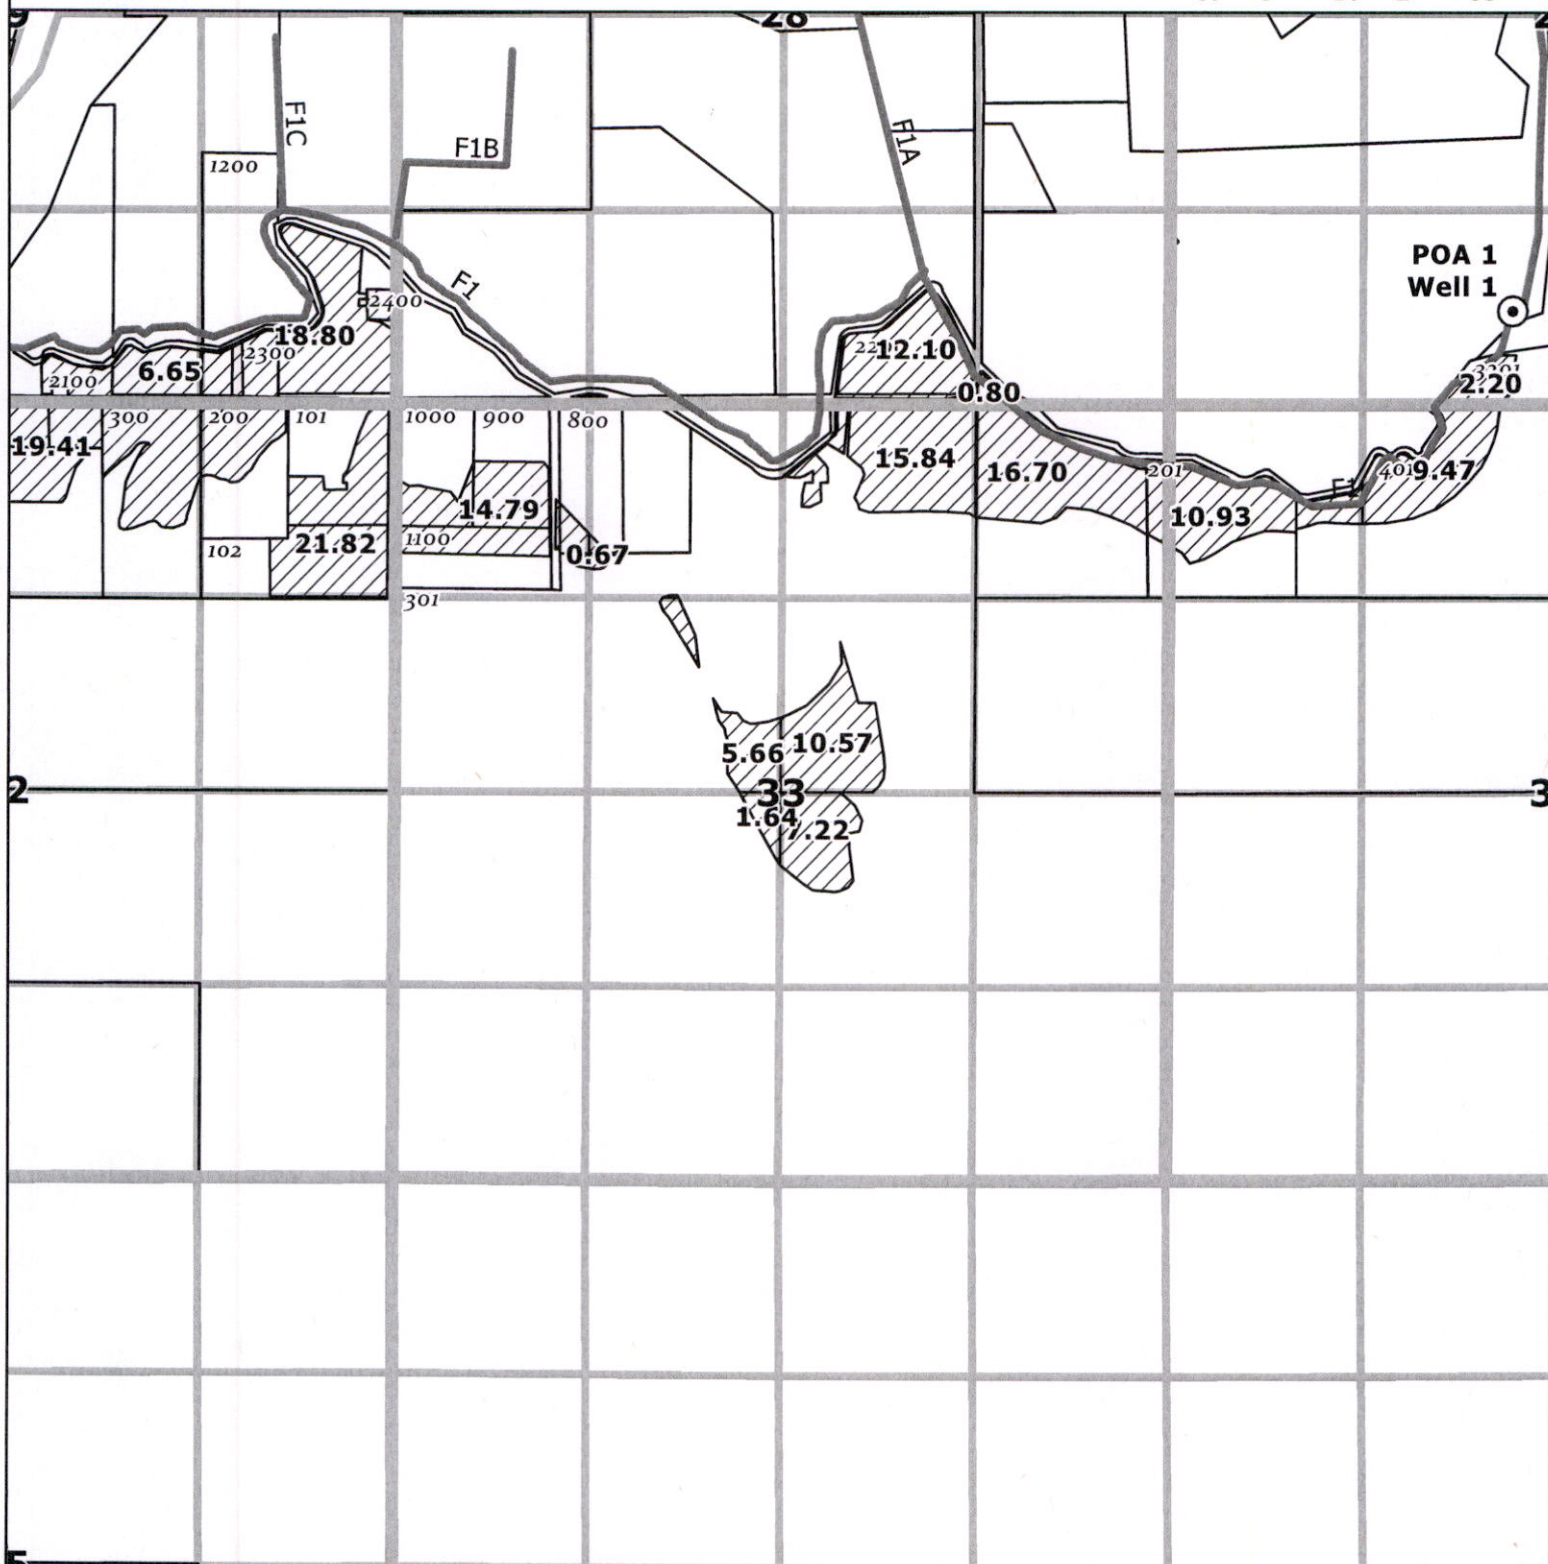

- Place of Use
- Klamath County Taxlot
- QQ Sections and Gov't Lots
- Map Series Sections
- Canal

Received

JUL 07 2025




1,320

Feet

OWRD


DISCLAIMER
This map is not intended to
provide legal dimensions or
locations of property
ownership lines

WATERSOLVING
johnw@watersolving.com

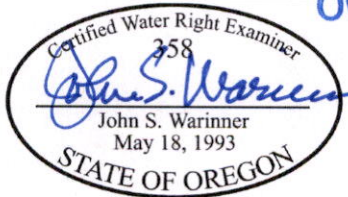

CLAIM OF BENEFICIAL USE MAP
APPLICATION G-16030
PERMIT G-18797
06/23/2025

T		R		S
39	S	10	E	34

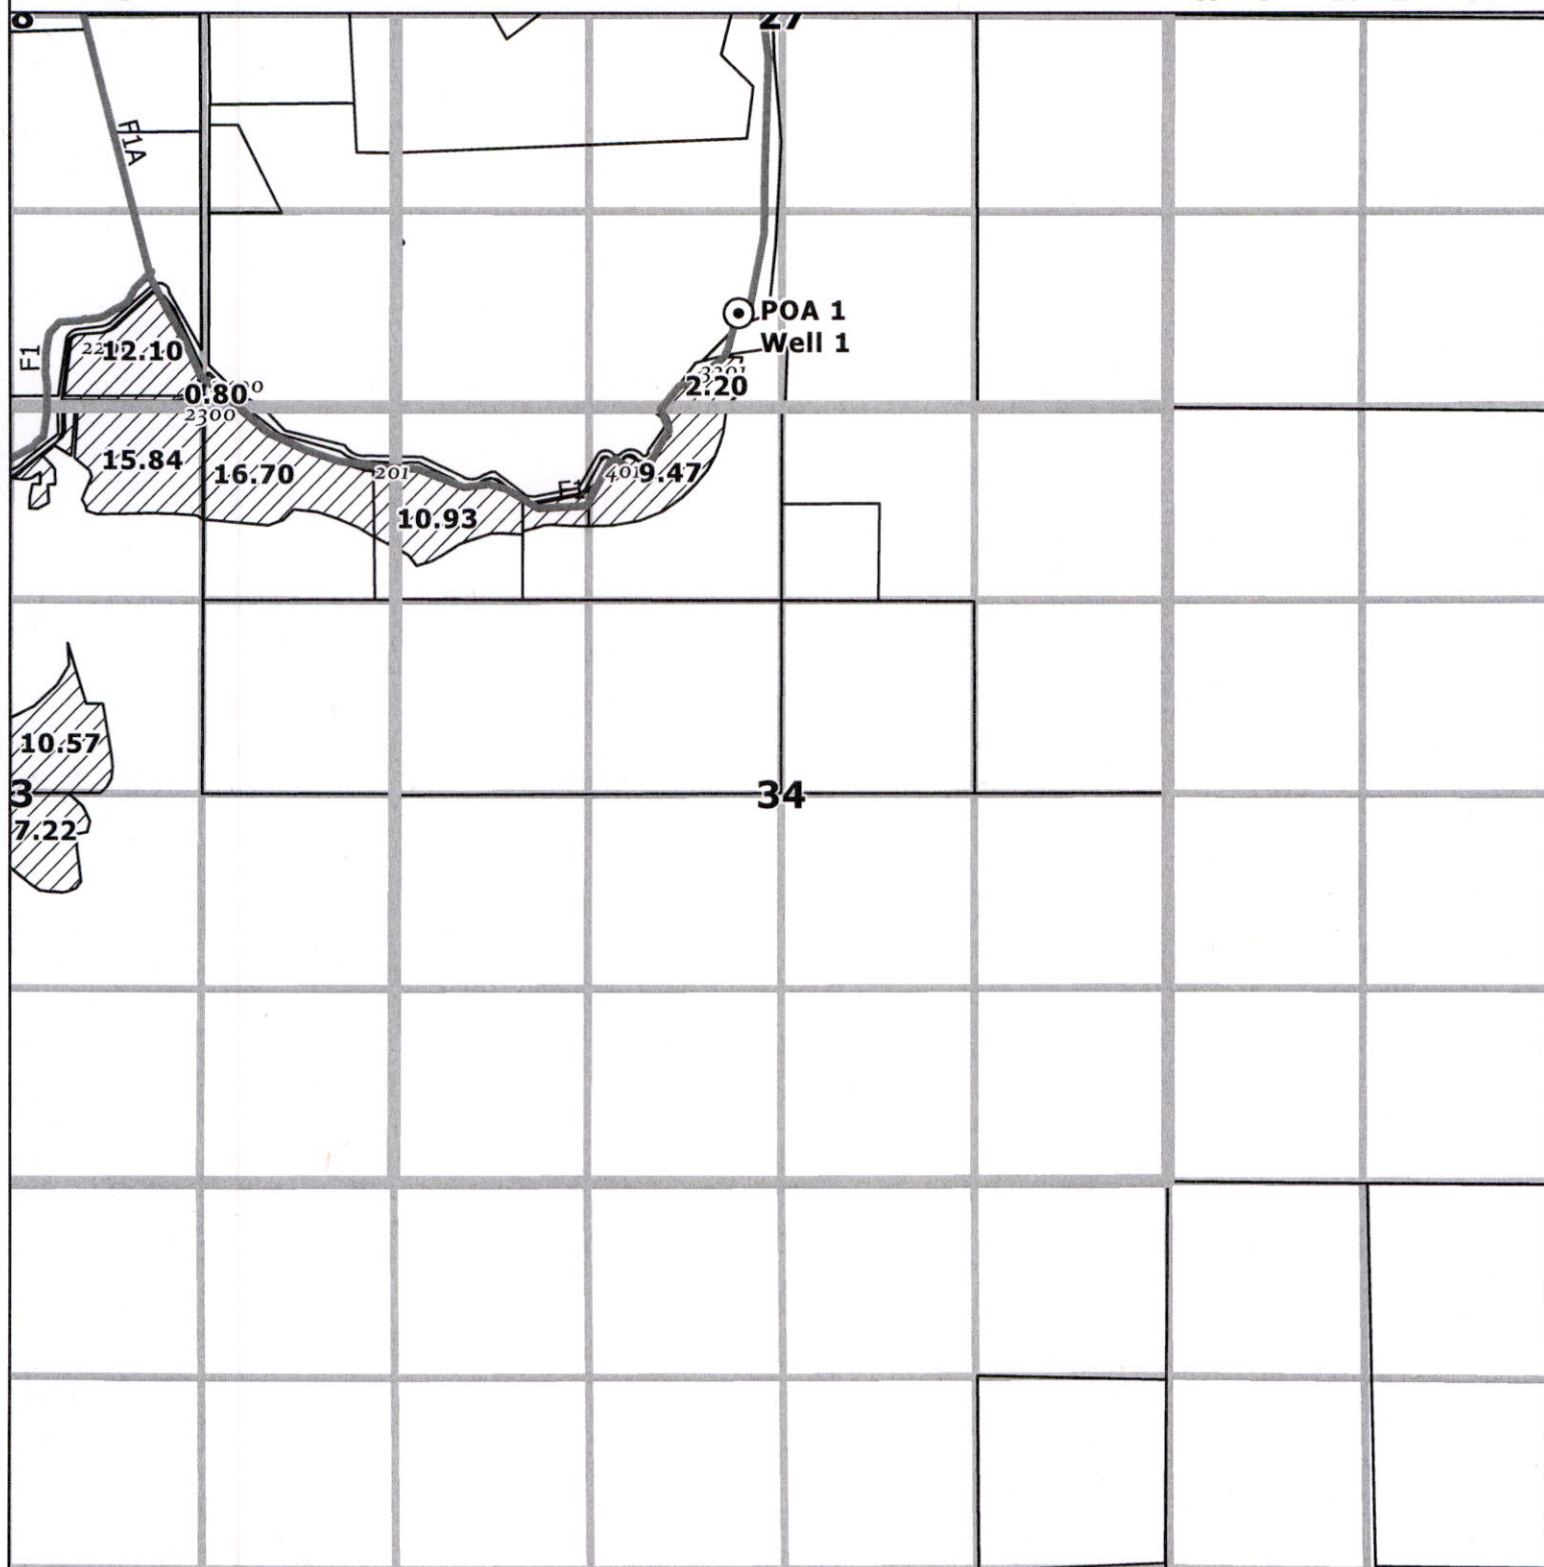

 Place of Use  Map Series Sections
 Klamath County Taxlot  Canal
 QQ Sections and Gov't Lots

Received
JUL 07 2025
OWRD




1,320

Feet

This map is not intended to provide legal dimensions or locations of property ownership lines


WATERSOLVING
johnw@watersolving.com

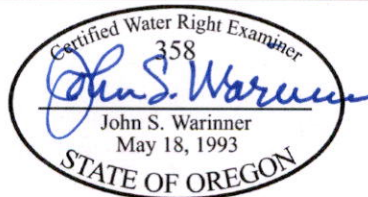

**CLAIM OF BENEFICIAL USE MAP
APPLICATION G-16030
PERMIT G-18797
06/23/2025**


Map No. 34


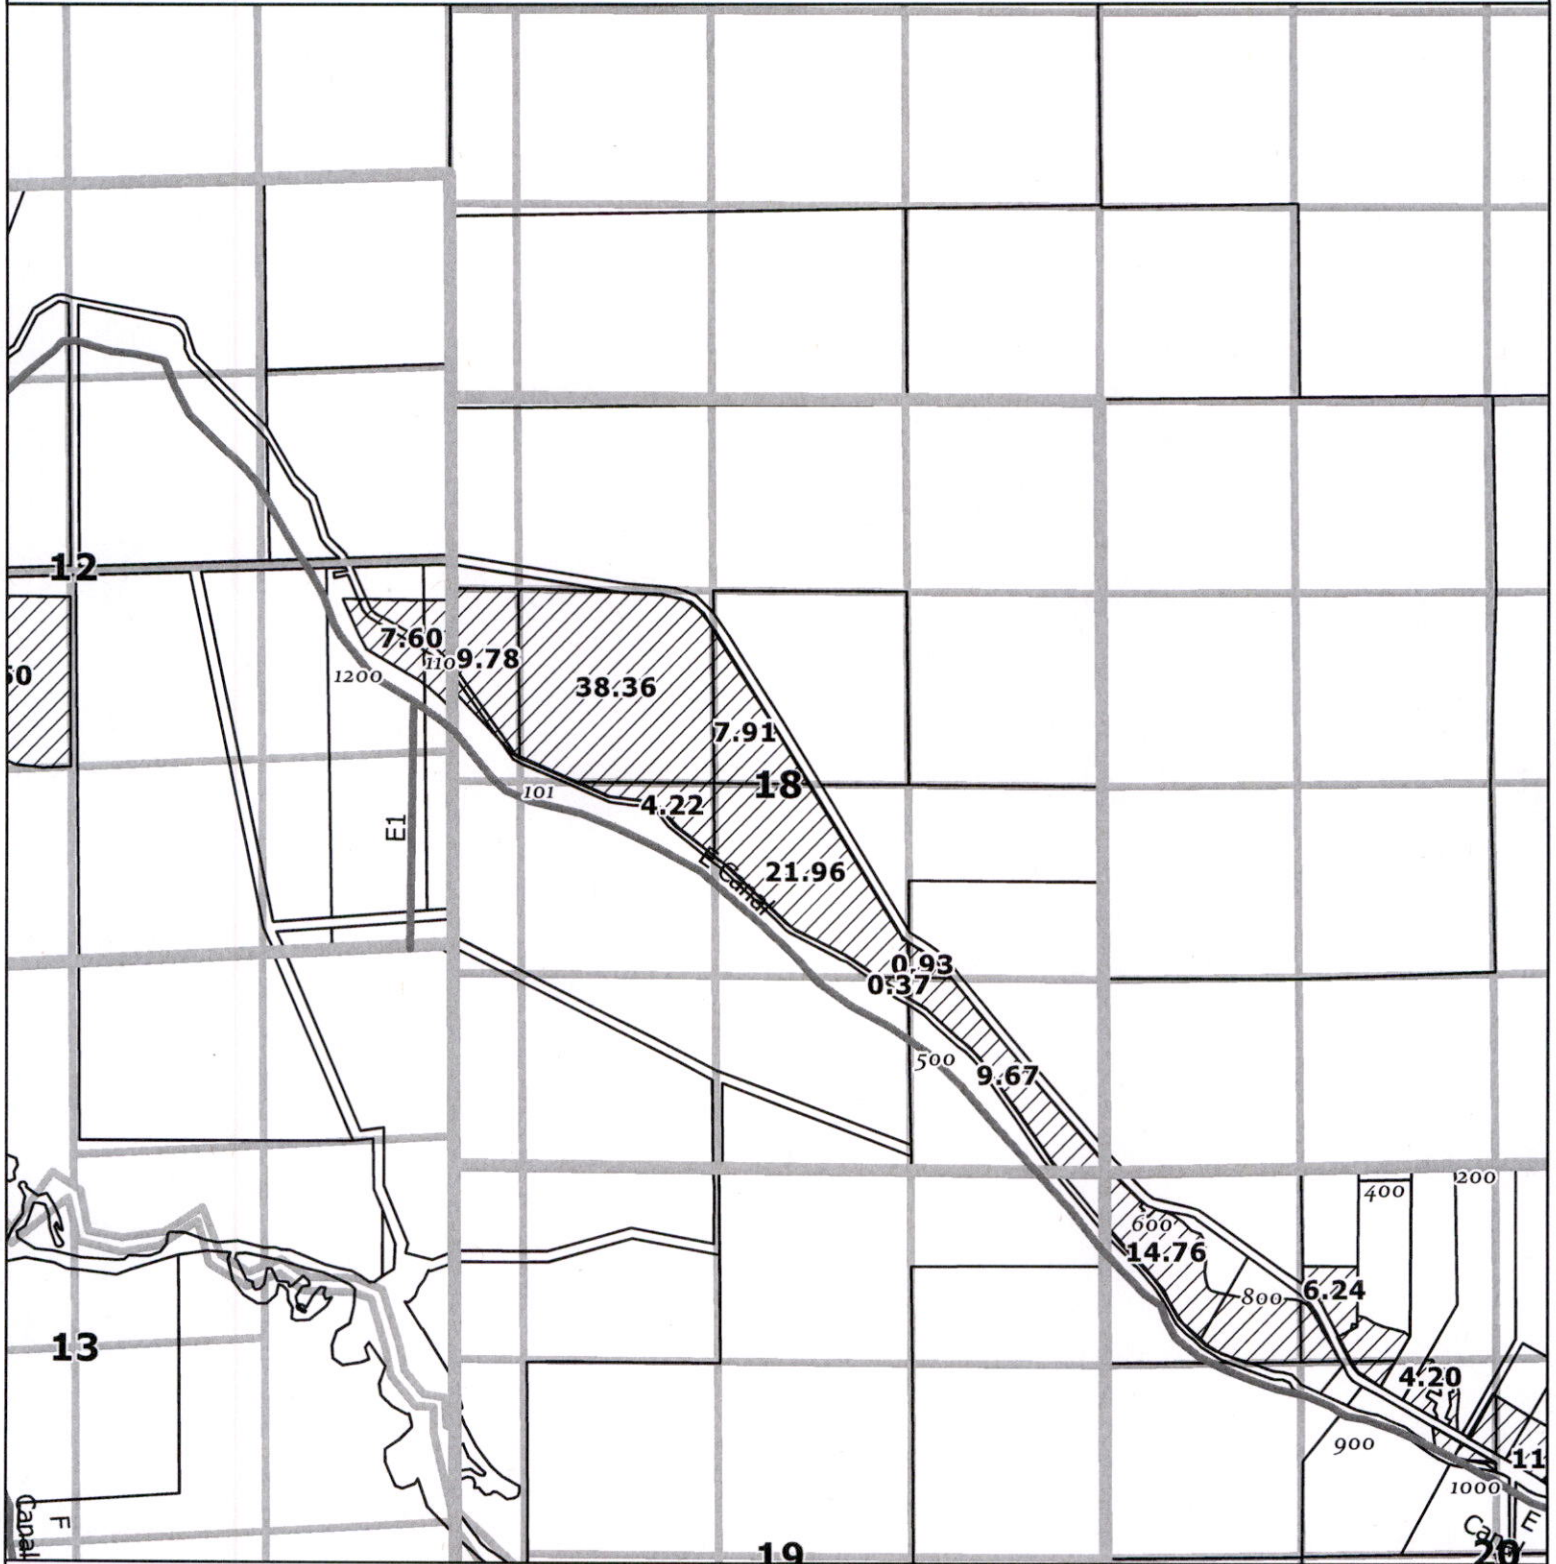


- Place of Use
- Klamath County Taxlot
- QQ Sections and Gov't Lots
- Map Series Sections
- Canal

Received
JUL 07 2025
OWRD

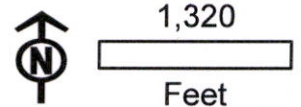

DISCLAIMER
This map is not intended to
provide legal dimensions or
locations of property
ownership lines


WATERSOLVING
johnw@watersolving.com

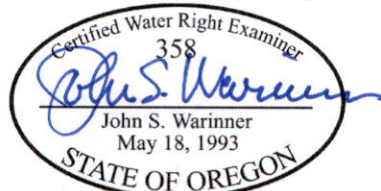

CLAIM OF BENEFICIAL USE MAP
APPLICATION G-16030
PERMIT G-18797
06/23/2025

Map No. 24


T S R S
39 S 10 E 21

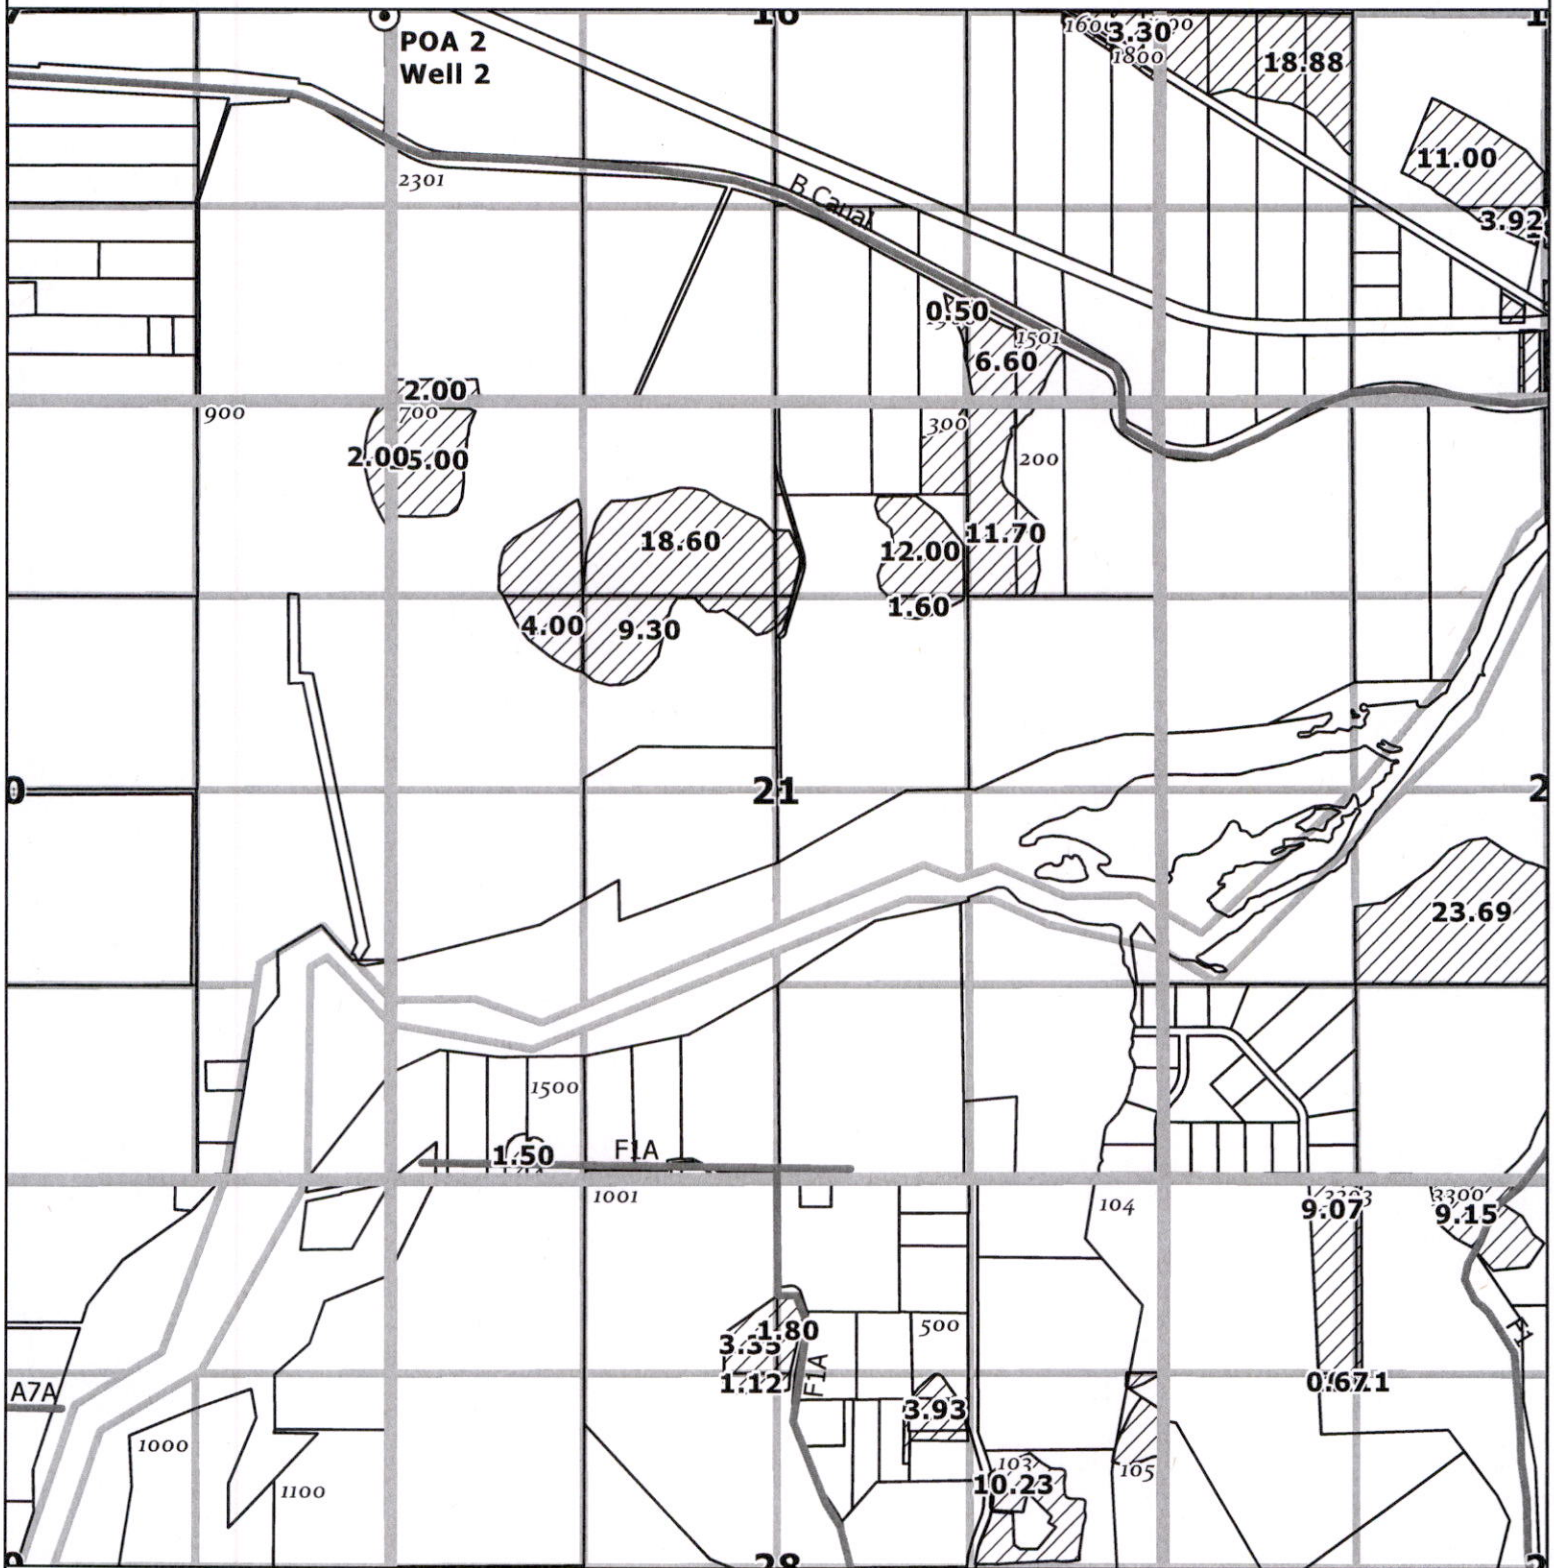

-  Place of Use
-  Klamath County Taxlot
-  QQ Sections and Gov't Lots
-  Map Series Sections
-  Canal


Received
JUL 07 2025

OWRD

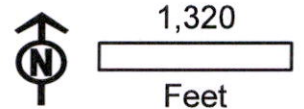

DISCLAIMER
This map is not intended to
provide legal dimensions or
locations of property
ownership lines


WATERSOLVING
johnw@watersolving.com

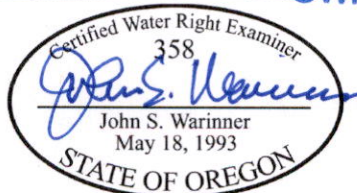

CLAIM OF BENEFICIAL USE MAP
APPLICATION G-16030
PERMIT G-18797
06/23/2025


Map No. 35

T S 39 R 11 S 19 E

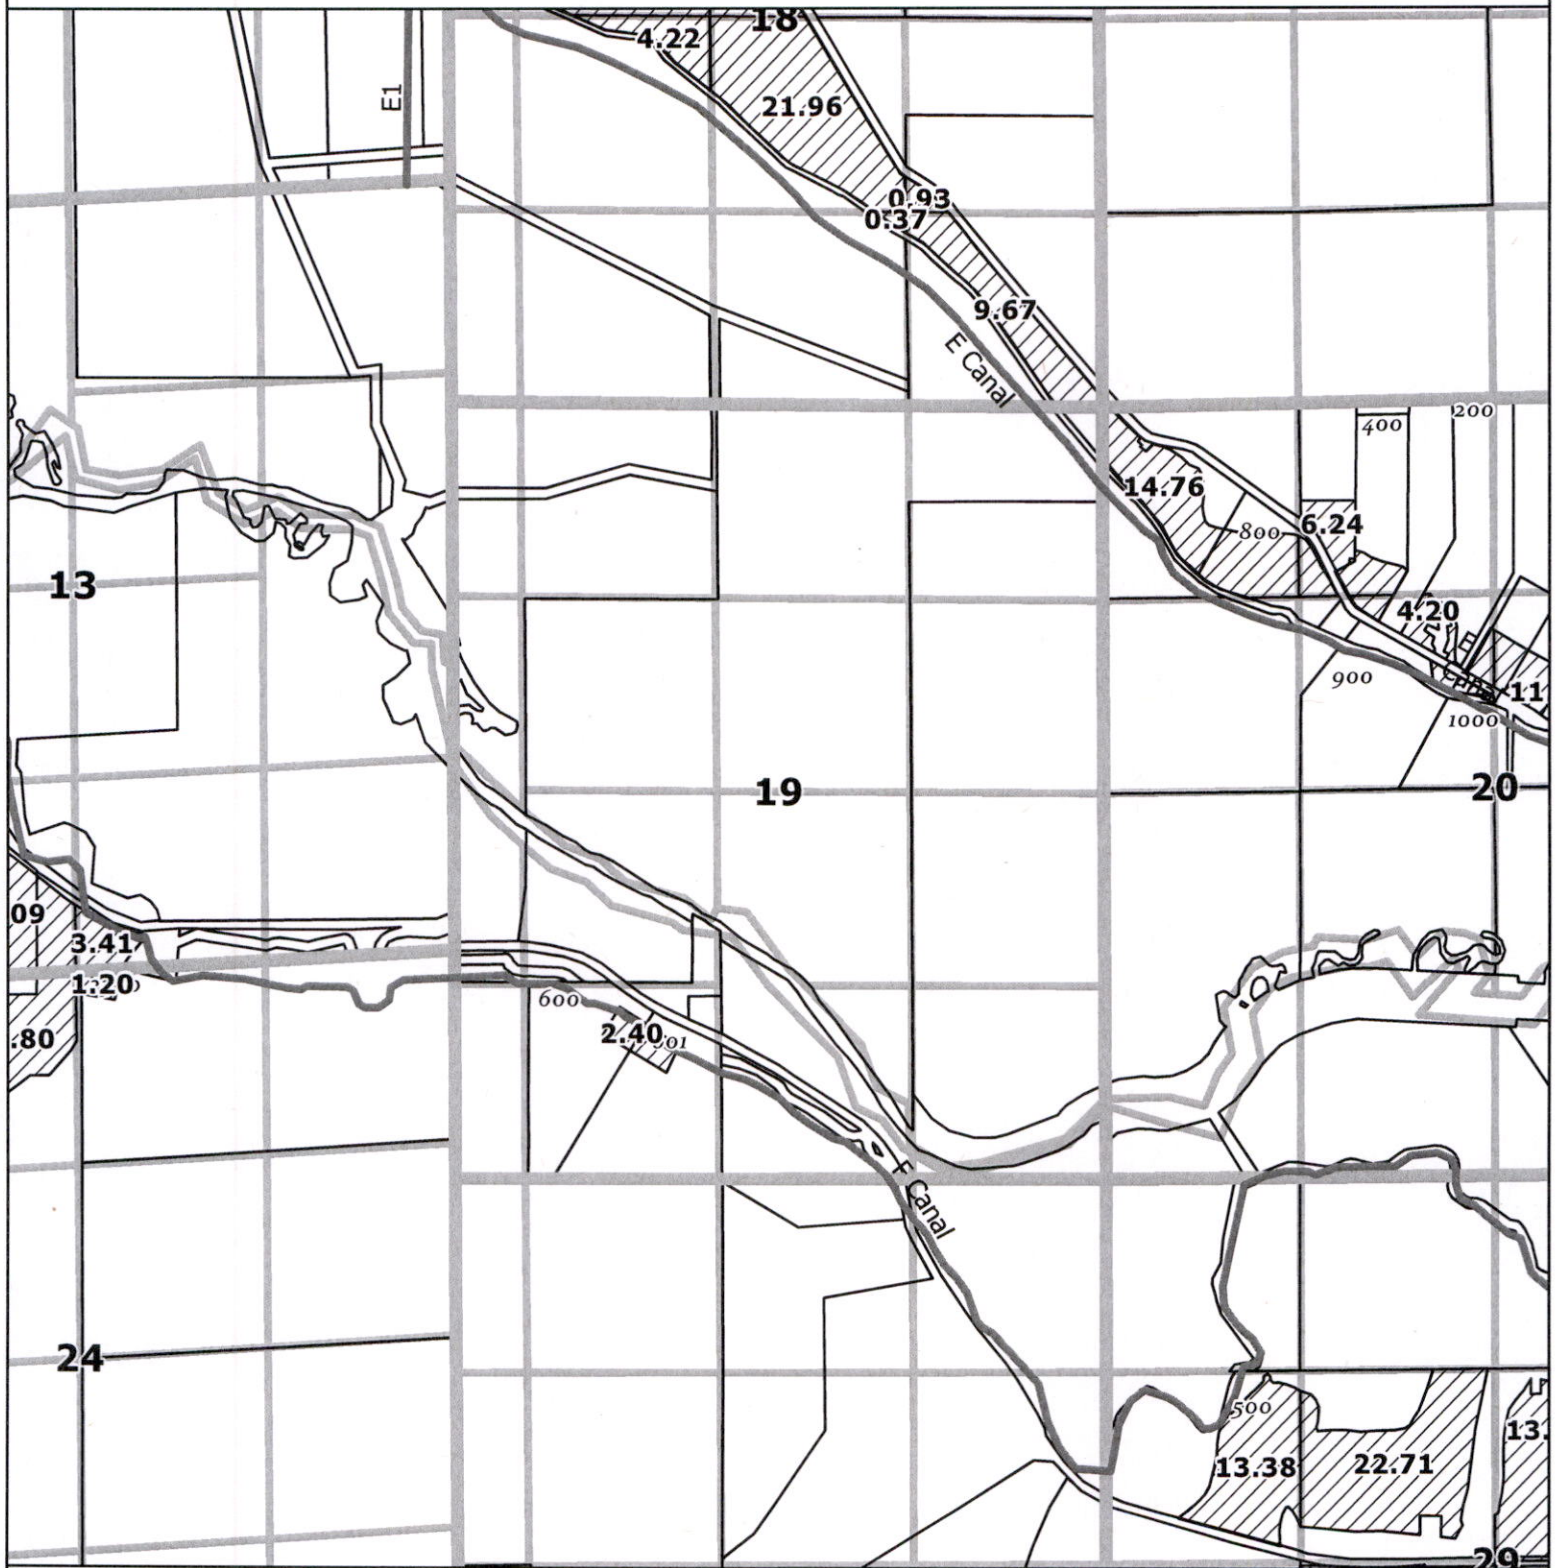


- Place of Use
- Klamath County Taxlot
- QQ Sections and Gov't Lots
- Map Series Sections
- Canal

Received
JUL 07 2025
OWRD

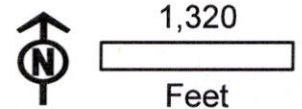

DISCLAIMER
This map is not intended to
provide legal dimensions or
locations of property
ownership lines


WATERSOLVING
johnw@watersolving.com

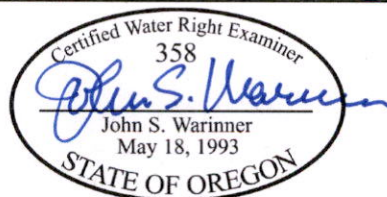

CLAIM OF BENEFICIAL USE MAP
APPLICATION G-16030
PERMIT G-18797
06/23/2025

Map No. 36

T 39 S 11 E S 20

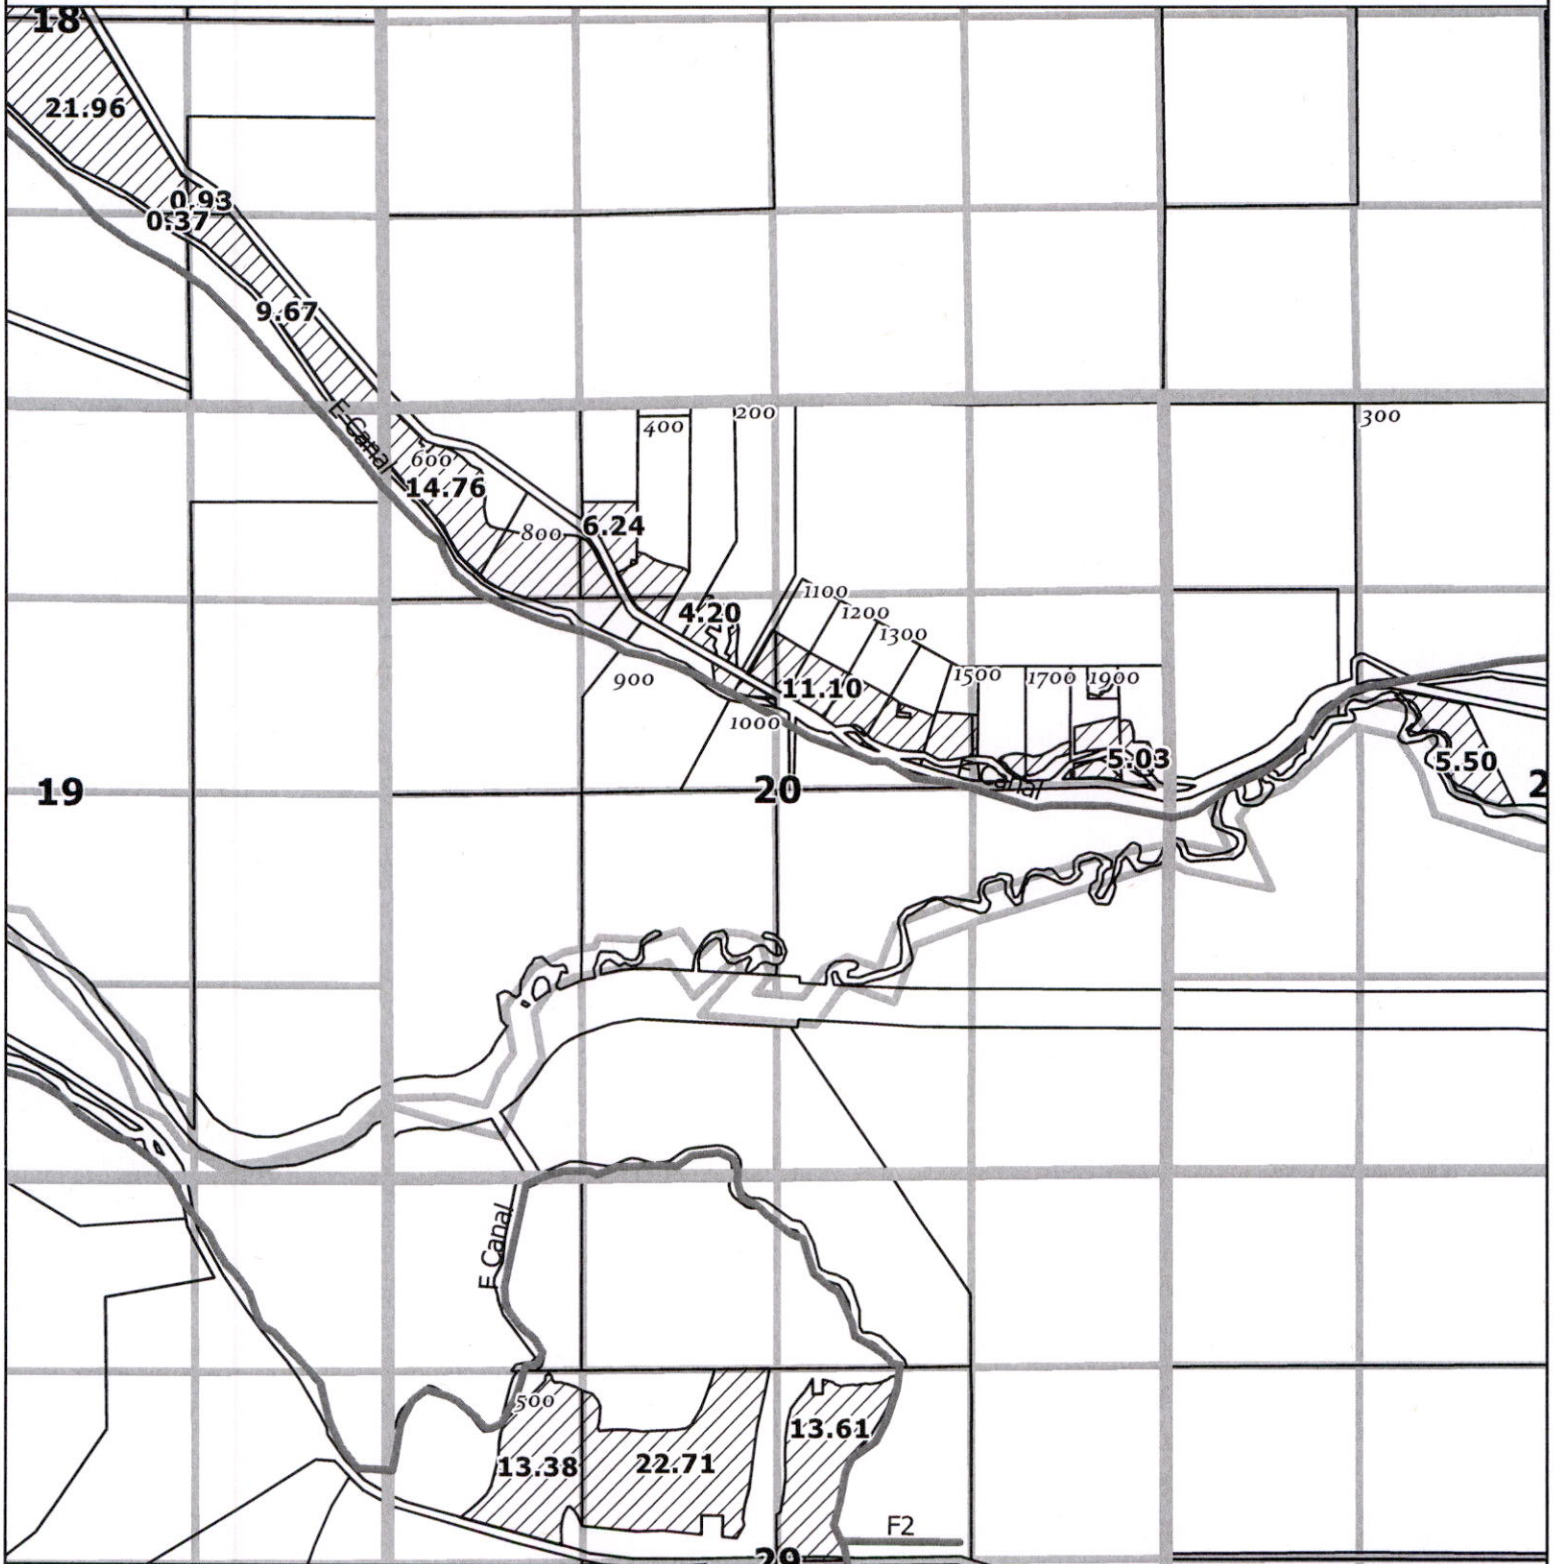

- Place of Use
- Klamath County Taxlot
- QQ Sections and Gov't Lots
- Map Series Sections
- Canal

Received
JUL 07 2025


OWRD



1,320
Feet

DISCLAIMER
This map is not intended to
provide legal dimensions or
locations of property
ownership lines


WATERSOLVING
johnw@watersolving.com

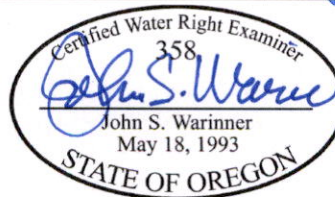

CLAIM OF BENEFICIAL USE MAP
APPLICATION G-16030
PERMIT G-18797
06/23/2025

Map No. 37

T 39 S 11 R E S 21

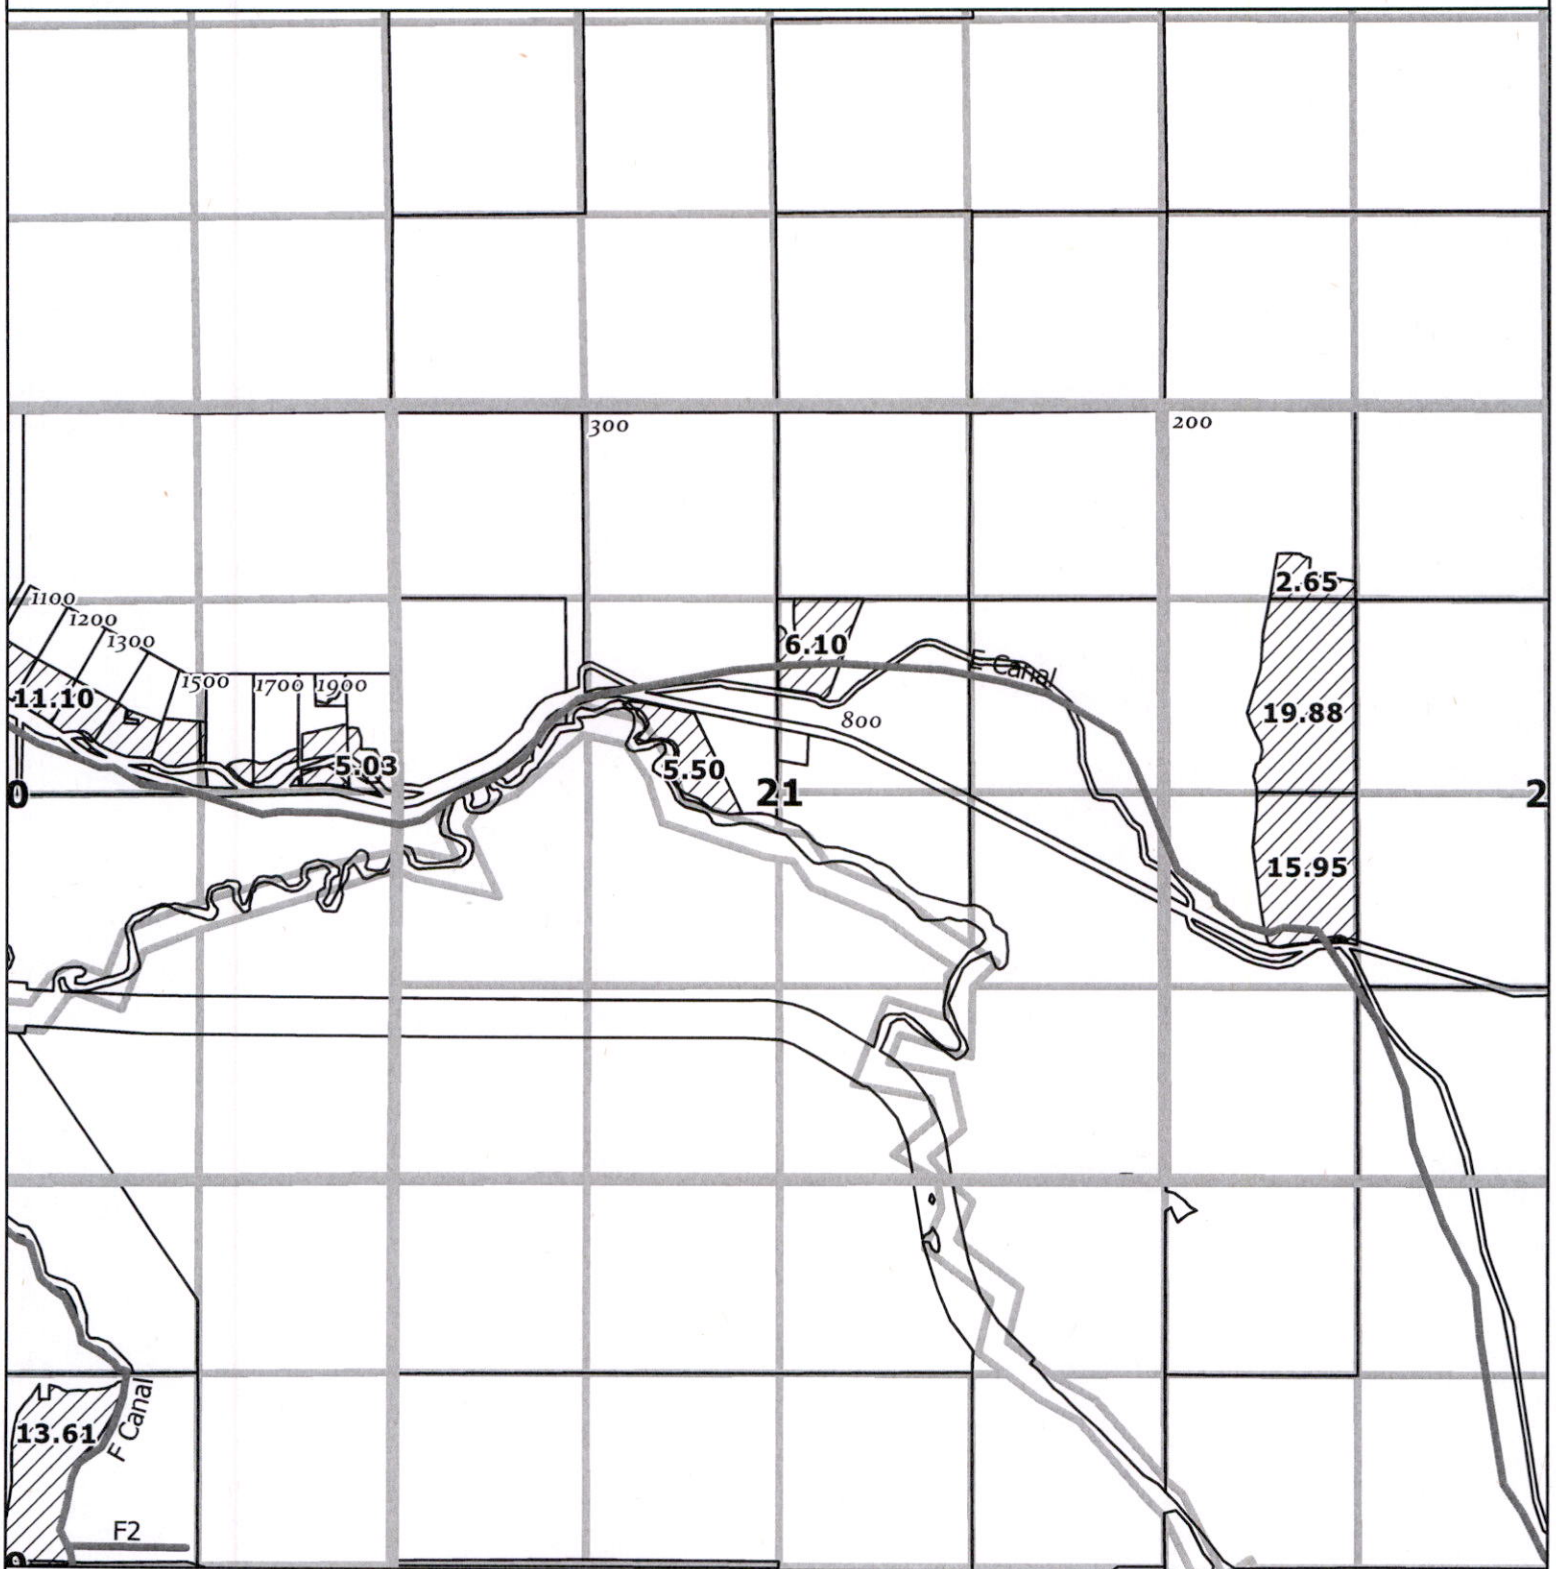

- Place of Use
- Klamath County Taxlot
- QQ Sections and Gov't Lots
- Map Series Sections
- Canal

Received

JUL 07 2025

OWRD




1,320

Feet

DISCLAIMER
This map is not intended to
provide legal dimensions or
locations of property
ownership lines


WATERSOLVING
johnw@watersolving.com

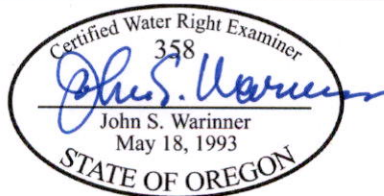

CLAIM OF BENEFICIAL USE MAP
APPLICATION G-16030
PERMIT G-18797
06/23/2025


Map No. 38

T 39 S 11 E S 22

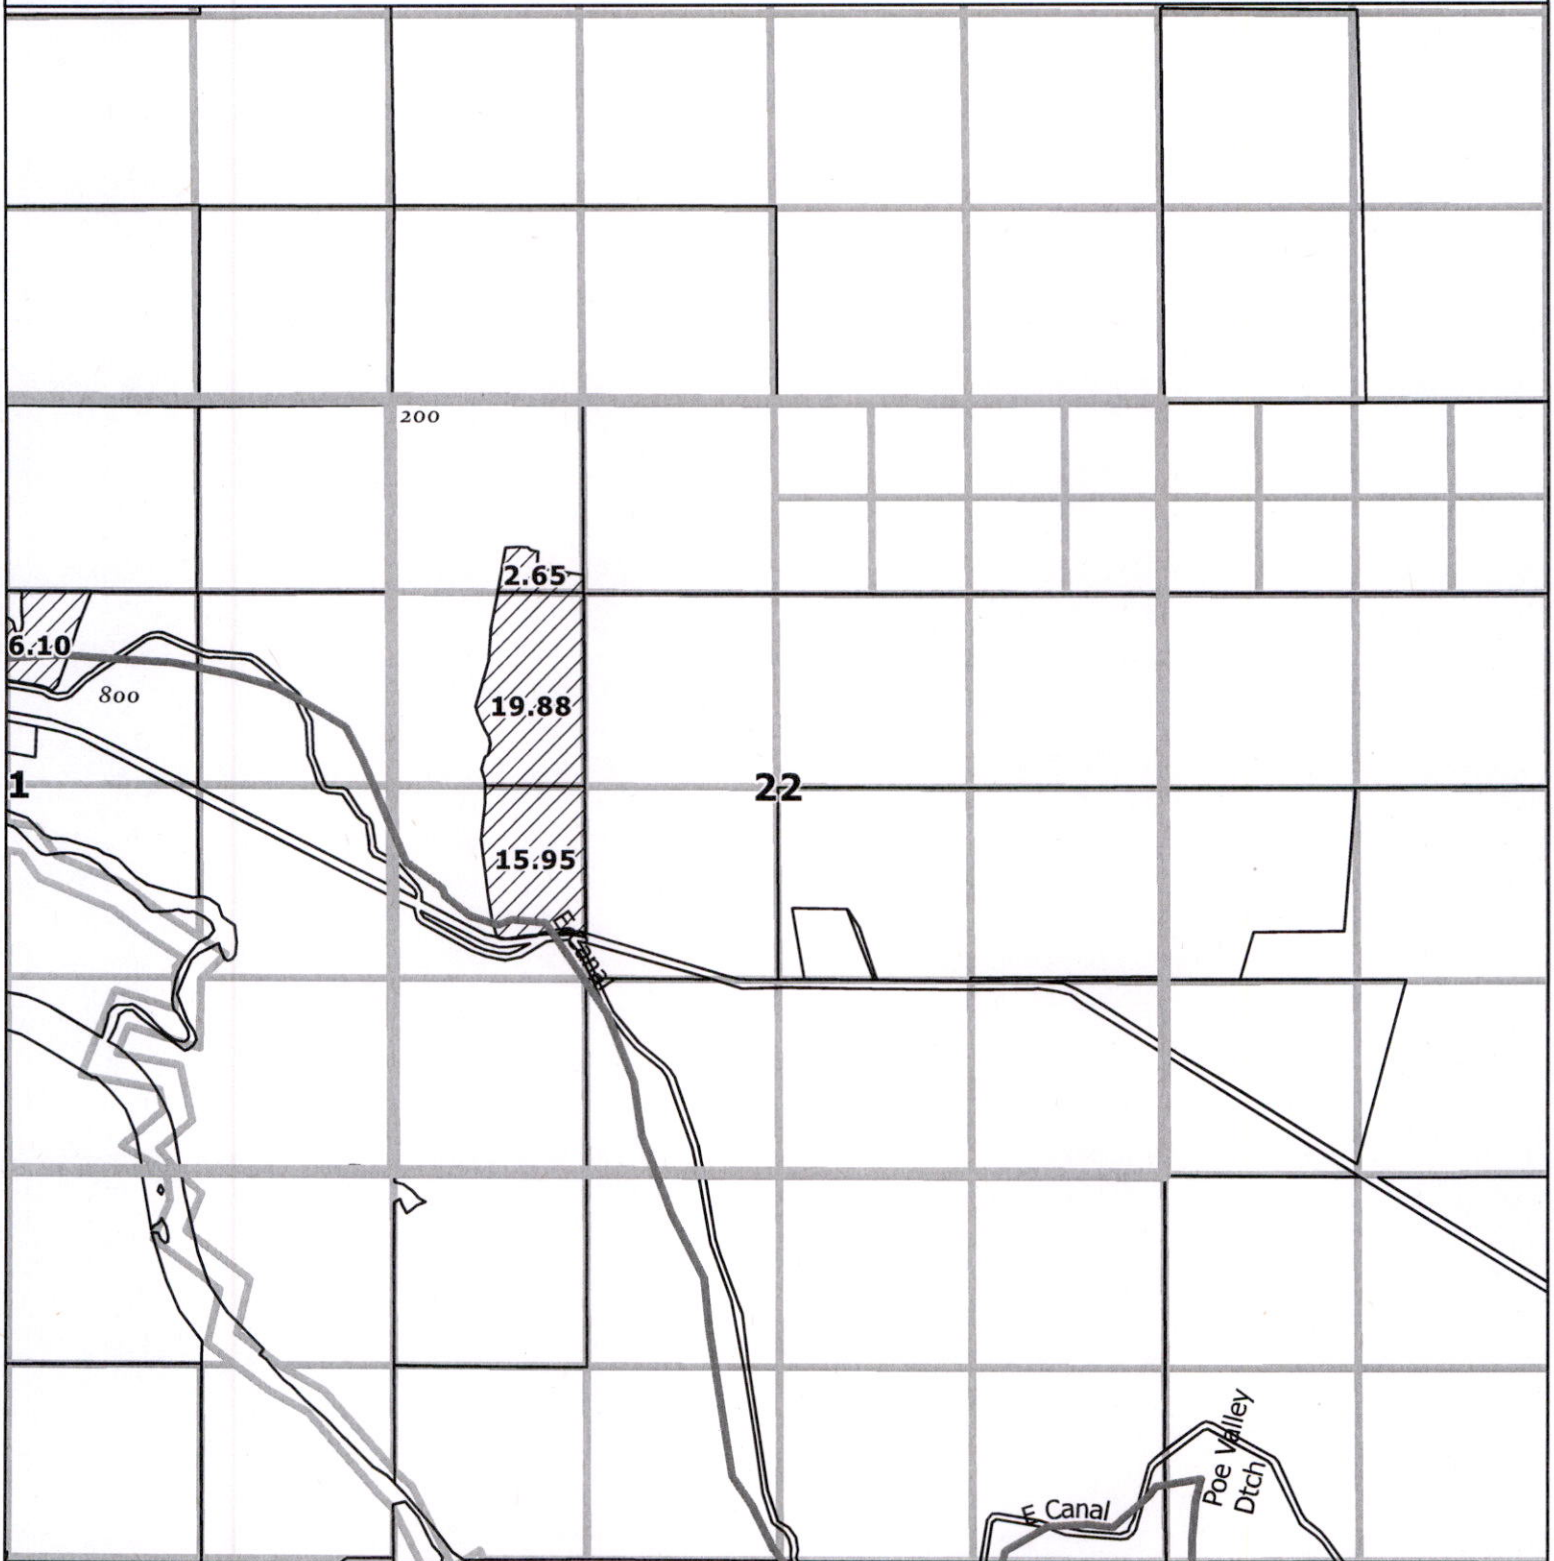


- Place of Use
- Klamath County Taxlot
- QQ Sections and Gov't Lots
- Map Series Sections
- Canal

Received
JUL 07 2025
OWRD

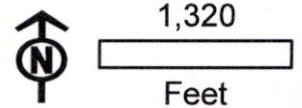

DISCLAIMER
This map is not intended to
provide legal dimensions or
locations of property
ownership lines


WATERSOLVING
johnw@watersolving.com

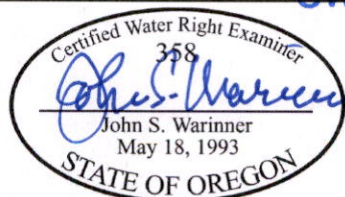

CLAIM OF BENEFICIAL USE MAP
APPLICATION G-16030
PERMIT G-18797
06/23/2025


Map No. 39

T 39 S 11 E S 29

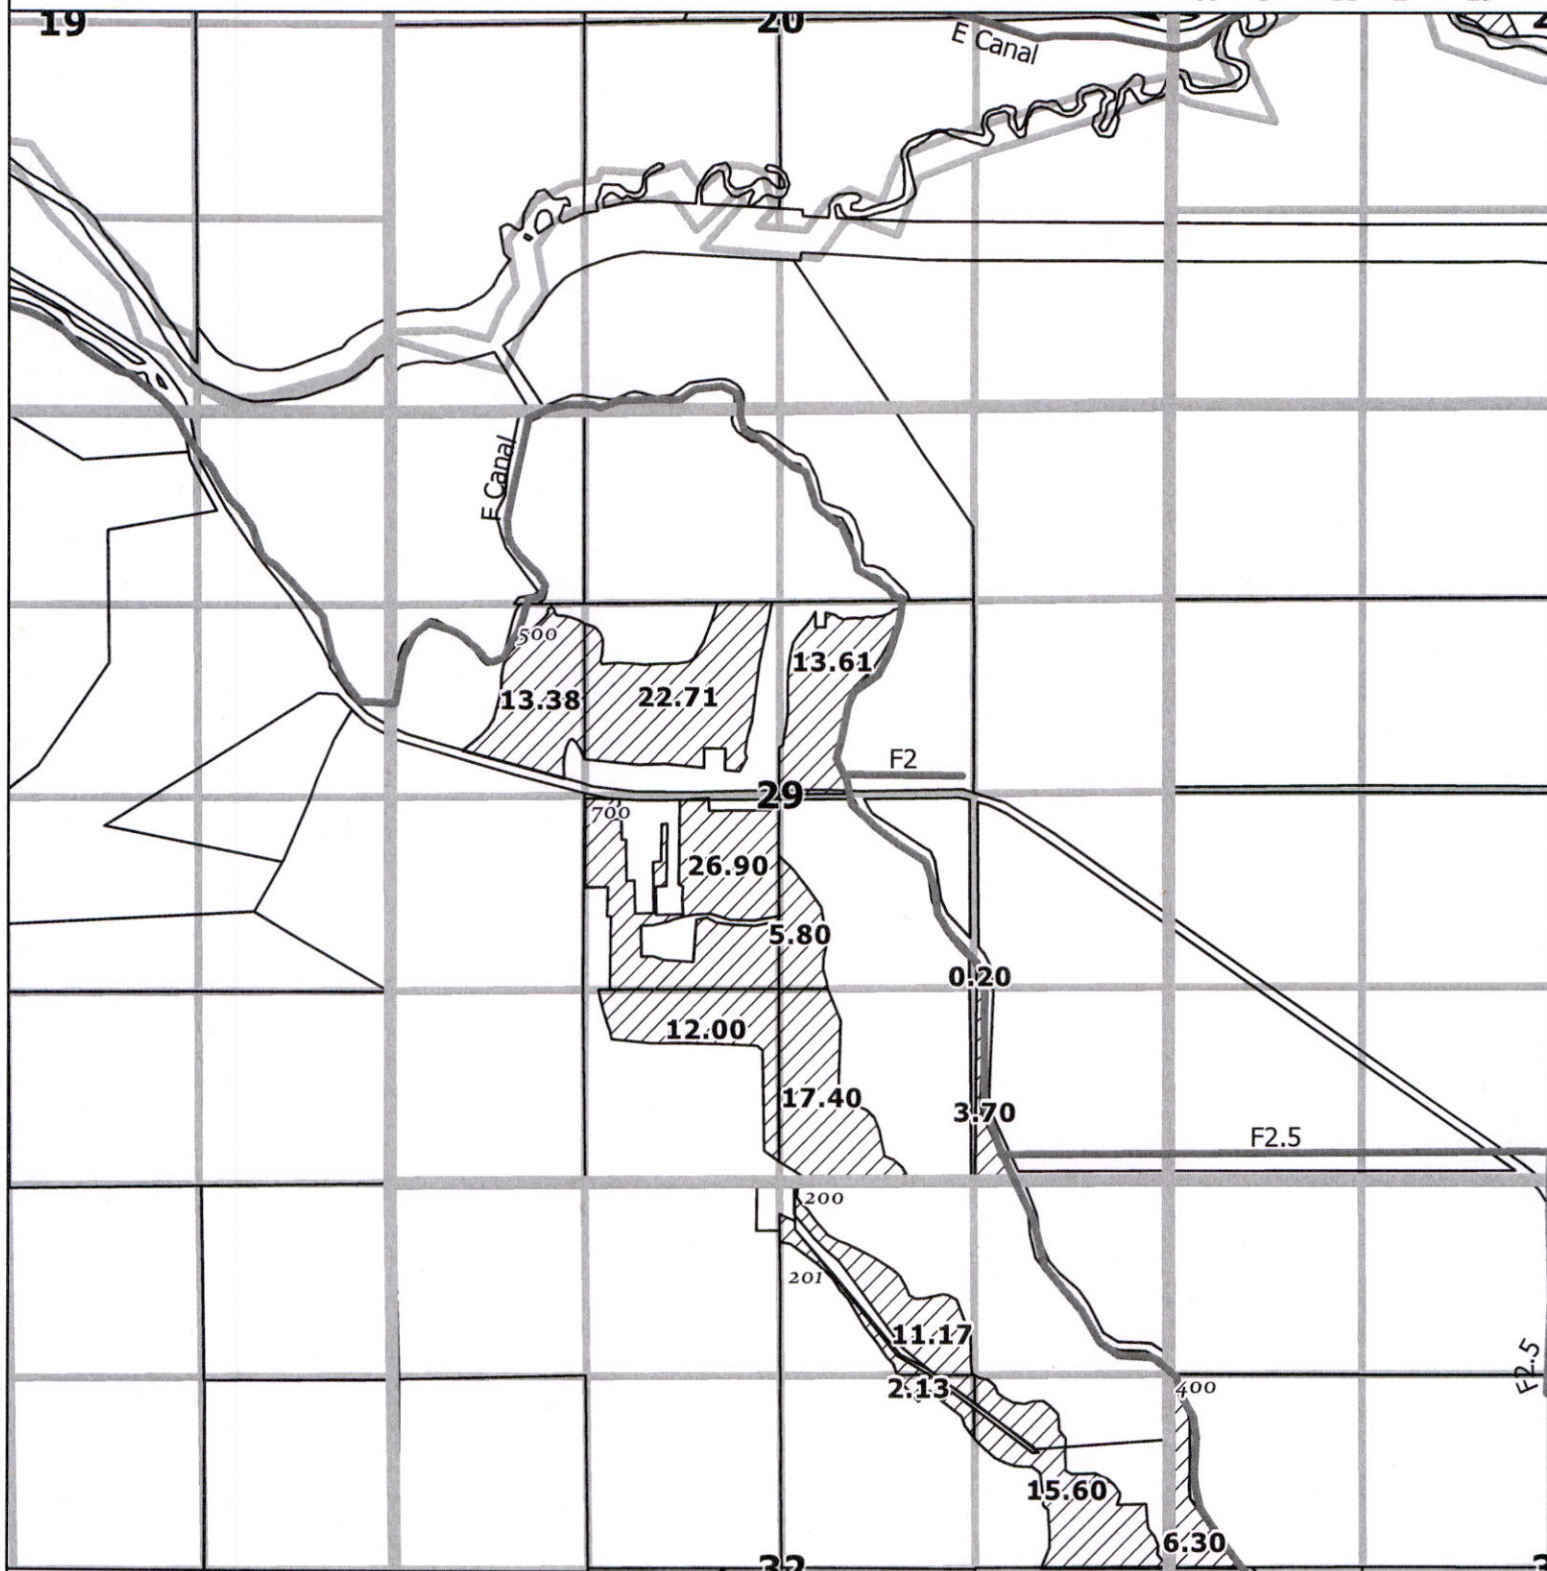

- Place of Use
- Klamath County Taxlot
- QQ Sections and Gov't Lots
- Map Series Sections
- Canal


Received
JUL 07 2025

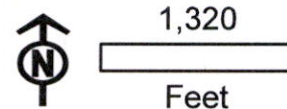

OWRD

DISCLAIMER
This map is not intended to provide legal dimensions or locations of property ownership lines


WATERSOLVING
johnw@watersolving.com

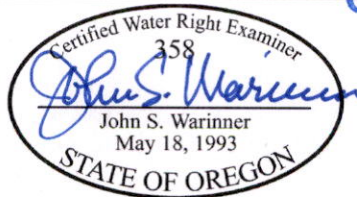

CLAIM OF BENEFICIAL USE MAP
APPLICATION G-16030
PERMIT G-18797
06/23/2025


Map No. 40

T S 39 R 11 S 32 E

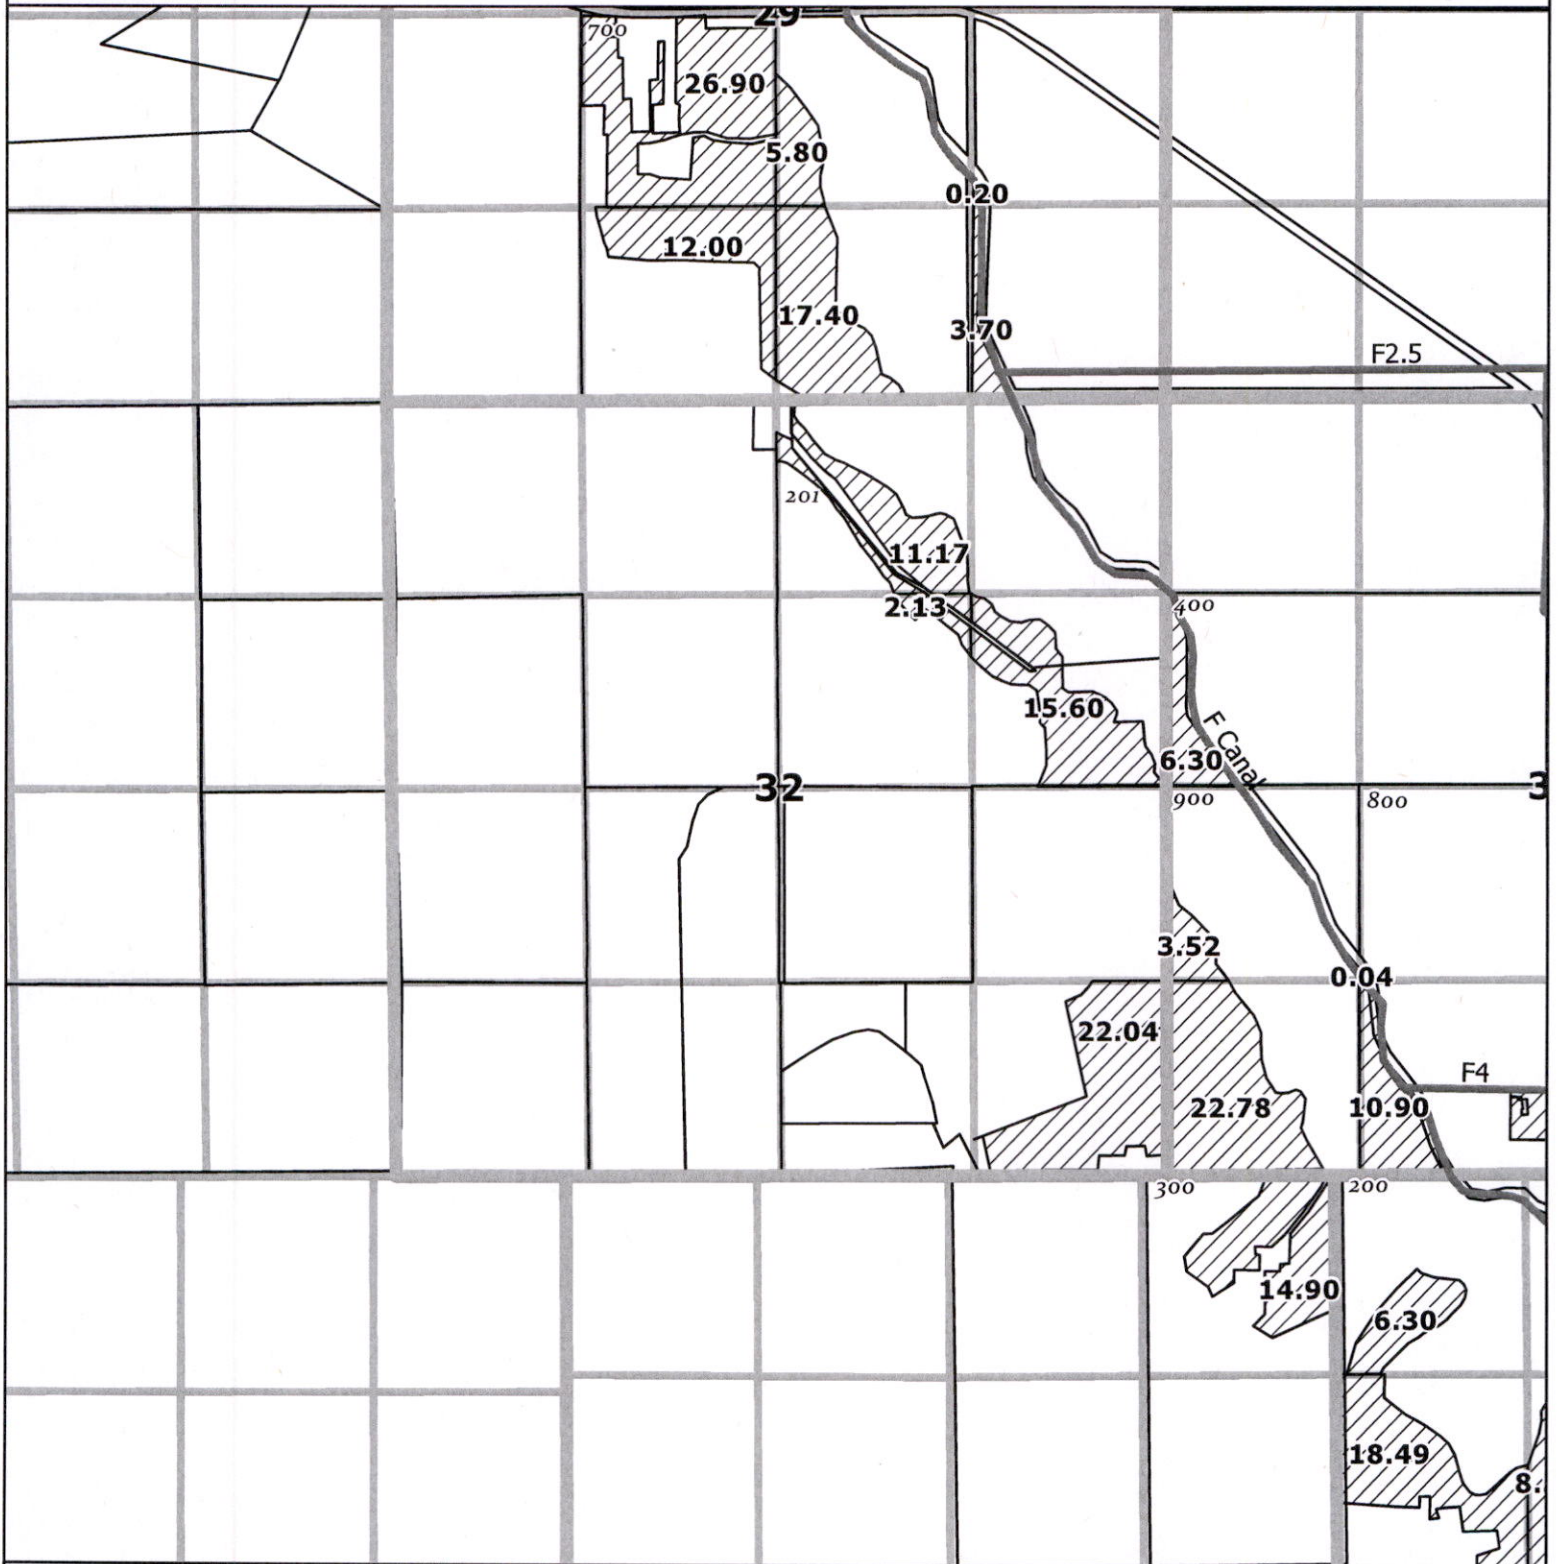


- Place of Use
- Klamath County Taxlot
- QQ Sections and Gov't Lots
- Map Series Sections
- Canal

Received
JUL 07 2025
OWRD

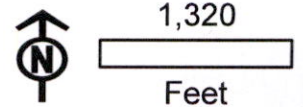

DISCLAIMER
This map is not intended to
provide legal dimensions or
locations of property
ownership lines


WATERSOLVING
johnw@watersolving.com

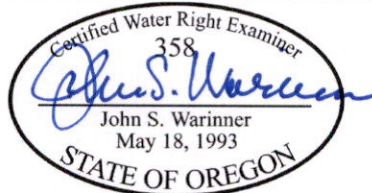

CLAIM OF BENEFICIAL USE MAP
APPLICATION G-16030
PERMIT G-18797
06/23/2025

Map No. 41


T 39 S 11 E S 33

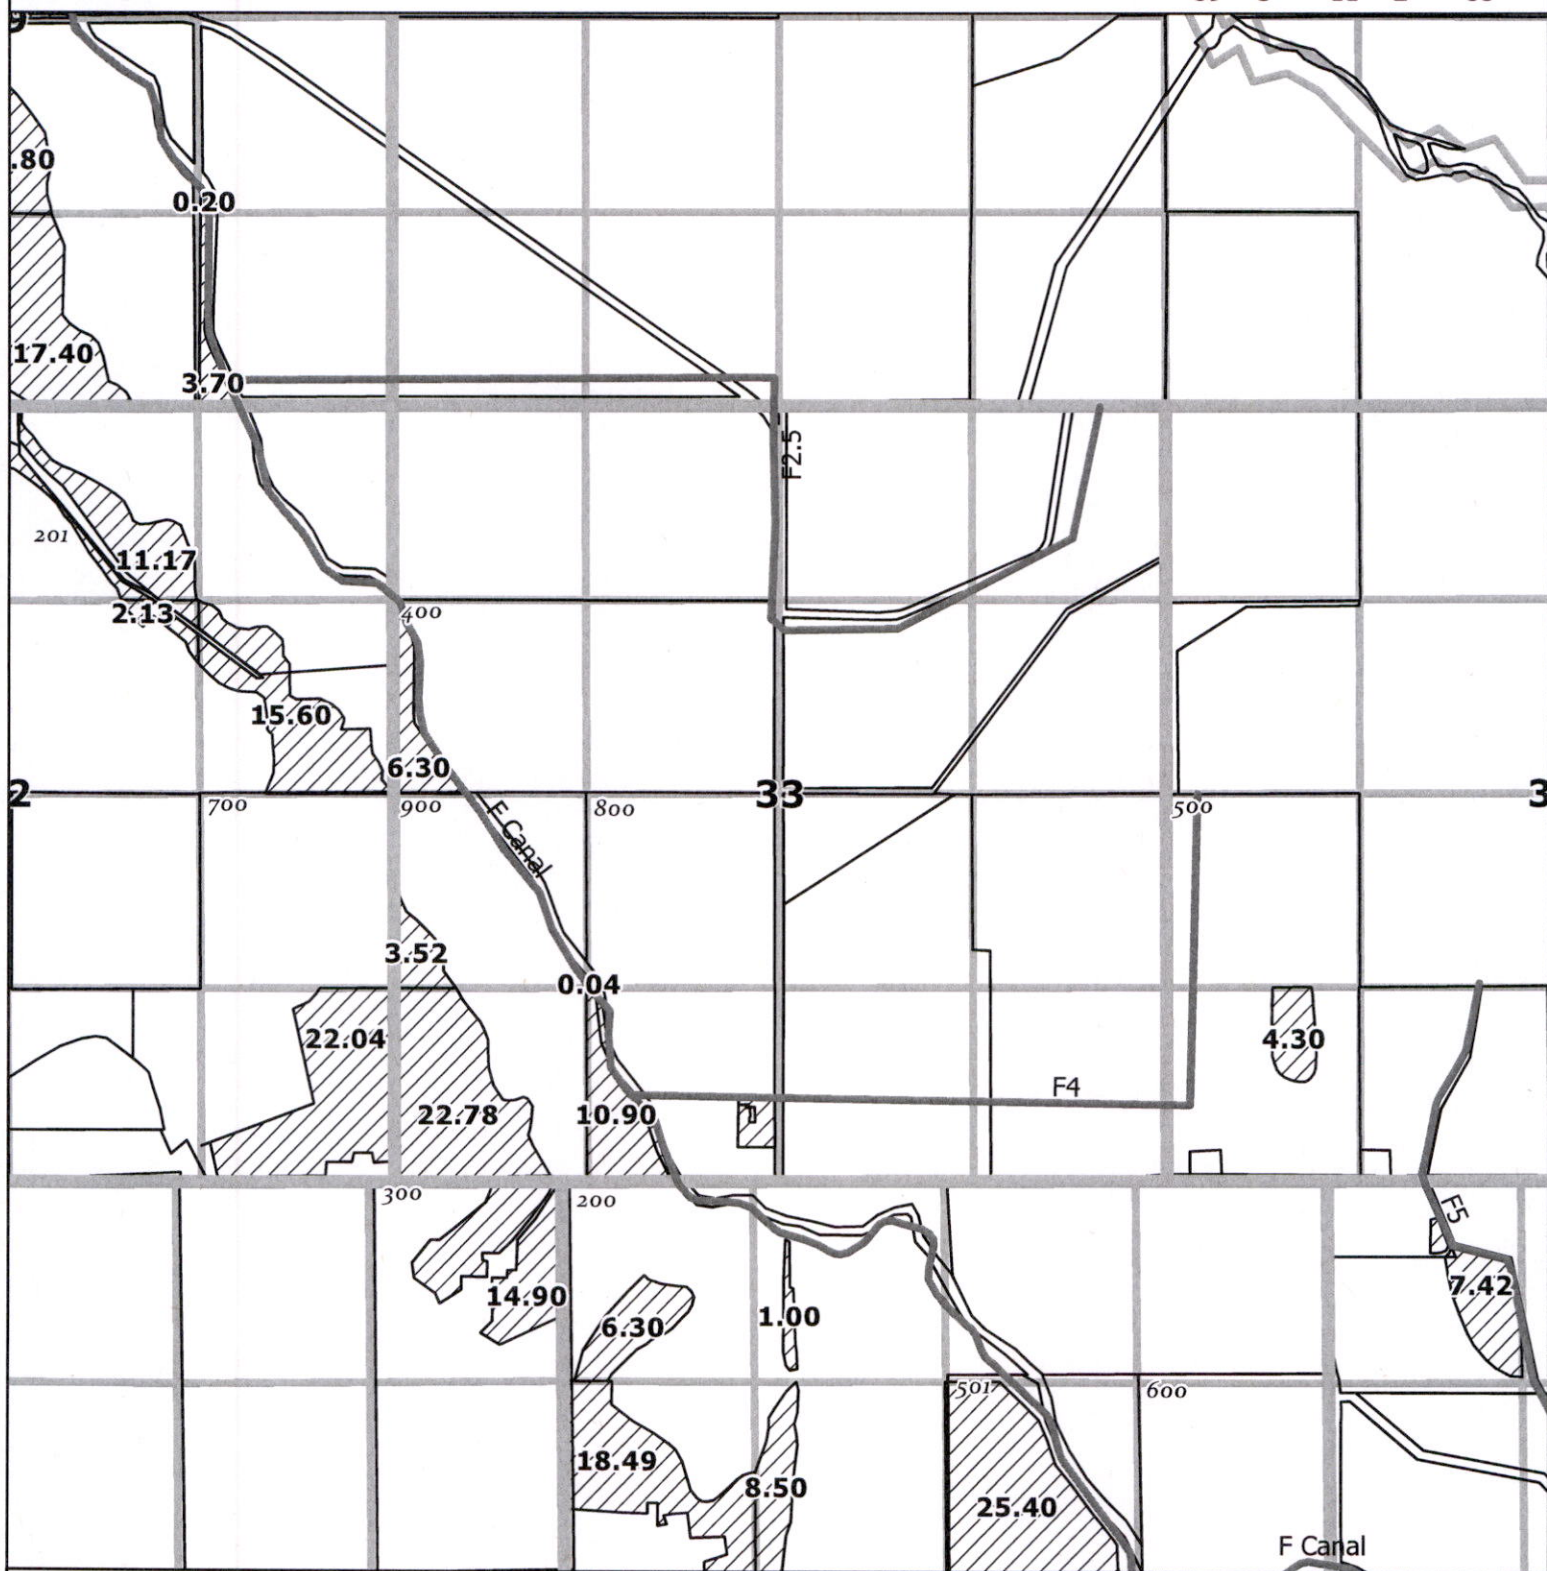

- Place of Use
- Klamath County Taxlot
- QQ Sections and Gov't Lots
- Map Series Sections
- Canal


Received
JUL 07 2025

OWRD

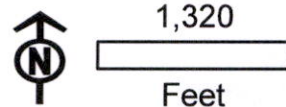

DISCLAIMER
This map is not intended to
provide legal dimensions or
locations of property
ownership lines


WATERSOLVING
johnw@watersolving.com

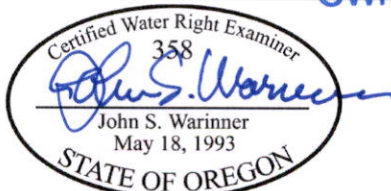

CLAIM OF BENEFICIAL USE MAP
APPLICATION G-16030
PERMIT G-18797
06/23/2025

Map No. 42

T 39 S 11 E S 34

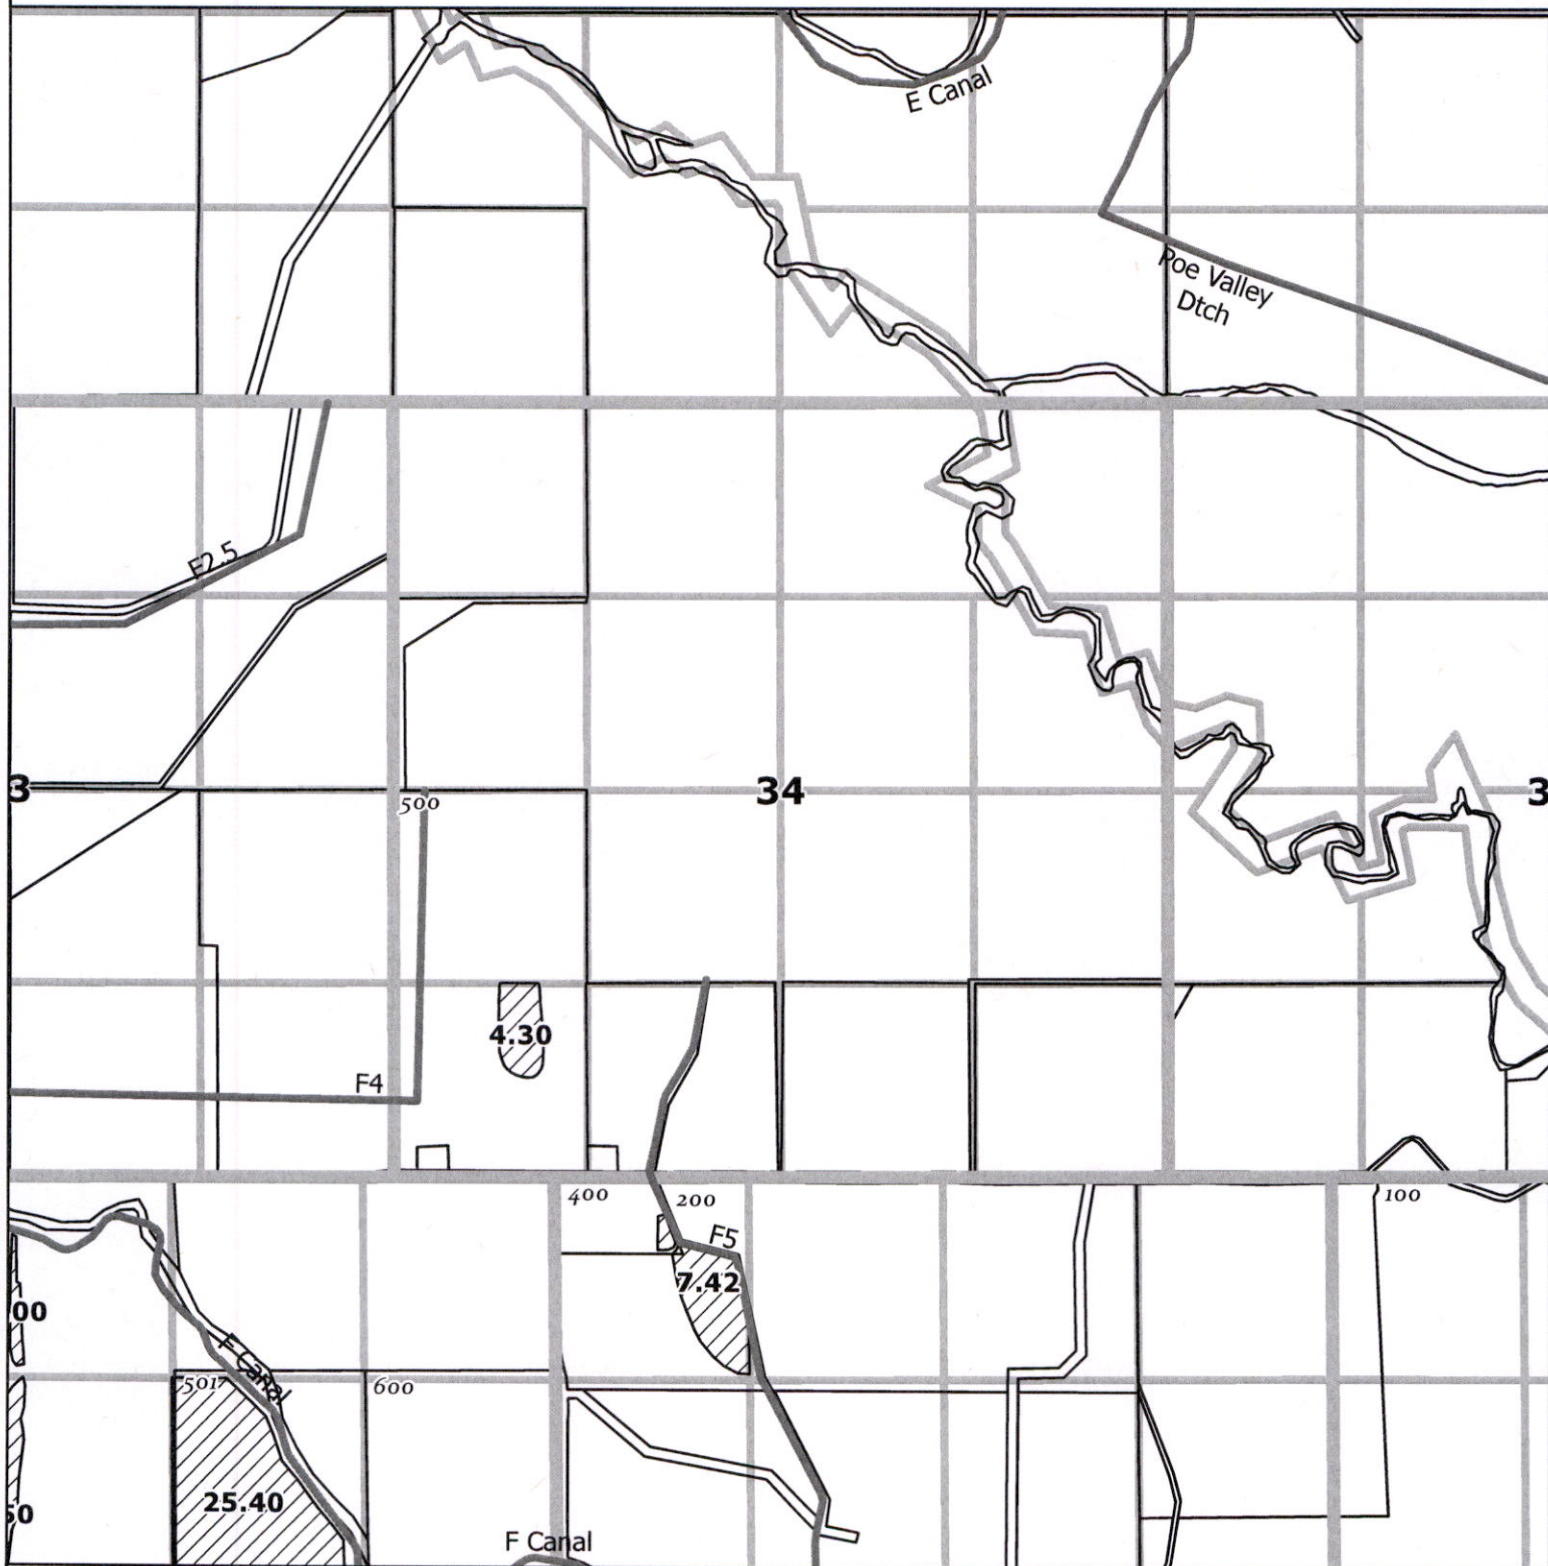

- Place of Use
- Klamath County Taxlot
- QQ Sections and Gov't Lots
- Map Series Sections
- Canal

Received

JUL 07 2025

OWRD




1,320
Feet

DISCLAIMER

This map is not intended to provide legal dimensions or locations of property ownership lines


WATERSOLVING
johnw@watersolving.com

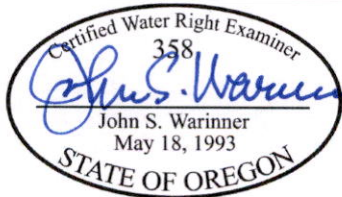

CLAIM OF BENEFICIAL USE MAP
APPLICATION G-16030
PERMIT G-18797
06/23/2025


Map No. 43

T 39 S R 11 E S 35

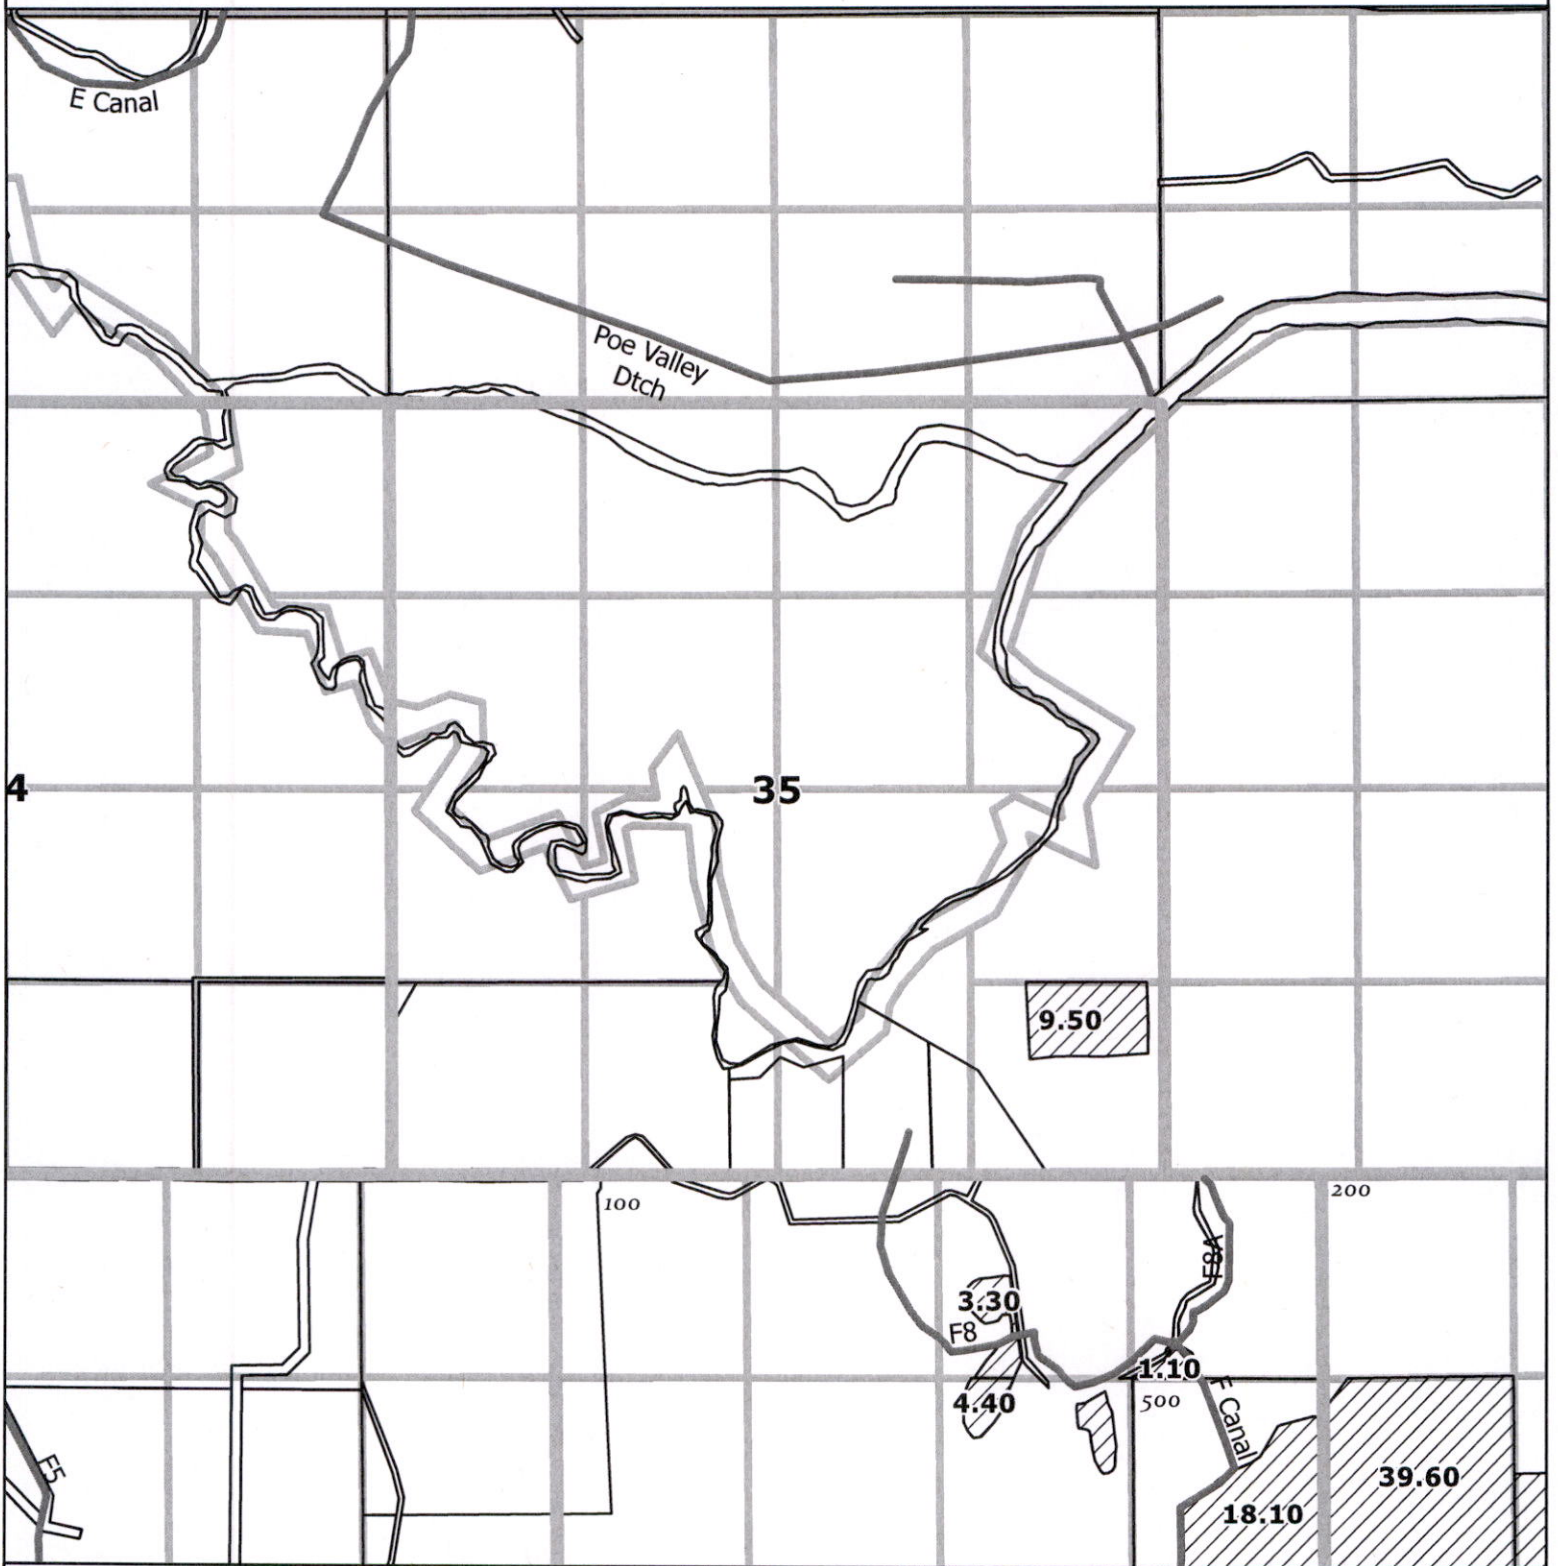


- Place of Use
- Klamath County Taxlot
- QQ Sections and Gov't Lots
- Map Series Sections
- Canal

Received
JUL 07 2025
OWRD

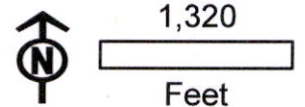

DISCLAIMER
This map is not intended to
provide legal dimensions or
locations of property
ownership lines


WATERSOLVING
johnw@watersolving.com

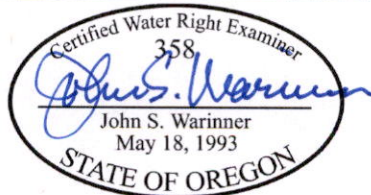

CLAIM OF BENEFICIAL USE MAP
APPLICATION G-16030
PERMIT G-18797
06/23/2025

Map No. 44

T S R S
40 9 01

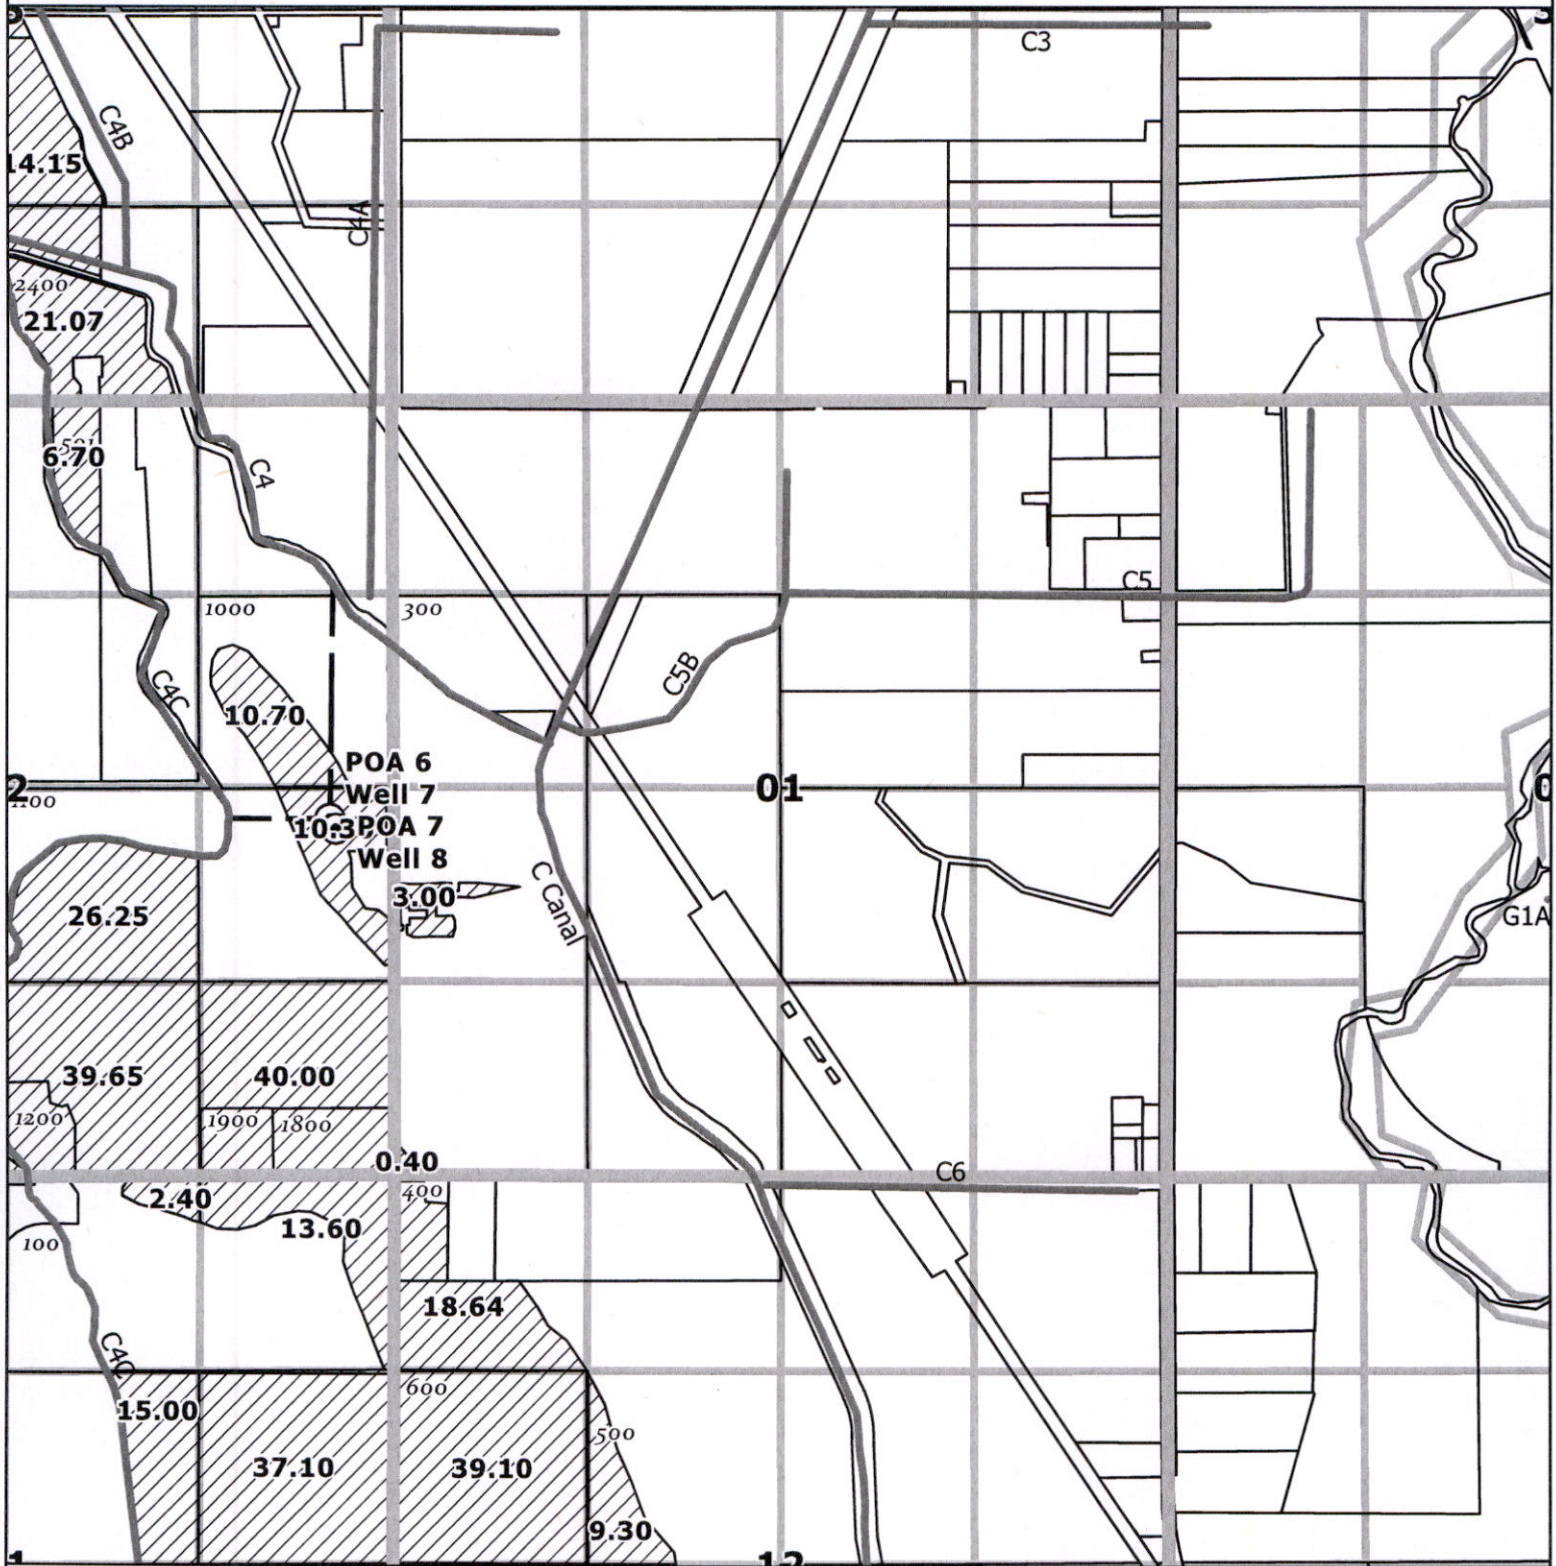

- Place of Use
- Klamath County Taxlot
- QQ Sections and Gov't Lots
- Map Series Sections
- Canal

Received

JUL 07 2025

OWRD




1,320

Feet

DISCLAIMER

This map is not intended to provide legal dimensions or locations of property ownership lines


WATERSOLVING
johnw@watersolving.com

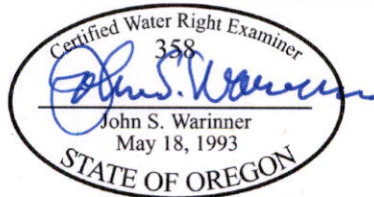

CLAIM OF BENEFICIAL USE MAP
APPLICATION G-16030
PERMIT G-18797
06/23/2025


Map No. 45

T S 9 E 02

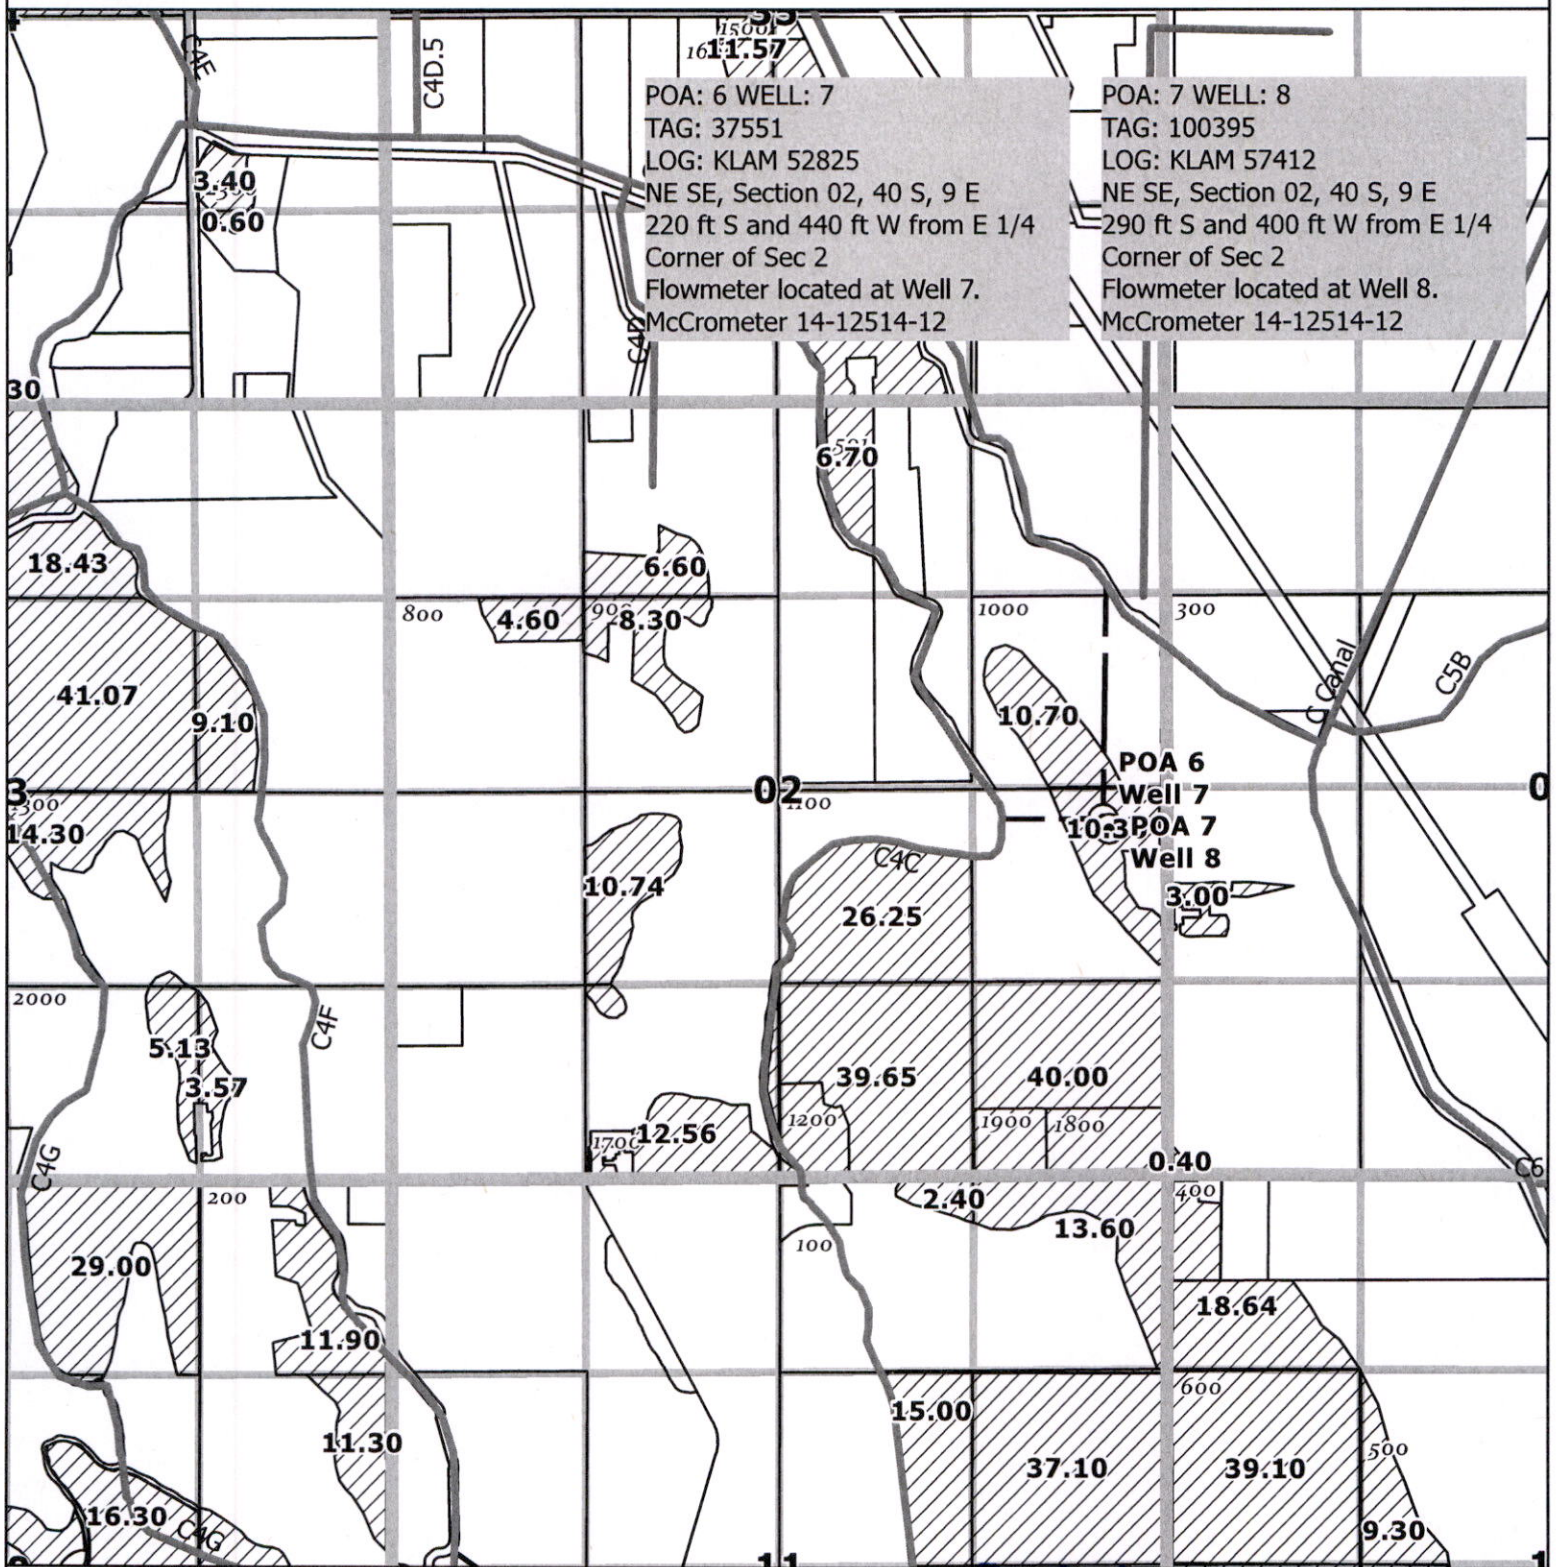


- Place of Use
- Map Series Sections
- Klamath County Taxlot
- Point of Appropriation
- QQ Sections and Gov't Lots
- Pipelines
- Canal

Received
JUL 07 2025
OWRD

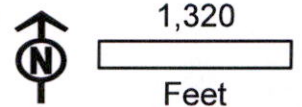

DISCLAIMER
This map is not intended to provide legal dimensions or locations of property ownership lines


WATERSOLVING
johnw@watersolving.com

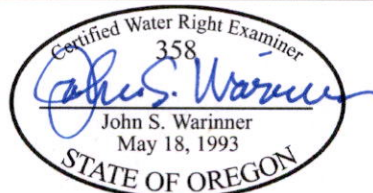

CLAIM OF BENEFICIAL USE MAP
APPLICATION G-16030
PERMIT G-18797
06/23/2025


Map No. 46

T S 9 R E 03

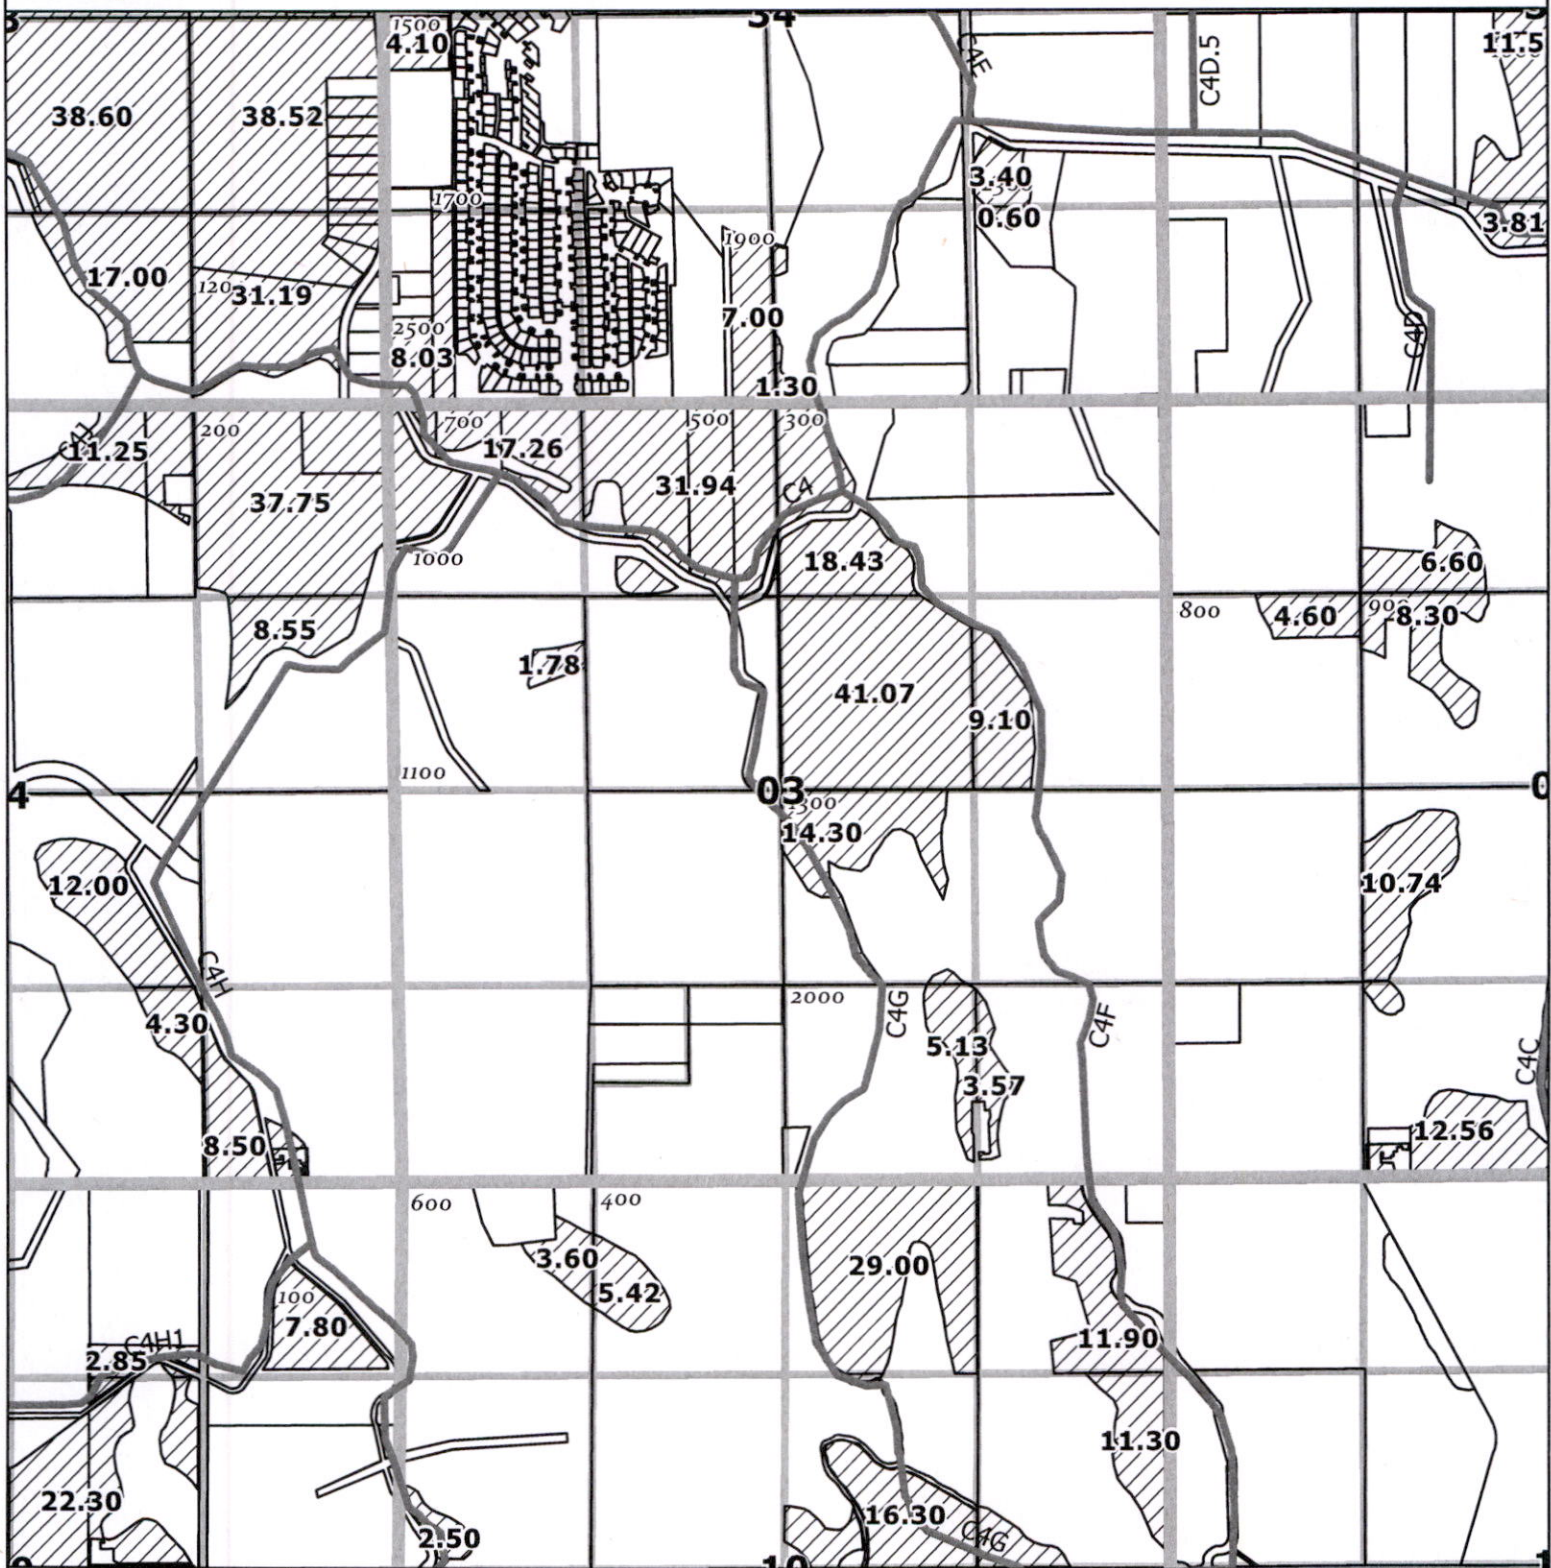

- Place of Use
- Klamath County Taxlot
- QQ Sections and Gov't Lots
- Map Series Sections
- Canal


Received
JUL 07 2025

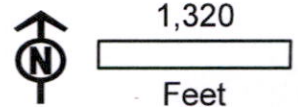

OWRD

DISCLAIMER
This map is not intended to
provide legal dimensions or
locations of property
ownership lines


WATERSOLVING
johnw@watersolving.com

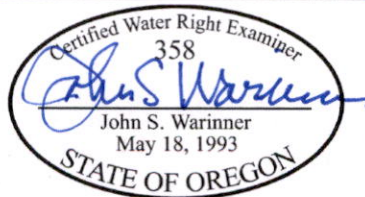

CLAIM OF BENEFICIAL USE MAP
APPLICATION G-16030
PERMIT G-18797
06/23/2025


Map No. 47

T S R S
40 9 04

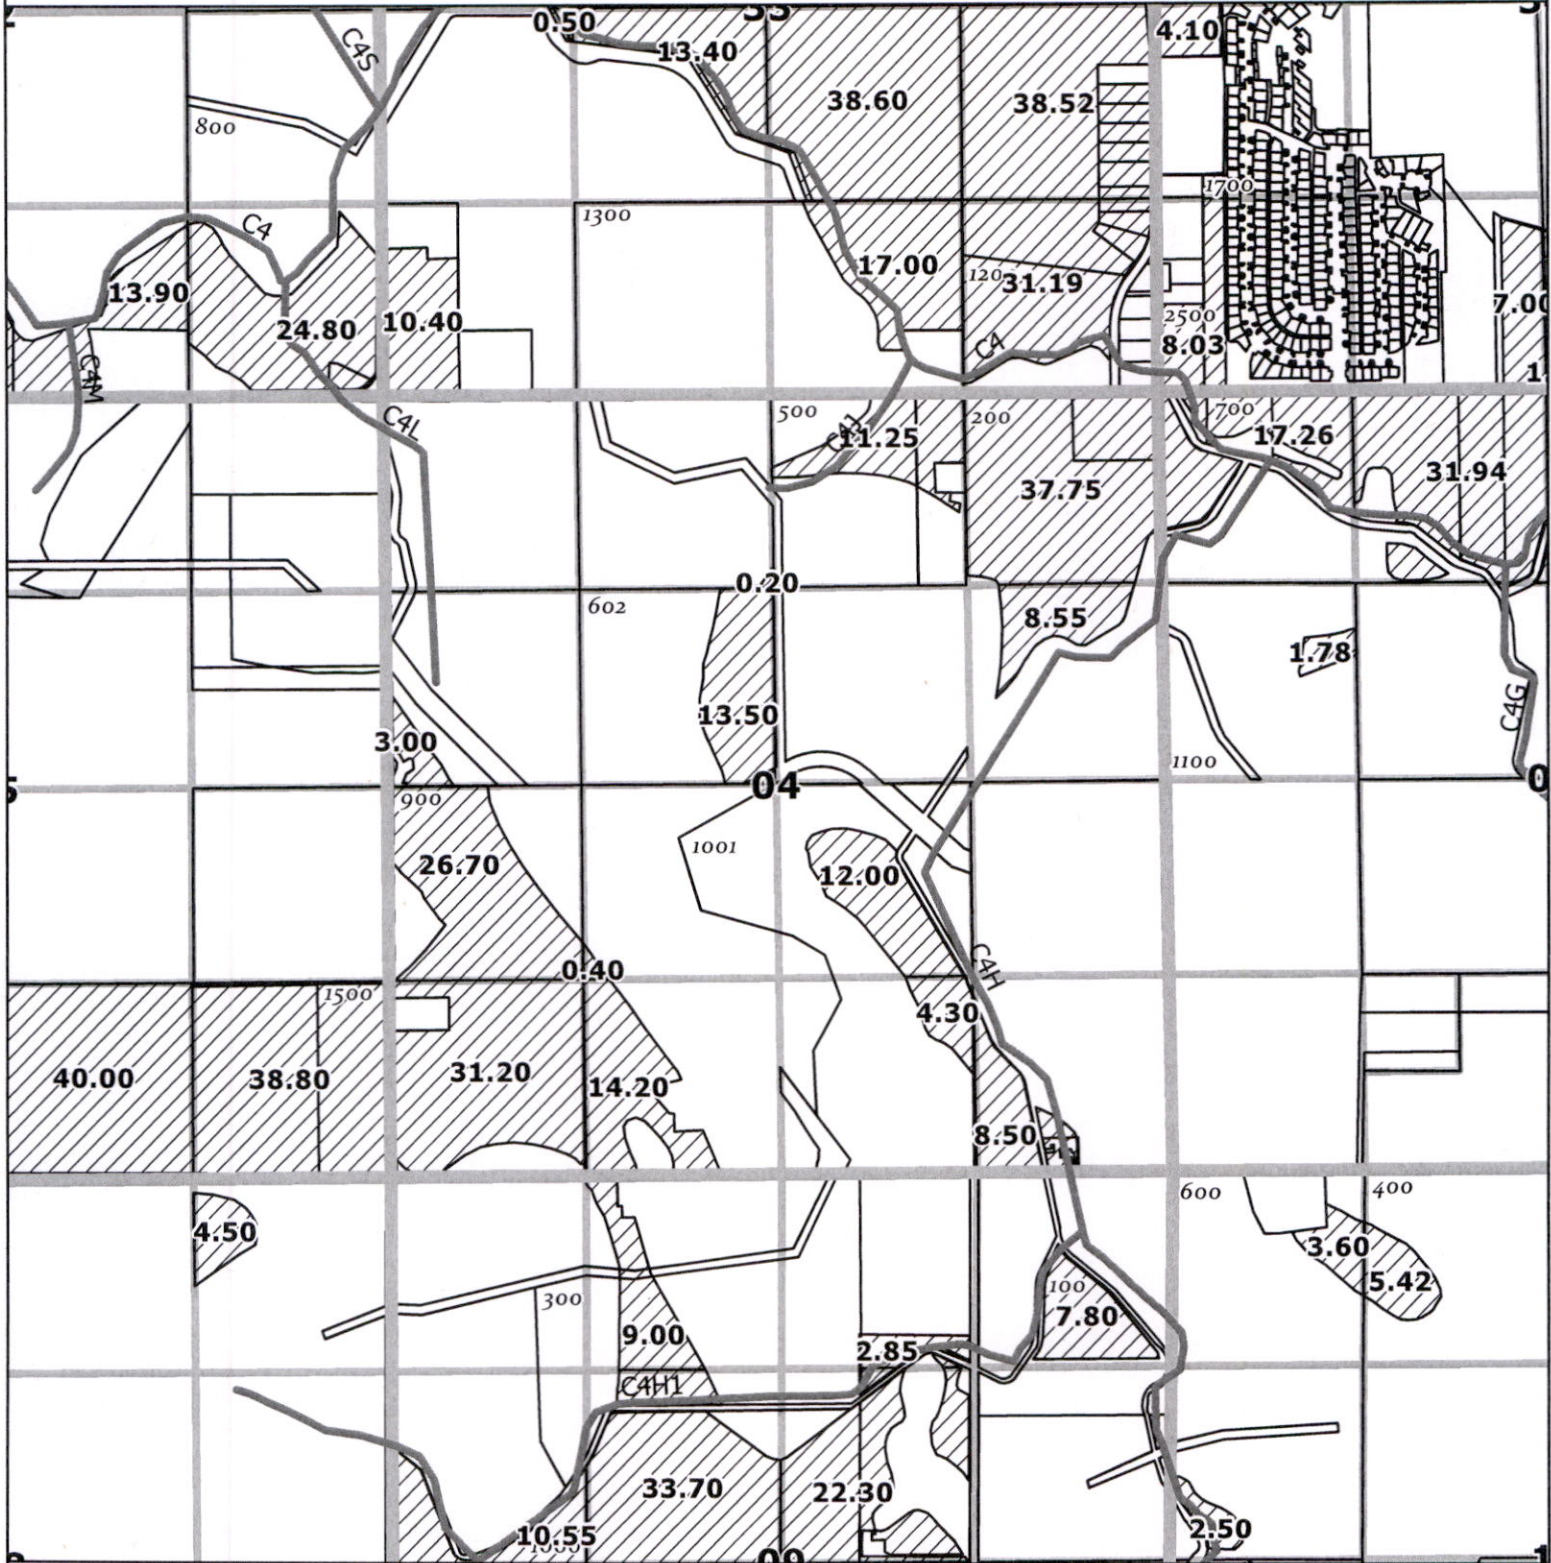


- Place of Use
- Klamath County Taxlot
- QQ Sections and Gov't Lots
- Map Series Sections
- Canal

Received
JUL 07 2025

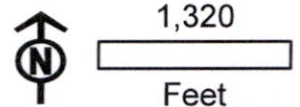

DISCLAIMER
This map is not intended to
provide legal dimensions or
locations of property
ownership lines

WATERSOLVING
johnw@watersolving.com

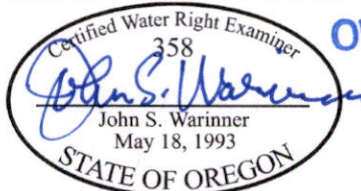

OWRD CLAIM OF BENEFICIAL USE MAP
APPLICATION G-16030
PERMIT G-18797
06/23/2025

T R S
40 S 9 E 05




- Received
JUL 07 2025



Feet


**CLAIM OF BENEFICIAL USE MAP
APPLICATION G-16030
PERMIT G-18797
06/23/2025**

WATERSOLVING
johnw@watersolving.com

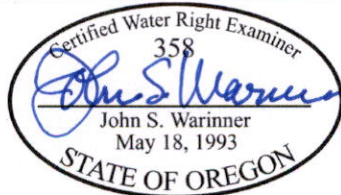


Map No. 49

T 40 S 9 E 08

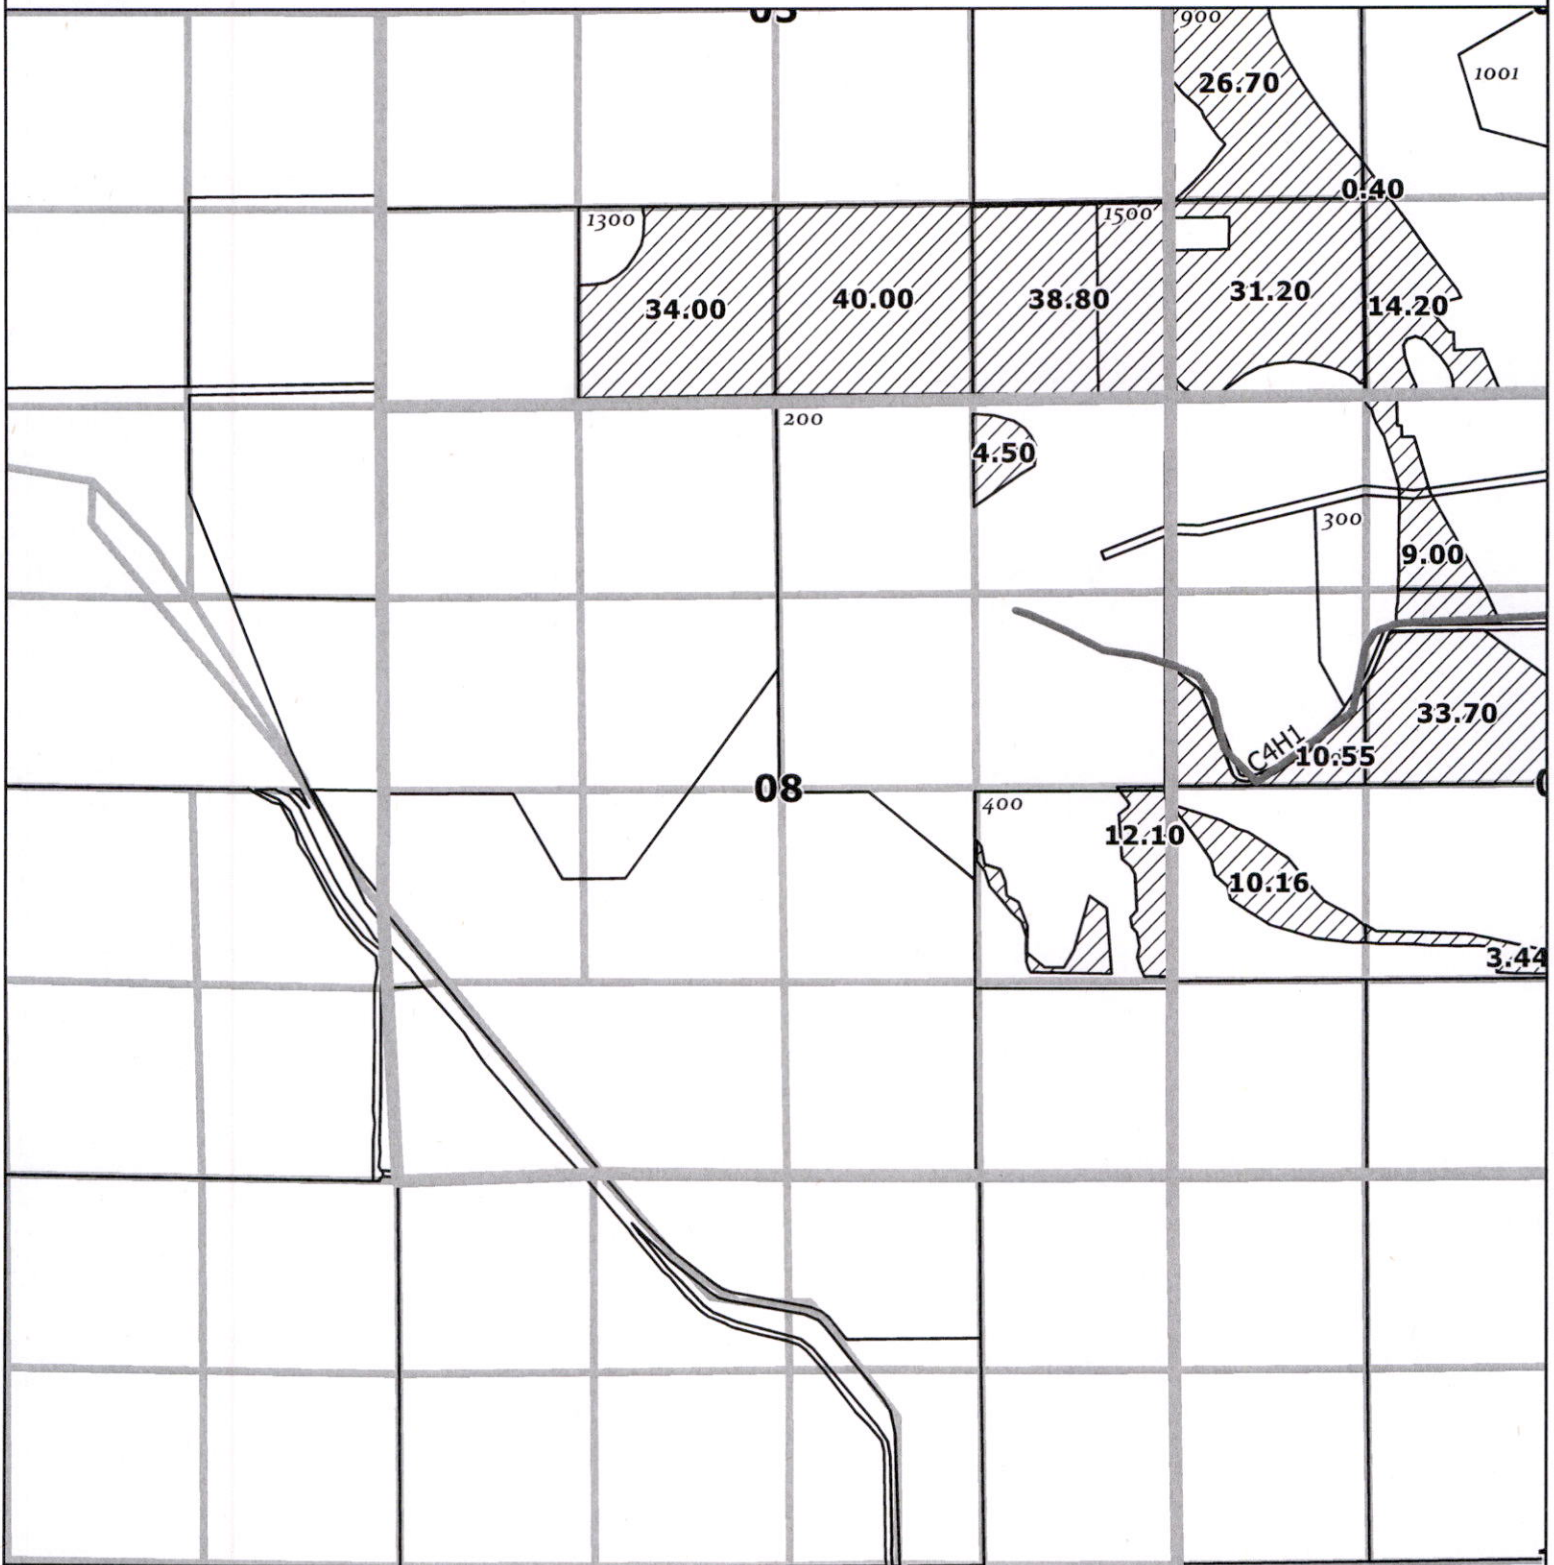


- Place of Use
- Map Series Sections
- Klamath County Taxlot
- Canal
- QQ Sections and Gov't Lots

Received
JUL 07 2025
OWRD

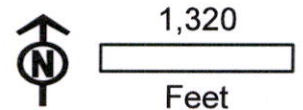

DISCLAIMER
This map is not intended to
provide legal dimensions or
locations of property
ownership lines


WATERSOLVING
johnw@watersolving.com

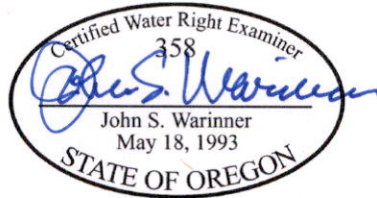

CLAIM OF BENEFICIAL USE MAP
APPLICATION G-16030
PERMIT G-18797
06/23/2025


Map No. 50

T S R S
40 9 09

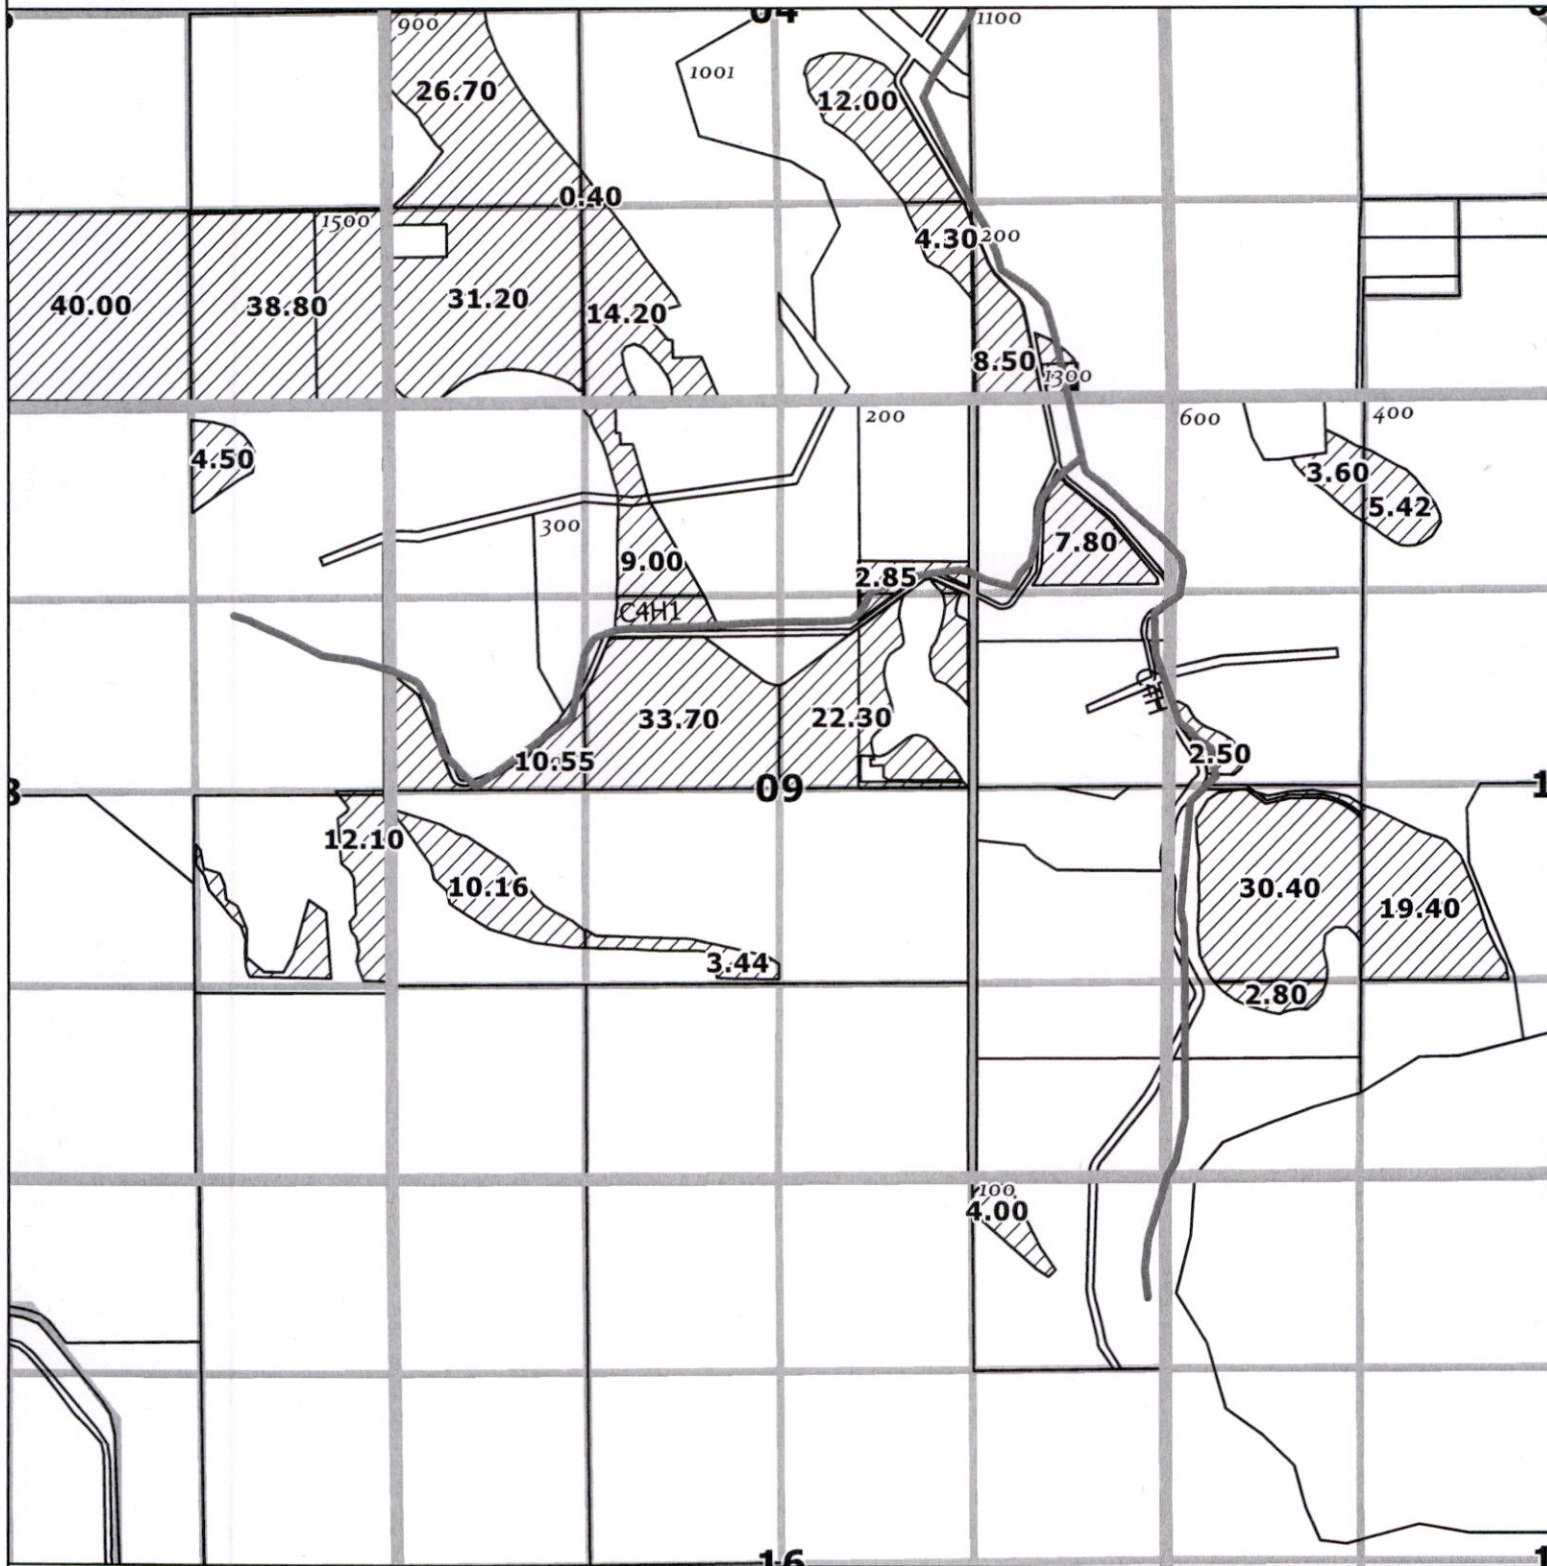

- Place of Use
- Klamath County Taxlot
- QQ Sections and Gov't Lots
- Map Series Sections
- Canal


Received
JUL 07 2025

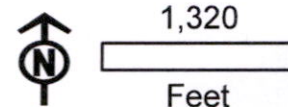

OWRD


DISCLAIMER
This map is not intended to
provide legal dimensions or
locations of property
ownership lines

WATERSOLVING
johnw@watersolving.com

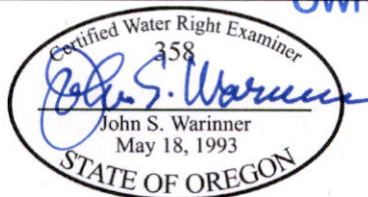

CLAIM OF BENEFICIAL USE MAP
APPLICATION G-16030
PERMIT G-18797
06/23/2025

T		R		S
40	S	9	E	10

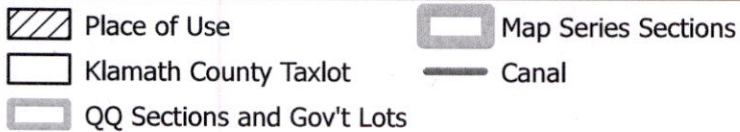


1,320
Feet

Certified Water Right Examiner
358
John S. Warinner
May 18, 1993
STATE OF OREGON

**CLAIM OF BENEFICIAL USE MAP
APPLICATION G-16030
PERMIT G-18797
06/23/2025**


T	R	S
40 S	9 E	11

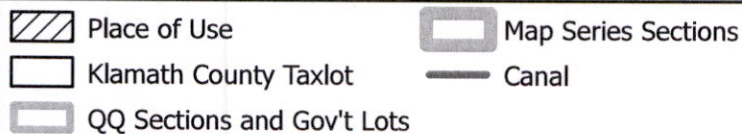

1,320
Feet

**CLAIM OF BENEFICIAL USE MAP
APPLICATION G-16030
PERMIT G-18797
06/23/2025**

T		R		S
40	S	9	E	12

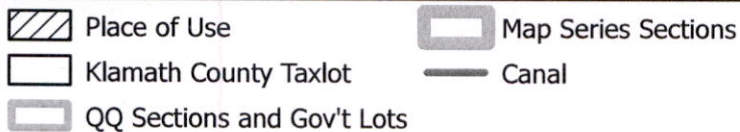


1,320
Feet

Certified Water Right Examiner
358
John S. Warriner
John S. Warriner
May 18, 1993
STATE OF OREGON

**CLAIM OF BENEFICIAL USE MAP
APPLICATION G-16030
PERMIT G-18797
06/23/2025**


T		R		S
40	S	9	E	13

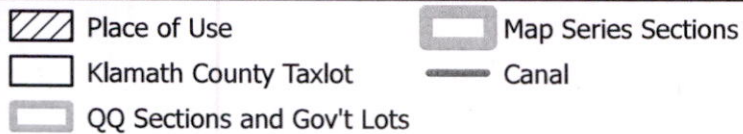

**CLAIM OF BENEFICIAL USE MAP
APPLICATION G-16030
PERMIT G-18797
06/23/2025**


Map No. 55

T S 9 R E 14

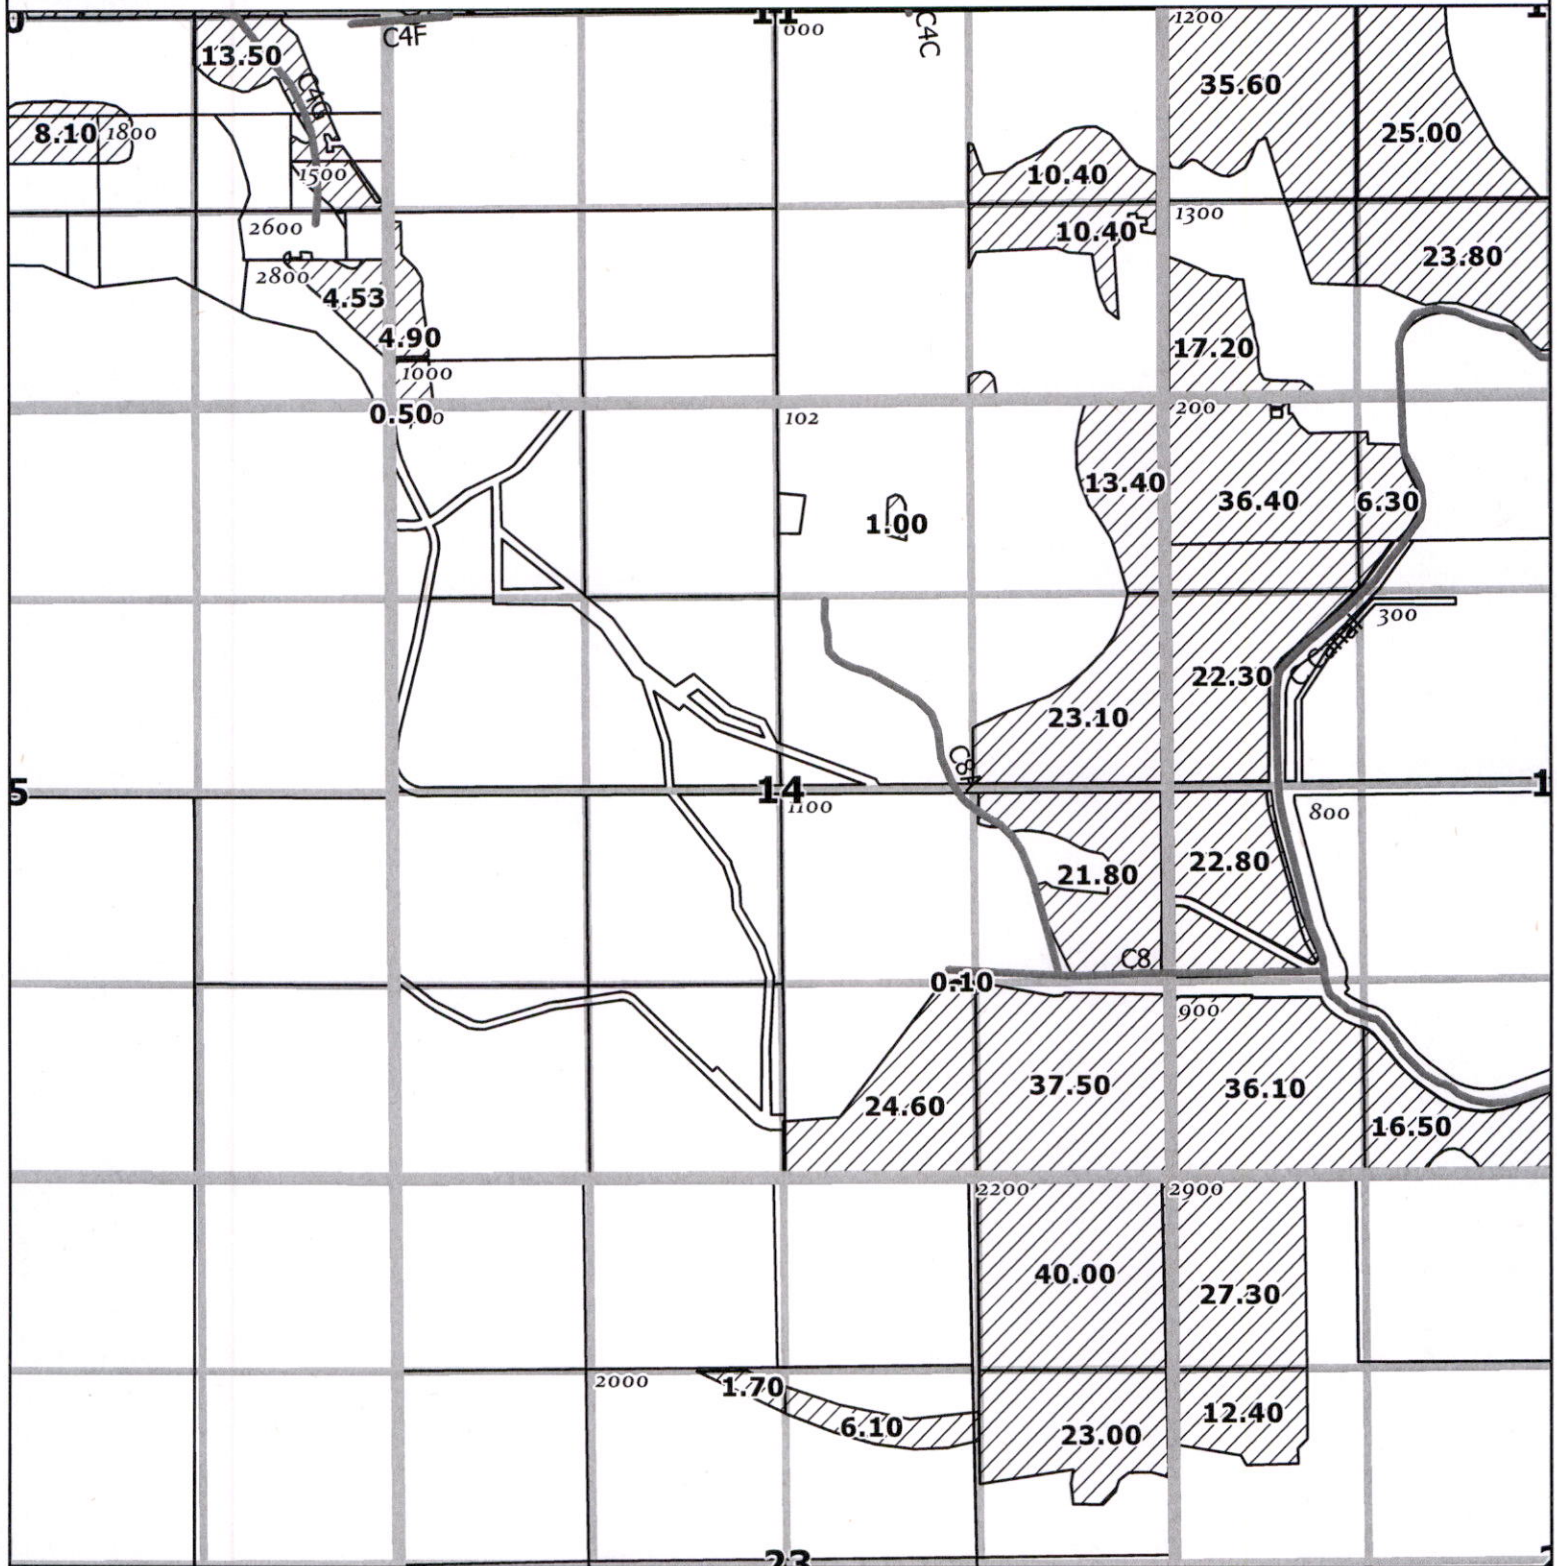


- Place of Use
- Klamath County Taxlot
- QQ Sections and Gov't Lots
- Map Series Sections
- Canal

Received
JUL 07 2025
OWRD

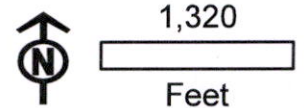

DISCLAIMER
This map is not intended to
provide legal dimensions or
locations of property
ownership lines


WATERSOLVING
johnw@watersolving.com

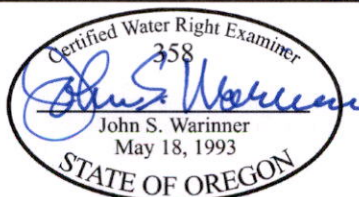

CLAIM OF BENEFICIAL USE MAP
APPLICATION G-16030
PERMIT G-18797
06/23/2025

Map No. 56

T 40 S 9 E S 15

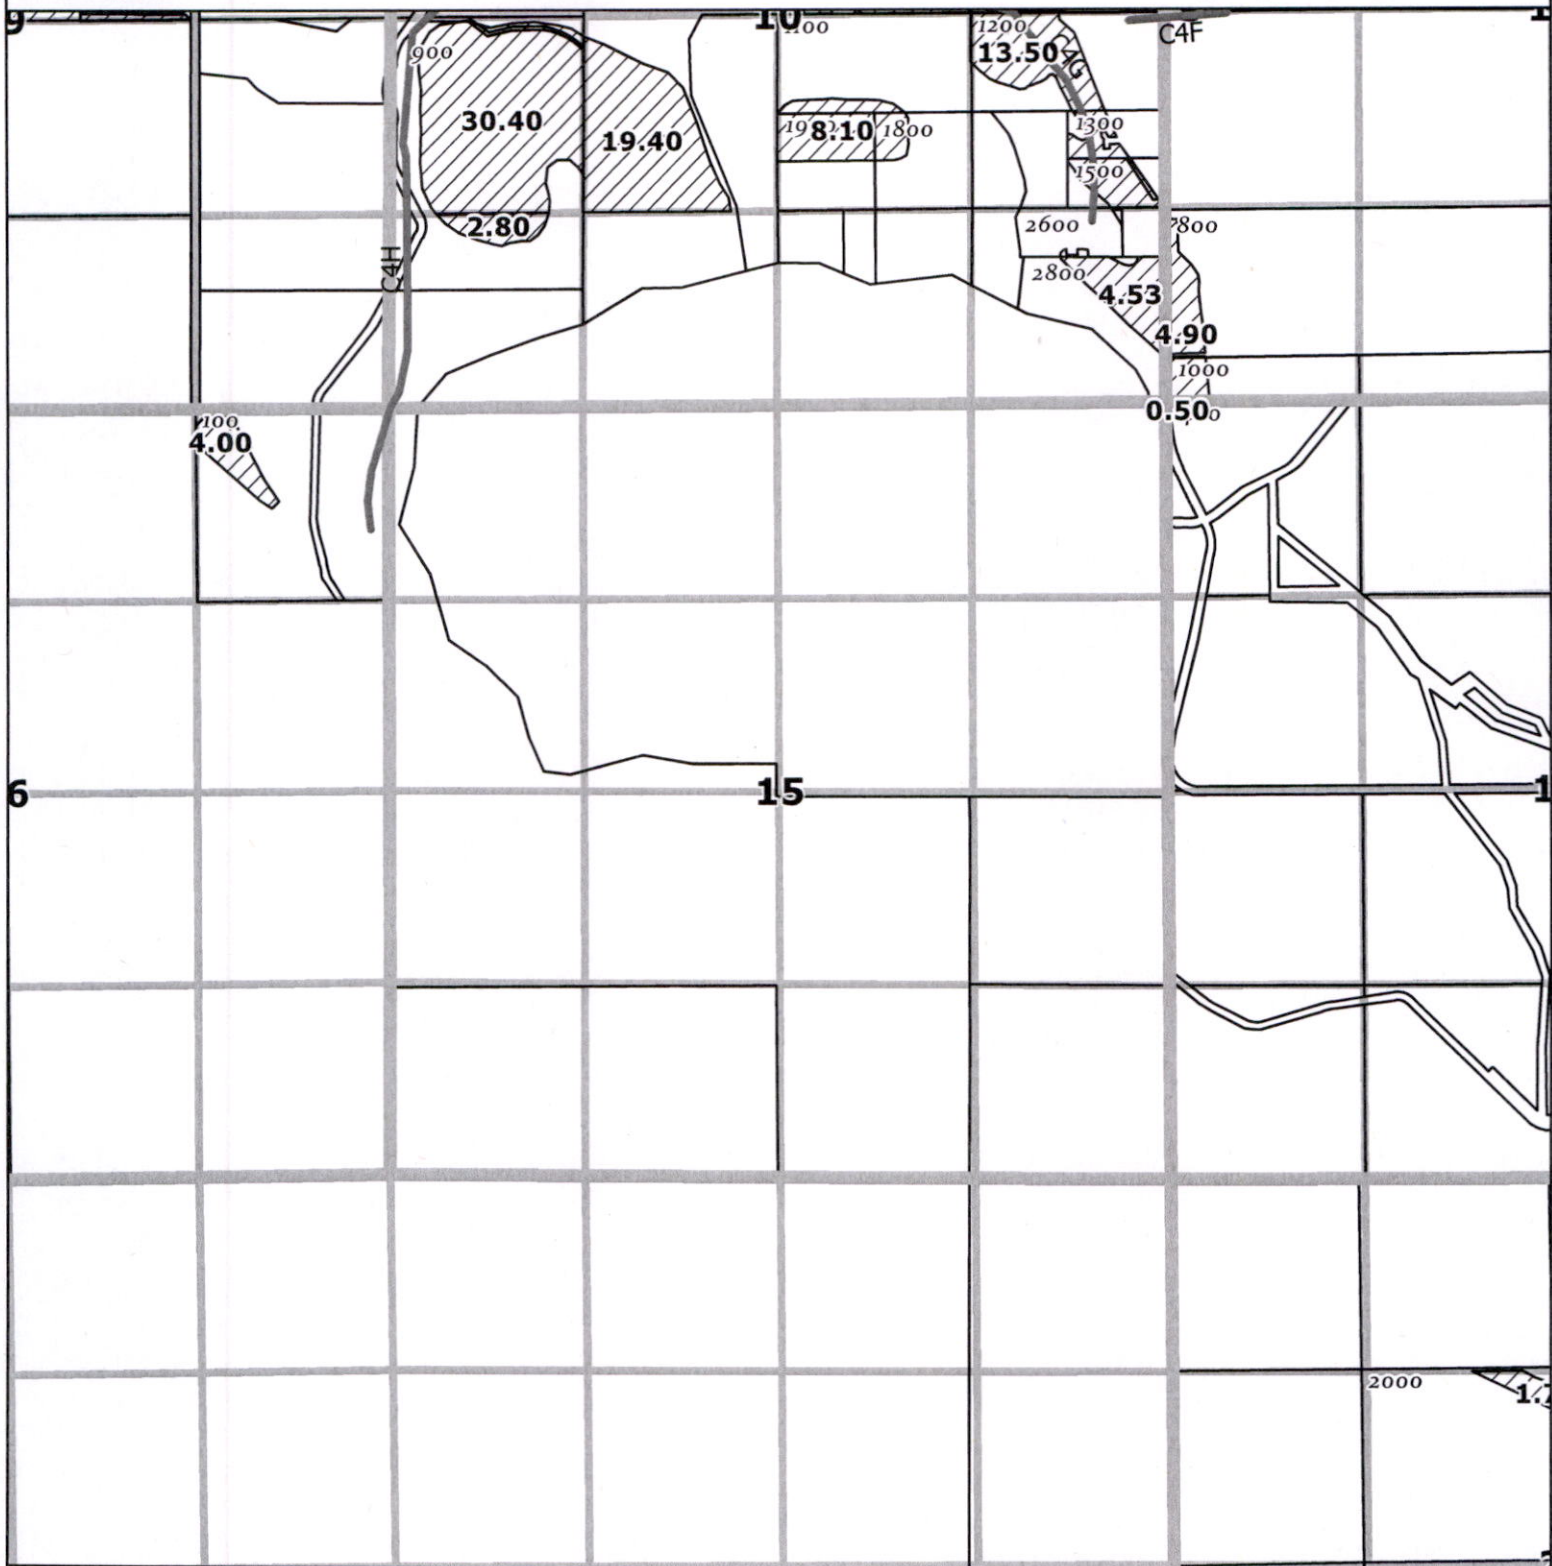

- Klamath County Taxlot
- QQ Sections and Gov't Lots
- Map Series Sections
- Canal


Received
JUL 07 2025
OWRD



1,320
Feet

DISCLAIMER
This map is not intended to
provide legal dimensions or
locations of property
ownership lines


WATERSOLVING
johnw@watersolving.com

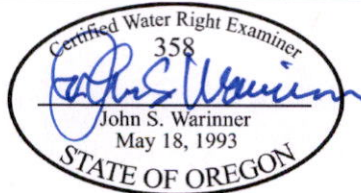

CLAIM OF BENEFICIAL USE MAP
APPLICATION G-16030
PERMIT G-18797
06/23/2025

Map No. 57

T S 9 E 16

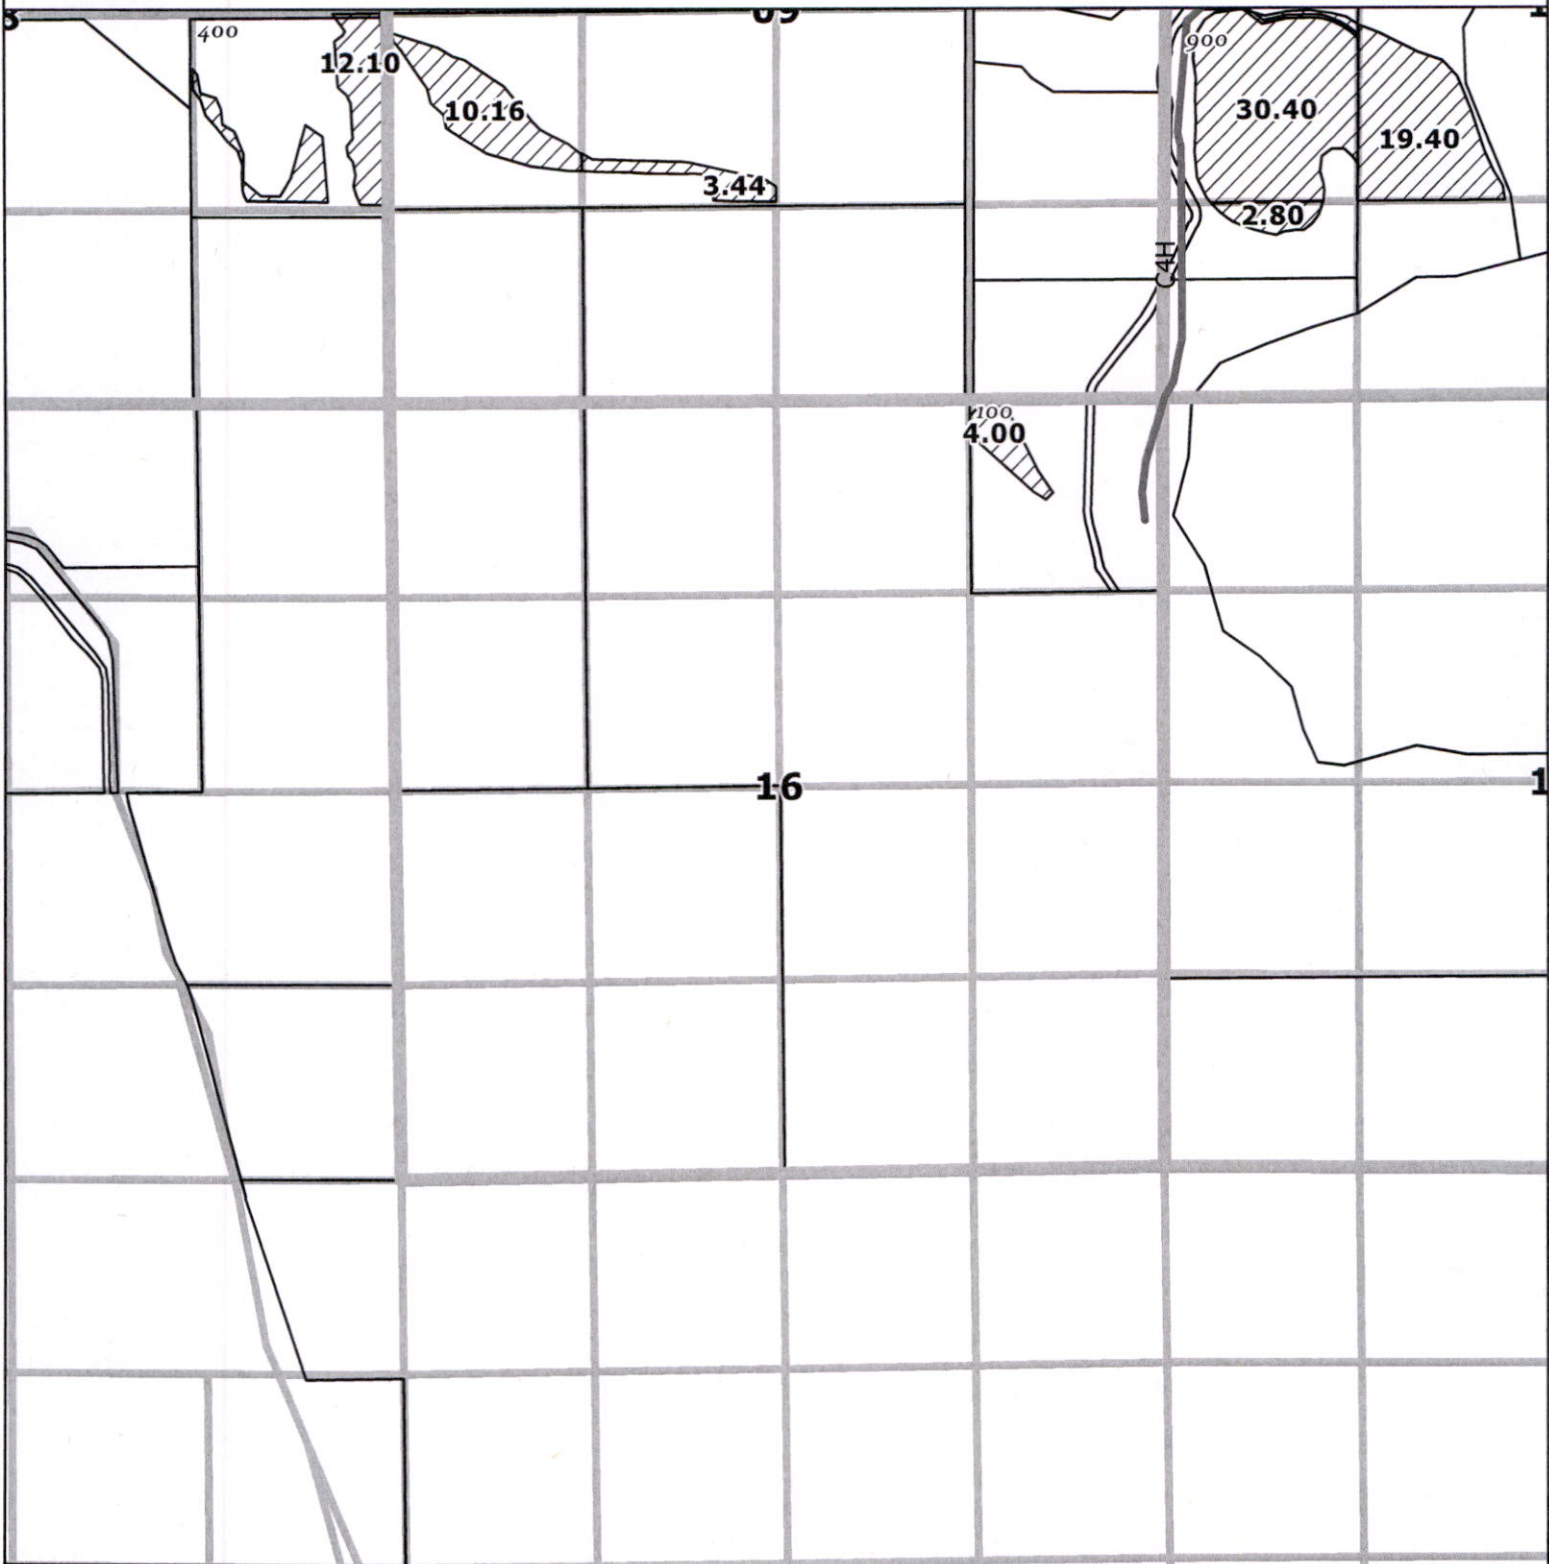

- Place of Use
- Klamath County Taxlot
- QQ Sections and Gov't Lots
- Map Series Sections
- Canal

Received

JUL 07 2025


OWRD



1,320
Feet

DISCLAIMER
This map is not intended to
provide legal dimensions or
locations of property
ownership lines


WATERSOLVING
johnw@watersolving.com

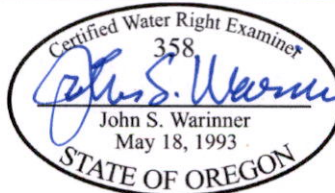

CLAIM OF BENEFICIAL USE MAP
APPLICATION G-16030
PERMIT G-18797
06/23/2025


Map No. 58

T S 40 R 9 S 23 E 23

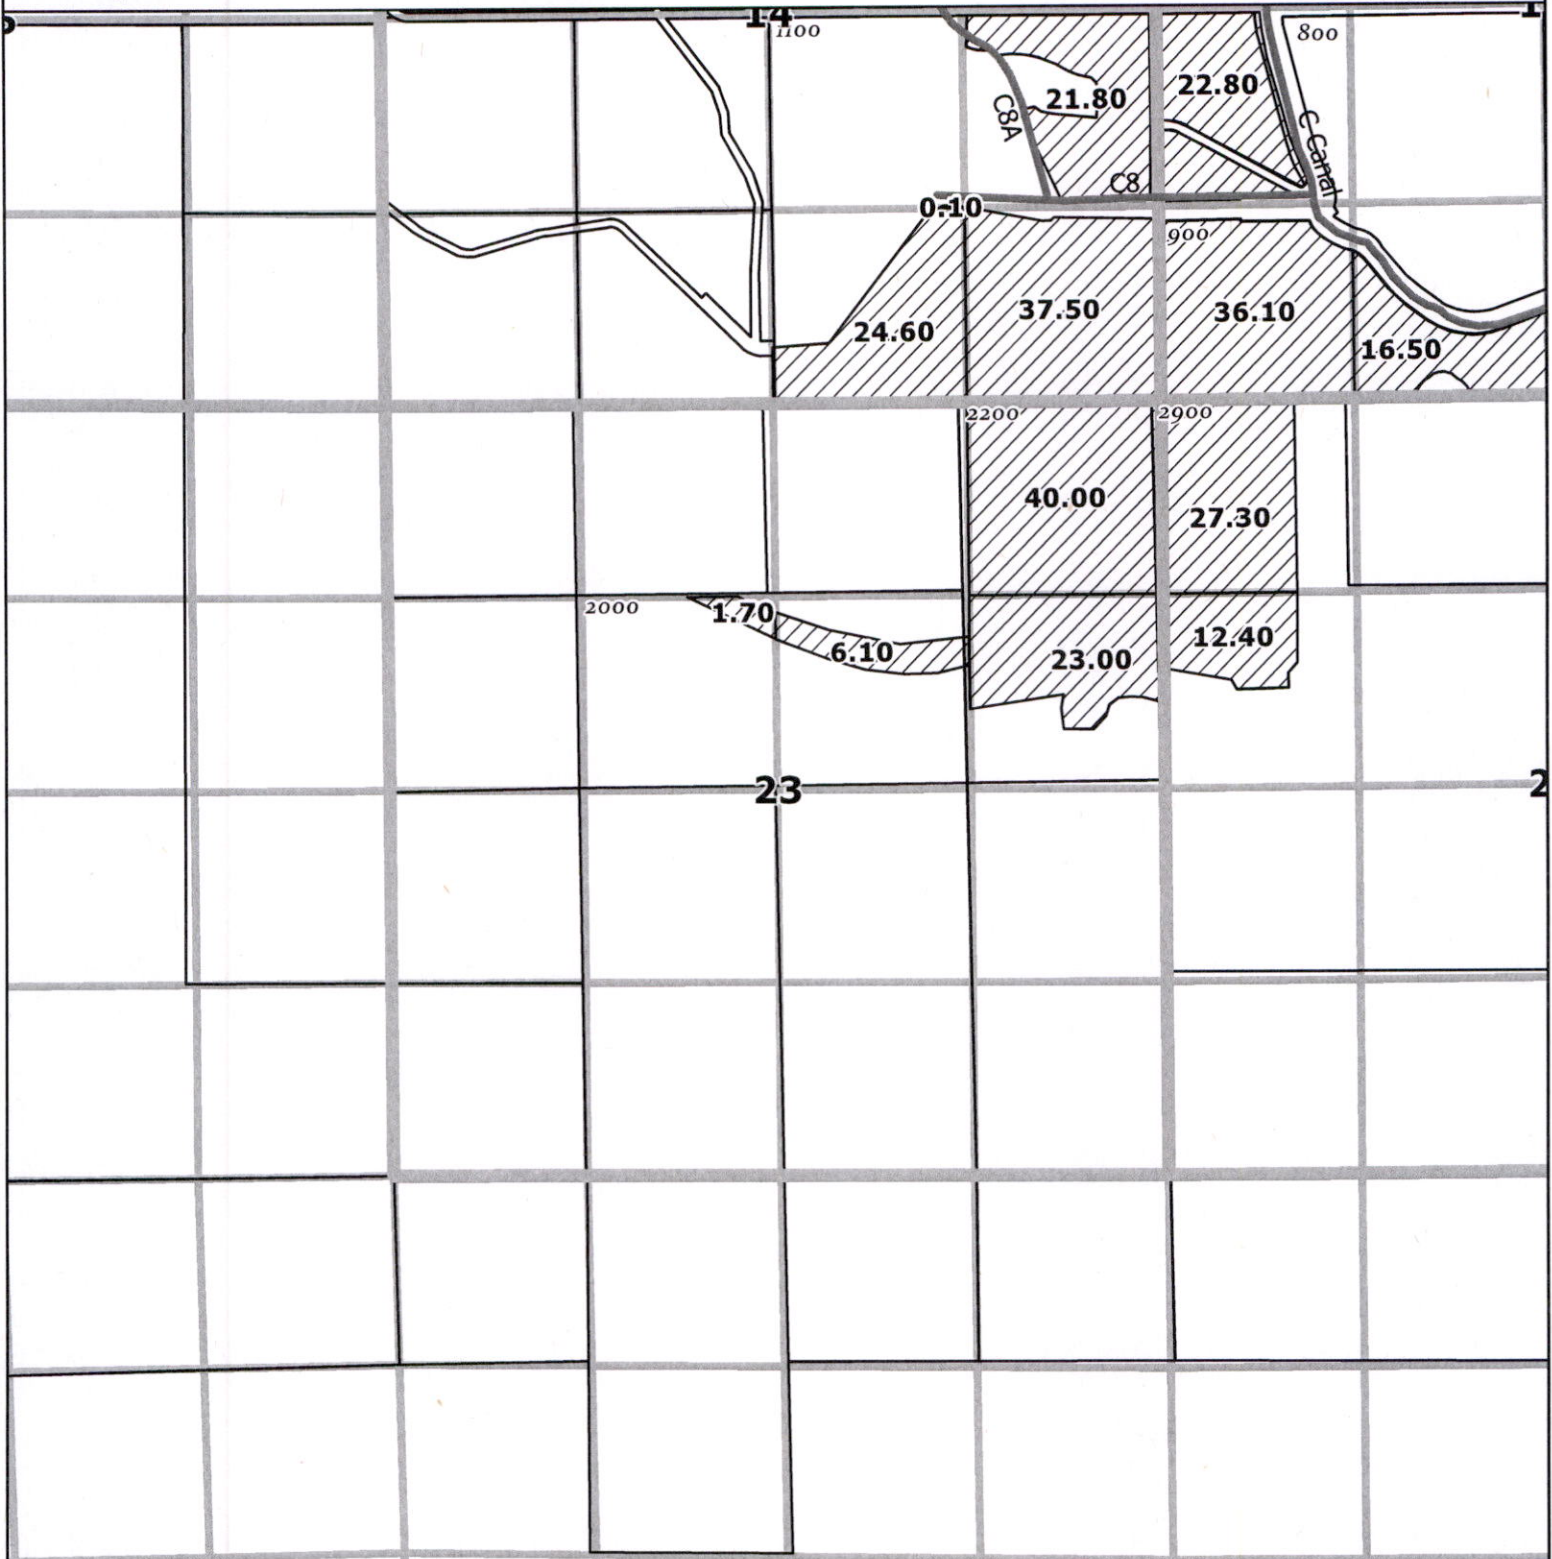


- Place of Use
- Klamath County Taxlot
- QQ Sections and Gov't Lots
- Map Series Sections
- Canal

Received
JUL 07 2025
OWRD

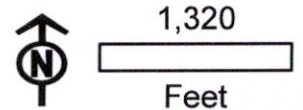

DISCLAIMER
This map is not intended to
provide legal dimensions or
locations of property
ownership lines


WATERSOLVING
johnw@watersolving.com

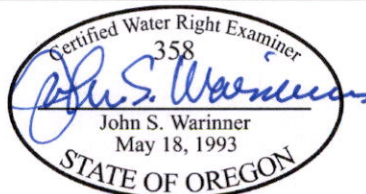

CLAIM OF BENEFICIAL USE MAP
APPLICATION G-16030
PERMIT G-18797
06/23/2025


Map No. 59

T 40 S 9 R E S 24

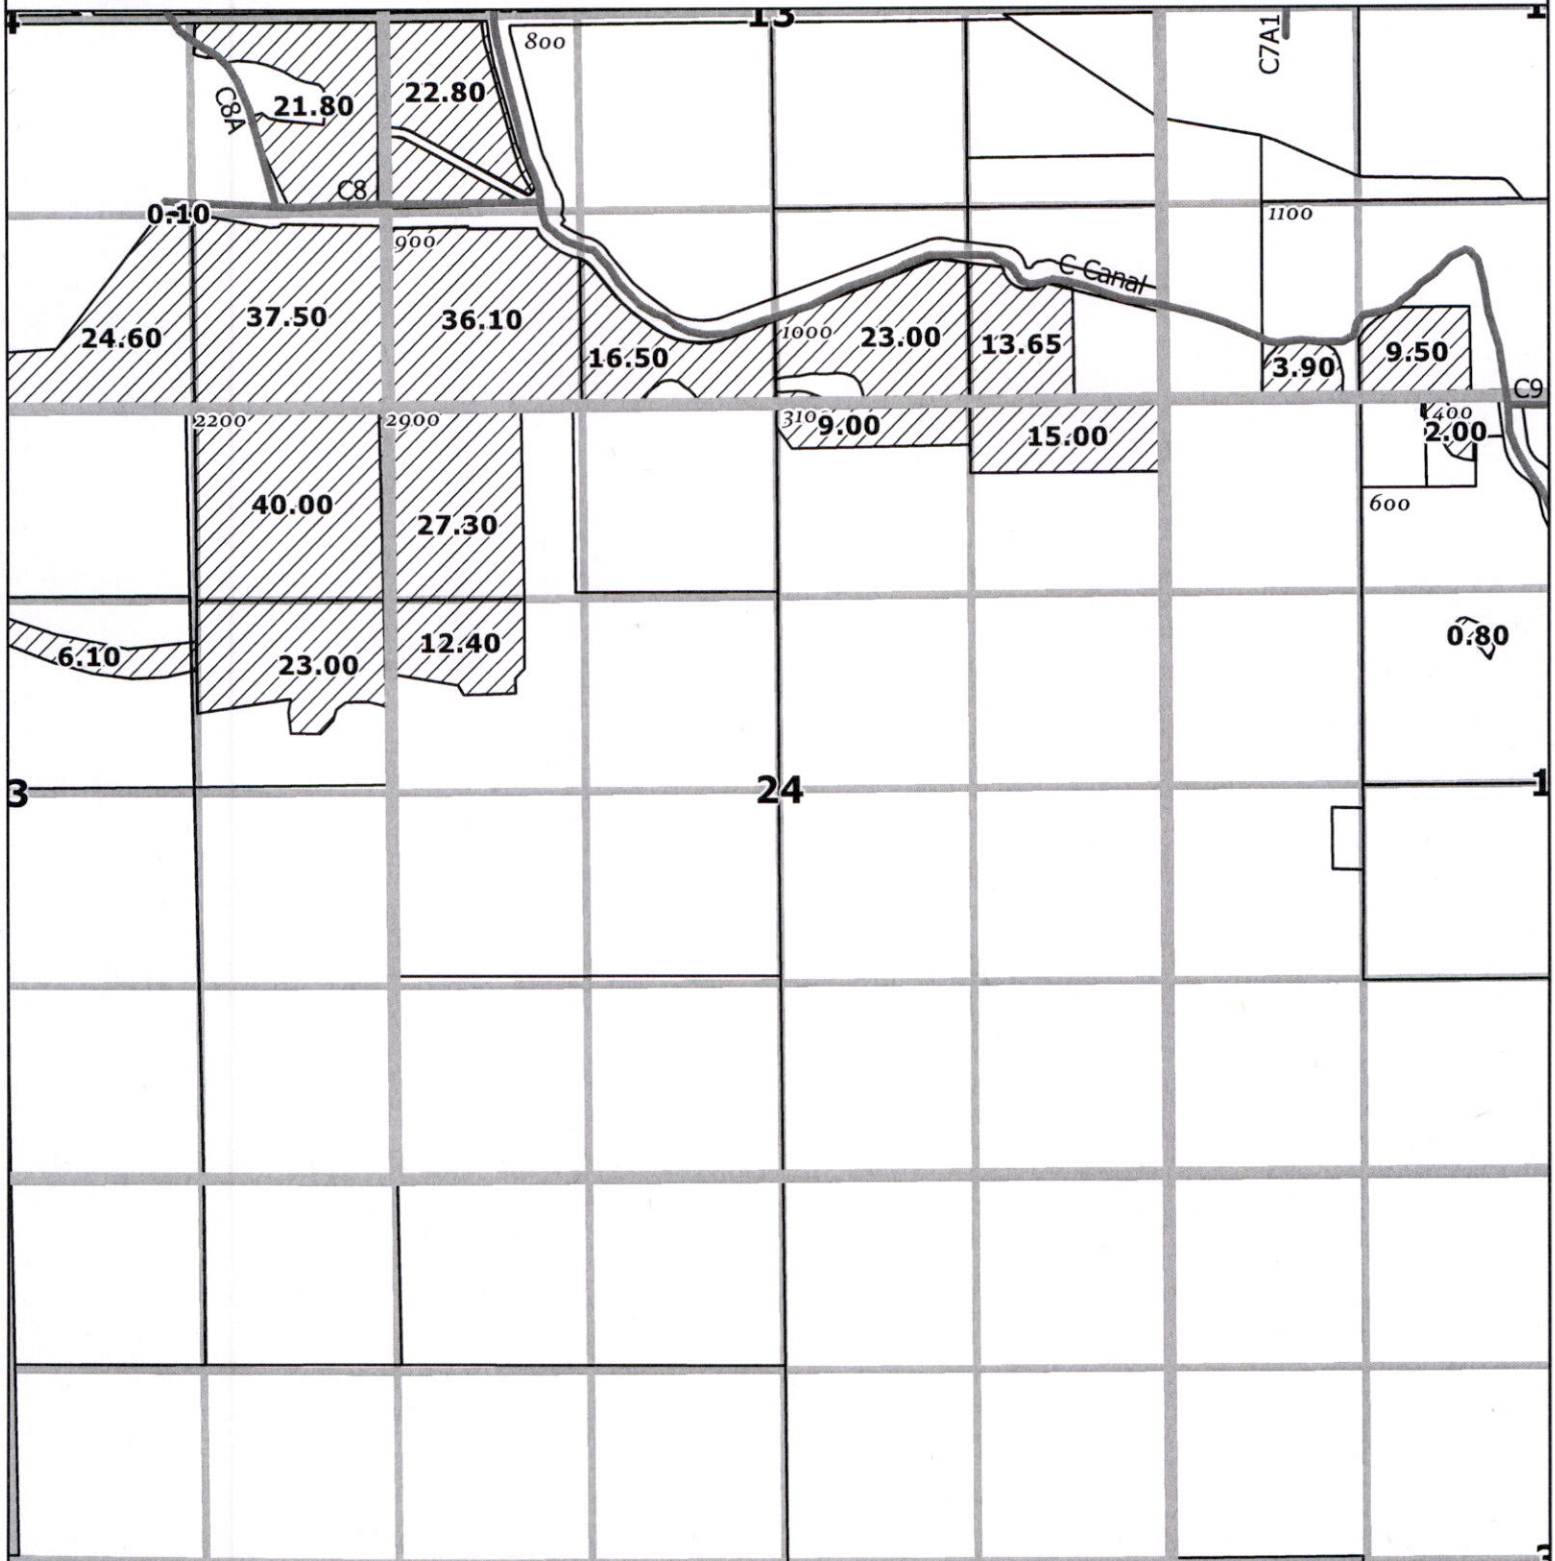


- Place of Use
- Klamath County Taxlot
- QQ Sections and Gov't Lots
- Map Series Sections
- Canal

Received
JUL 07 2025
OWRD

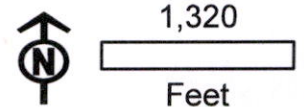

DISCLAIMER
This map is not intended to
provide legal dimensions or
locations of property
ownership lines


WATERSOLVING
johnw@watersolving.com

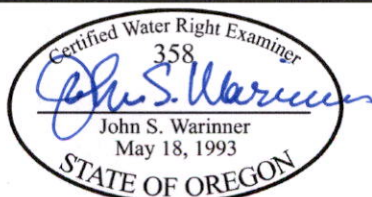

CLAIM OF BENEFICIAL USE MAP
APPLICATION G-16030
PERMIT G-18797
06/23/2025


Map No. 60

T 40 S 10 E S 05

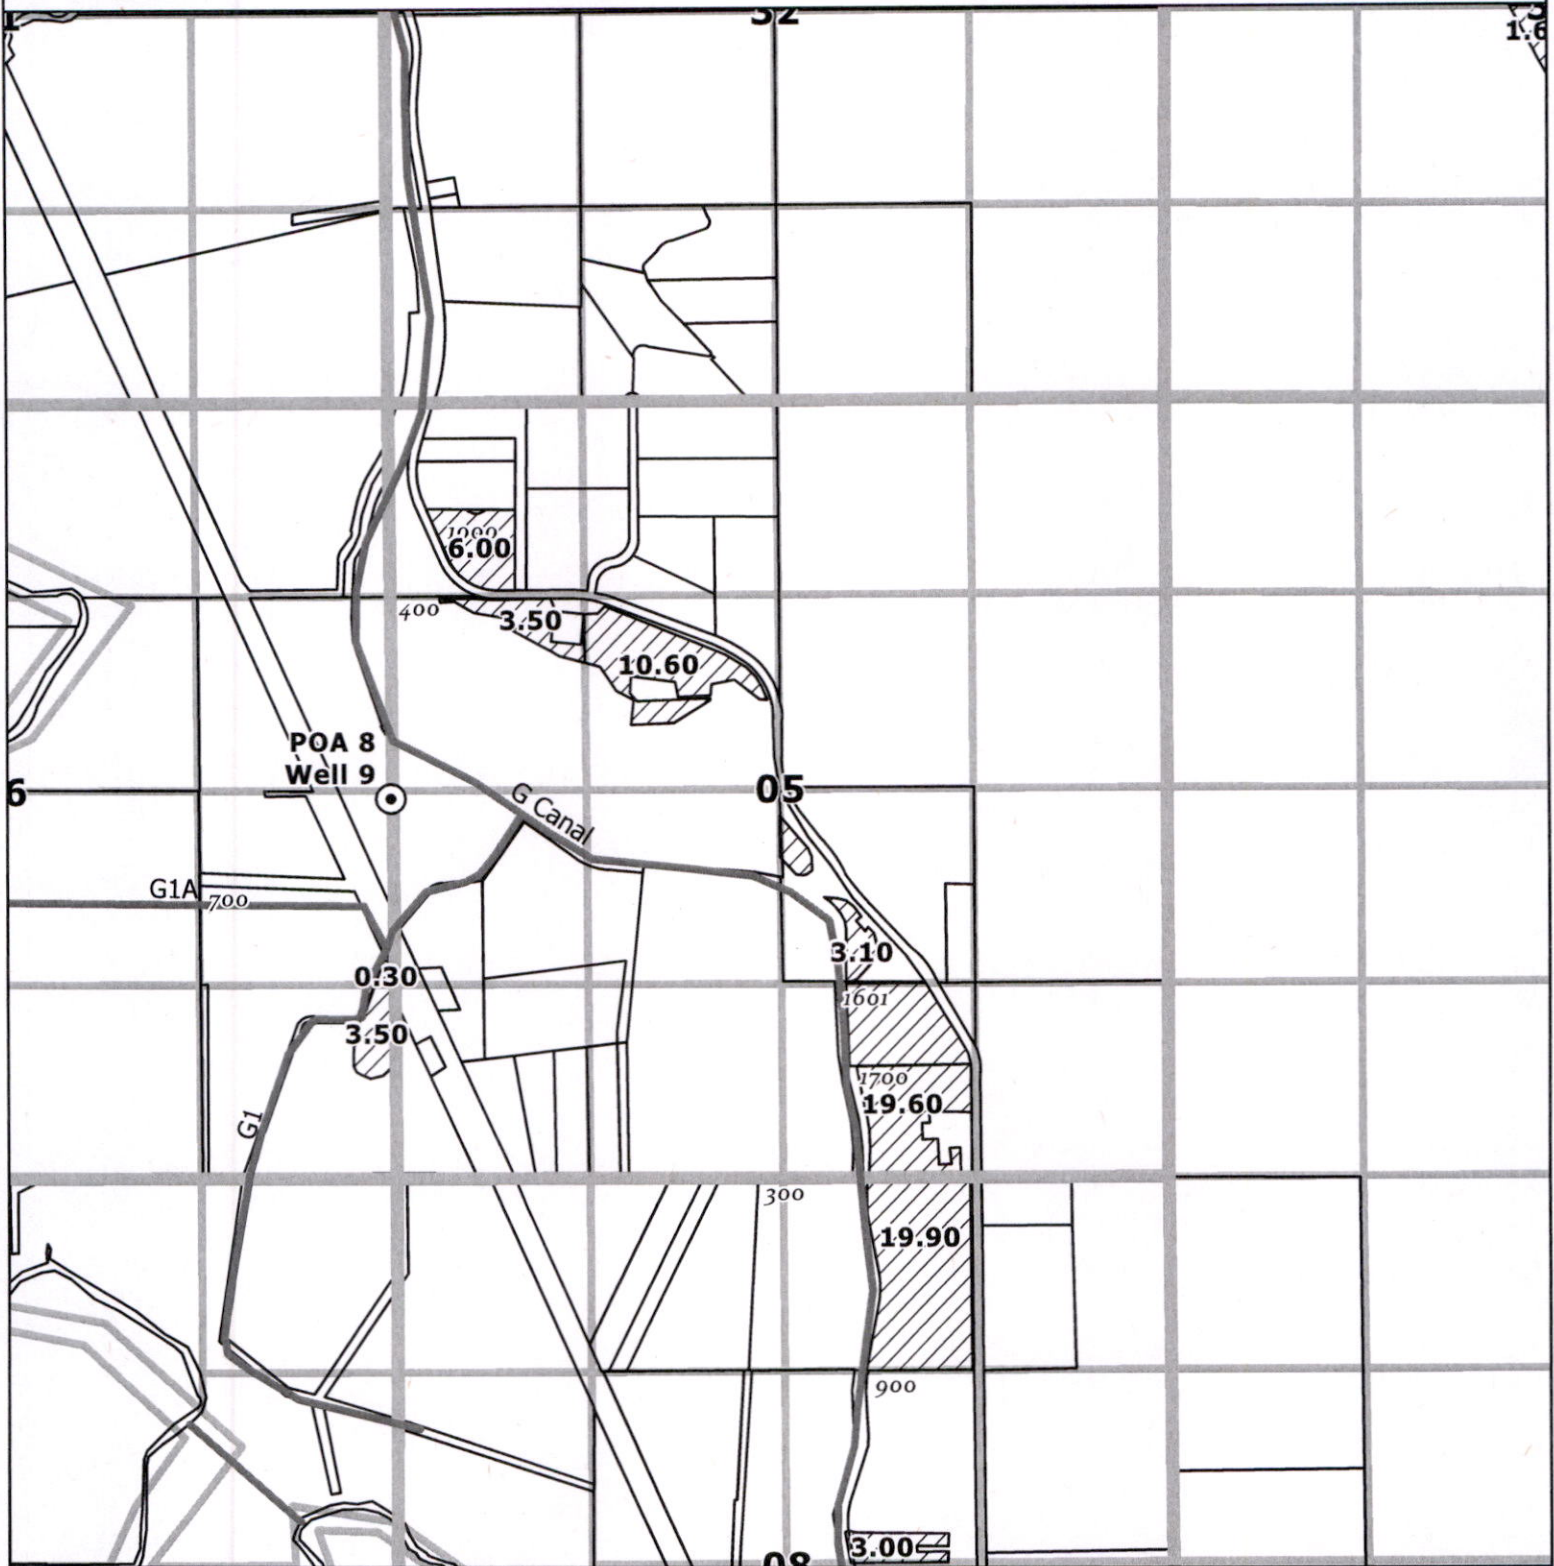

- Place of Use
- Klamath County Taxlot
- QQ Sections and Gov't Lots
- Point of Appropriation
- Pipelines
- Canal
- Map Series Sections


Received
JUL 07 2025

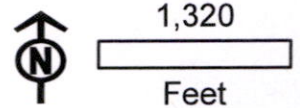

OWRD

DISCLAIMER
This map is not intended to
provide legal dimensions or
locations of property
ownership lines


WATERSOLVING
johnw@watersolving.com

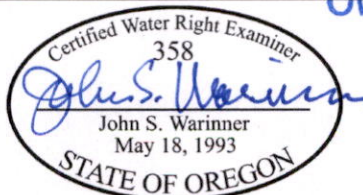

CLAIM OF BENEFICIAL USE MAP
APPLICATION G-16030
PERMIT G-18797
06/23/2025

Map No. 61

T S 40 R 10 S 06 E 06

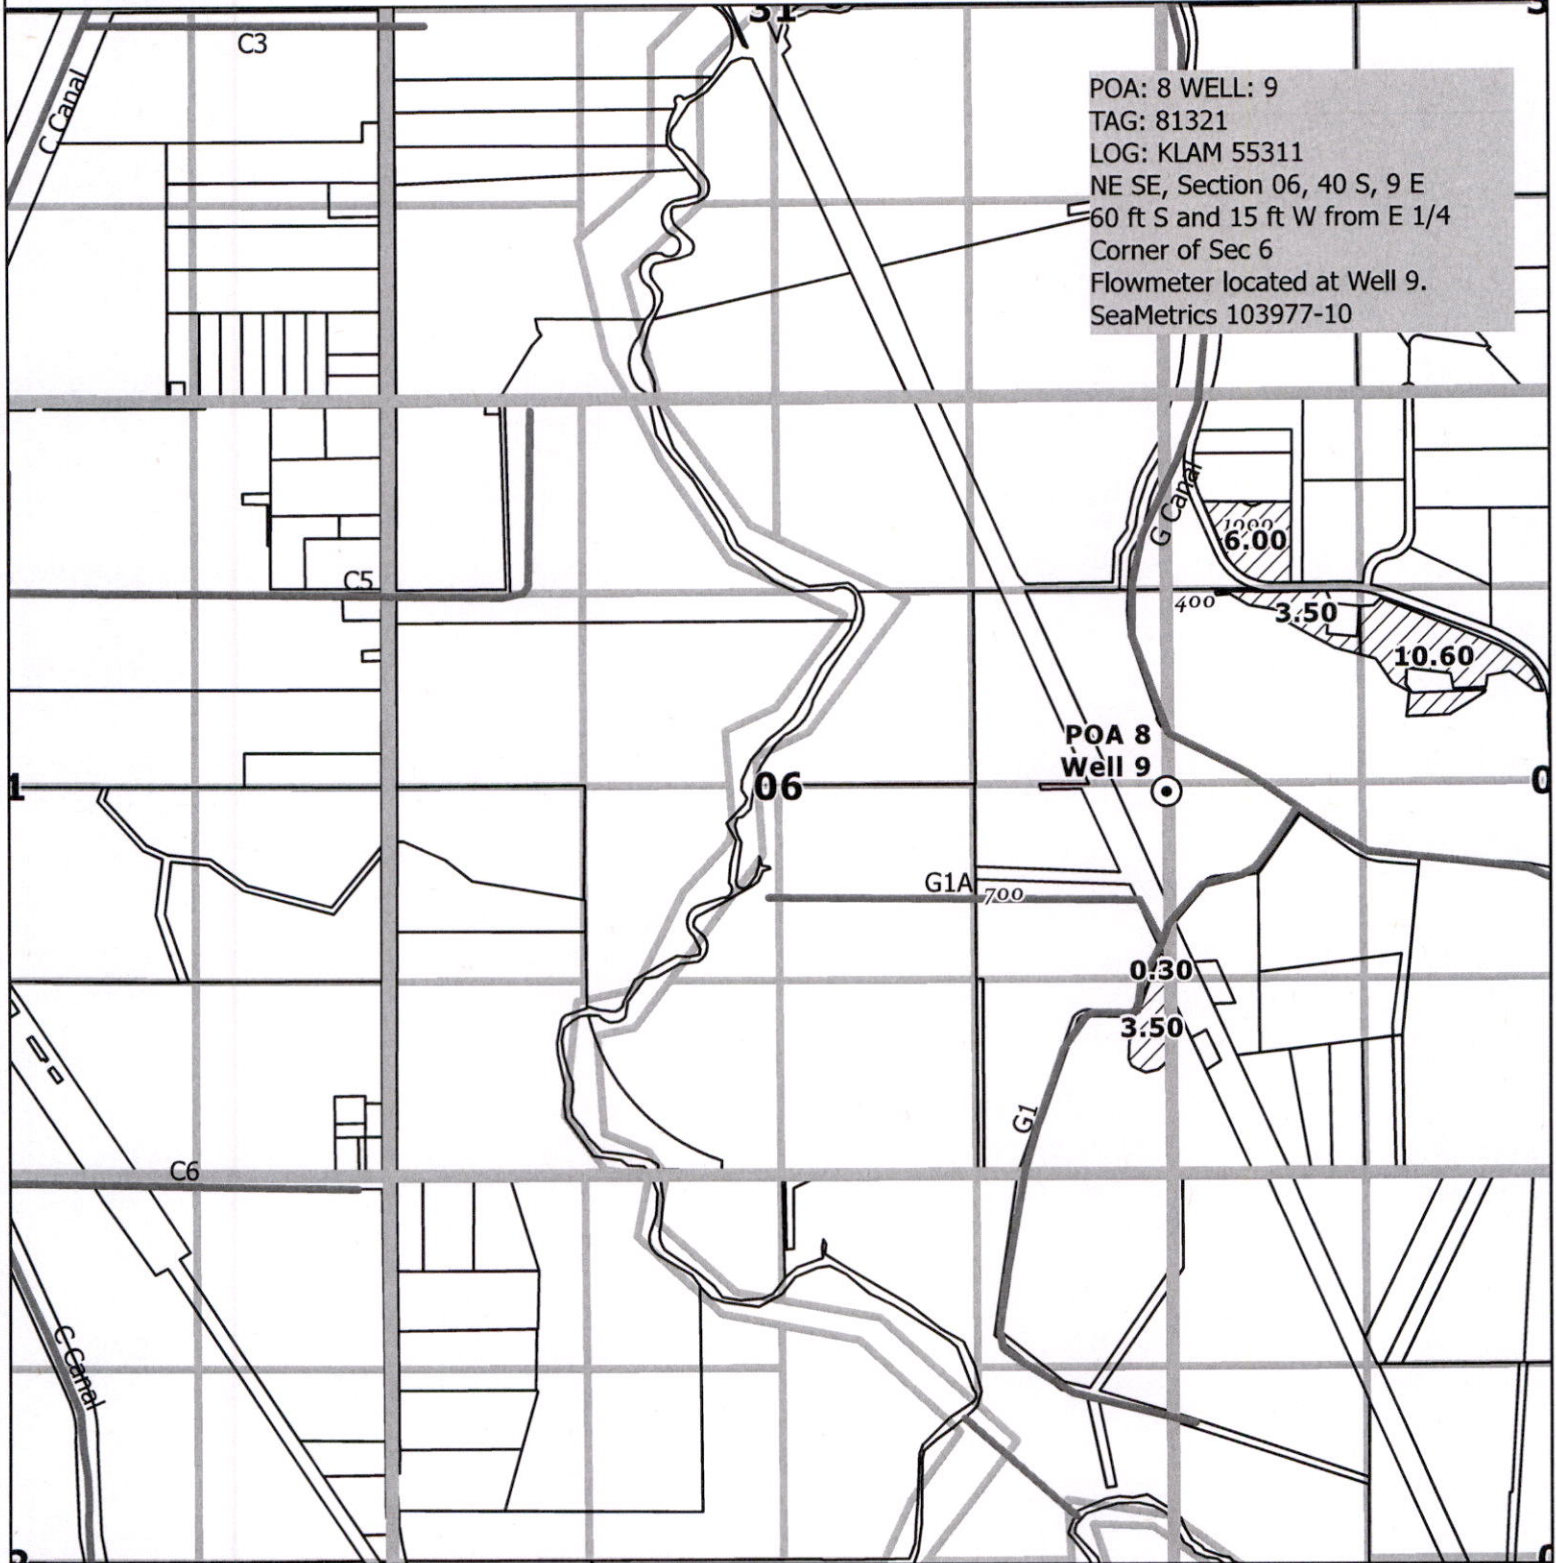

POA: 8 WELL: 9
TAG: 81321
LOG: KLAM 55311
NE SE, Section 06, 40 S, 9 E
60 ft S and 15 ft W from E 1/4
Corner of Sec 6
Flowmeter located at Well 9.
SeaMetrics 103977-10

- Place of Use
- Klamath County Taxlot
- QQ Sections and Gov't Lots
- Map Series Sections
- Point of Appropriation
- Pipelines
- Canal

Received

JUL 07 2025

OWRD




1,320

Feet

DISCLAIMER
This map is not intended to
provide legal dimensions or
locations of property
ownership lines


WATERSOLVING
johnw@watersolving.com

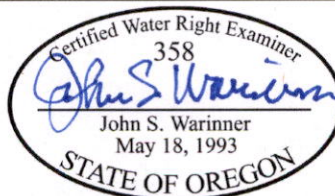

CLAIM OF BENEFICIAL USE MAP
APPLICATION G-16030
PERMIT G-18797
06/23/2025

Map No. 62

T S 40 R 10 S 08 E 08

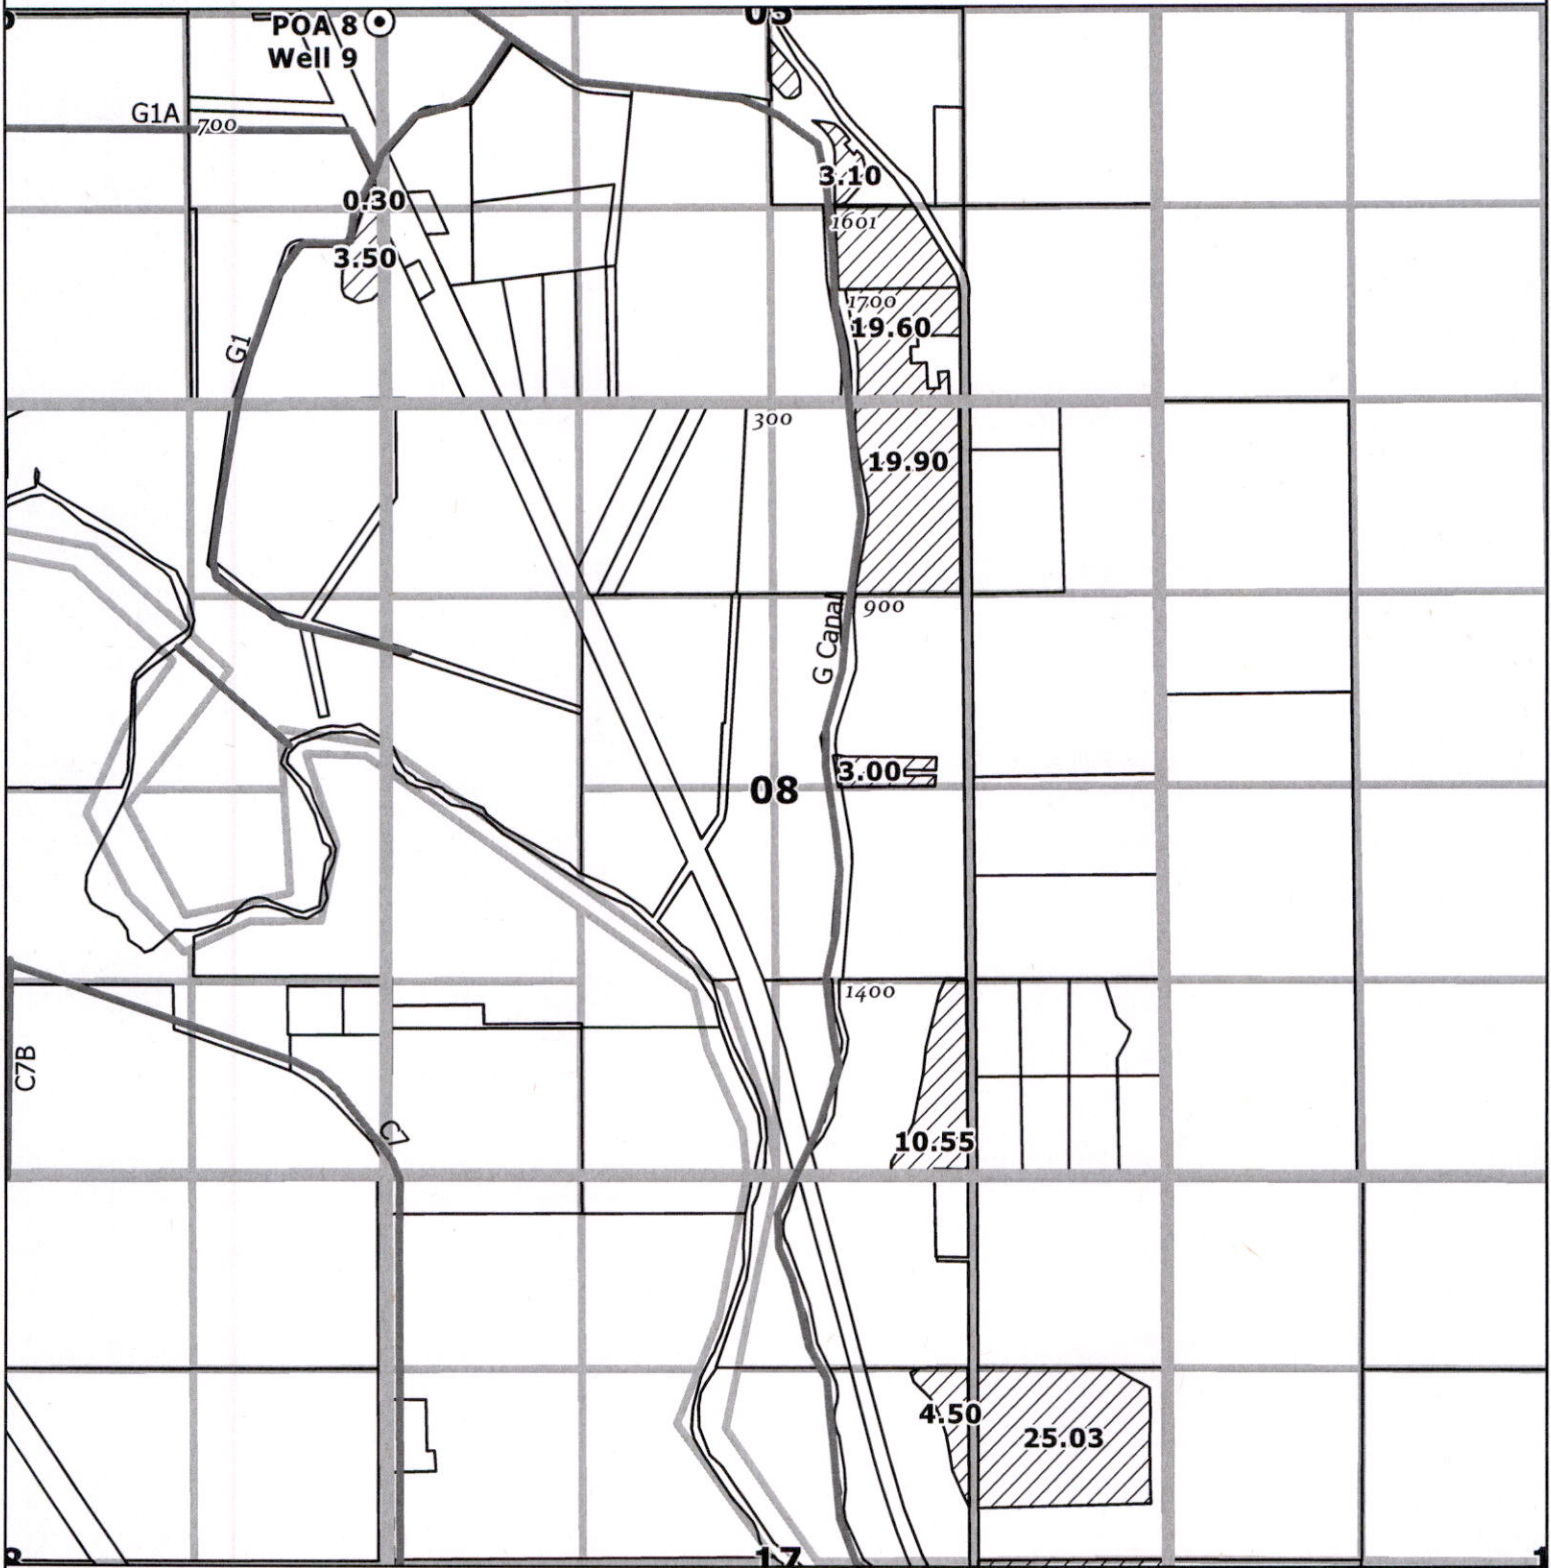

- Place of Use
- Klamath County Taxlot
- QQ Sections and Gov't Lots
- Map Series Sections
- Canal

Received

JUL 07 2025

OWRD




1,320

Feet

DISCLAIMER

This map is not intended to provide legal dimensions or locations of property ownership lines


WATERSOLVING
johnw@watersolving.com

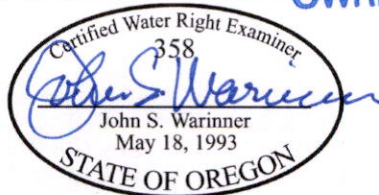

CLAIM OF BENEFICIAL USE MAP
APPLICATION G-16030
PERMIT G-18797
06/23/2025

Map No. 63

T 40 S 10 R 16 S 16

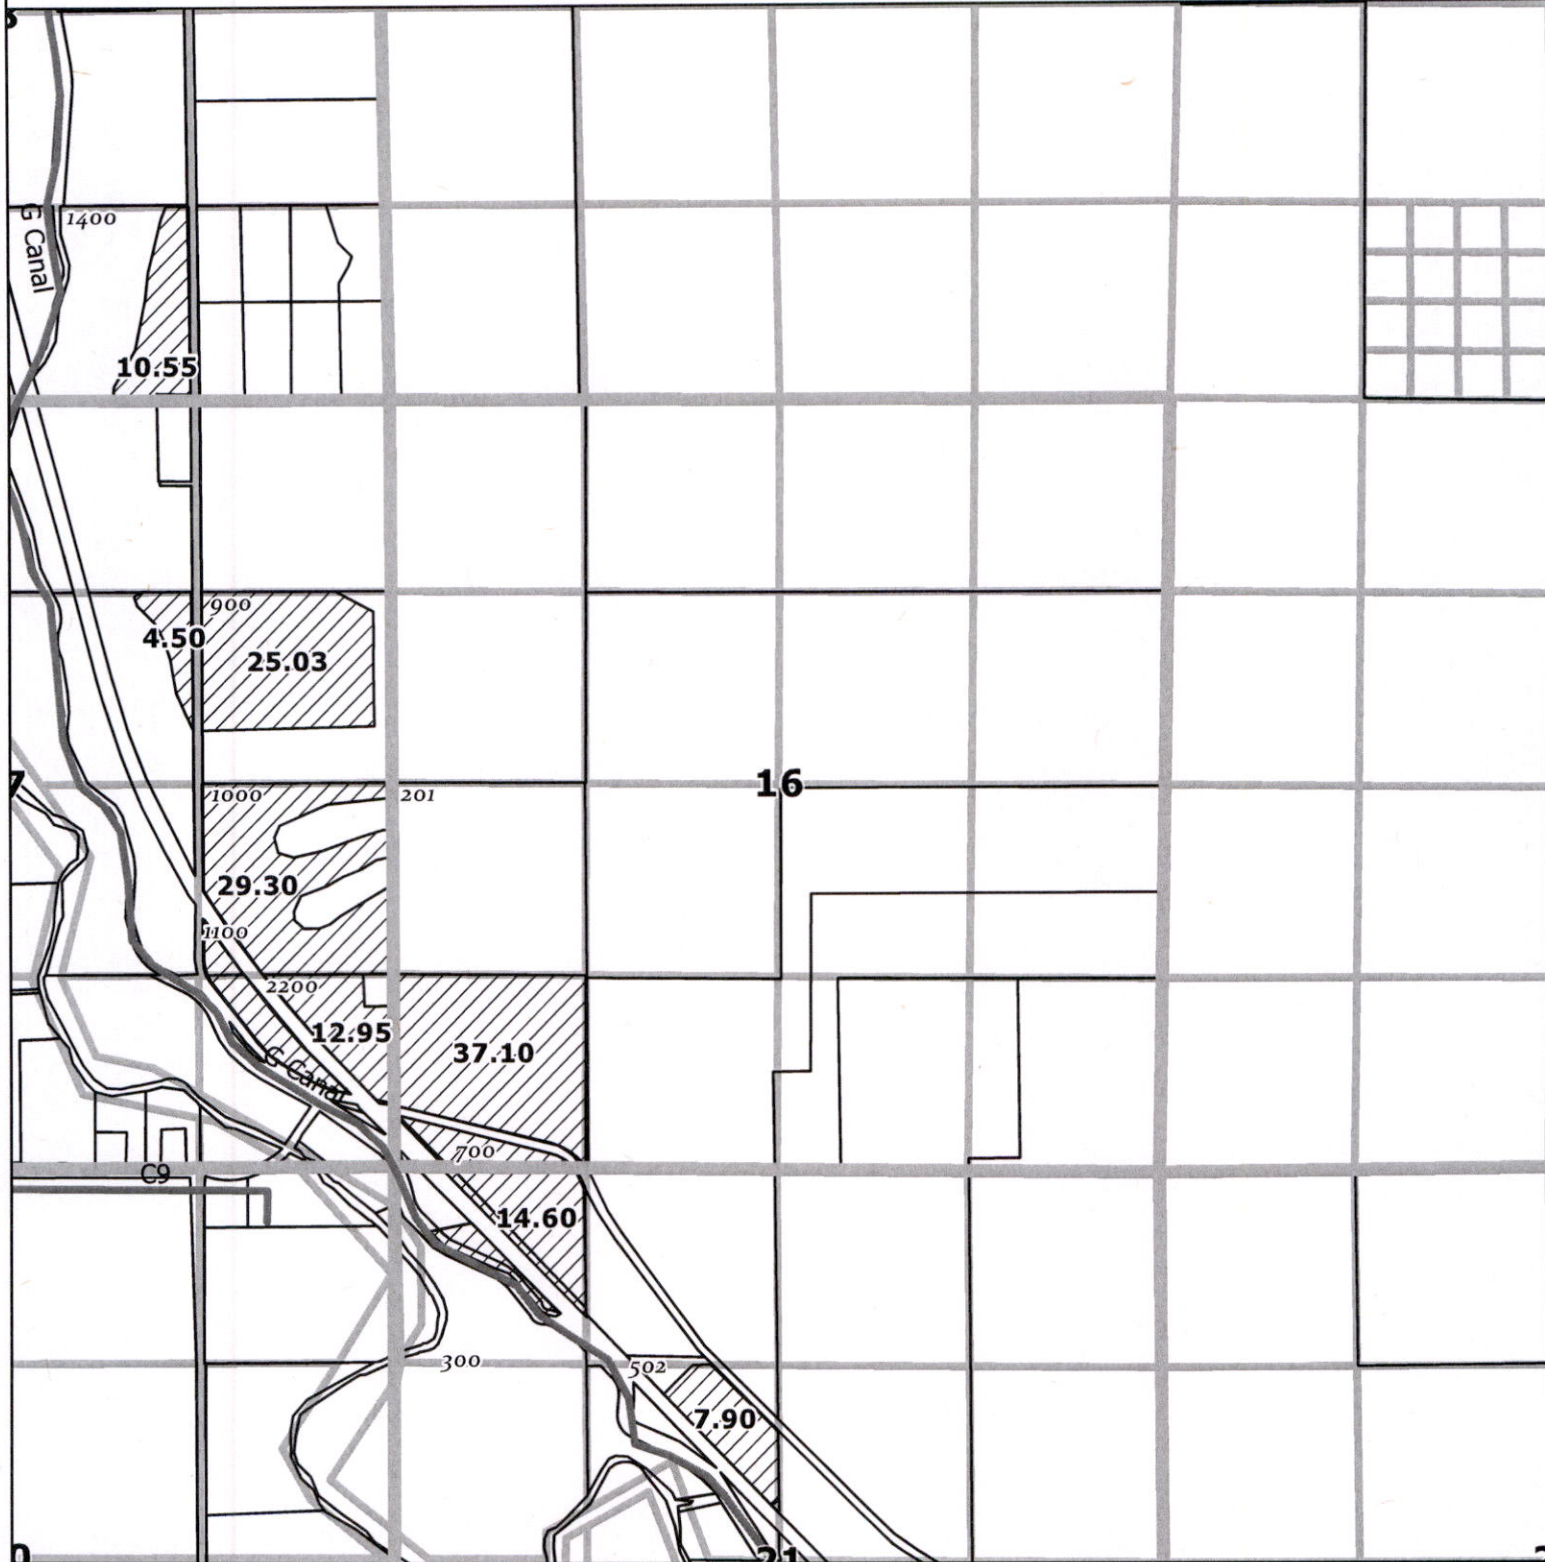

- Place of Use
- Klamath County Taxlot
- QQ Sections and Gov't Lots
- Map Series Sections
- Canal

Received
JUL 07 2025




1,320
Feet

OWRD

DISCLAIMER
This map is not intended to
provide legal dimensions or
locations of property
ownership lines


WATERSOLVING
johnw@watersolving.com

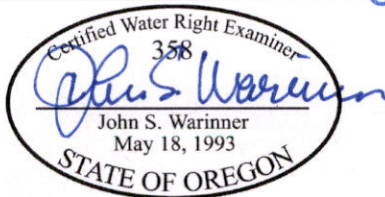

CLAIM OF BENEFICIAL USE MAP
APPLICATION G-16030
PERMIT G-18797
06/23/2025


Map No. 64

T S 40 R 10 S 17 E

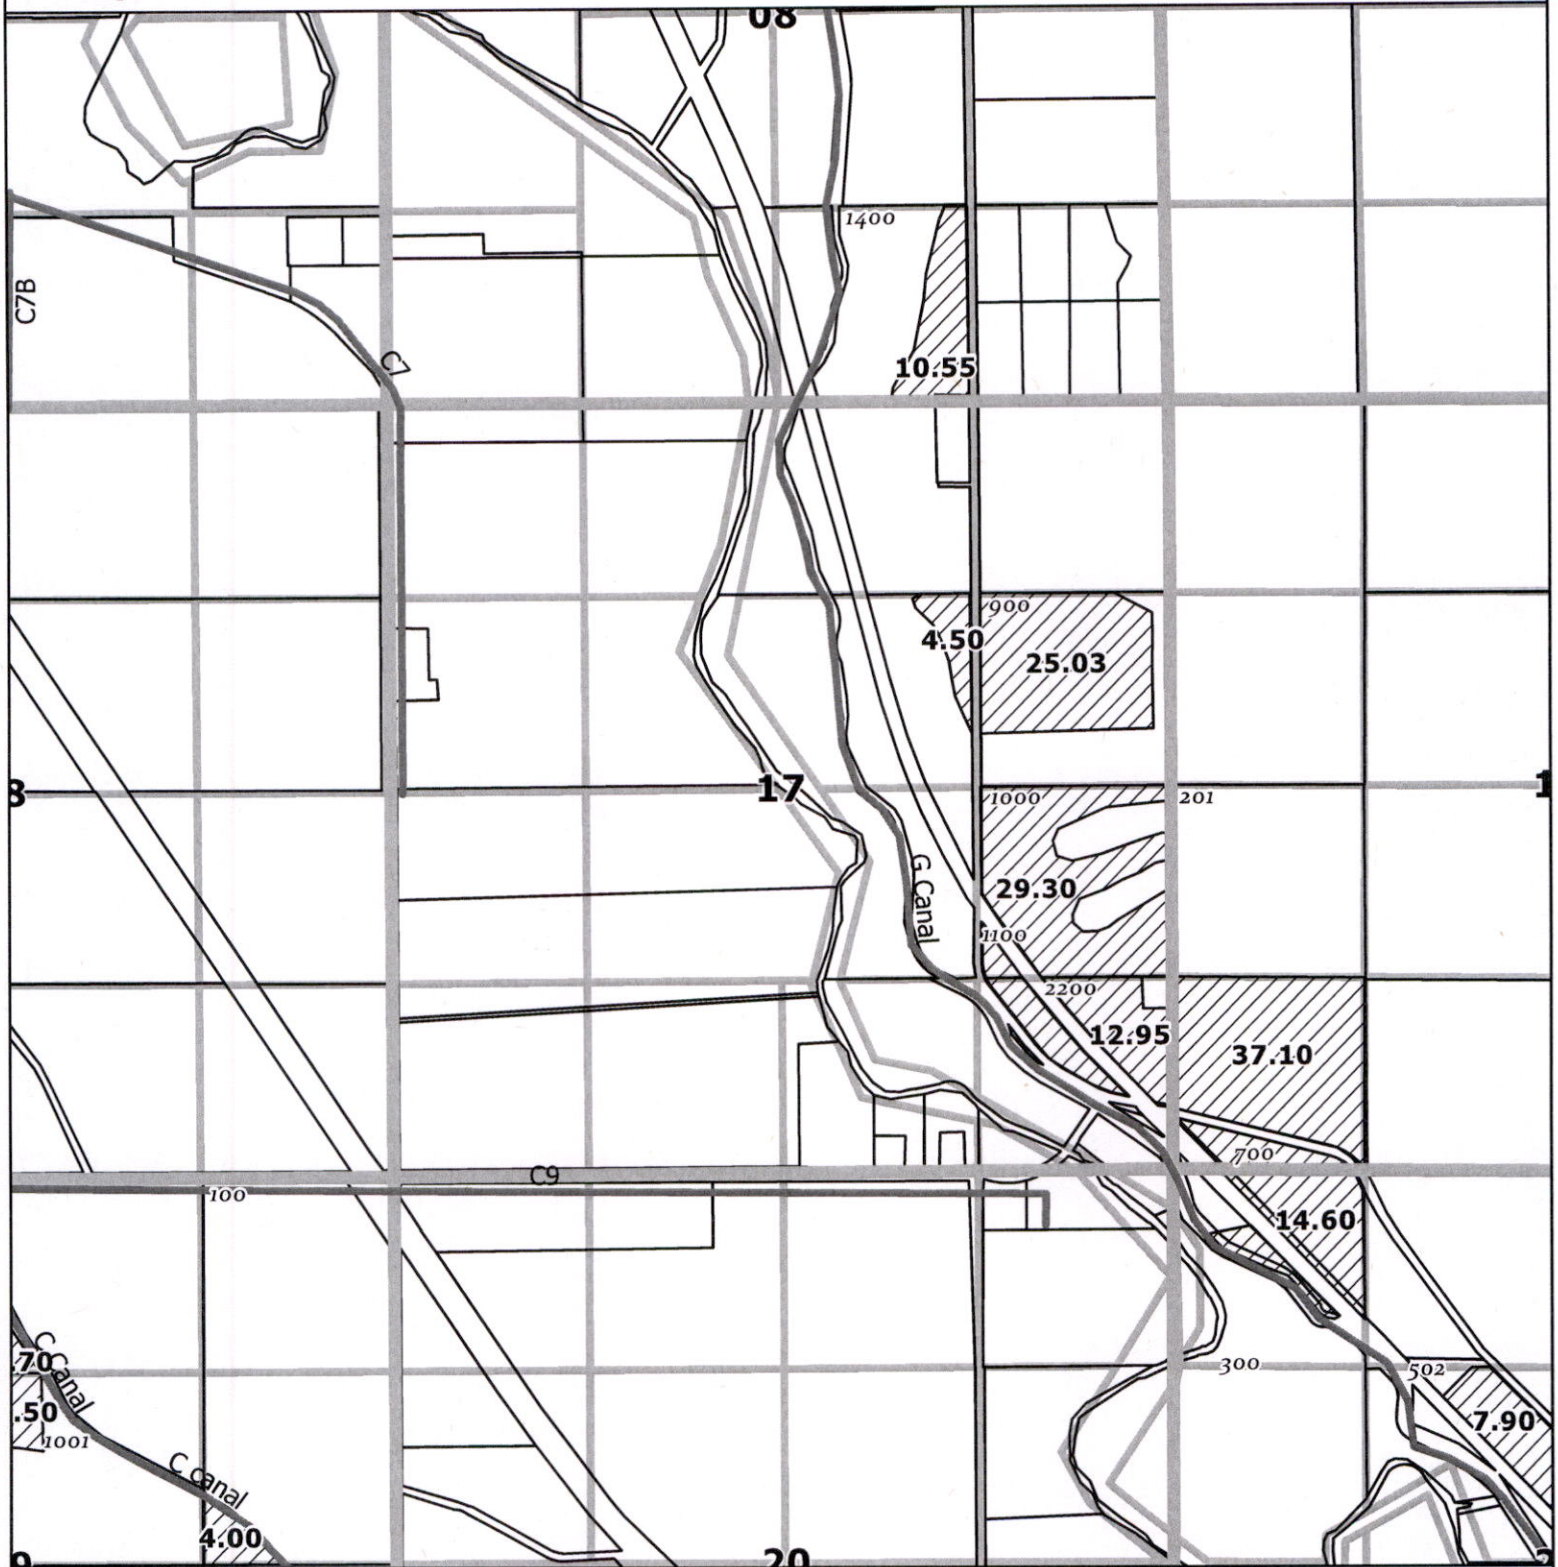


-  Place of Use
-  Klamath County Taxlot
-  QQ Sections and Gov't Lots
-  Map Series Sections
-  Canal

Received
JUL 07 2025
OWRD

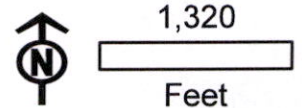

DISCLAIMER
This map is not intended to
provide legal dimensions or
locations of property
ownership lines


WATERSOLVING
johnw@watersolving.com

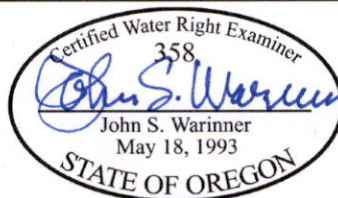

CLAIM OF BENEFICIAL USE MAP
APPLICATION G-16030
PERMIT G-18797
06/23/2025

Map No. 65

T S 40 R 10 E S 18

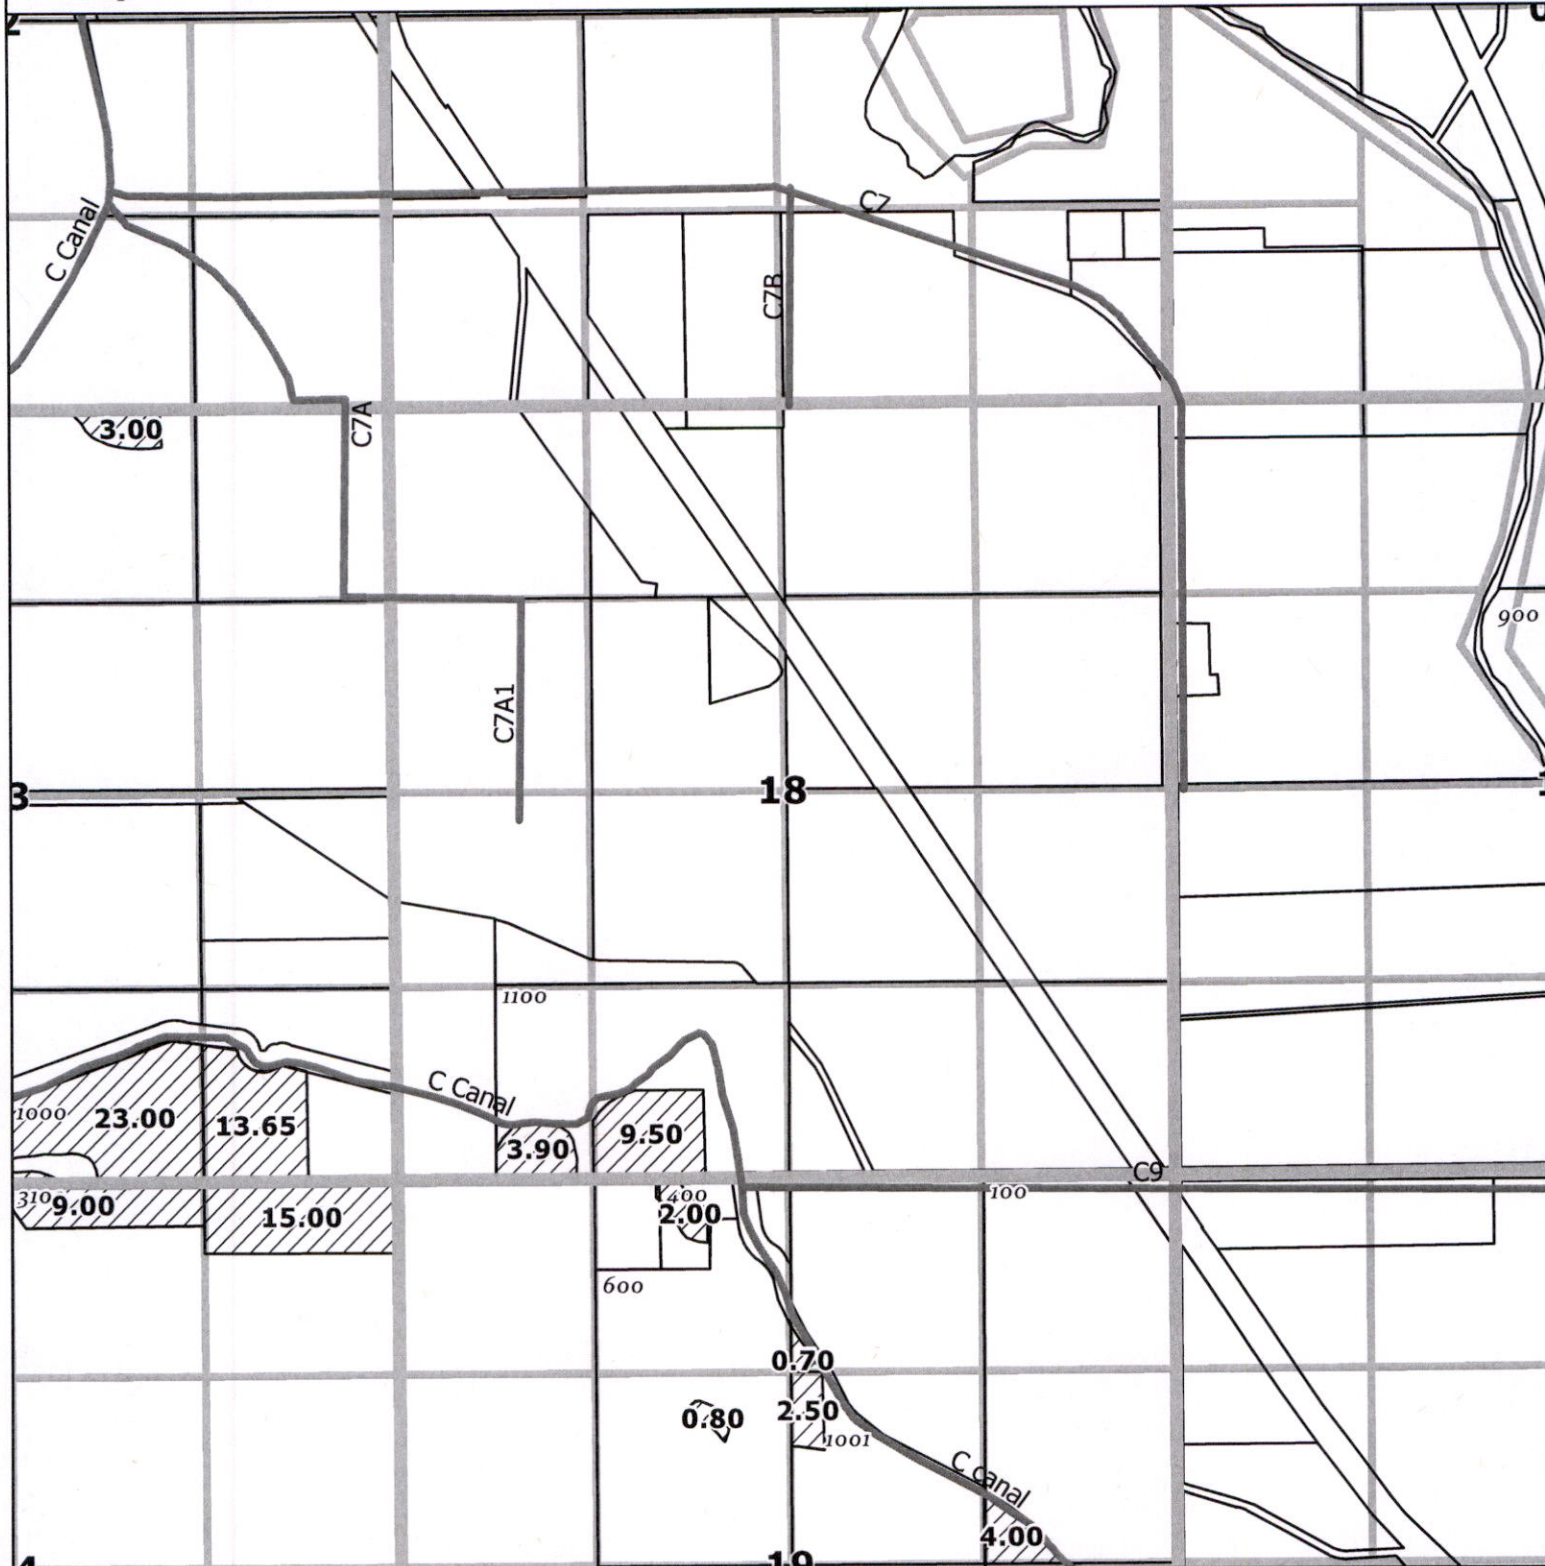

- Place of Use
- Klamath County Taxlot
- QQ Sections and Gov't Lots
- Map Series Sections
- Canal

Received

JUL 07 2025

OWRD




1,320

Feet

DISCLAIMER
This map is not intended to
provide legal dimensions or
locations of property
ownership lines


WATERSOLVING
johnw@watersolving.com

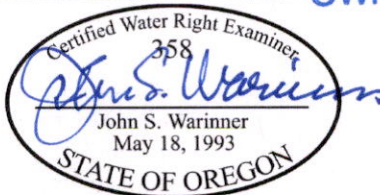

CLAIM OF BENEFICIAL USE MAP
APPLICATION G-16030
PERMIT G-18797
06/23/2025


Map No. 66

T 40 S 10 E S 19

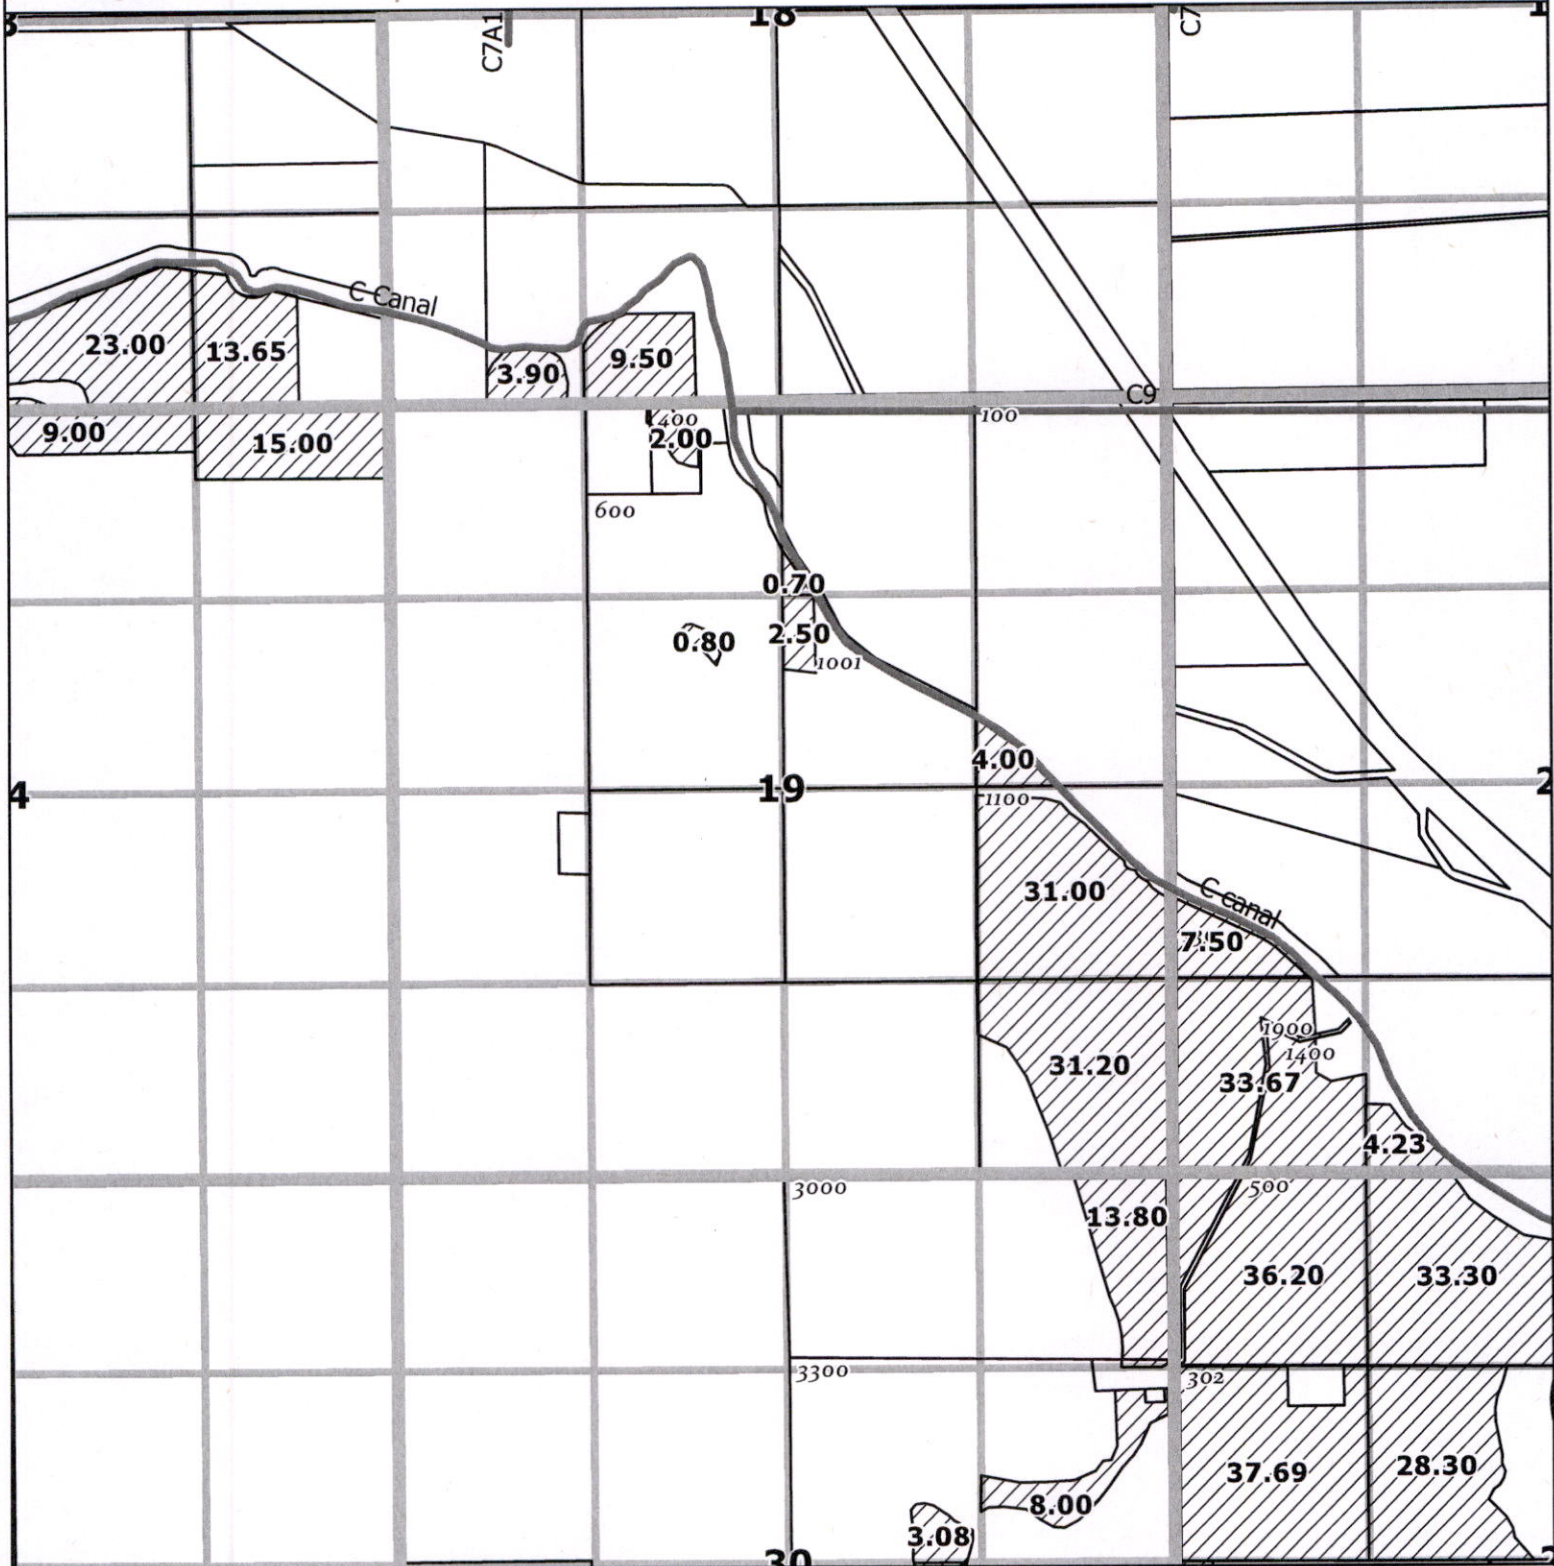


- Place of Use
- Klamath County Taxlot
- QQ Sections and Gov't Lots
- Map Series Sections
- Canal

Received
JUL 07 2025
OWRD

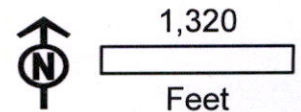

DISCLAIMER
This map is not intended to
provide legal dimensions or
locations of property
ownership lines


WATERSOLVING
johnw@watersolving.com

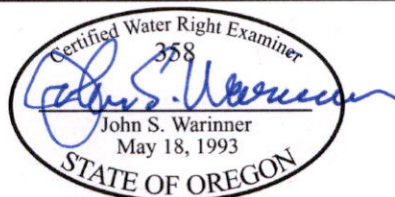

CLAIM OF BENEFICIAL USE MAP
APPLICATION G-16030
PERMIT G-18797
06/23/2025

Map No. 67

T 40 S 10 R 20 E S 20

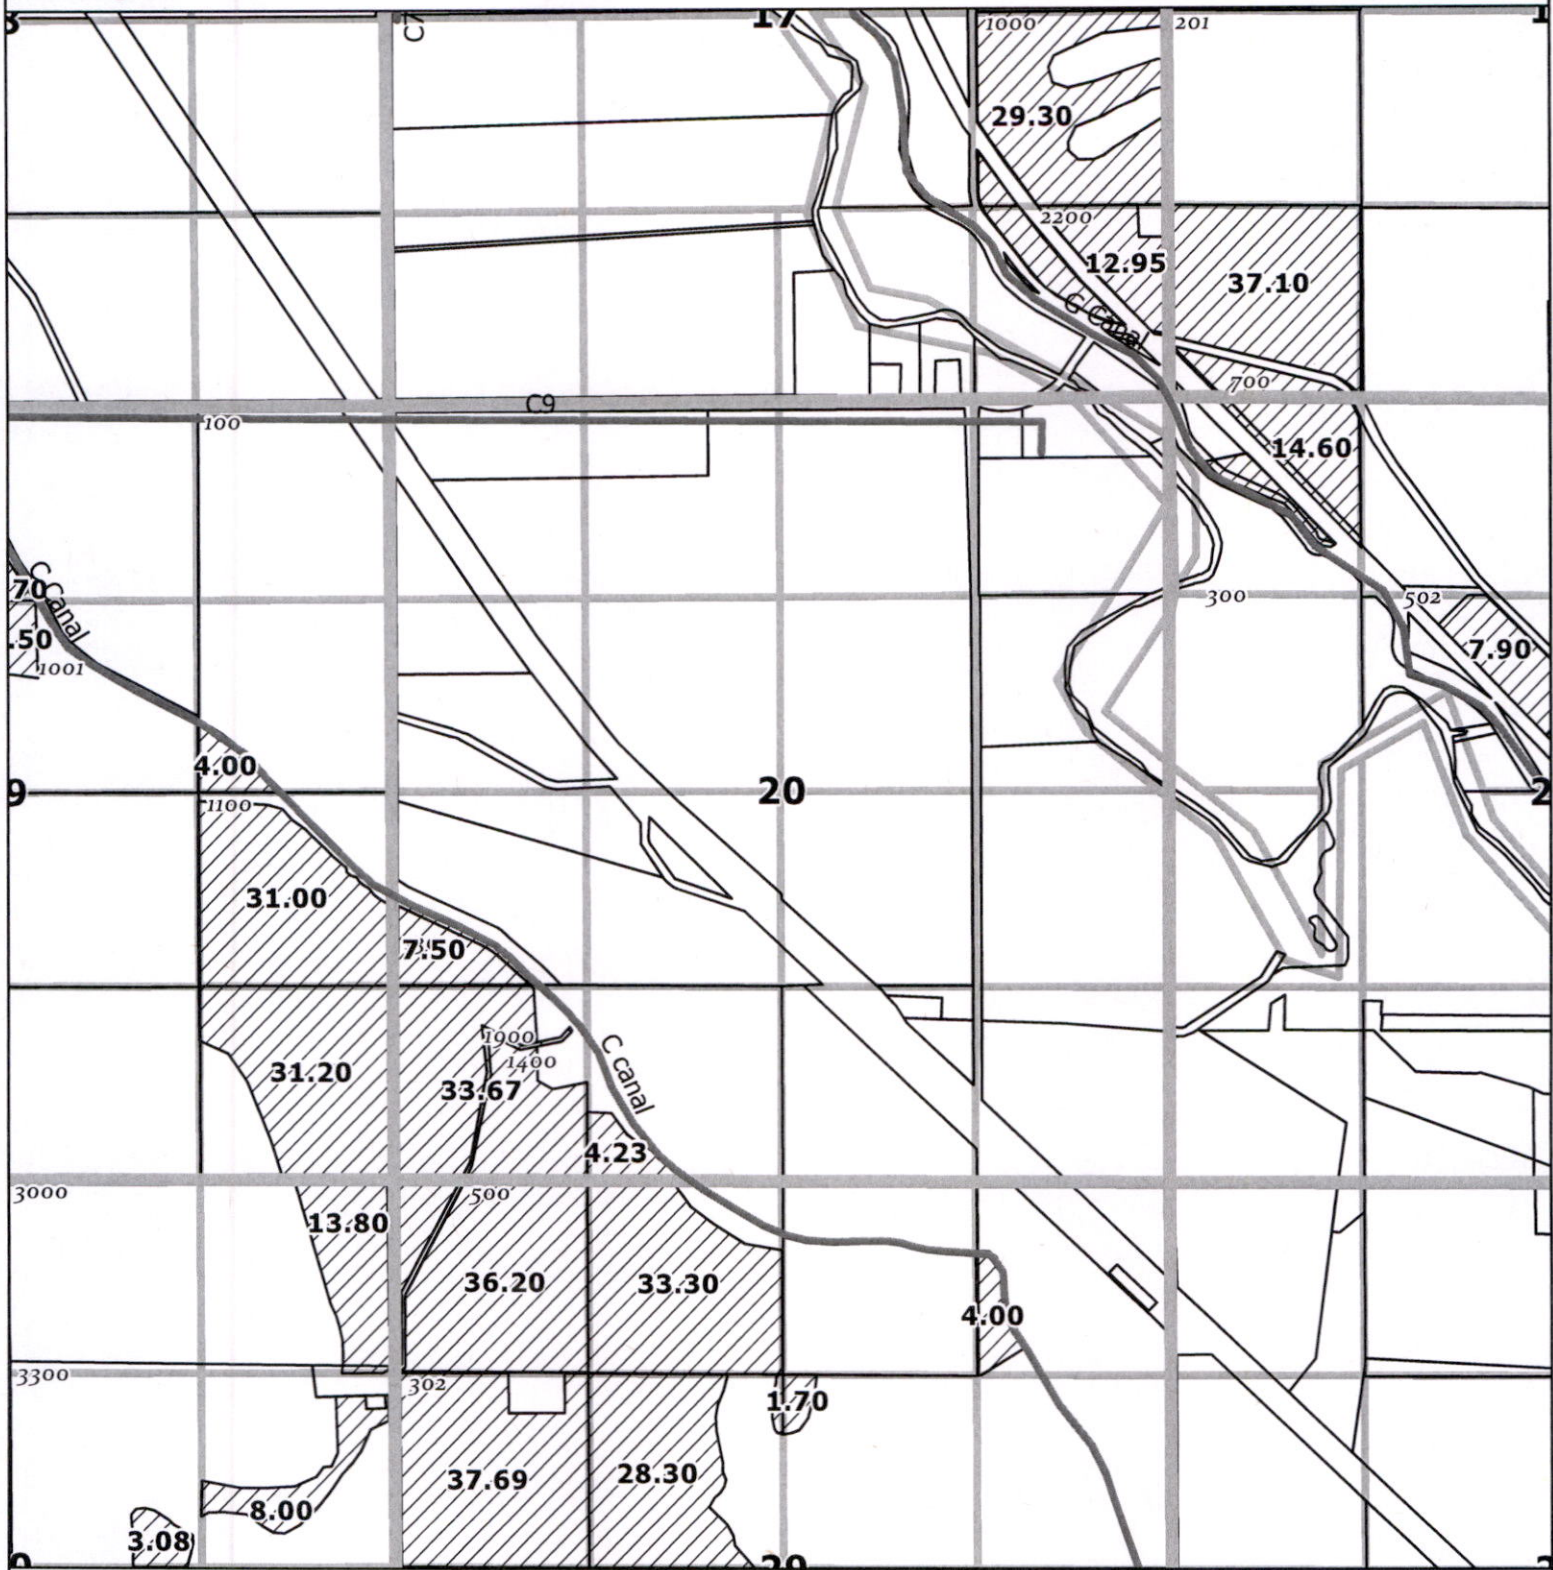

- Place of Use
- Klamath County Taxlot
- QQ Sections and Gov't Lots
- Map Series Sections
- Canal


Received
JUL 07 2025
OWRD



1,320
Feet

DISCLAIMER
This map is not intended to
provide legal dimensions or
locations of property
ownership lines


WATERSOLVING
johnw@watersolving.com

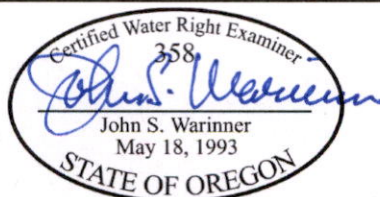

CLAIM OF BENEFICIAL USE MAP
APPLICATION G-16030
PERMIT G-18797
06/23/2025


Map No. 68

T 40 S 10 E S 21

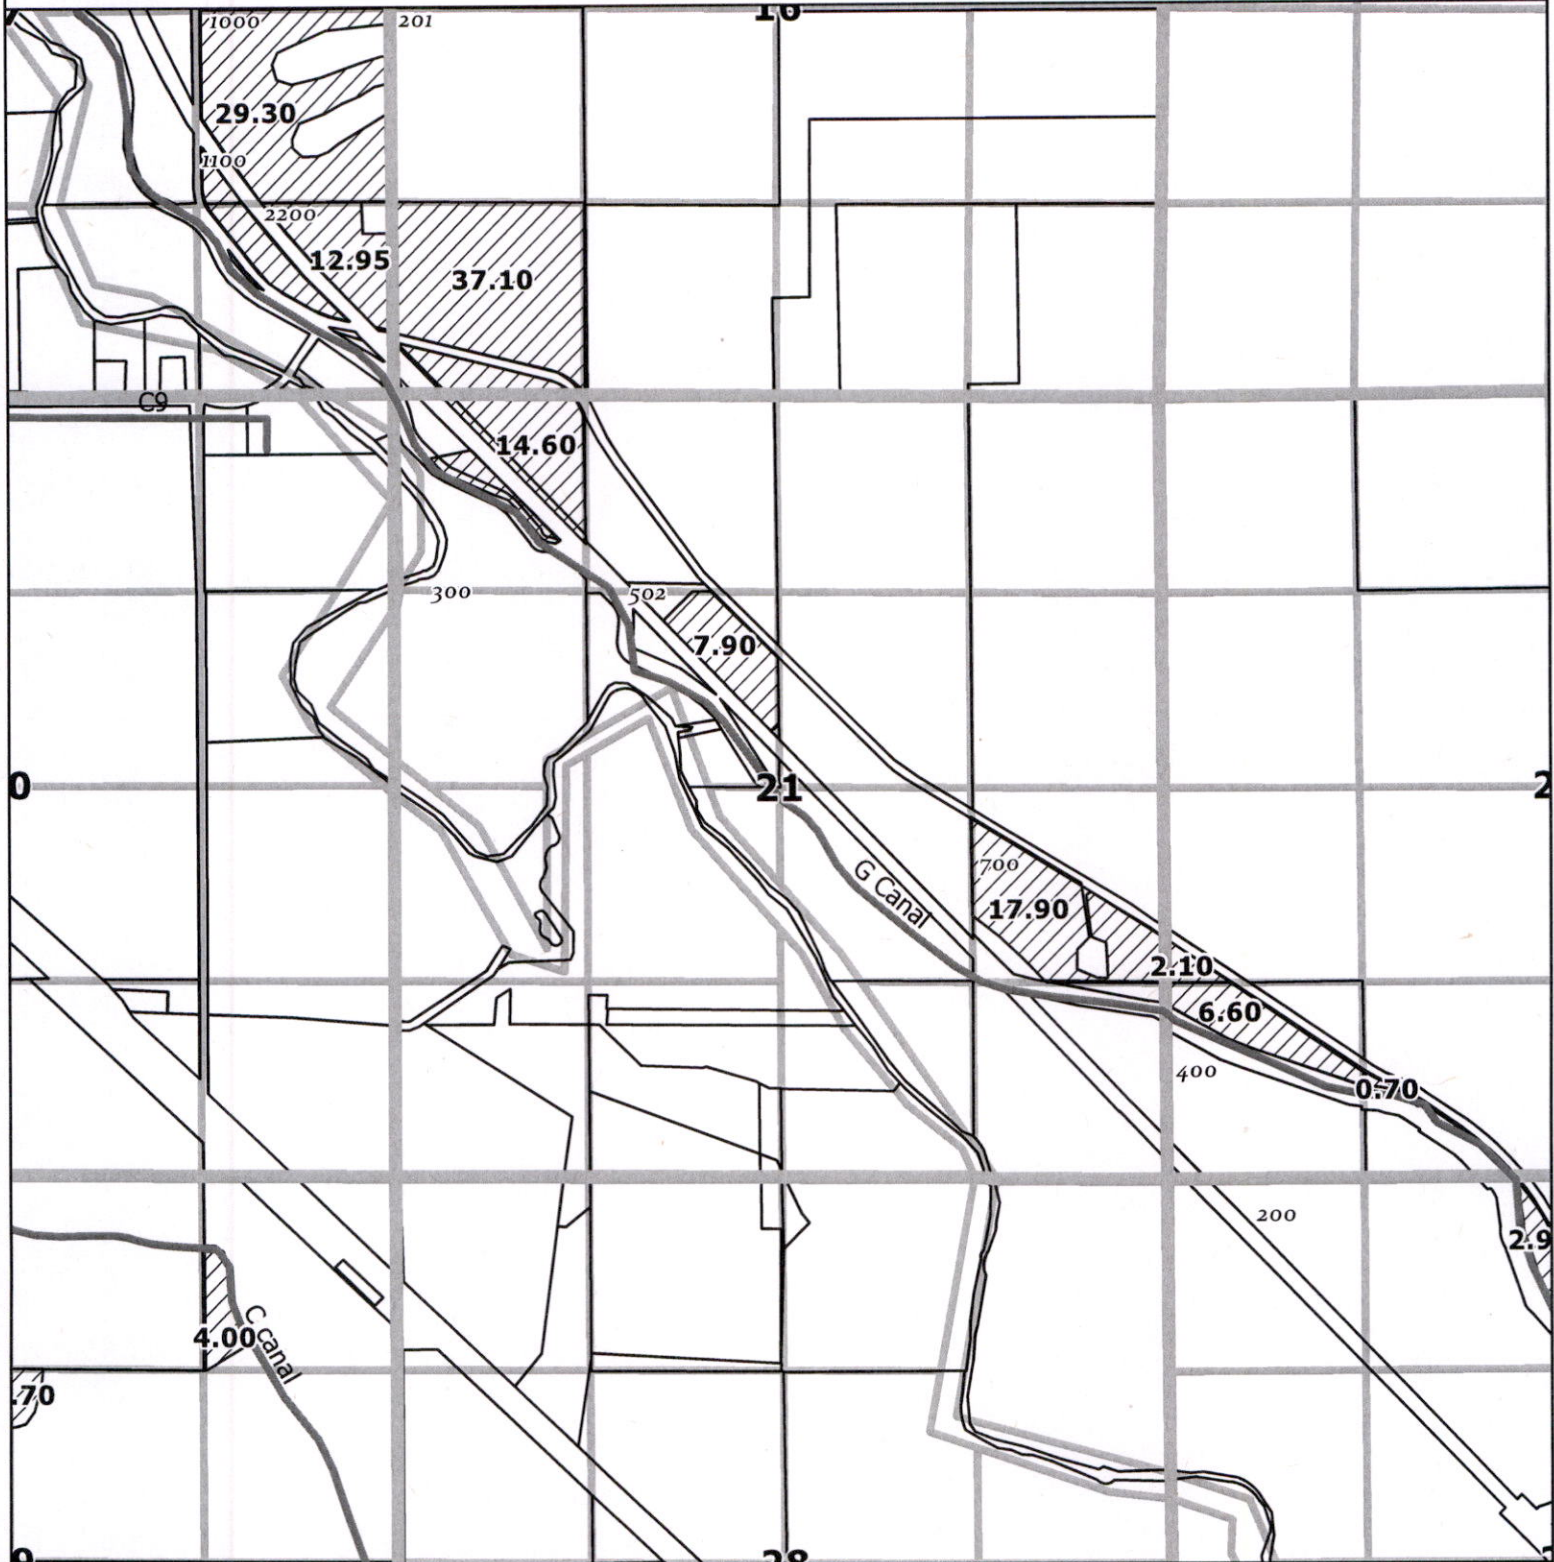


- Place of Use
- Klamath County Taxlot
- QQ Sections and Gov't Lots
- Map Series Sections
- Canal

Received
JUL 07 2025
OWRD

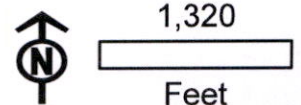

DISCLAIMER
This map is not intended to
provide legal dimensions or
locations of property
ownership lines


WATERSOLVING
johnw@watersolving.com

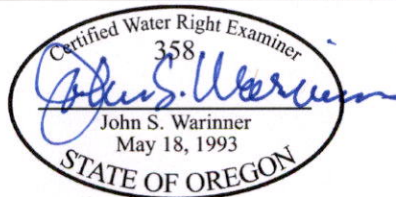

CLAIM OF BENEFICIAL USE MAP
APPLICATION G-16030
PERMIT G-18797
06/23/2025


Map No. 69

T 40 S 10 R 22 E S 22

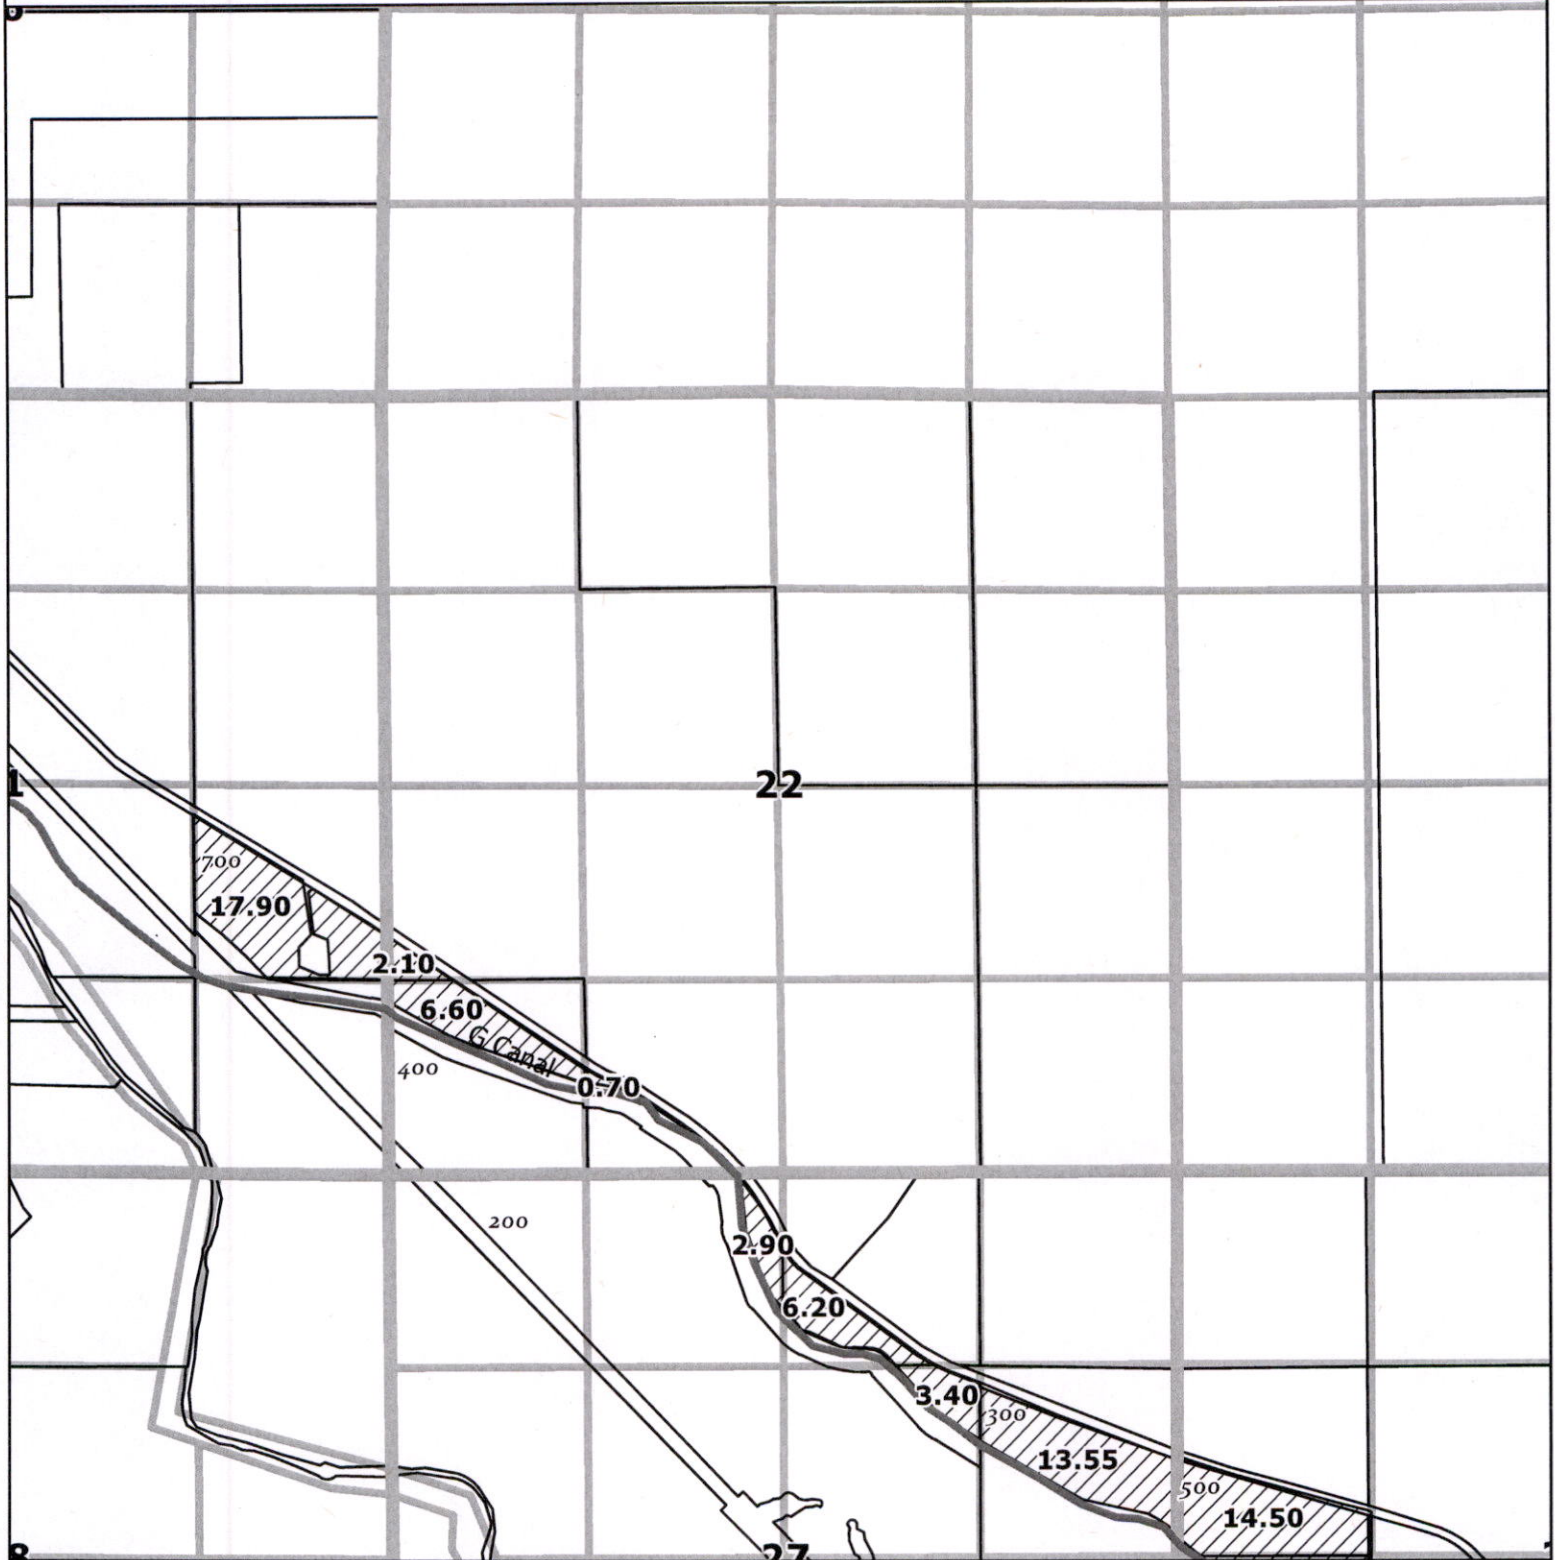


- Place of Use
- Klamath County Taxlot
- QQ Sections and Gov't Lots
- Map Series Sections
- Canal

Received
JUL 07 2025
OWRD

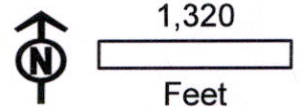

DISCLAIMER
This map is not intended to
provide legal dimensions or
locations of property
ownership lines


WATERSOLVING
johnw@watersolving.com

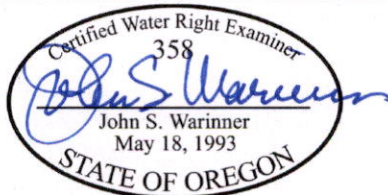

CLAIM OF BENEFICIAL USE MAP
APPLICATION G-16030
PERMIT G-18797
06/23/2025


Map No. 70

T S 40 R 10 S 25 E

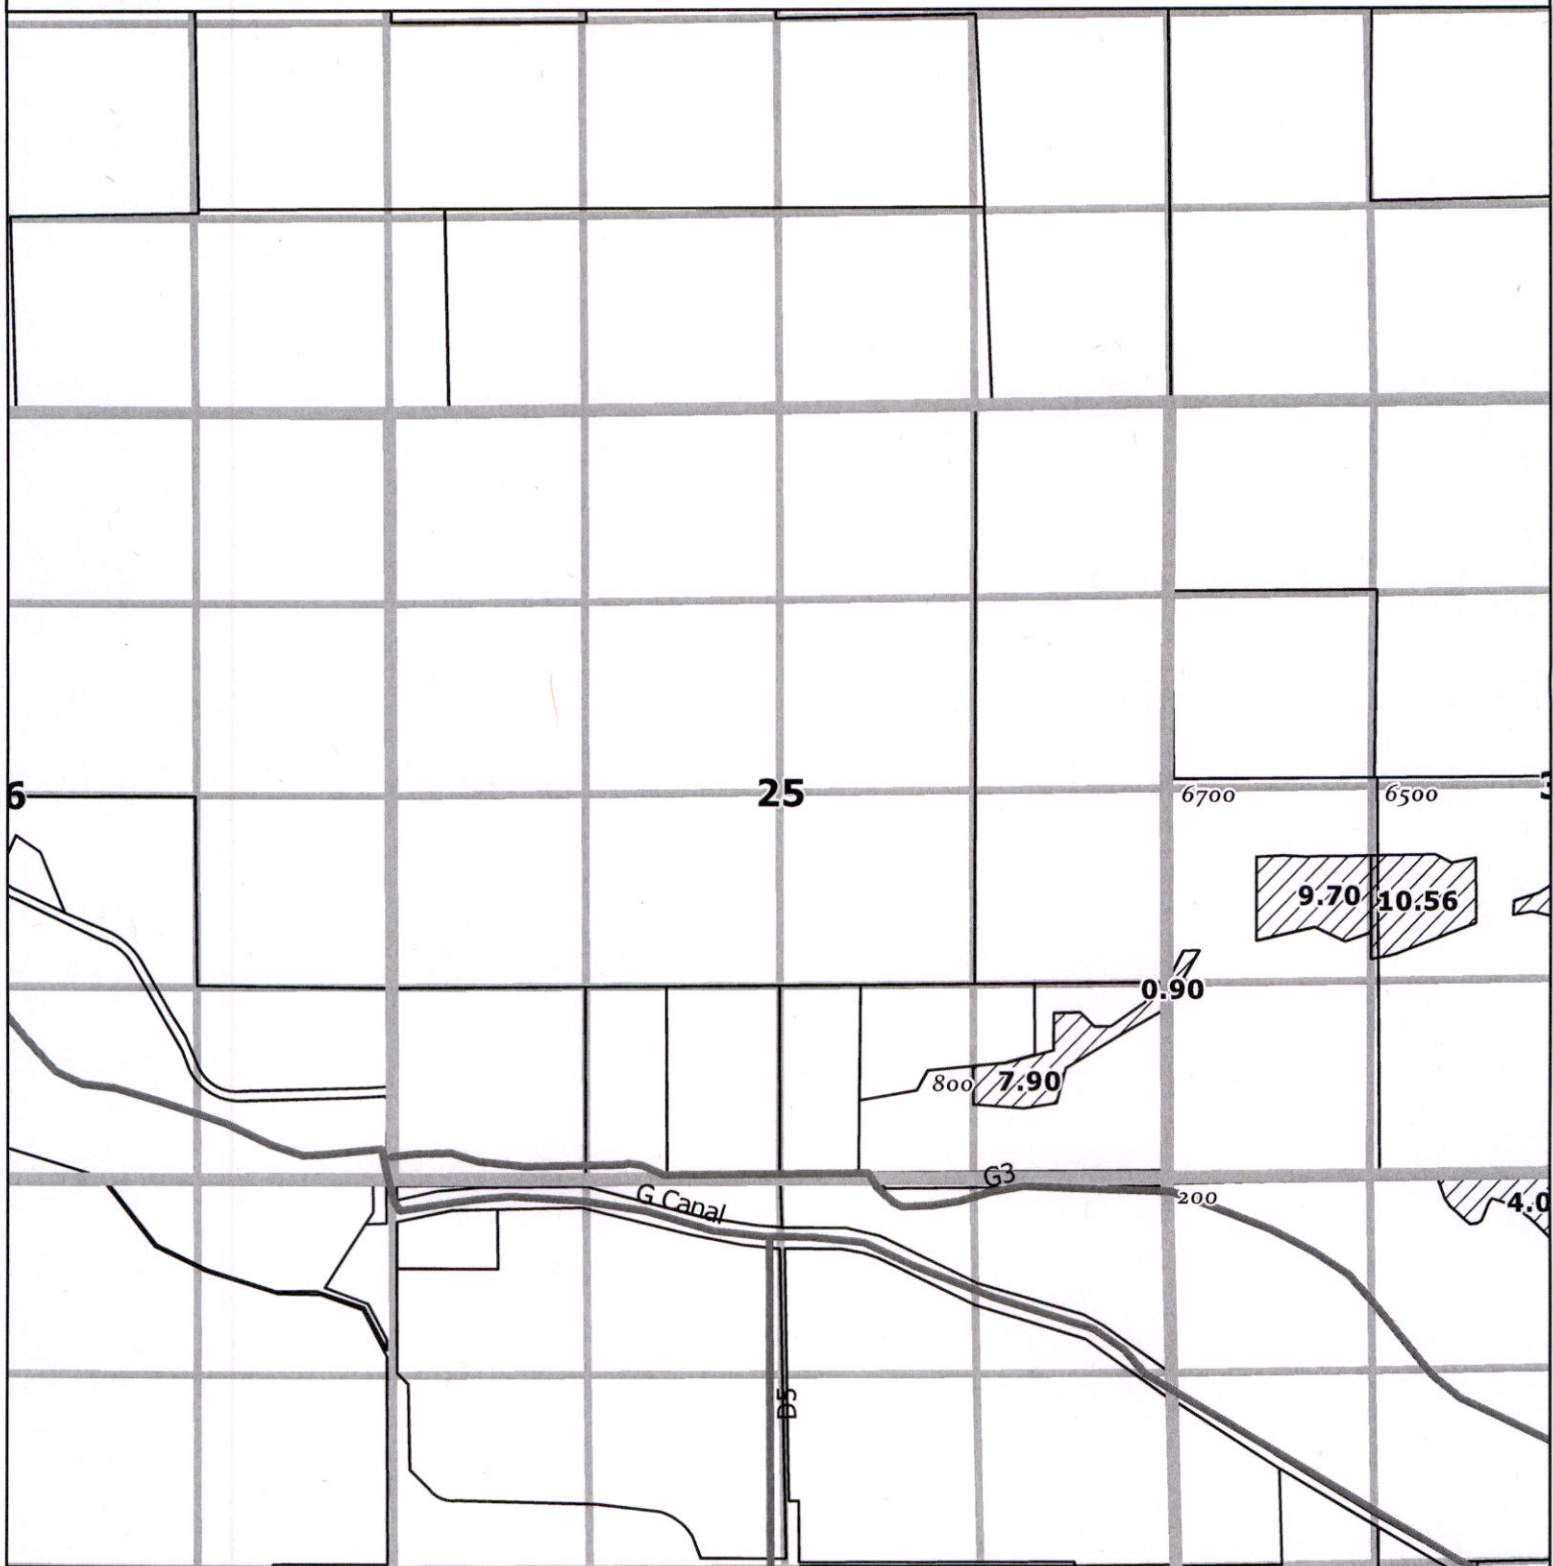


- Place of Use
- Klamath County Taxlot
- QQ Sections and Gov't Lots
- Map Series Sections
- Canal

Received
JUL 07 2025
OWRD

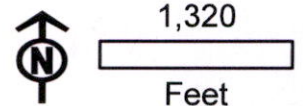

DISCLAIMER
This map is not intended to
provide legal dimensions or
locations of property
ownership lines


WATERSOLVING
johnw@watersolving.com

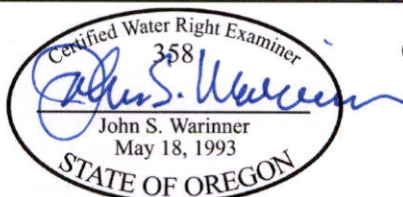

CLAIM OF BENEFICIAL USE MAP
APPLICATION G-16030
PERMIT G-18797
06/23/2025


Map No. 71

T 40 S 10 E S 26

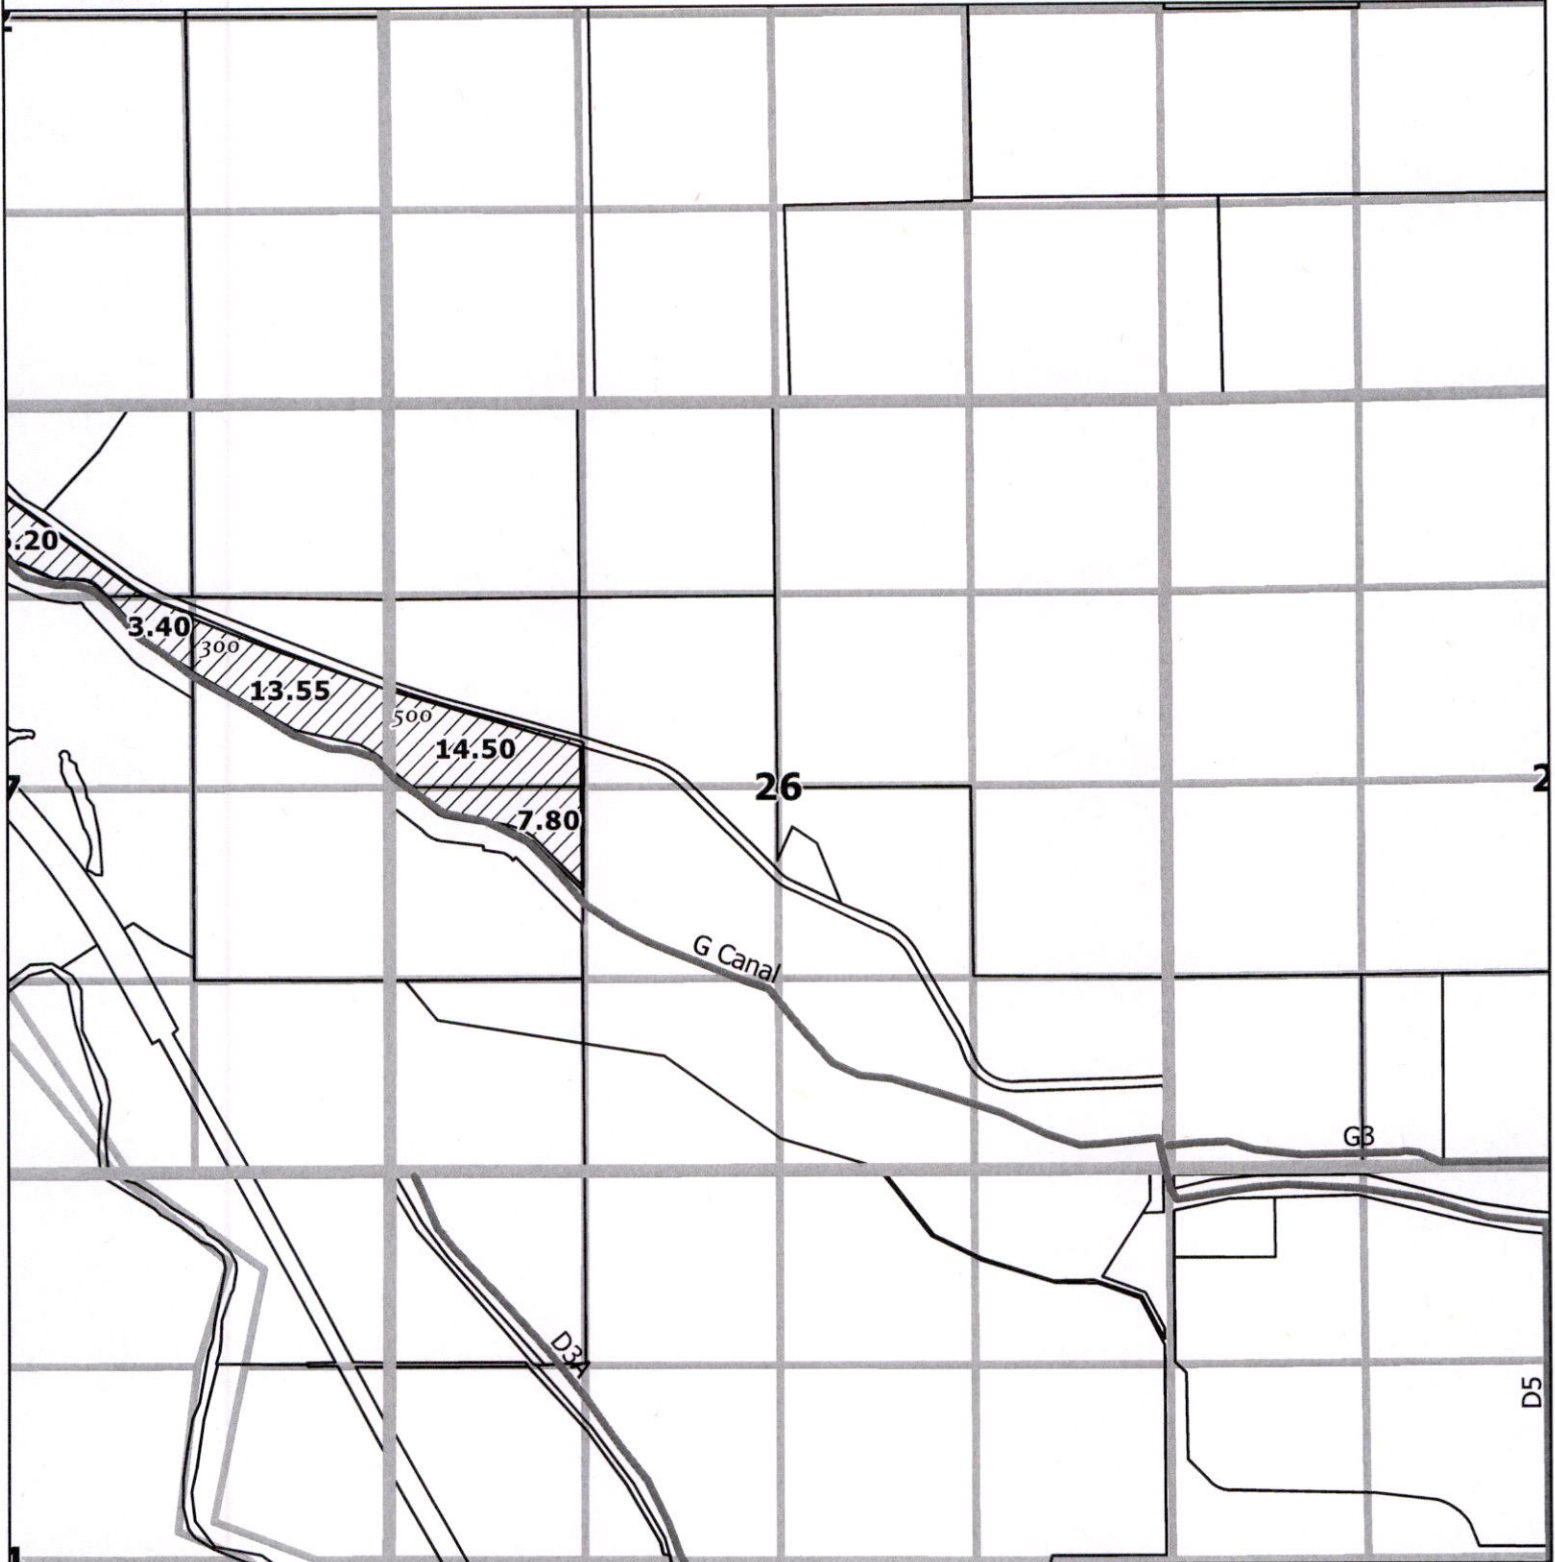

- Place of Use
- Klamath County Taxlot
- QQ Sections and Gov't Lots
- Map Series Sections
- Canal


Received
JUL 07 2025

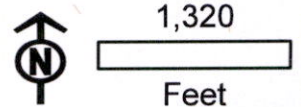

OWRD

DISCLAIMER
This map is not intended to
provide legal dimensions or
locations of property
ownership lines


WATERSOLVING
johnw@watersolving.com

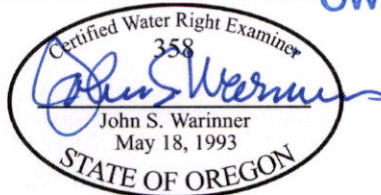

CLAIM OF BENEFICIAL USE MAP
APPLICATION G-16030
PERMIT G-18797
06/23/2025


Map No. 72

T 40 S 10 E S 27

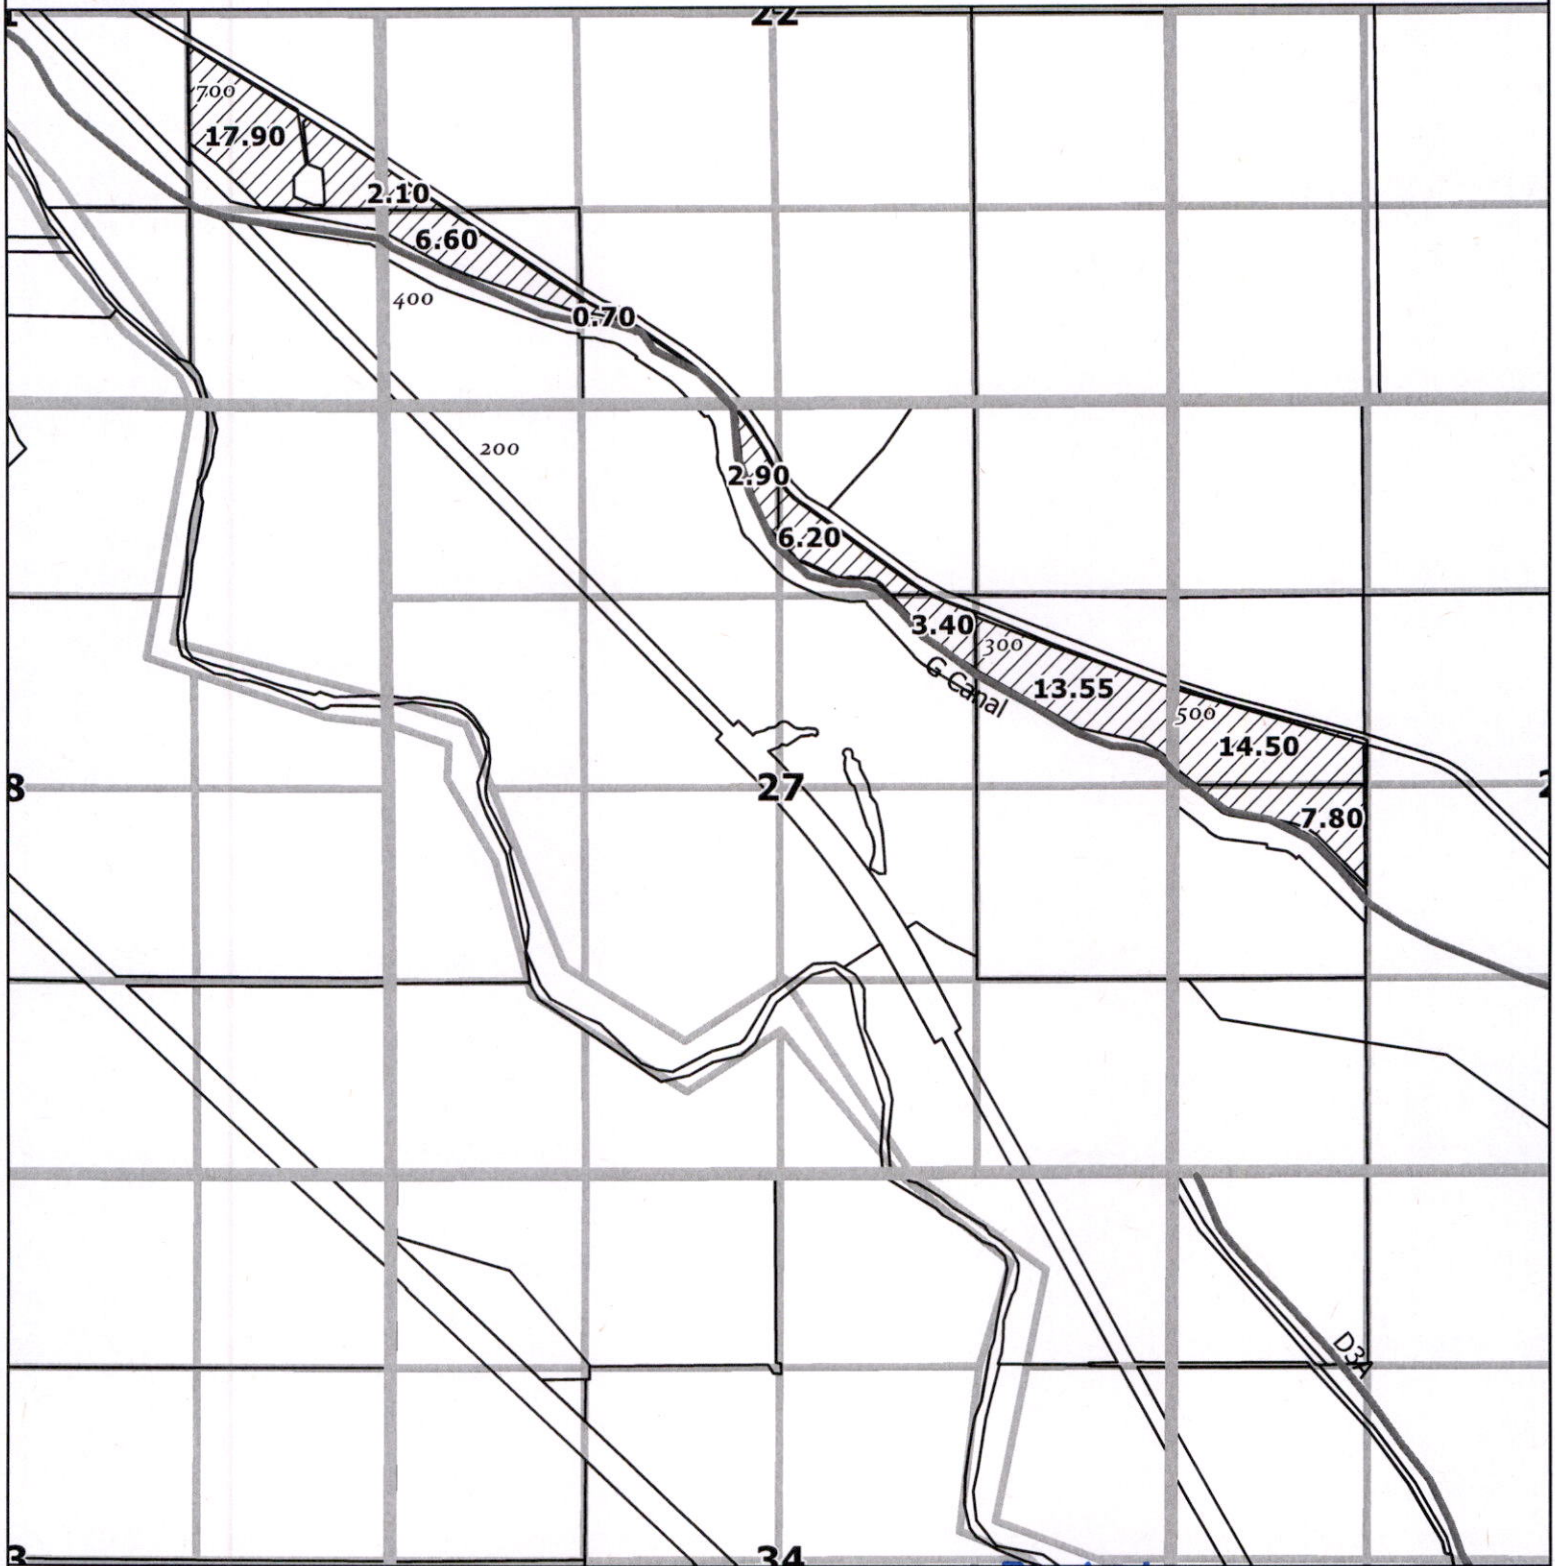


- Place of Use
- Klamath County Taxlot
- QQ Sections and Gov't Lots
- Map Series Sections
- Canal

Received
JUL 07 2025
OWRD

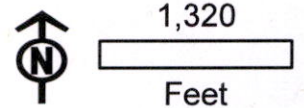

DISCLAIMER
This map is not intended to provide legal dimensions or locations of property ownership lines


WATERSOLVING
johnw@watersolving.com

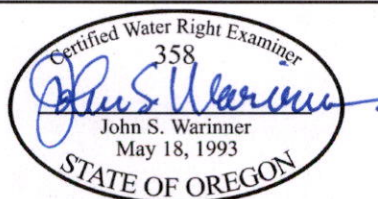

CLAIM OF BENEFICIAL USE MAP
APPLICATION G-16030
PERMIT G-18797
06/23/2025


Map No. 73

T S 40 R 10 S 28 E 28

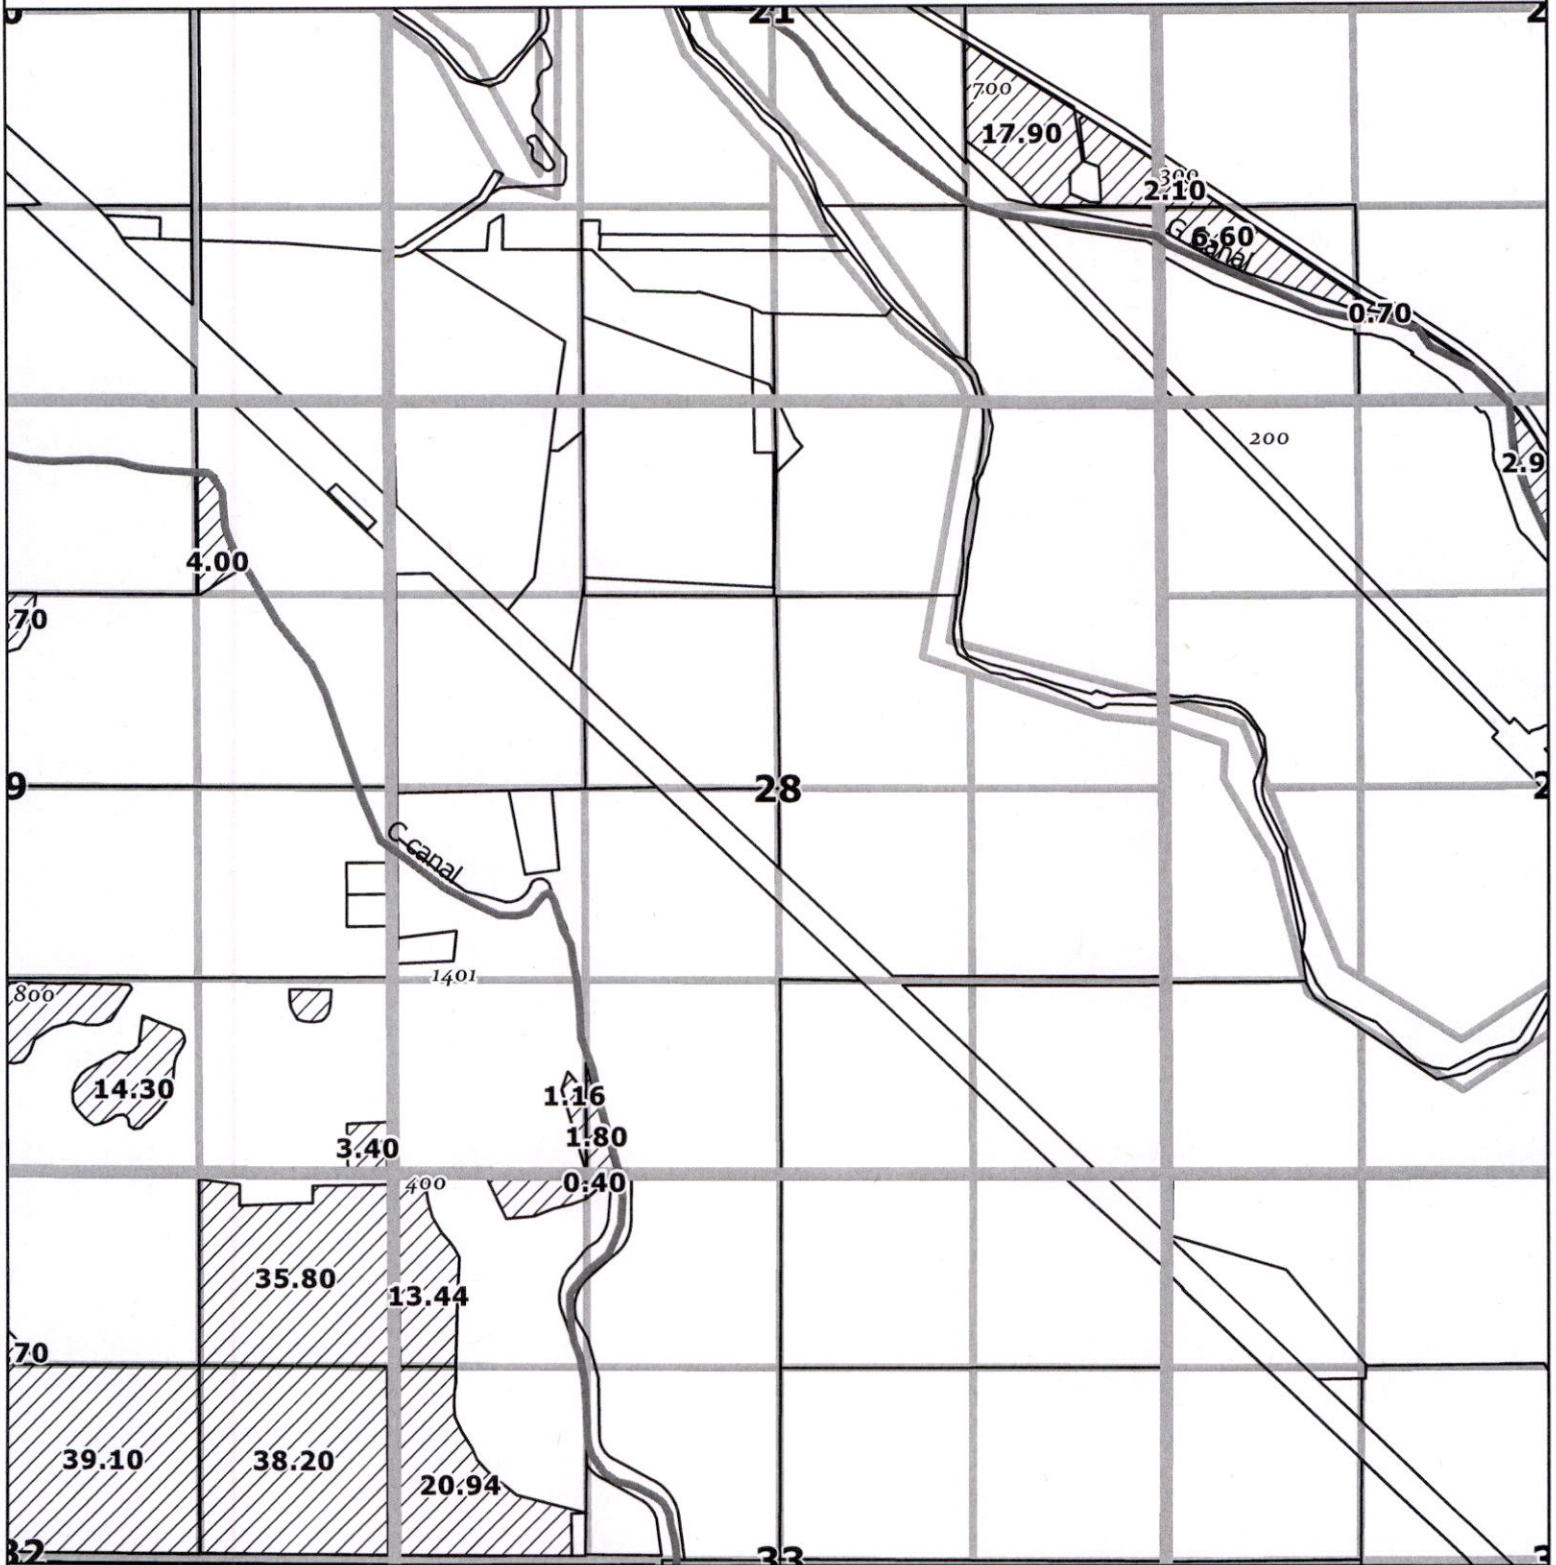


- Place of Use
- Klamath County Taxlot
- QQ Sections and Gov't Lots
- Map Series Sections
- Canal

Received
JUL 07 2025
OWRD

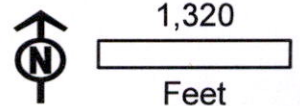

DISCLAIMER
This map is not intended to
provide legal dimensions or
locations of property
ownership lines


WATERSOLVING
johnw@watersolving.com

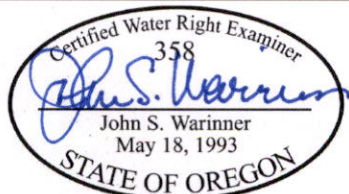

CLAIM OF BENEFICIAL USE MAP
APPLICATION G-16030
PERMIT G-18797
06/23/2025


Map No. 74

T S 40 R 10 S 29 E 29

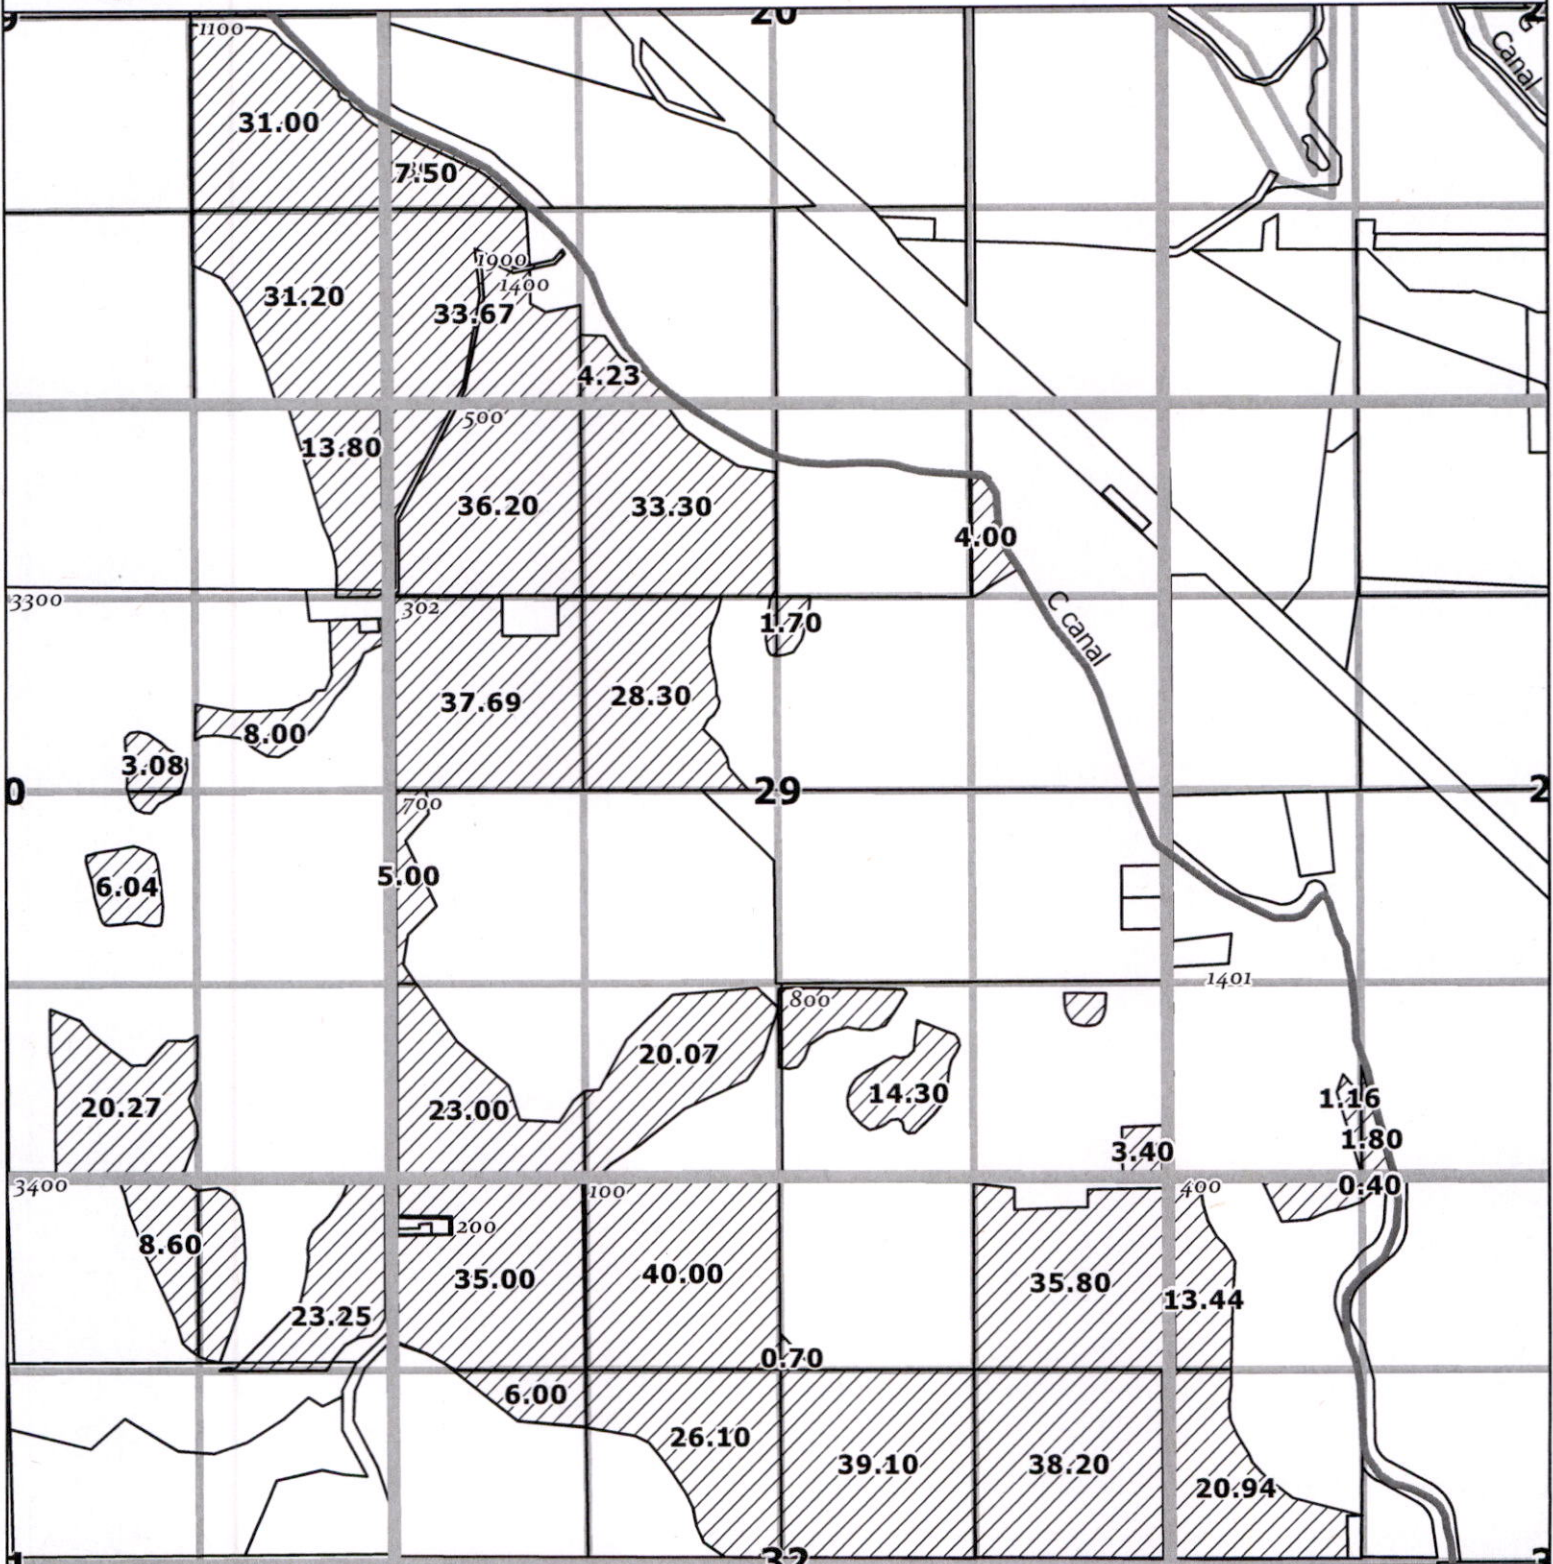


- Place of Use
- Klamath County Taxlot
- QQ Sections and Gov't Lots
- Map Series Sections
- Canal

Received
JUL 07 2025
OWRD

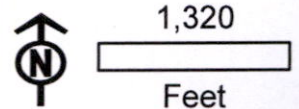

DISCLAIMER
This map is not intended to
provide legal dimensions or
locations of property
ownership lines


WATERSOLVING
johnw@watersolving.com

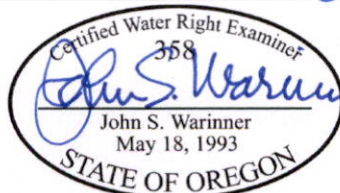

CLAIM OF BENEFICIAL USE MAP
APPLICATION G-16030
PERMIT G-18797
06/23/2025

Map No. 75

T S 40 R 10 S 30 E 30

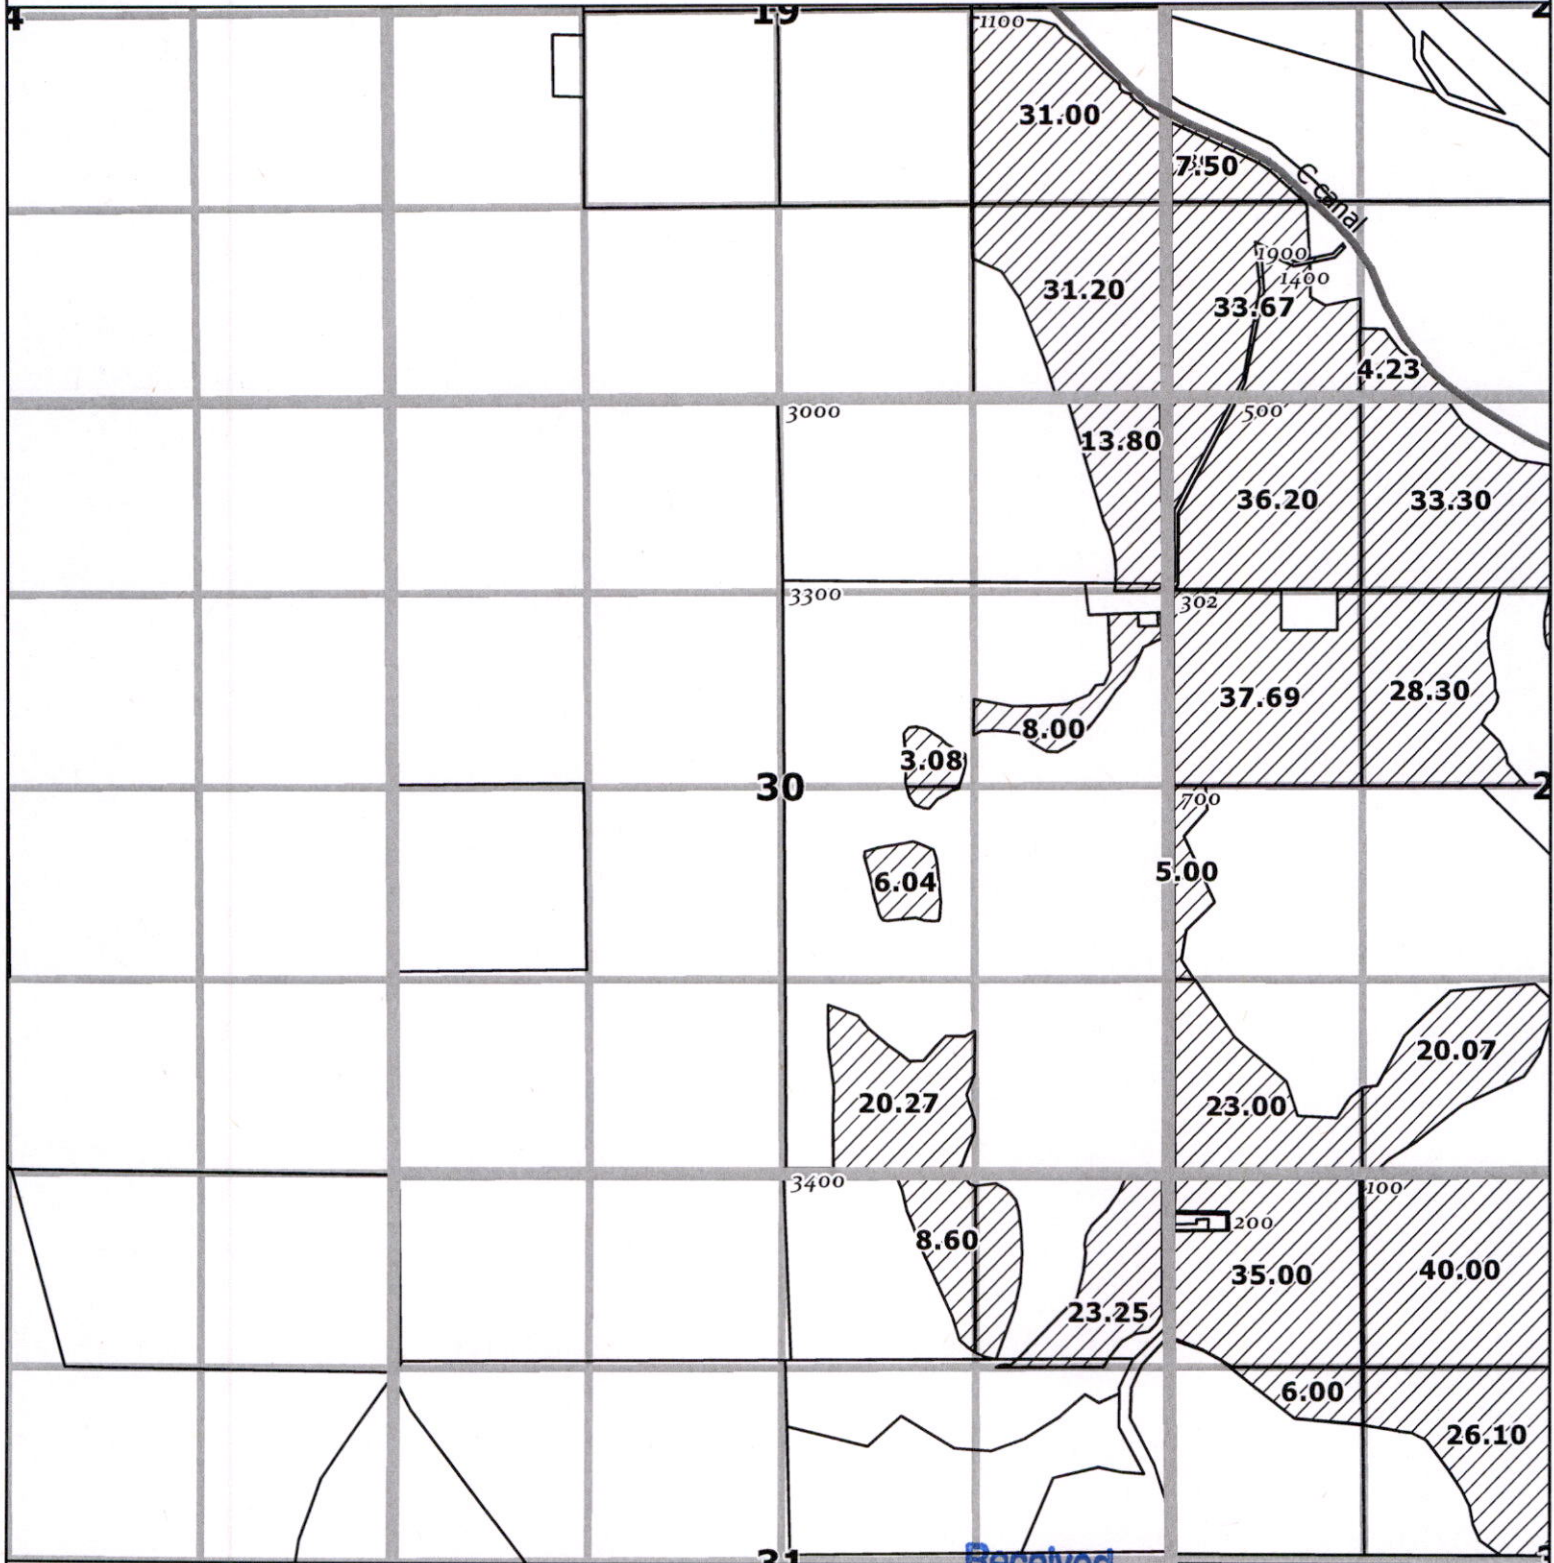

- Place of Use
- Klamath County Taxlot
- QQ Sections and Gov't Lots
- Map Series Sections
- Canal


Received
JUL 07 2025
OWRD



1,320
Feet

DISCLAIMER
This map is not intended to
provide legal dimensions or
locations of property
ownership lines


WATERSOLVING
johnw@watersolving.com

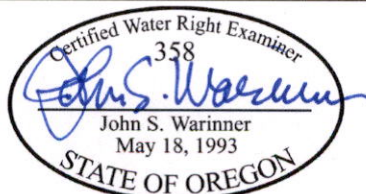

CLAIM OF BENEFICIAL USE MAP
APPLICATION G-16030
PERMIT G-18797
06/23/2025

Map No. 76

T S 40 R 10 S 31 E

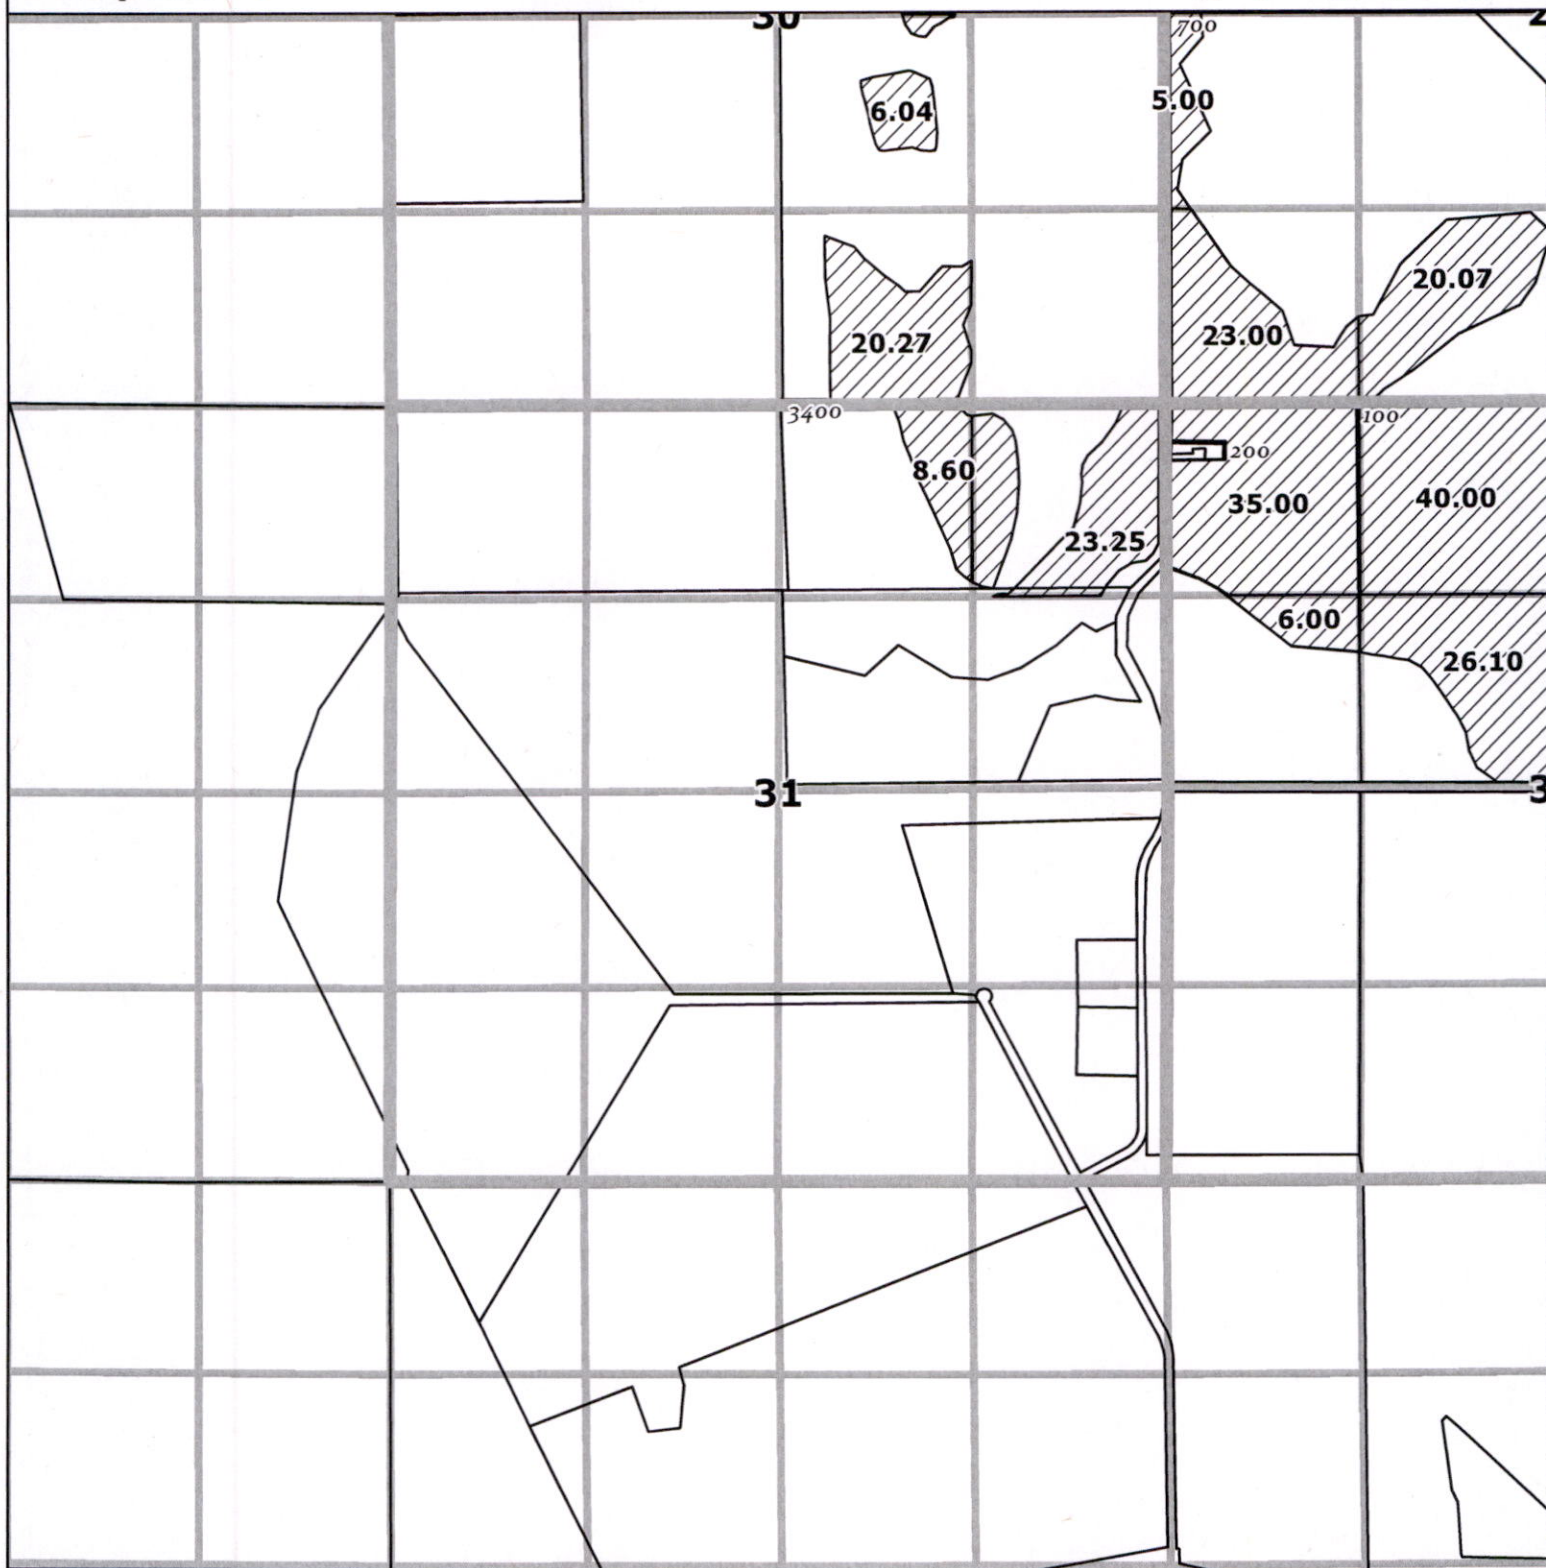

- Place of Use
- Klamath County Taxlot
- QQ Sections and Gov't Lots
- Map Series Sections
- Canal

Received

JUL 07 2025

OWRD




1,320

Feet

DISCLAIMER
This map is not intended to
provide legal dimensions or
locations of property
ownership lines


WATERSOLVING
johnw@watersolving.com

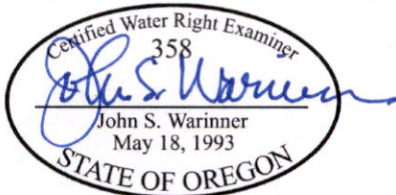

CLAIM OF BENEFICIAL USE MAP
APPLICATION G-16030
PERMIT G-18797
06/23/2025


Map No. 77

T 40 S 10 E S 32

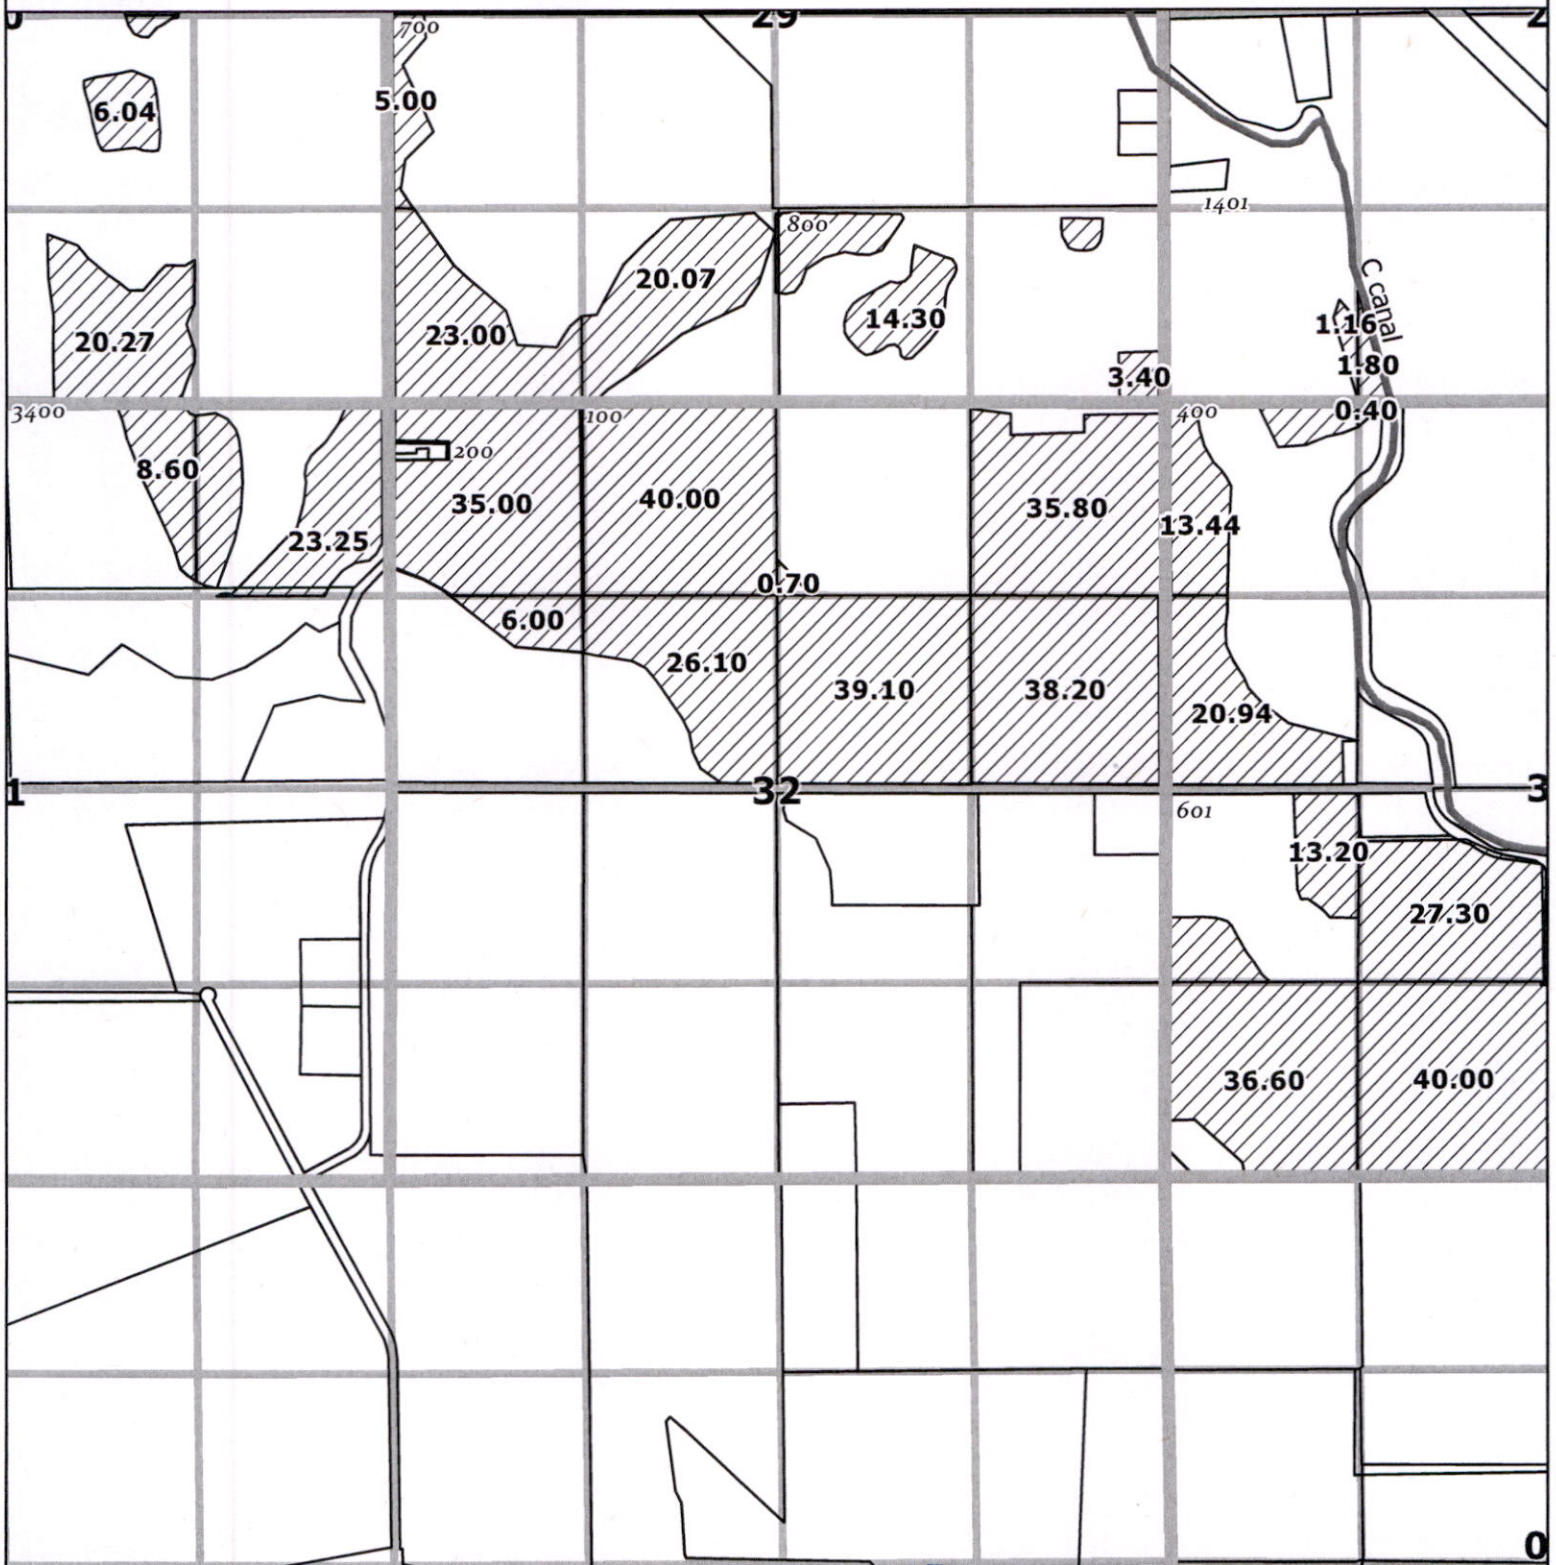


- Place of Use
- Klamath County Taxlot
- QQ Sections and Gov't Lots
- Map Series Sections
- Canal

Received
JUL 07 2025
OWRD

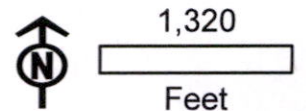

DISCLAIMER
This map is not intended to
provide legal dimensions or
locations of property
ownership lines


WATERSOLVING
johnw@watersolving.com

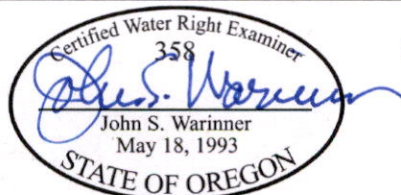

CLAIM OF BENEFICIAL USE MAP
APPLICATION G-16030
PERMIT G-18797
06/23/2025

Map No. 78

T S 40 R 10 S 33 E 33

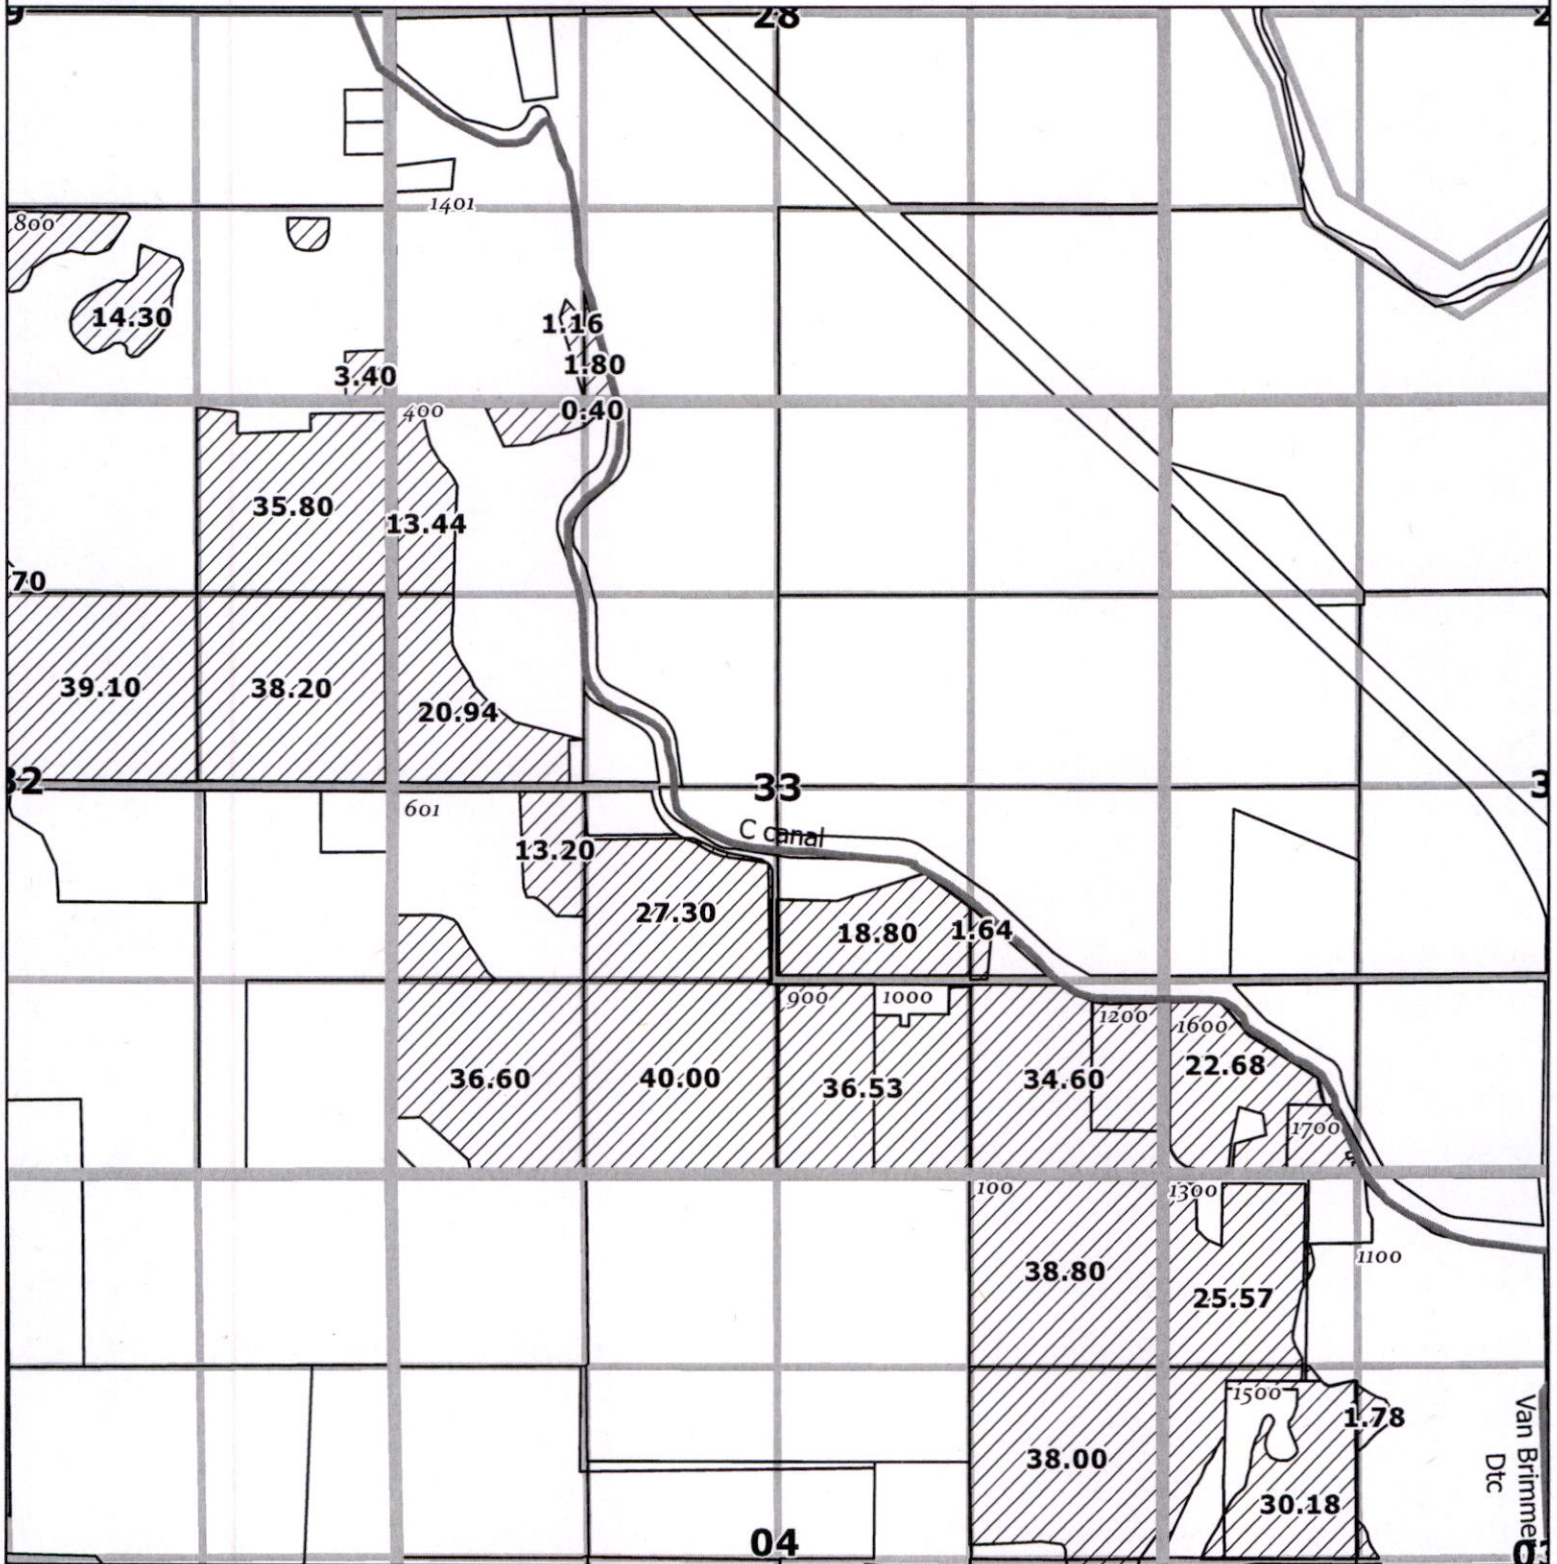

- Place of Use
- Klamath County Taxlot
- QQ Sections and Gov't Lots
- Map Series Sections
- Canal

Received

JUL 07 2025

OWRD




1,320

Feet

DISCLAIMER
This map is not intended to
provide legal dimensions or
locations of property
ownership lines


WATERSOLVING
johnw@watersolving.com

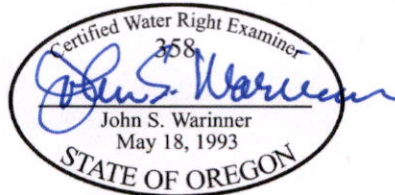

CLAIM OF BENEFICIAL USE MAP
APPLICATION G-16030
PERMIT G-18797
06/23/2025


Map No. 79

T 40 S 10 E S 34

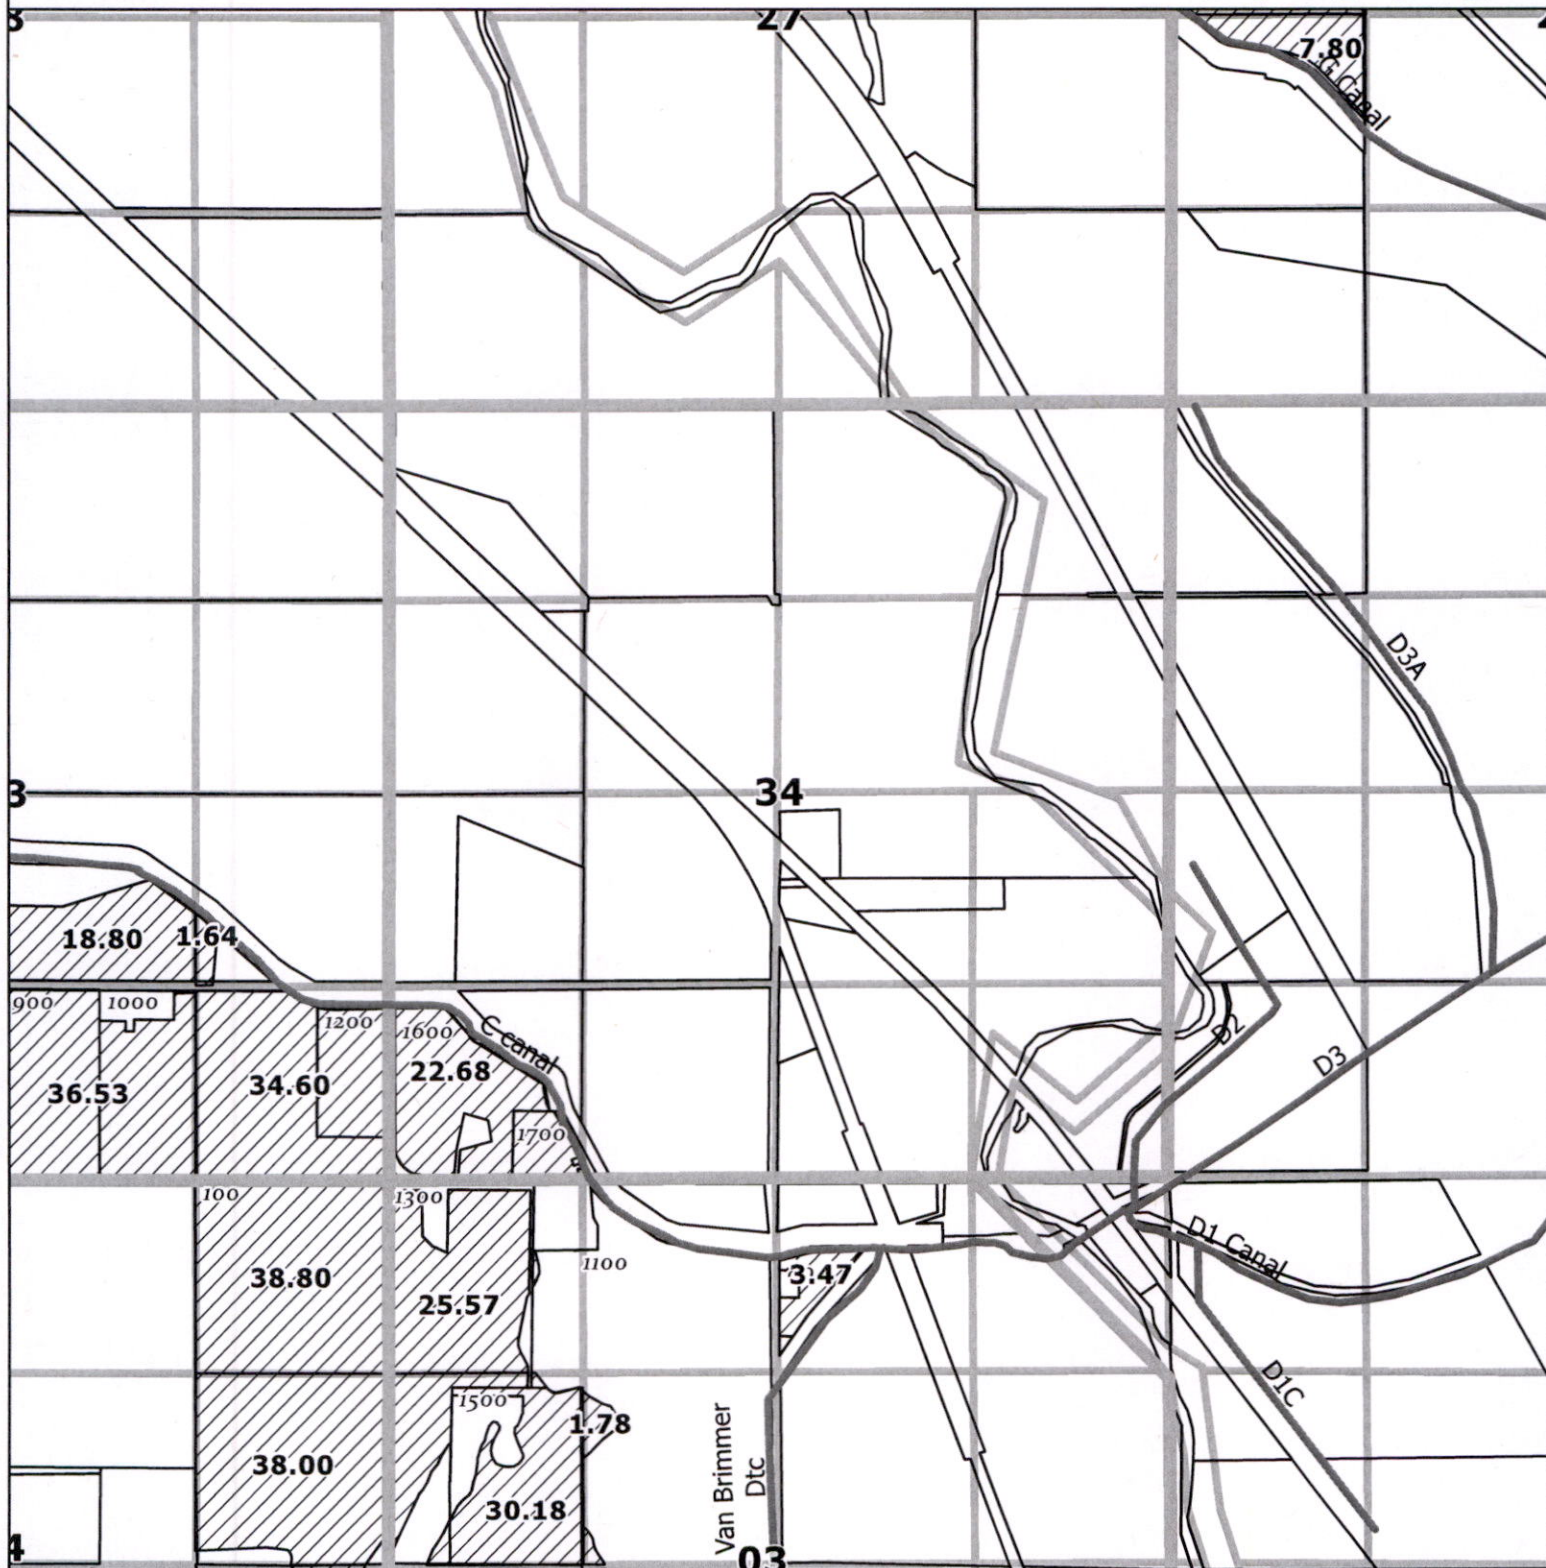


- Place of Use
- Klamath County Taxlot
- QQ Sections and Gov't Lots
- Map Series Sections
- Canal

Received
JUL 07 2025
OWRD

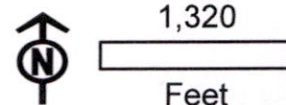

DISCLAIMER
This map is not intended to
provide legal dimensions or
locations of property
ownership lines


WATERSOLVING
johnw@watersolving.com

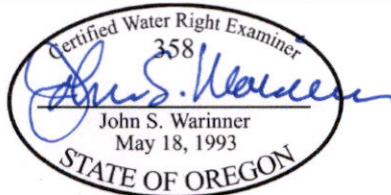

CLAIM OF BENEFICIAL USE MAP
APPLICATION G-16030
PERMIT G-18797
06/23/2025

Map No. 80

T 40 S 11 E S 01

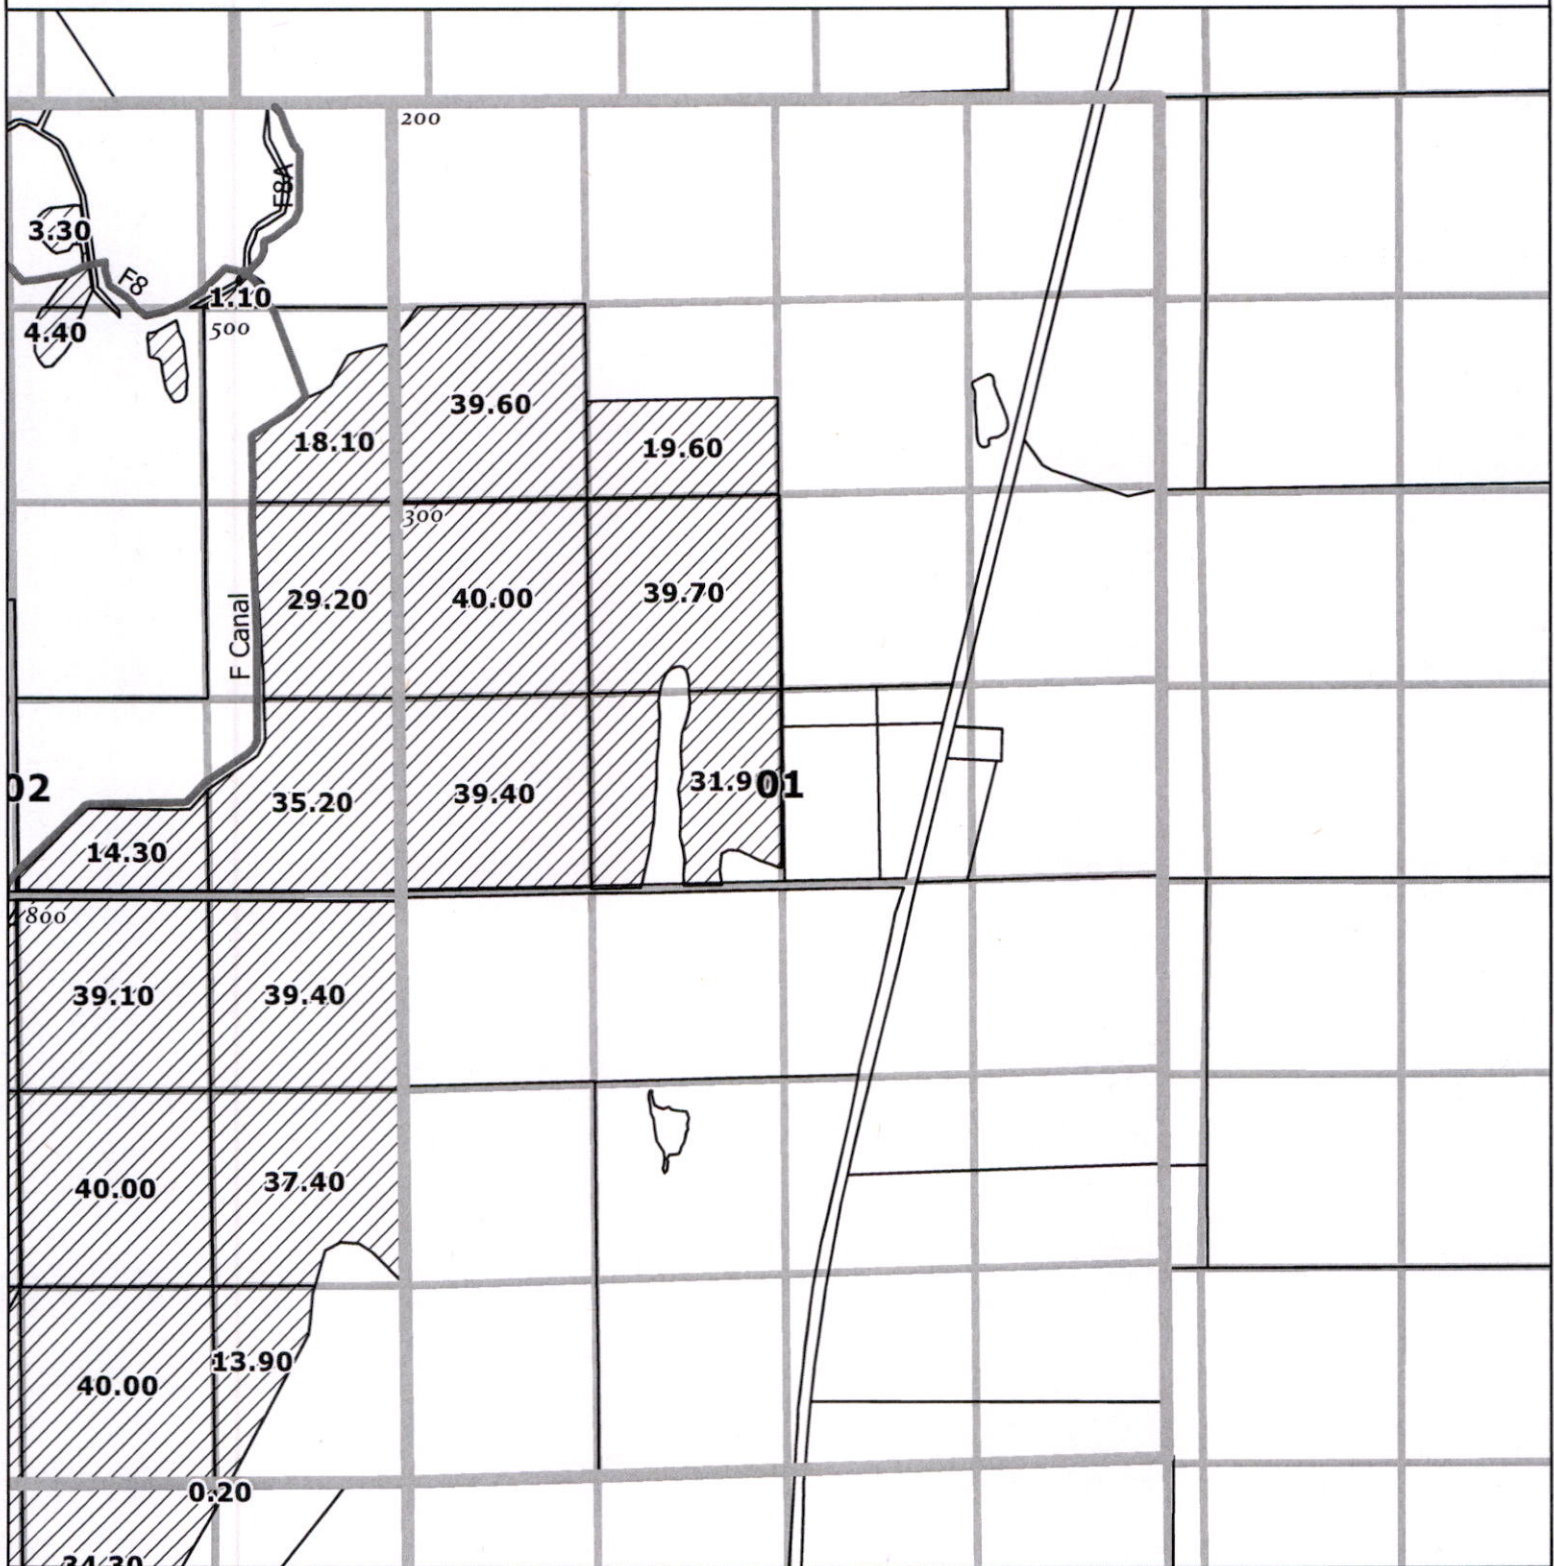

- Place of Use
- Klamath County Taxlot
- QQ Sections and Gov't Lots
- Map Series Sections
- Canal

Received

JUL 07 2025

OWRD




1,320

Feet

DISCLAIMER
This map is not intended to provide legal dimensions or locations of property ownership lines


WATERSOLVING
johnw@watersolving.com

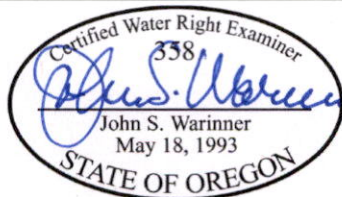

CLAIM OF BENEFICIAL USE MAP
APPLICATION G-16030
PERMIT G-18797
06/23/2025

Map No. 81

T 40 S 11 E S 02

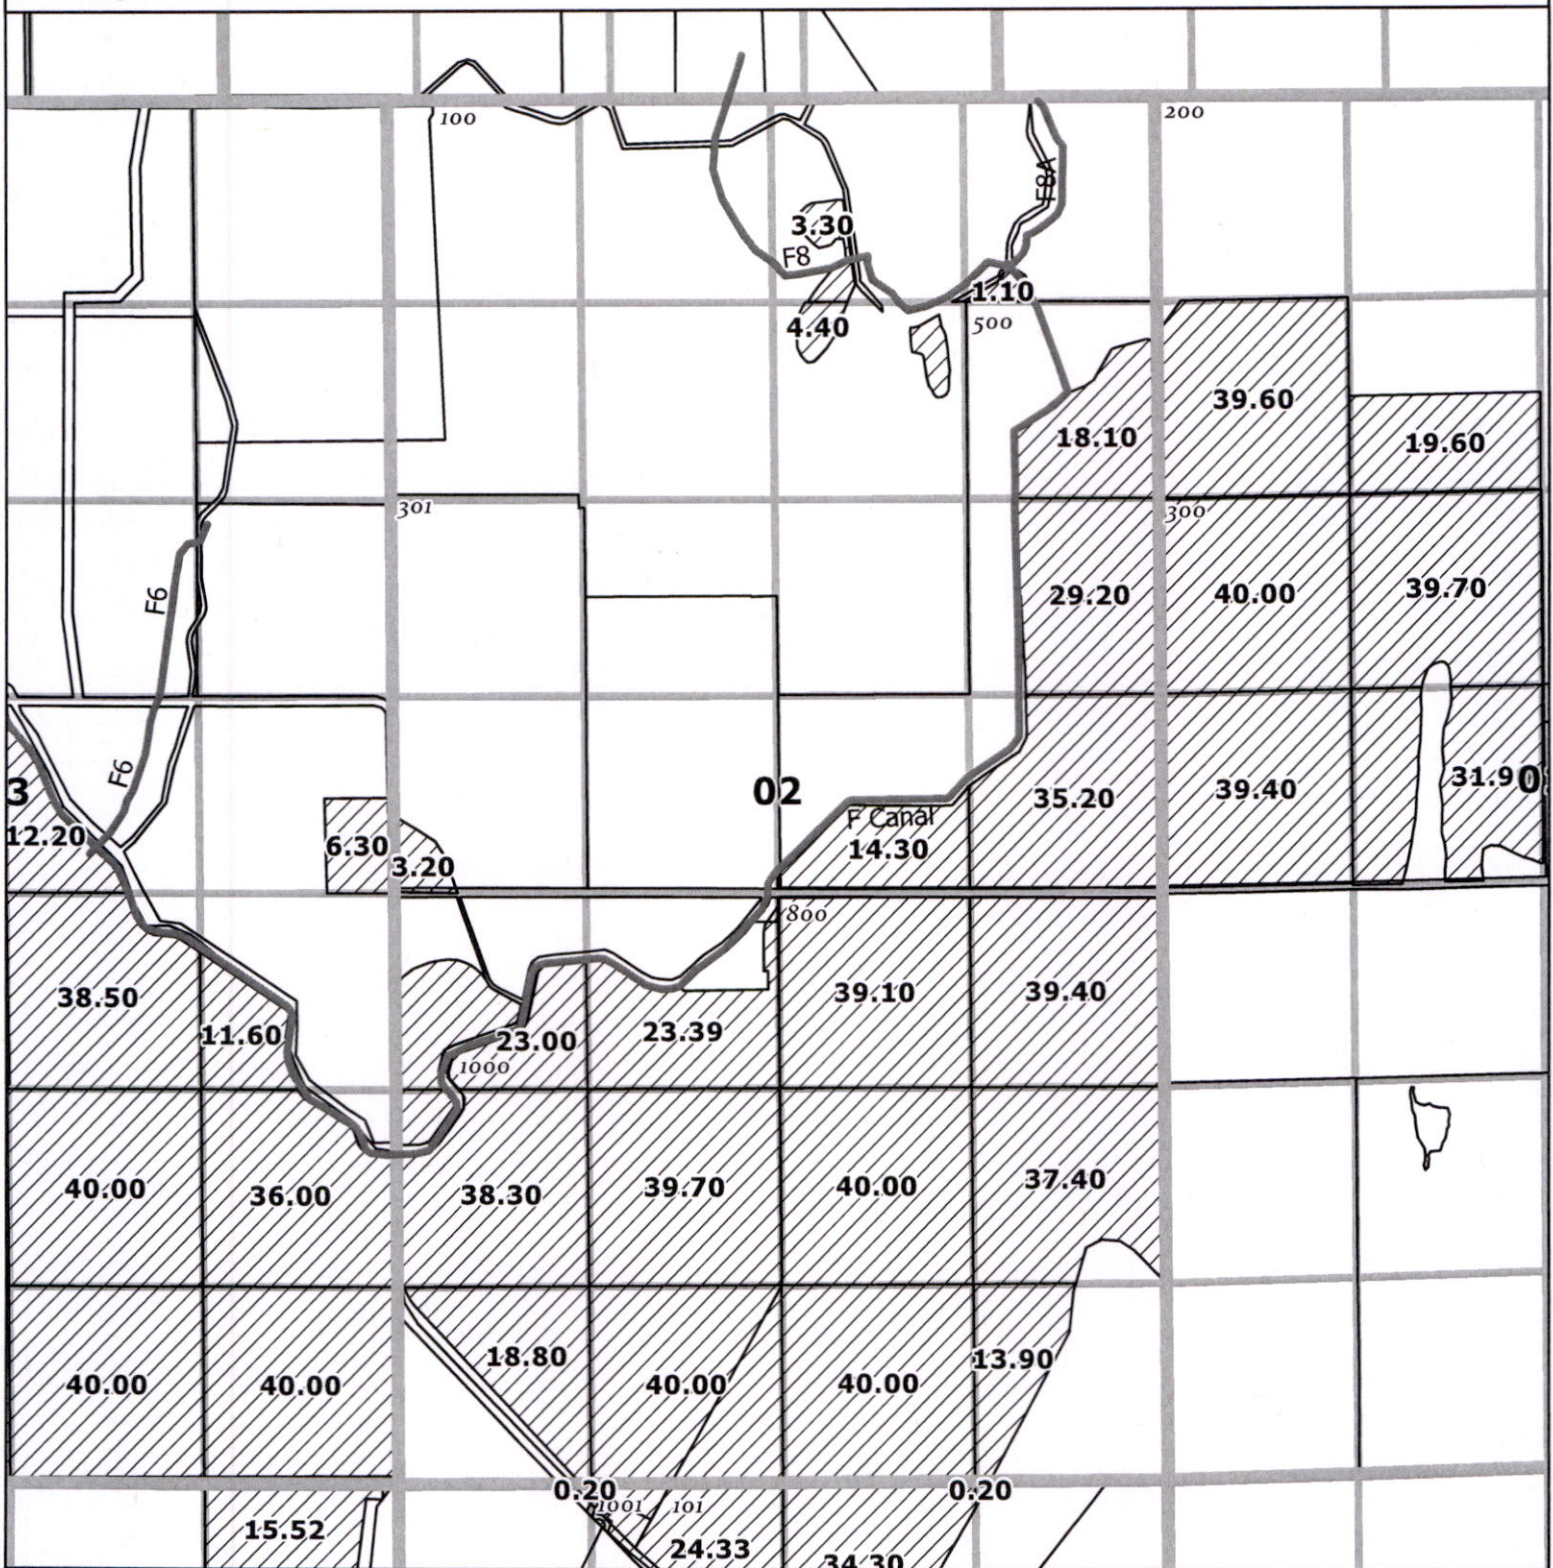

- Place of Use
- Klamath County Taxlot
- QQ Sections and Gov't Lots
- Map Series Sections
- Canal


Received
JUL 07 2025
OWRD



1,320
Feet

DISCLAIMER
This map is not intended to
provide legal dimensions or
locations of property
ownership lines


WATERSOLVING
johnw@watersolving.com

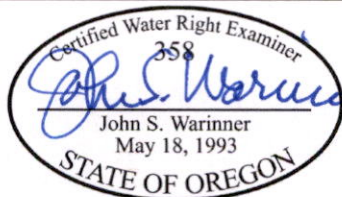

CLAIM OF BENEFICIAL USE MAP
APPLICATION G-16030
PERMIT G-18797
06/23/2025

Map No. 82

T S 40 R 11 S 03

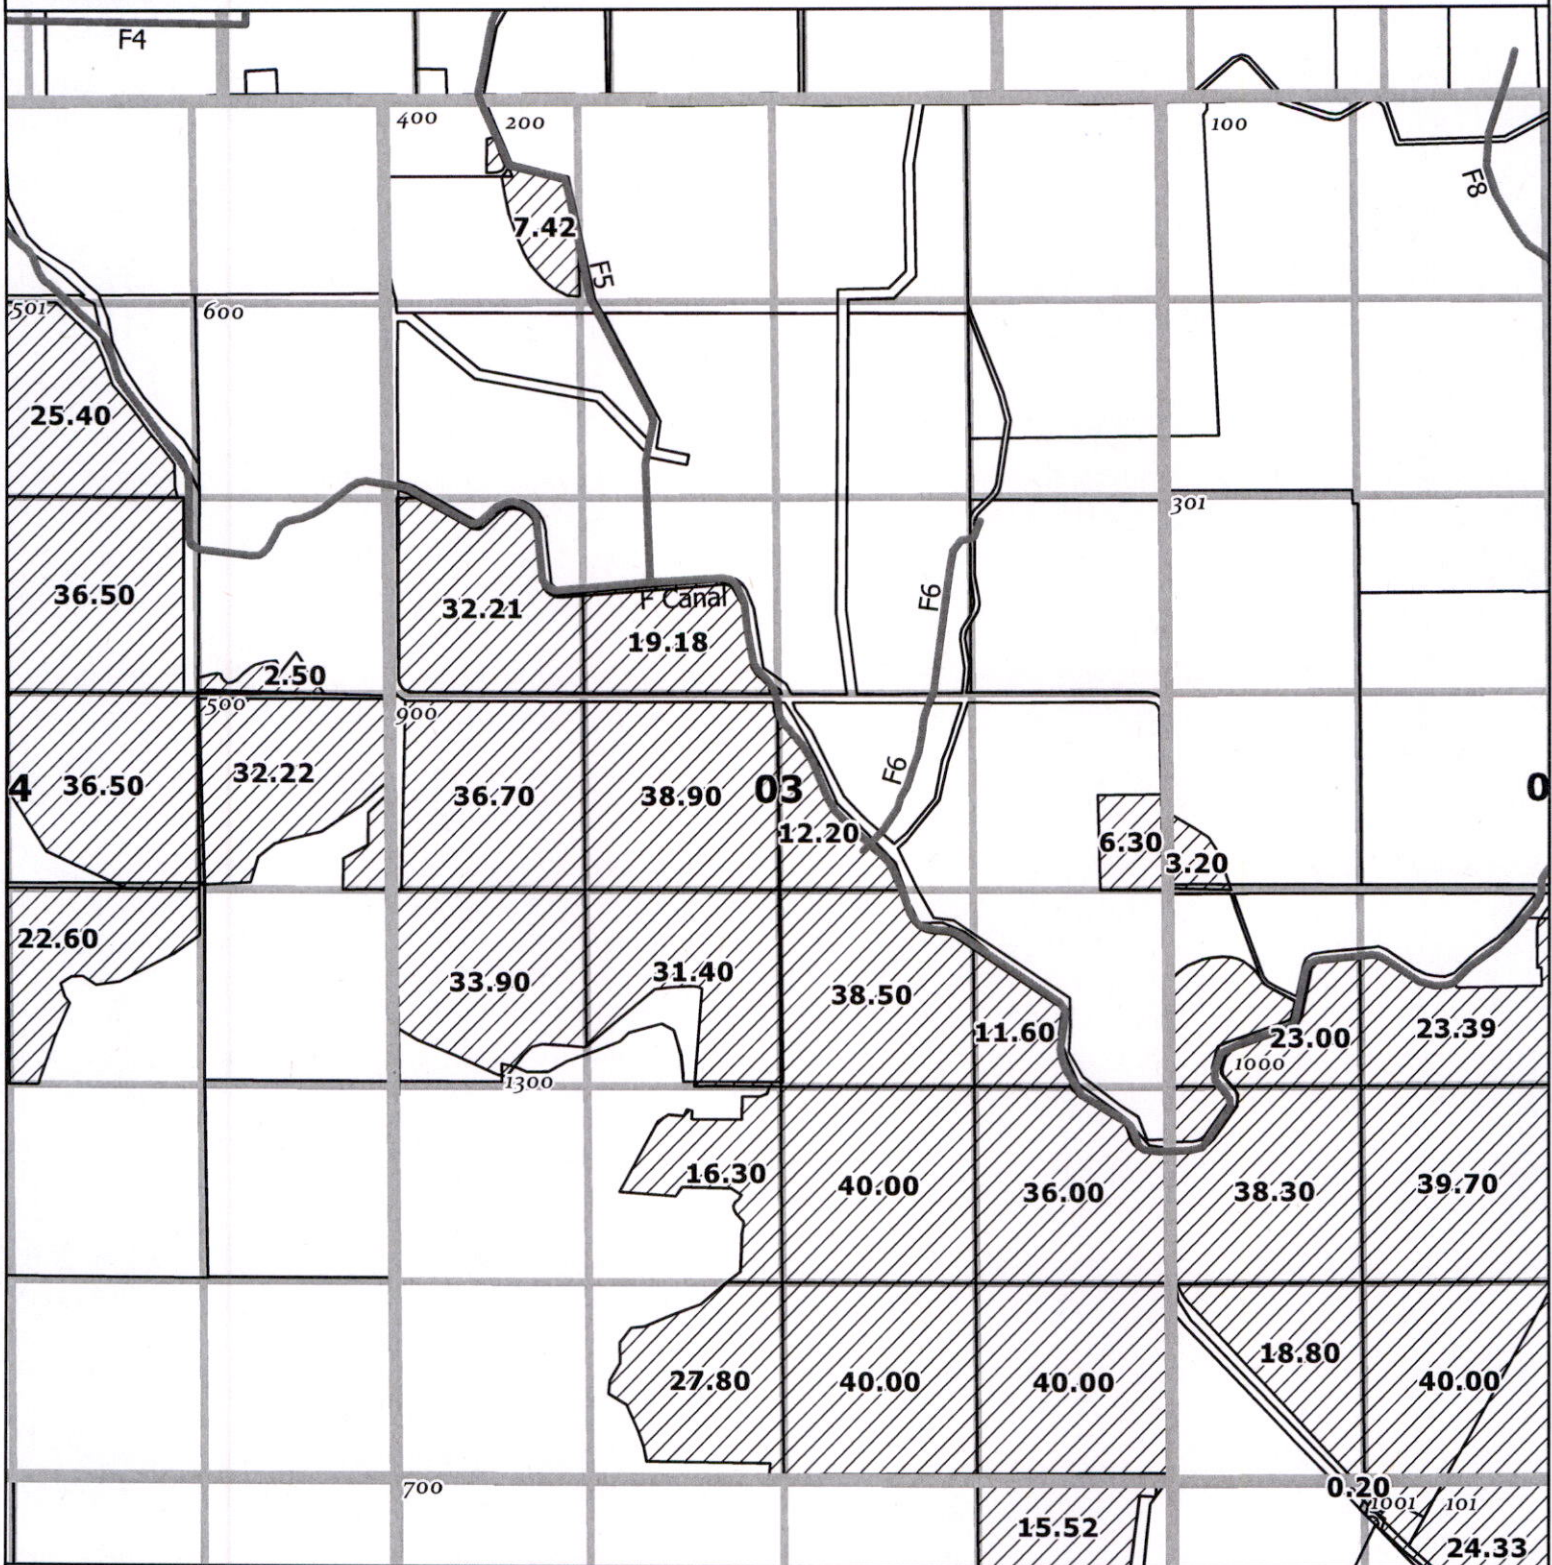

- Place of Use
- Klamath County Taxlot
- QQ Sections and Gov't Lots
- Map Series Sections
- Canal

Received

JUL 07 2025

OWRD




1,320

Feet

DISCLAIMER
This map is not intended to
provide legal dimensions or
locations of property
ownership lines


WATERSOLVING
johnw@watersolving.com

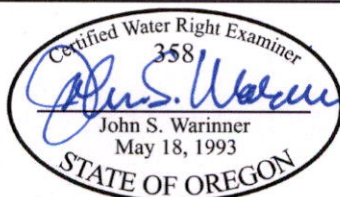

CLAIM OF BENEFICIAL USE MAP
APPLICATION G-16030
PERMIT G-18797
06/23/2025


Map No. 83

T S 40 R 11 E S 04

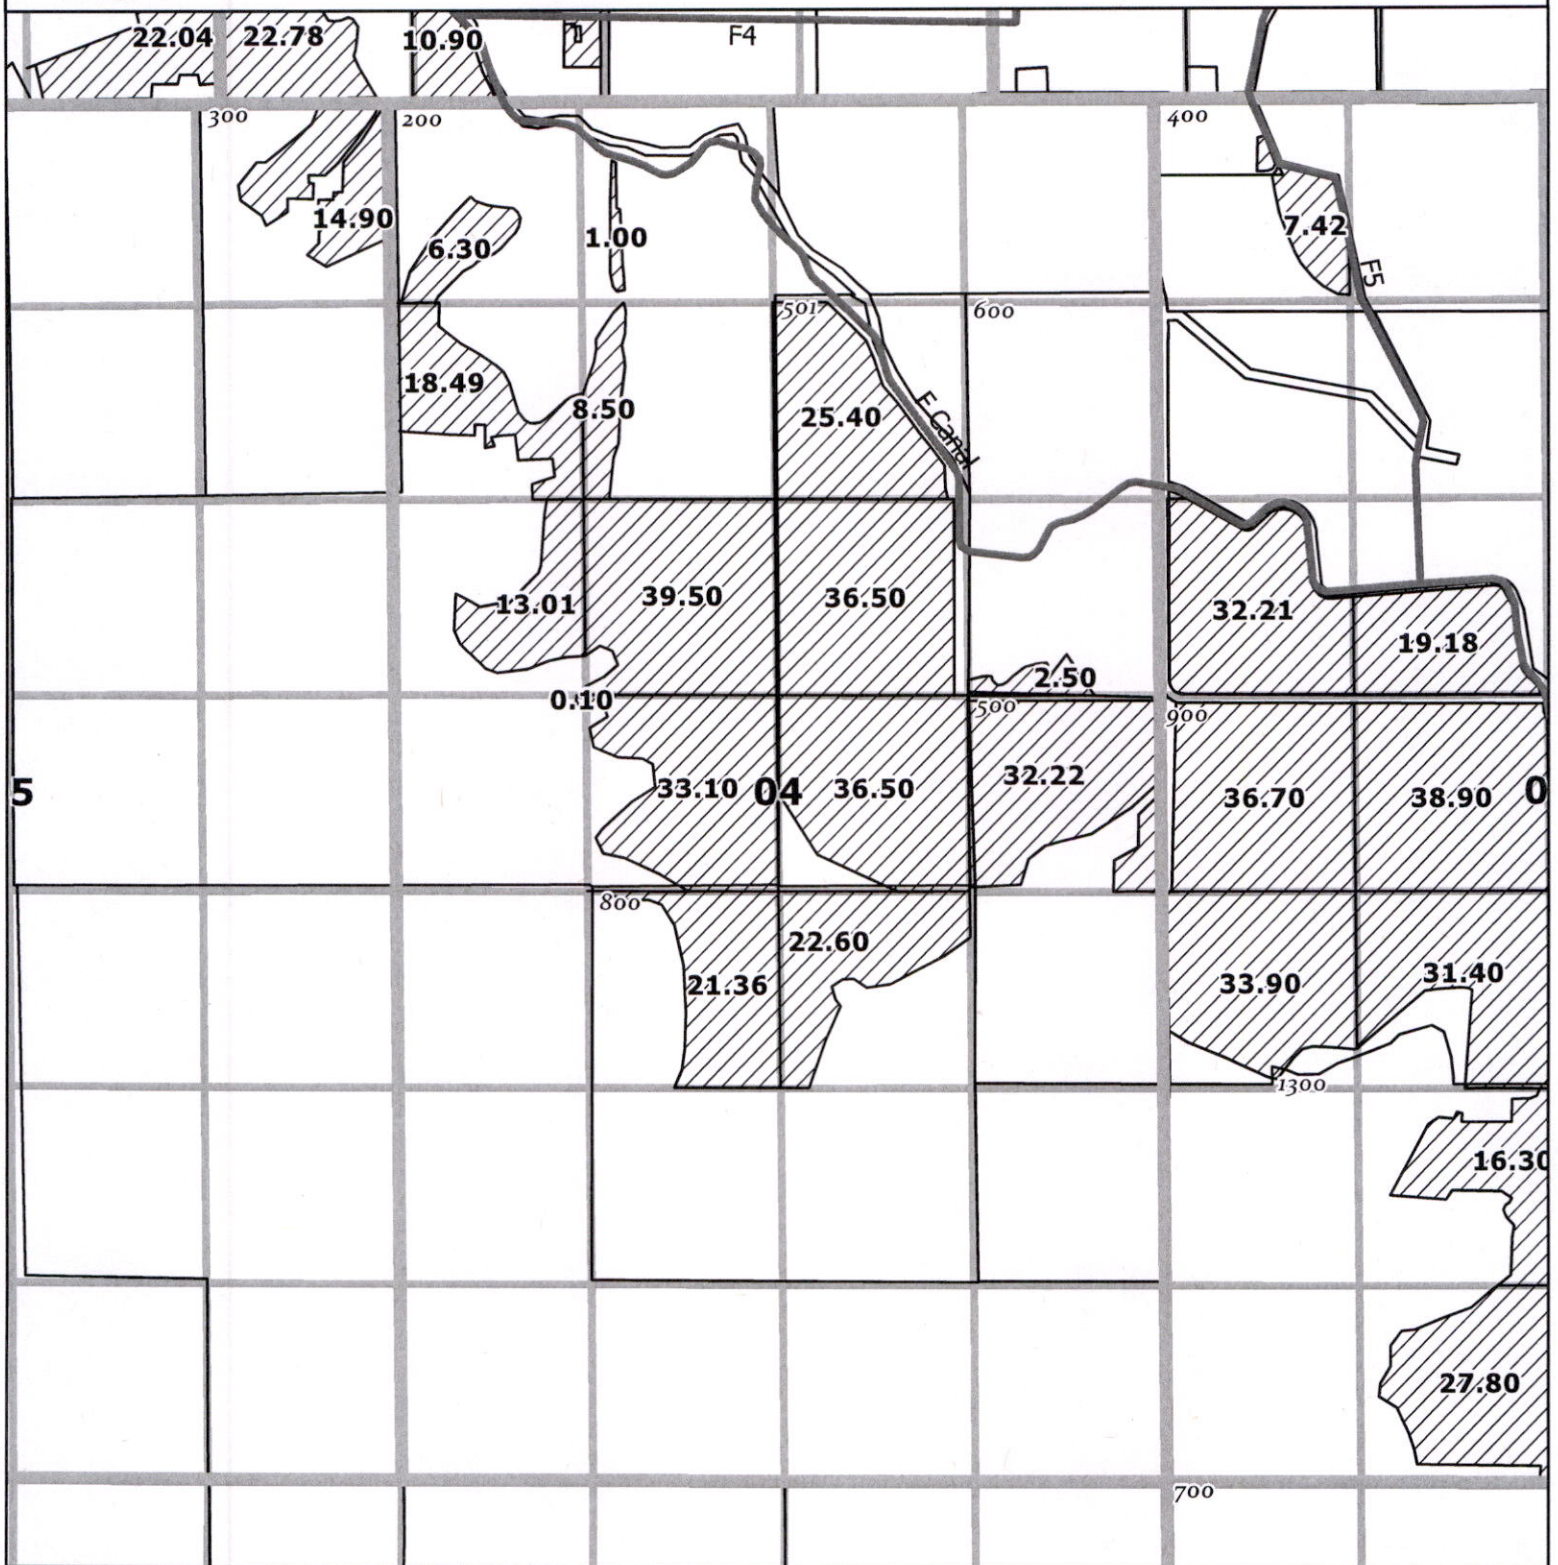


- Place of Use
- Klamath County Taxlot
- QQ Sections and Gov't Lots
- Map Series Sections
- Canal

Received
JUL 07 2025
OWRD

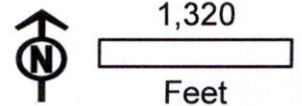

DISCLAIMER
This map is not intended to
provide legal dimensions or
locations of property
ownership lines


WATERSOLVING
johnw@watersolving.com

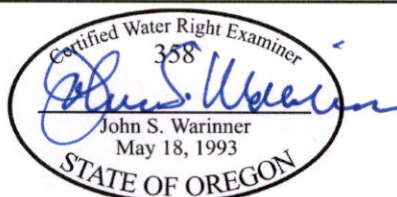

CLAIM OF BENEFICIAL USE MAP
APPLICATION G-16030
PERMIT G-18797
06/23/2025


Map No. 84

T S 40 R 11 E S 05

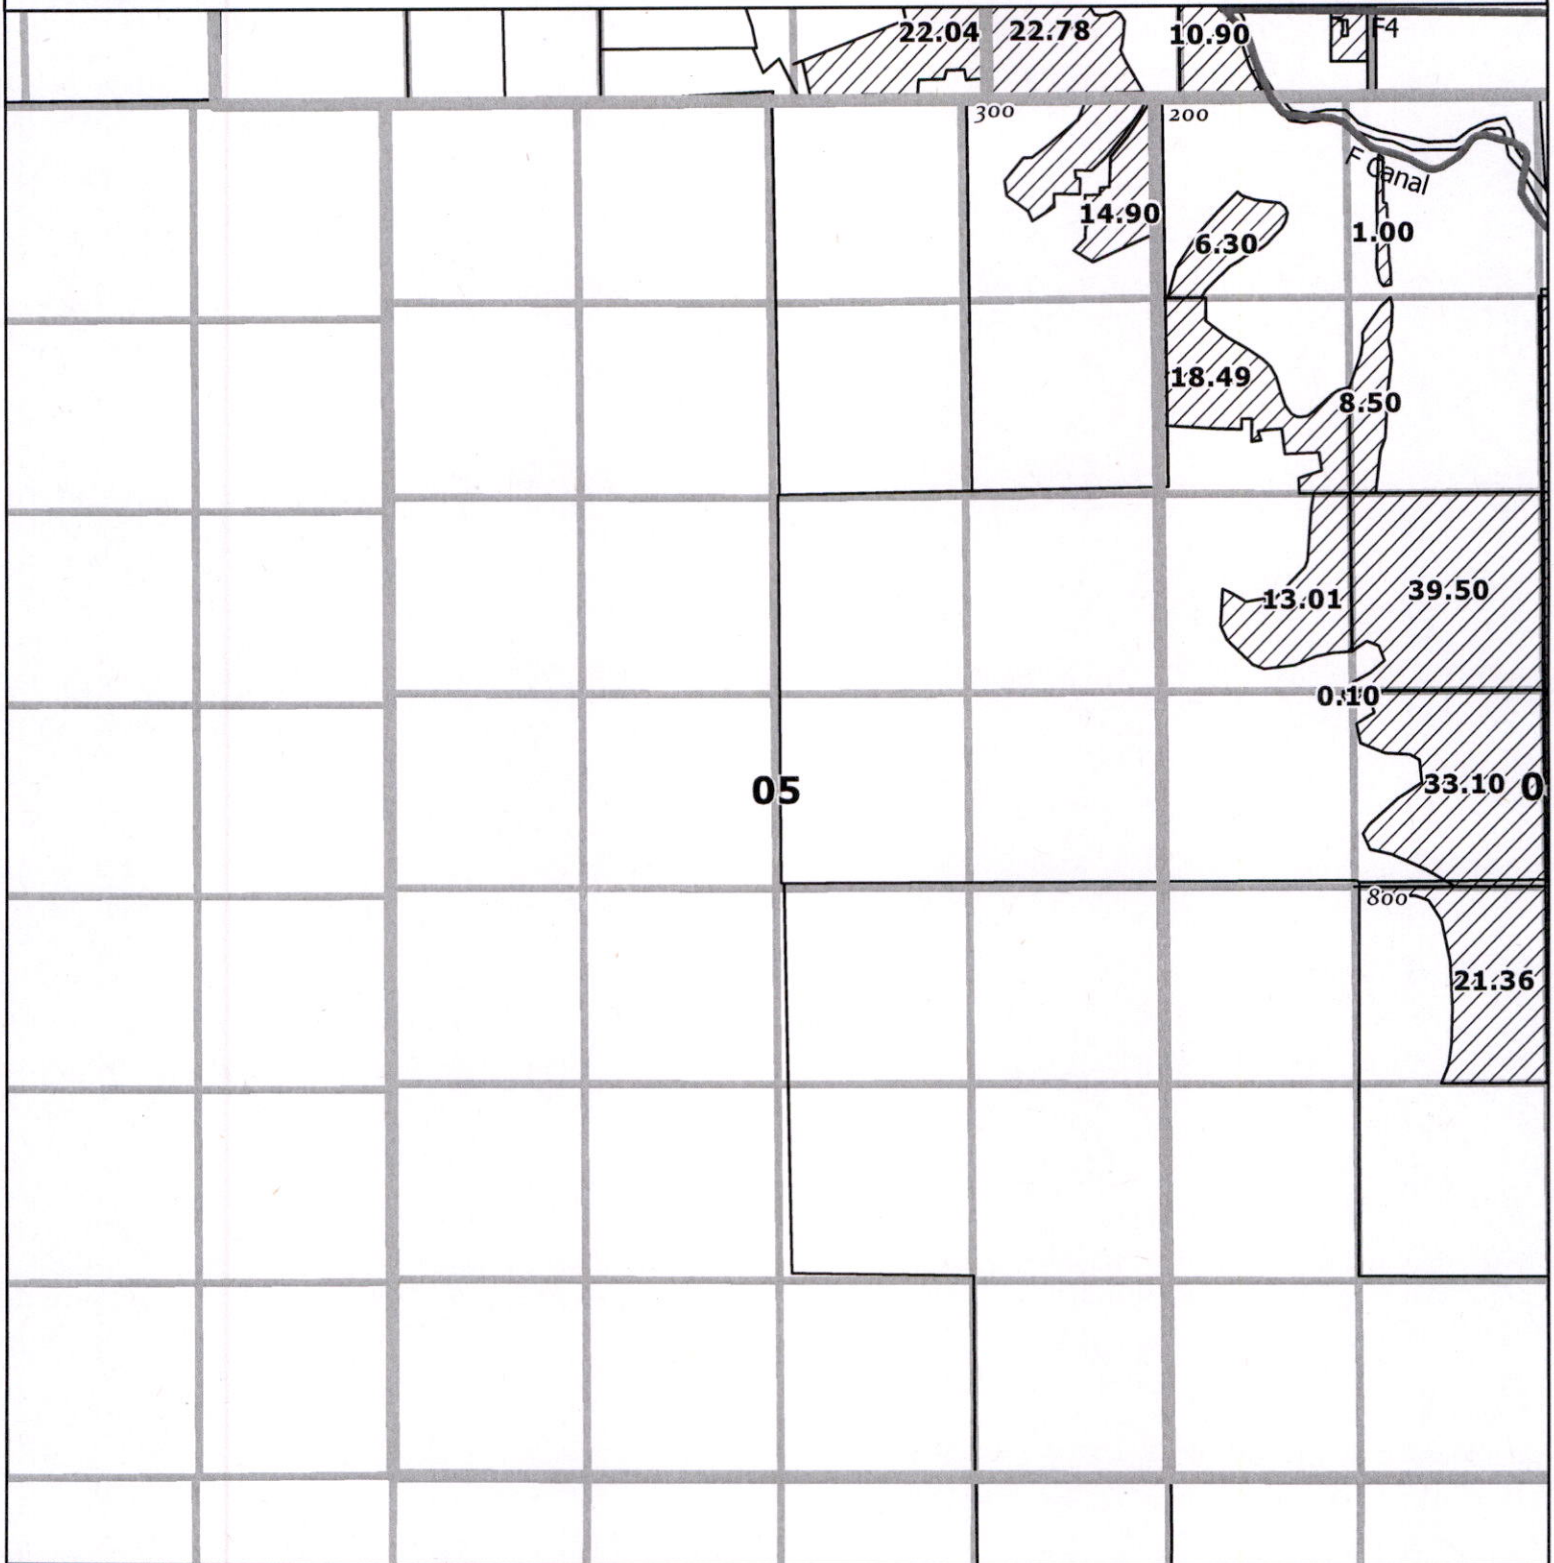


- Place of Use
- Klamath County Taxlot
- QQ Sections and Gov't Lots
- Map Series Sections
- Canal

Received
JUL 07 2025
OWRD

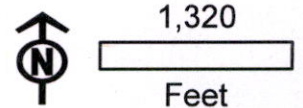

DISCLAIMER
This map is not intended to
provide legal dimensions or
locations of property
ownership lines


WATERSOLVING
johnw@watersolving.com

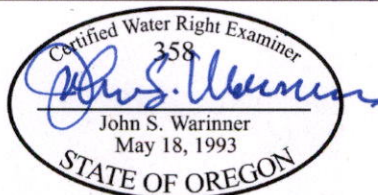

CLAIM OF BENEFICIAL USE MAP
APPLICATION G-16030
PERMIT G-18797
06/23/2025

Map No. 85

T 40 S 11 E S 10

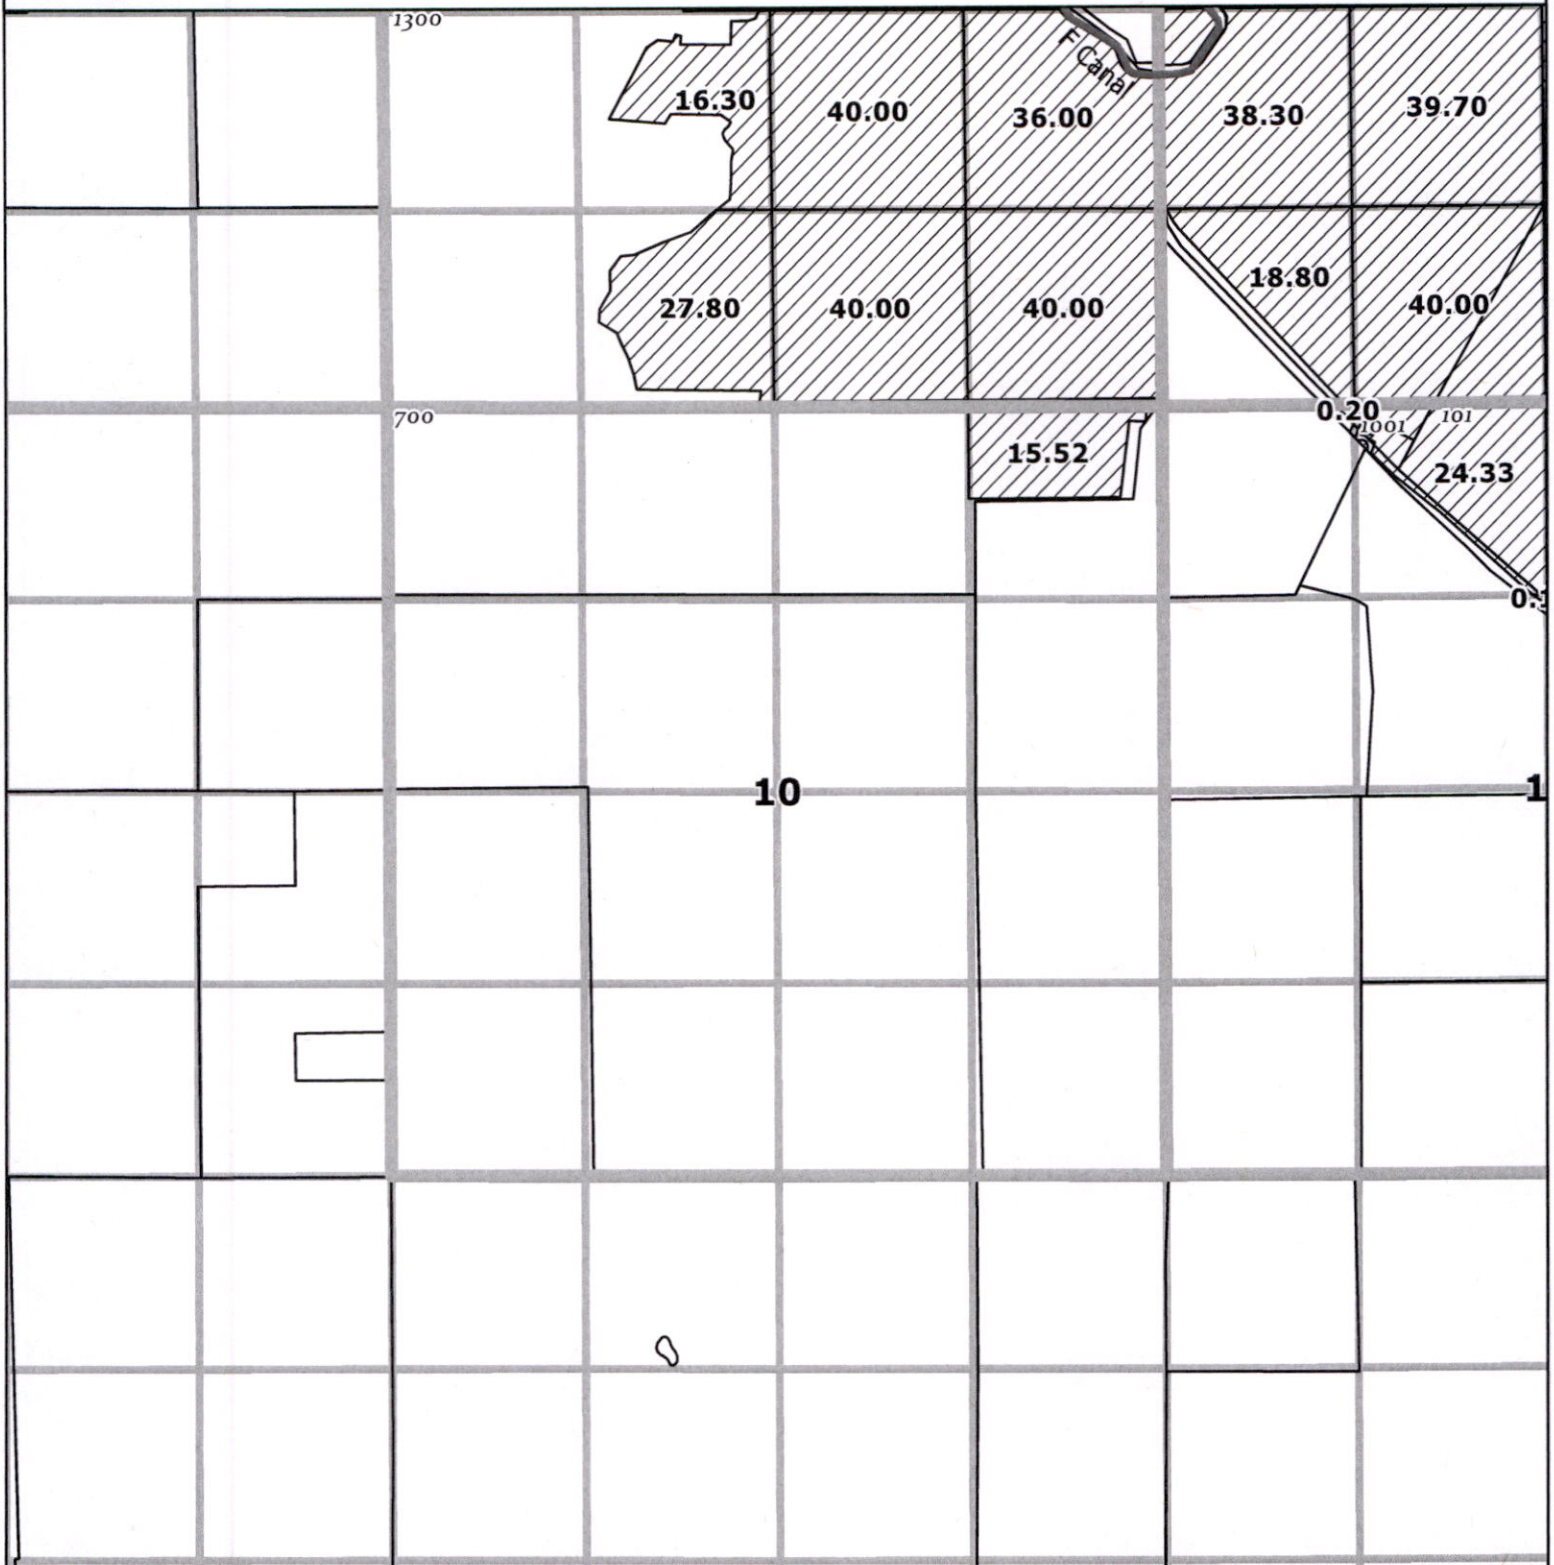

- Place of Use
- Klamath County Taxlot
- QQ Sections and Gov't Lots
- Map Series Sections
- Canal

Received

JUL 07 2025

OWRD




1,320

Feet

DISCLAIMER
This map is not intended to
provide legal dimensions or
locations of property
ownership lines


WATERSOLVING
johnw@watersolving.com

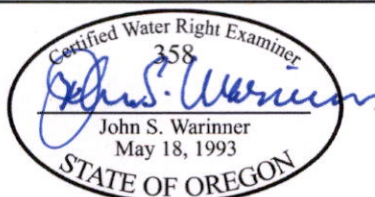

CLAIM OF BENEFICIAL USE MAP
APPLICATION G-16030
PERMIT G-18797
06/23/2025

Map No. 86

T 40 S 11 E S 11

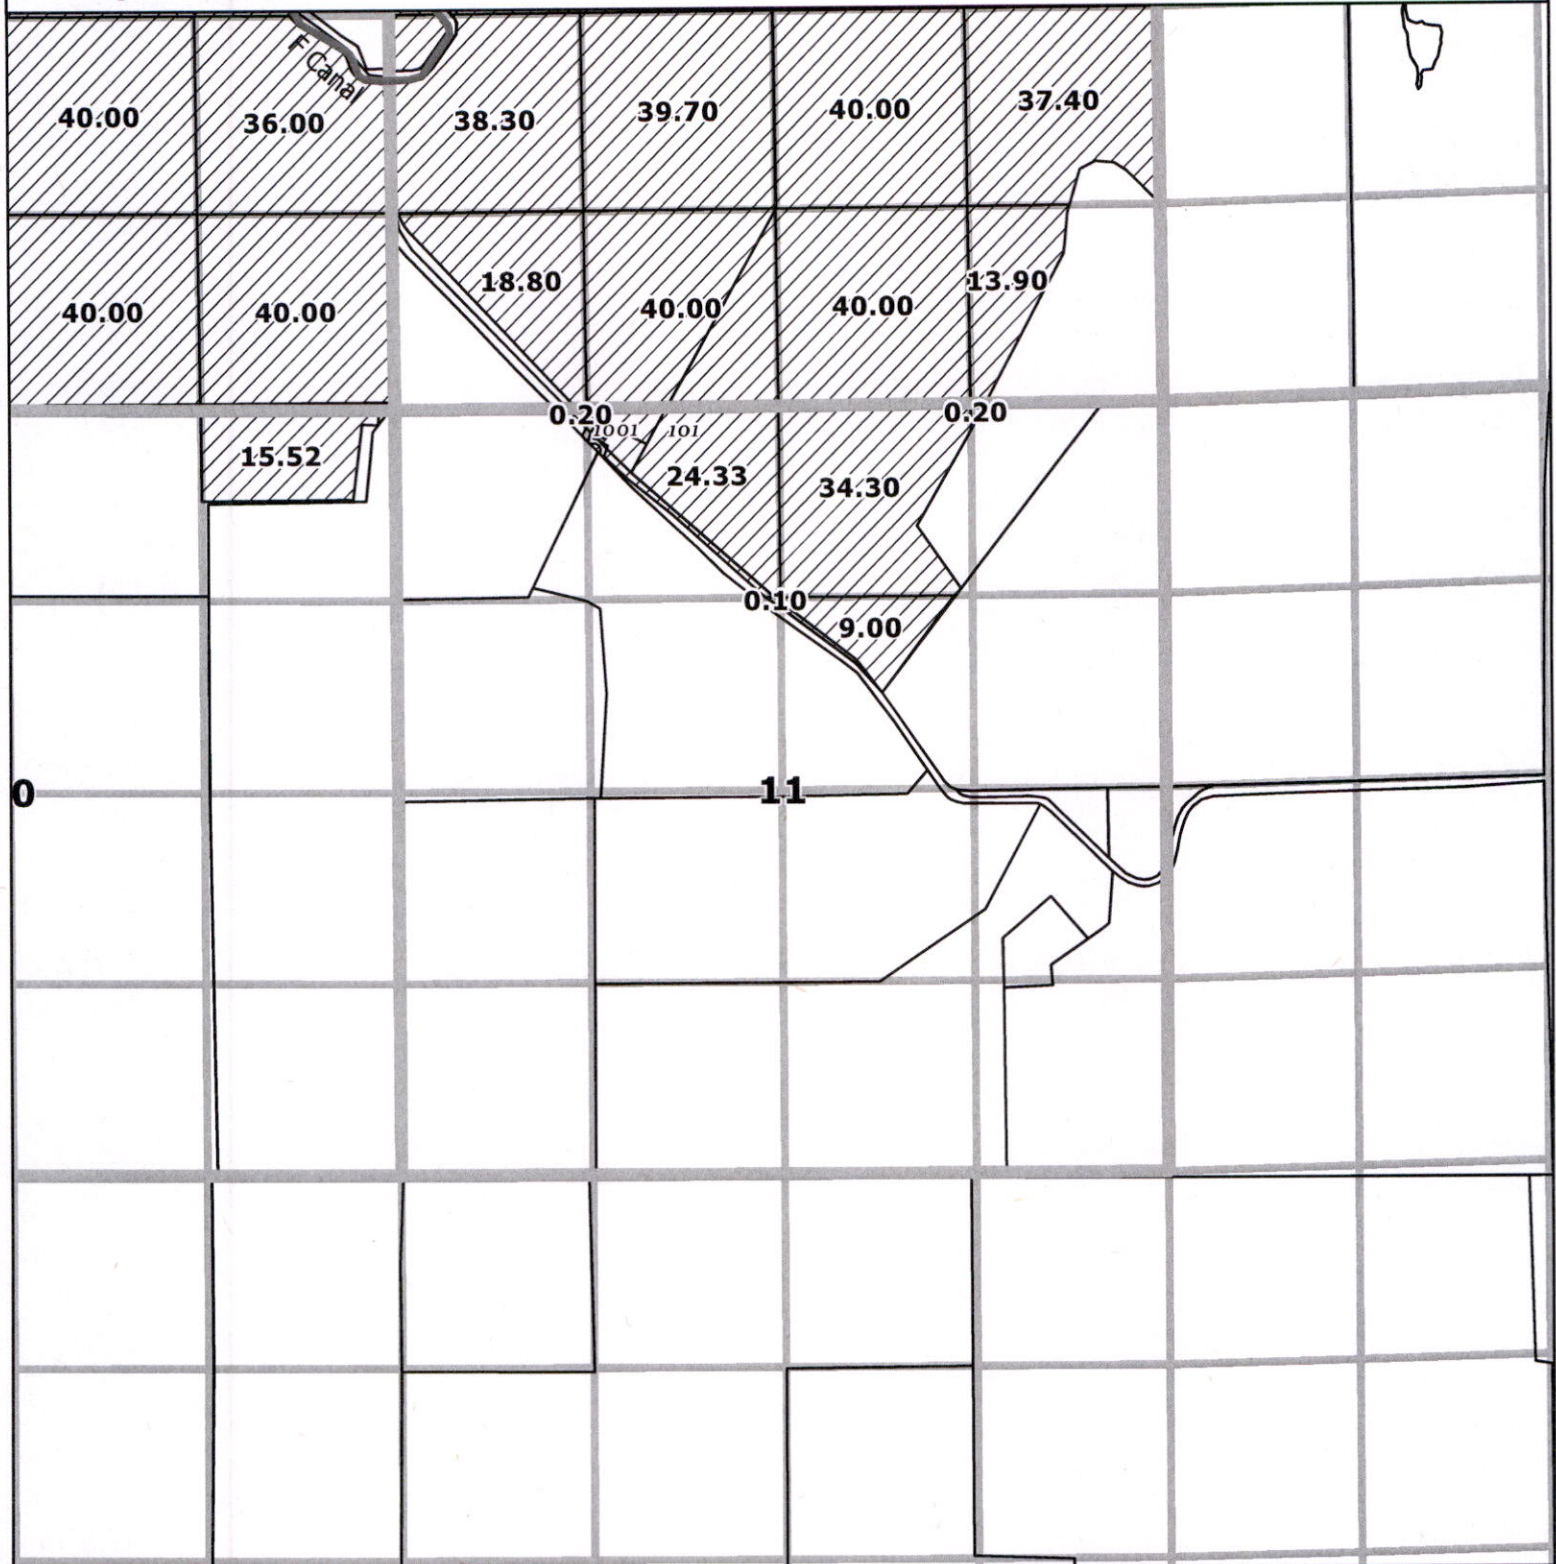

- Place of Use
- Map Series Sections
- Klamath County Taxlot
- Canal
- QQ Sections and Gov't Lots


Received

JUL 07 2025

OWRD




1,320

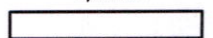

Feet

DISCLAIMER
This map is not intended to
provide legal dimensions or
locations of property
ownership lines


WATERSOLVING
johnw@watersolving.com

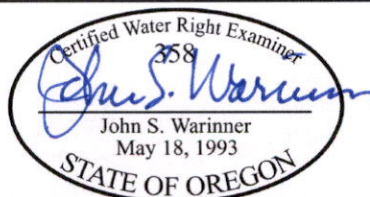

CLAIM OF BENEFICIAL USE MAP
APPLICATION G-16030
PERMIT G-18797
06/23/2025

Map No. 87

T 40 S 11 E S 28

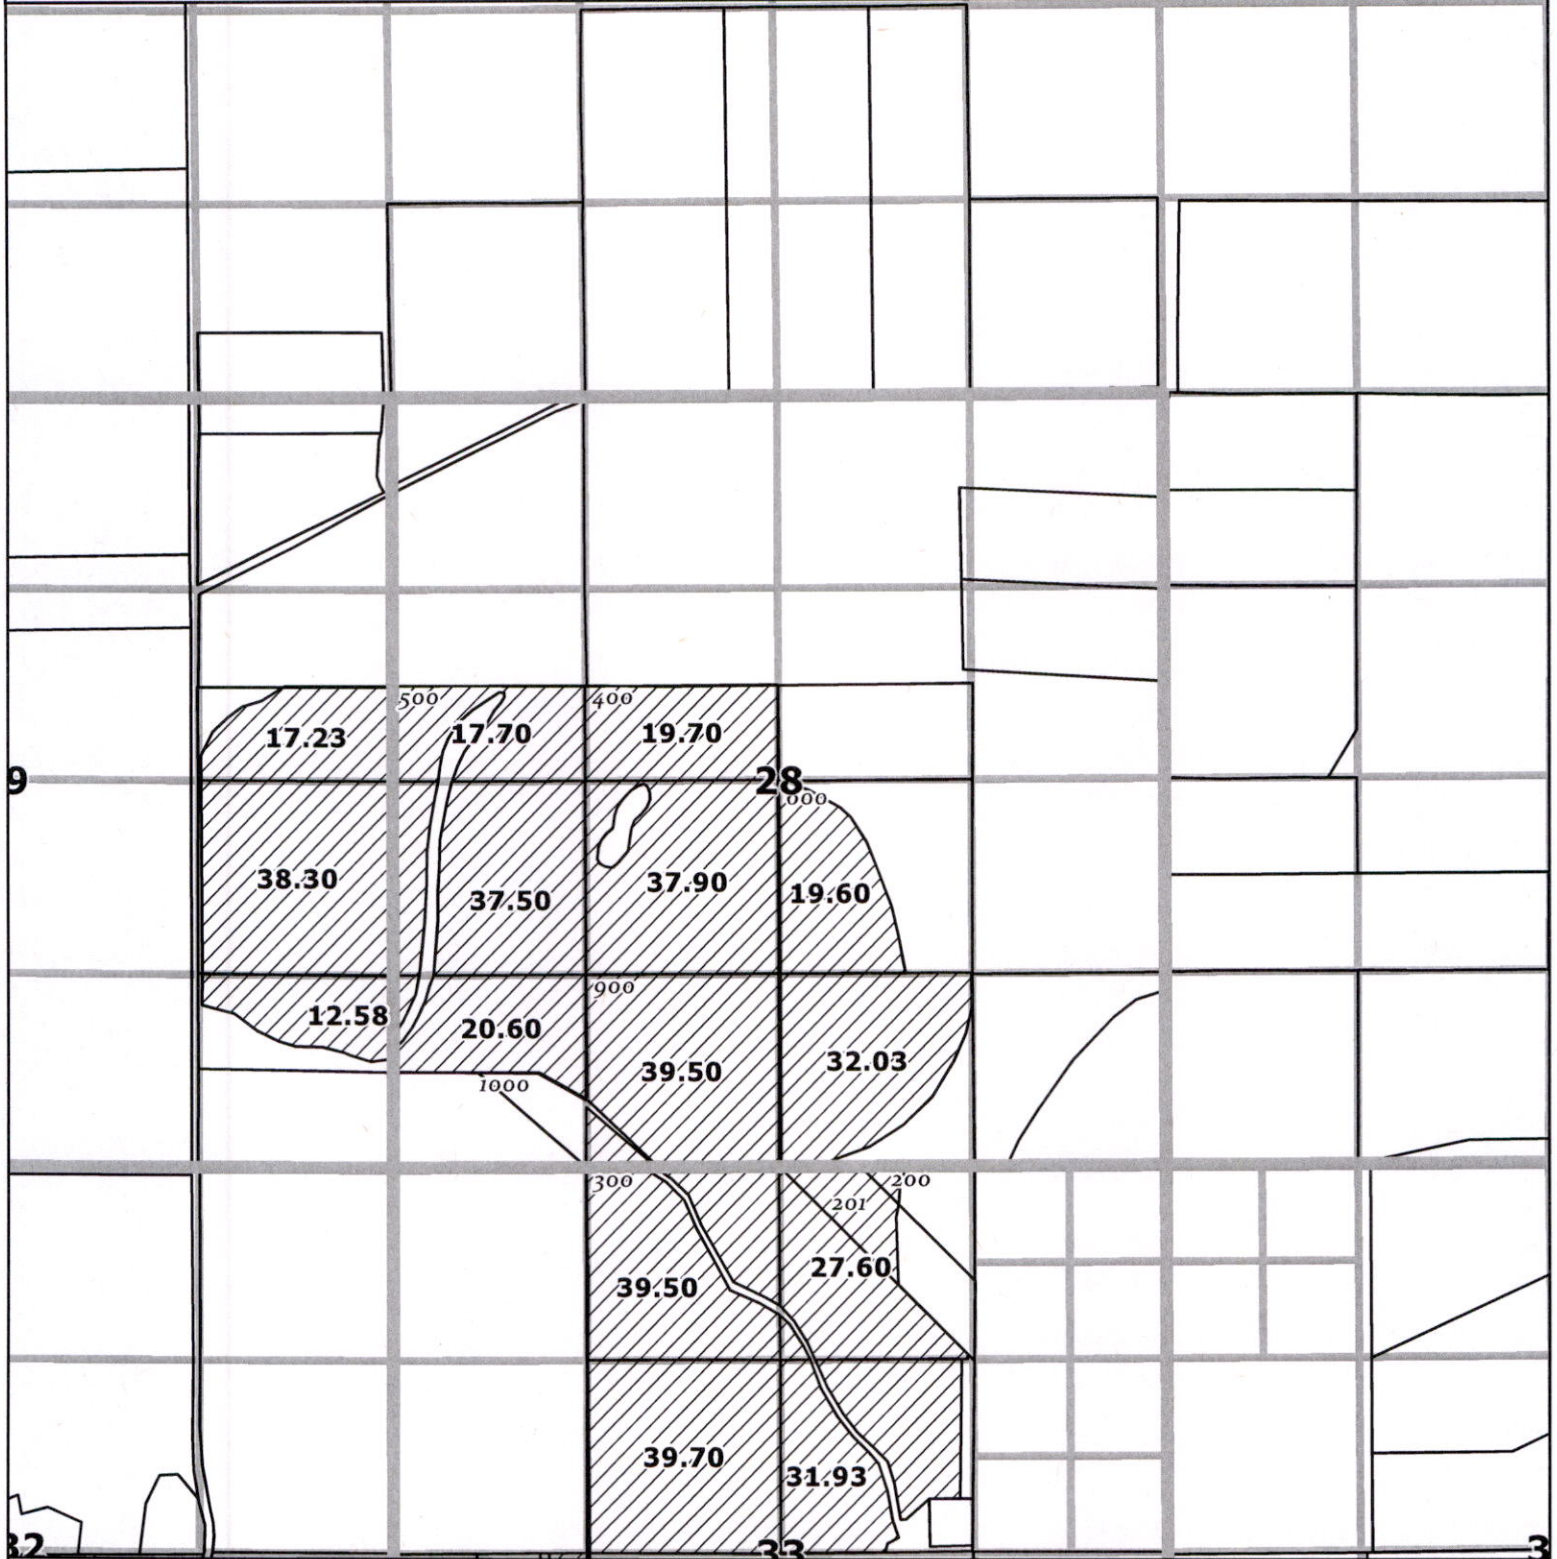

- Place of Use
- Klamath County Taxlot
- QQ Sections and Gov't Lots
- Map Series Sections
- Canal

Received

JUL 07 2025

OWRD




1,320

Feet

DISCLAIMER
This map is not intended to provide legal dimensions or locations of property ownership lines


WATERSOLVING
johnw@watersolving.com

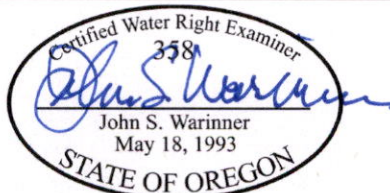

CLAIM OF BENEFICIAL USE MAP
APPLICATION G-16030
PERMIT G-18797
06/23/2025


Map No. 88

T 40 S 11 E S 29

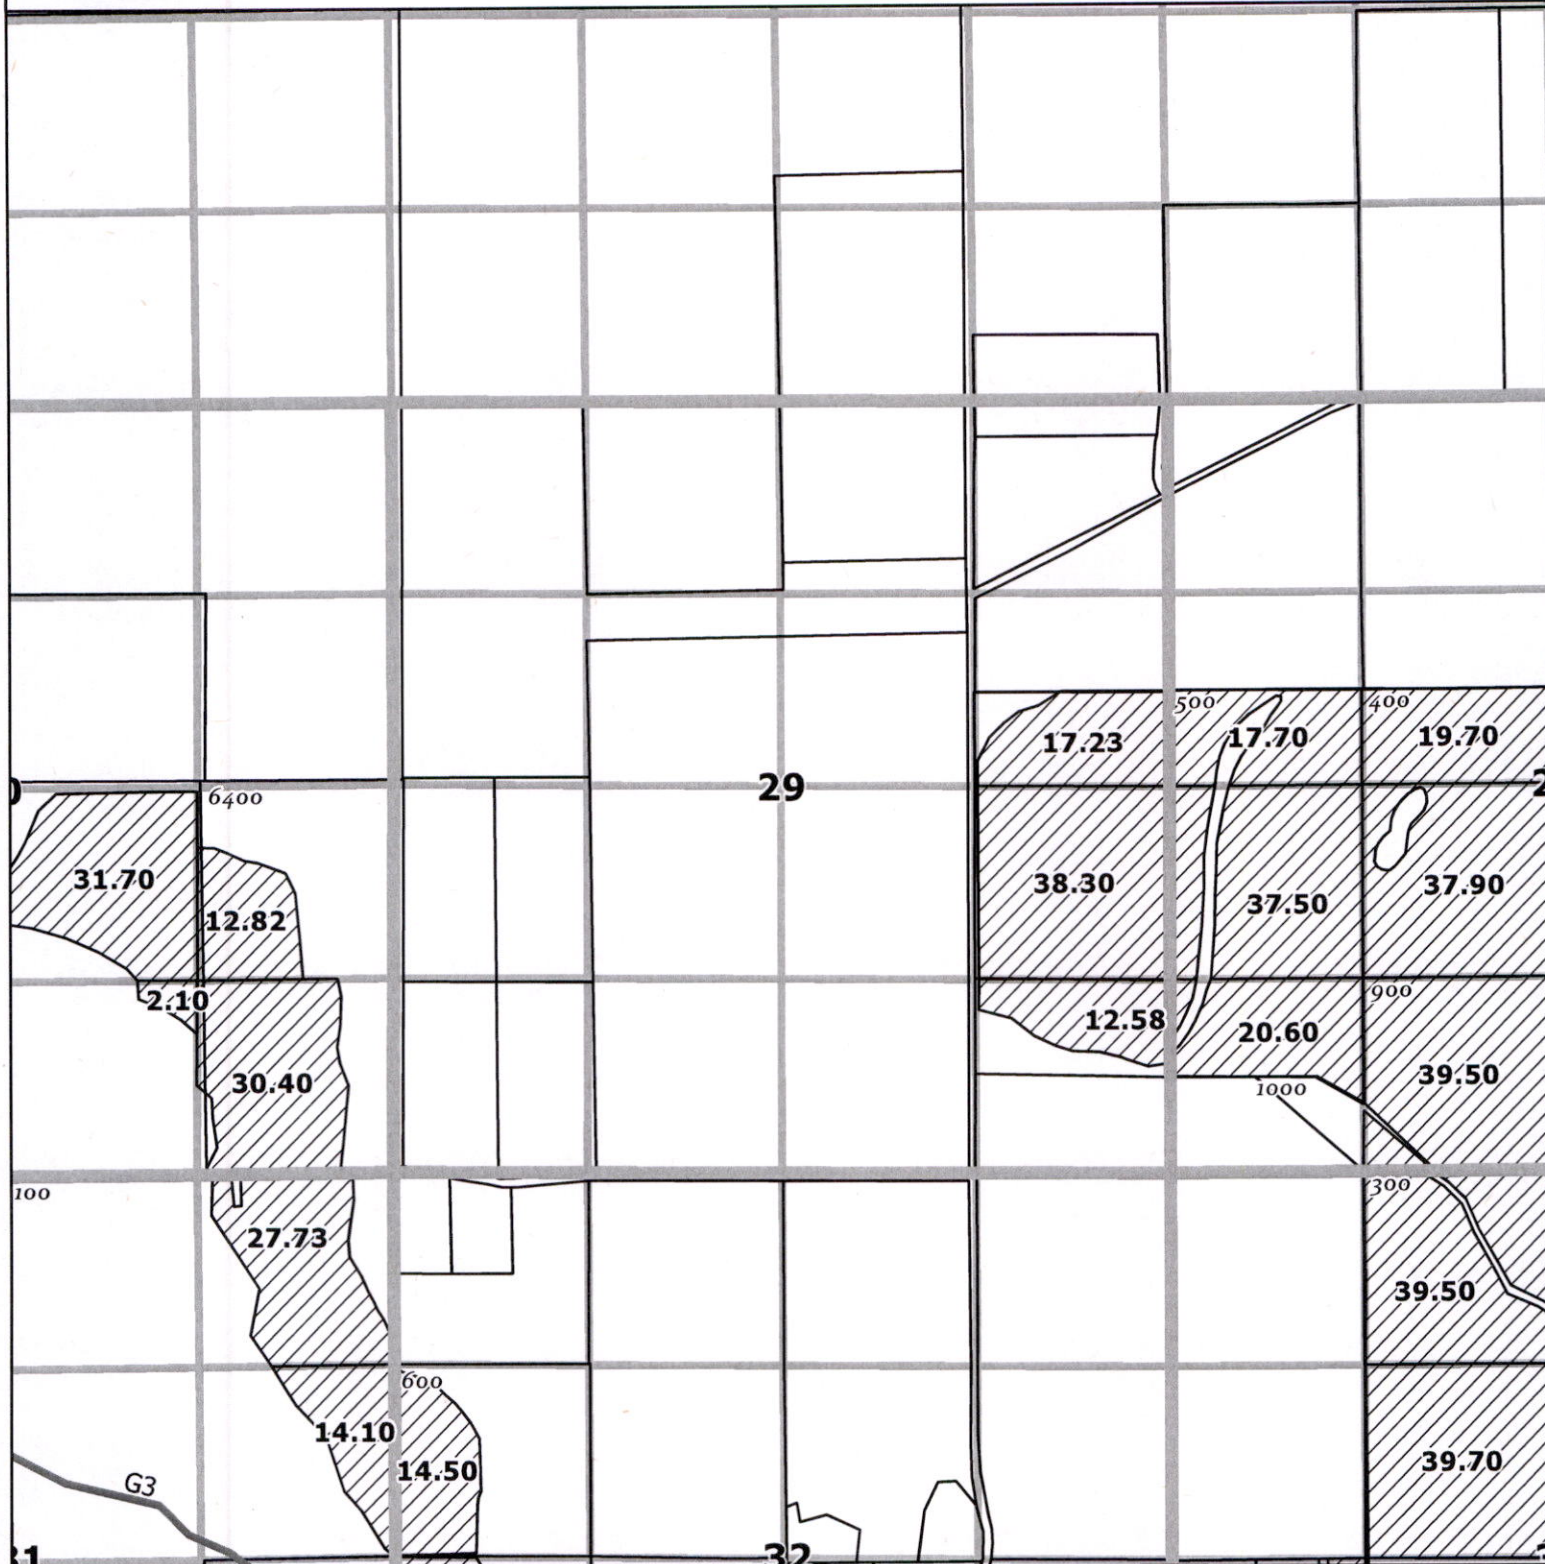

- Place of Use
- Klamath County Taxlot
- QQ Sections and Gov't Lots
- Map Series Sections
- Canal


Received
JUL 07 2025

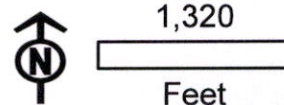

OWRD

DISCLAIMER
This map is not intended to
provide legal dimensions or
locations of property
ownership lines


WATERSOLVING
johnw@watersolving.com

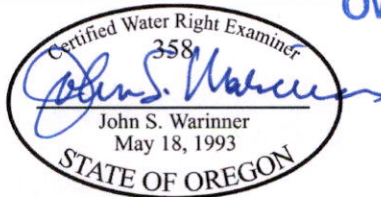

CLAIM OF BENEFICIAL USE MAP
APPLICATION G-16030
PERMIT G-18797
06/23/2025

Map No. 89

T 40 S 11 E S 30

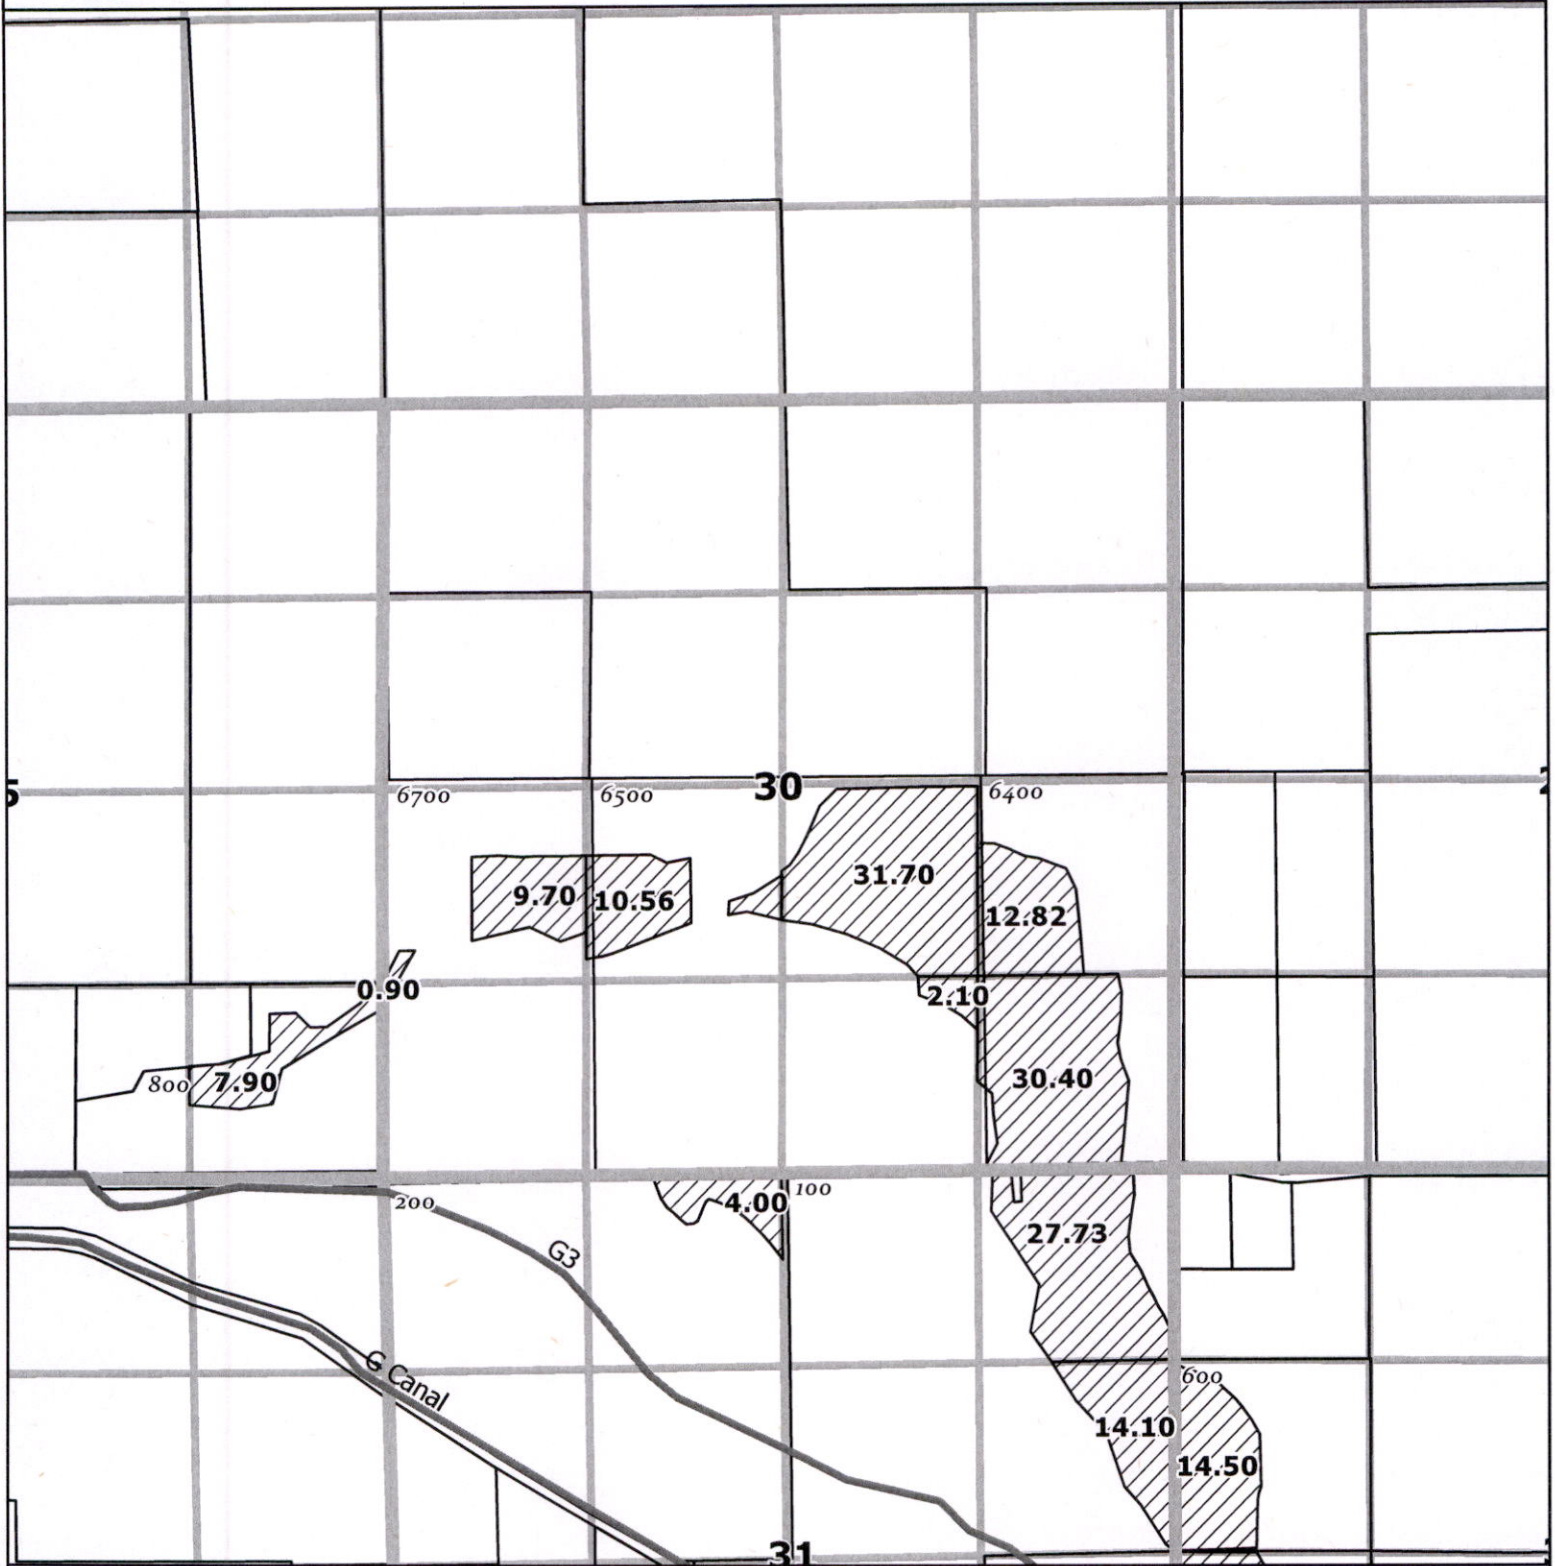

- Place of Use
- Klamath County Taxlot
- QQ Sections and Gov't Lots
- Map Series Sections
- Canal

Received
JUL 07 2025




1,320

Feet

OWRD

DISCLAIMER
This map is not intended to
provide legal dimensions or
locations of property
ownership lines


WATERSOLVING
johnw@watersolving.com

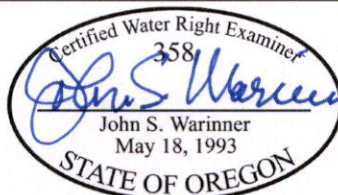

CLAIM OF BENEFICIAL USE MAP
APPLICATION G-16030
PERMIT G-18797
06/23/2025

Map No. 90

T S 40 R 11 E S 31

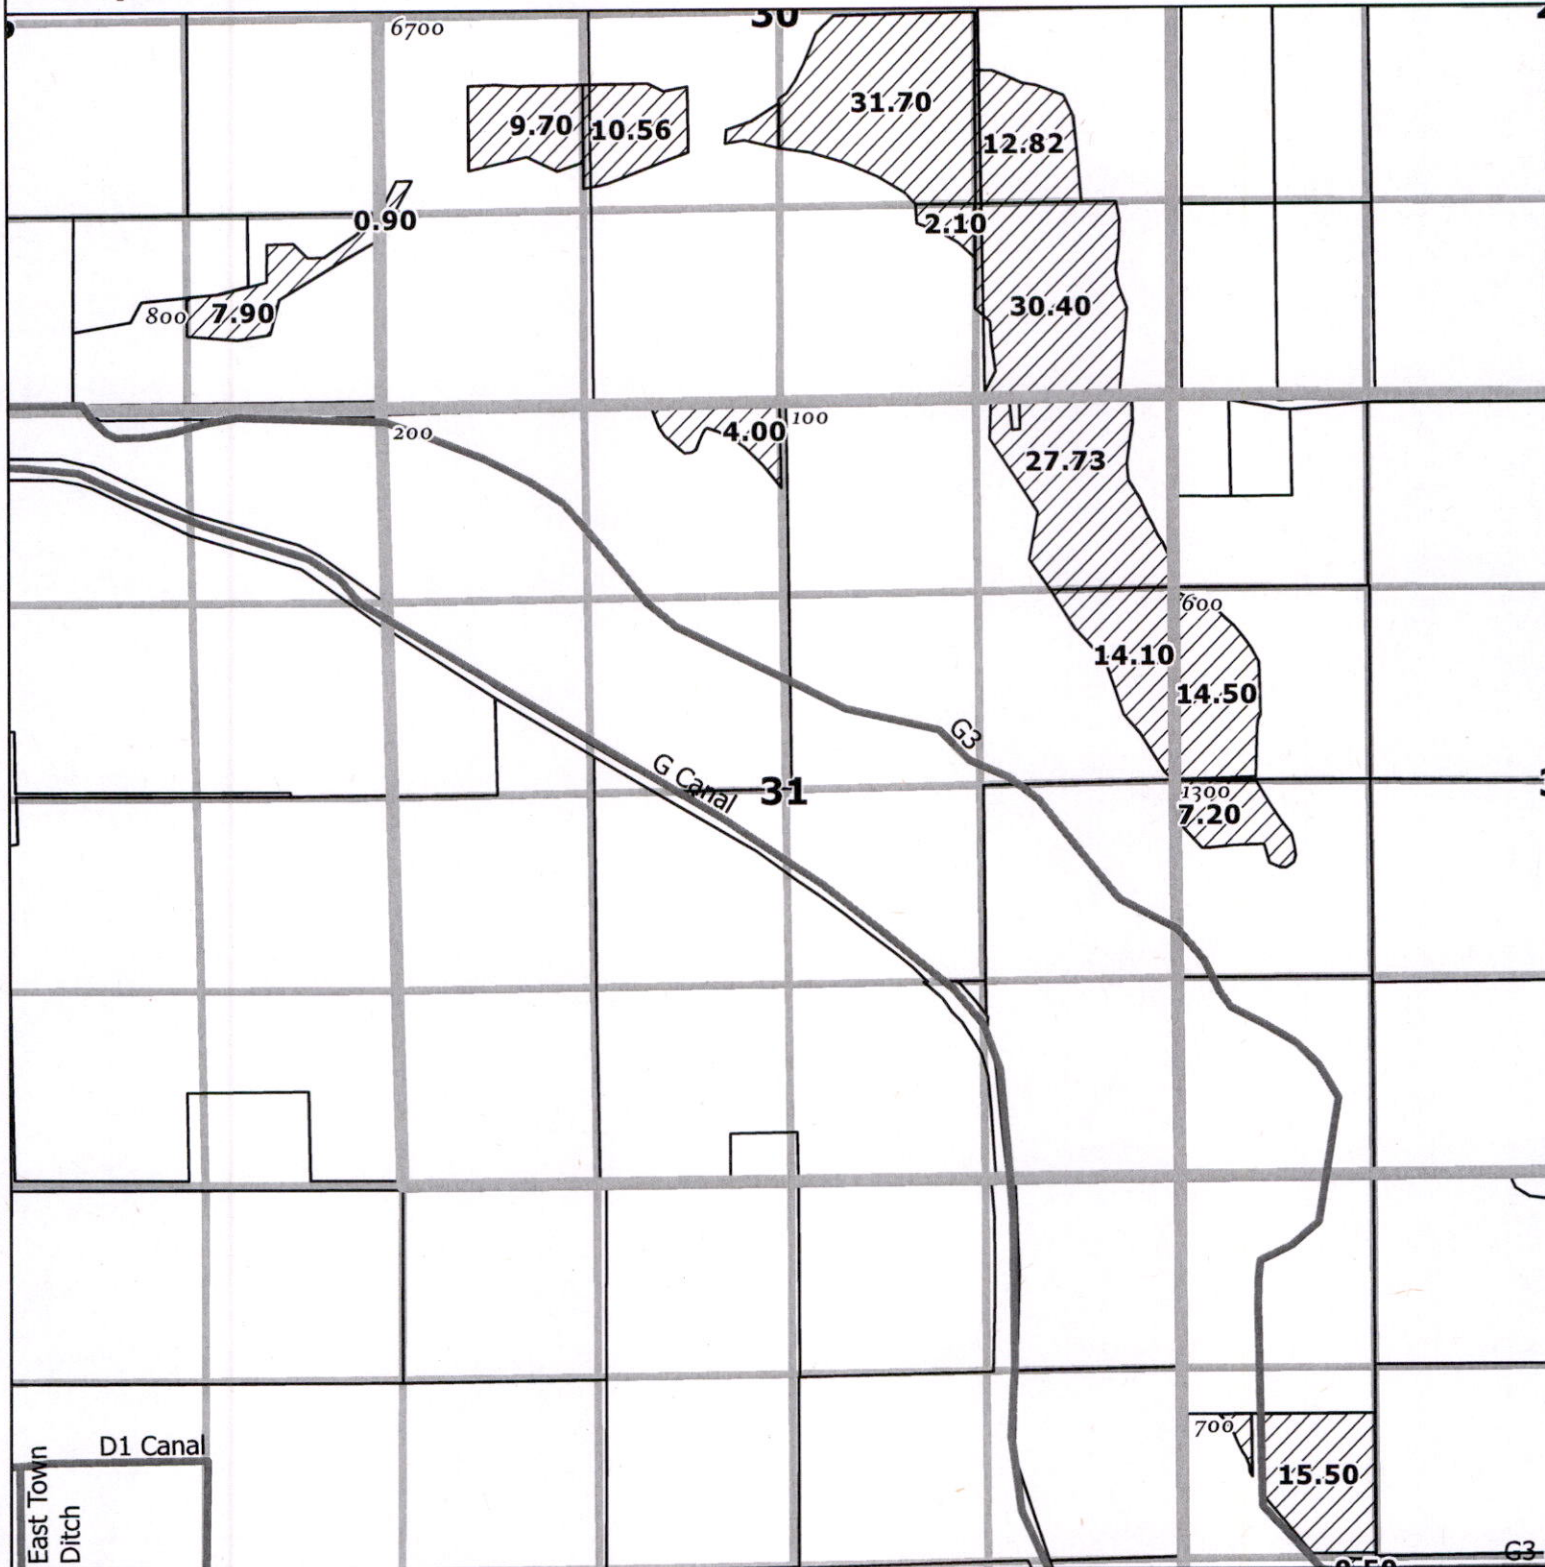

- Place of Use
- Klamath County Taxlot
- QQ Sections and Gov't Lots
- Map Series Sections
- Canal


Received
JUL 07 2025



1,320
Feet

DISCLAIMER
This map is not intended to
provide legal dimensions or
locations of property
ownership lines


WATERSOLVING
johnw@watersolving.com

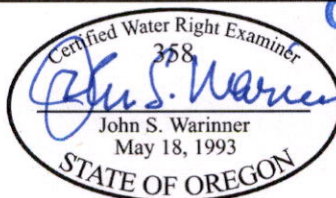

CLAIM OF BENEFICIAL USE MAP
APPLICATION G-16030
PERMIT G-18797
06/23/2025

Map No. 91

T 40 S 11 E S 32

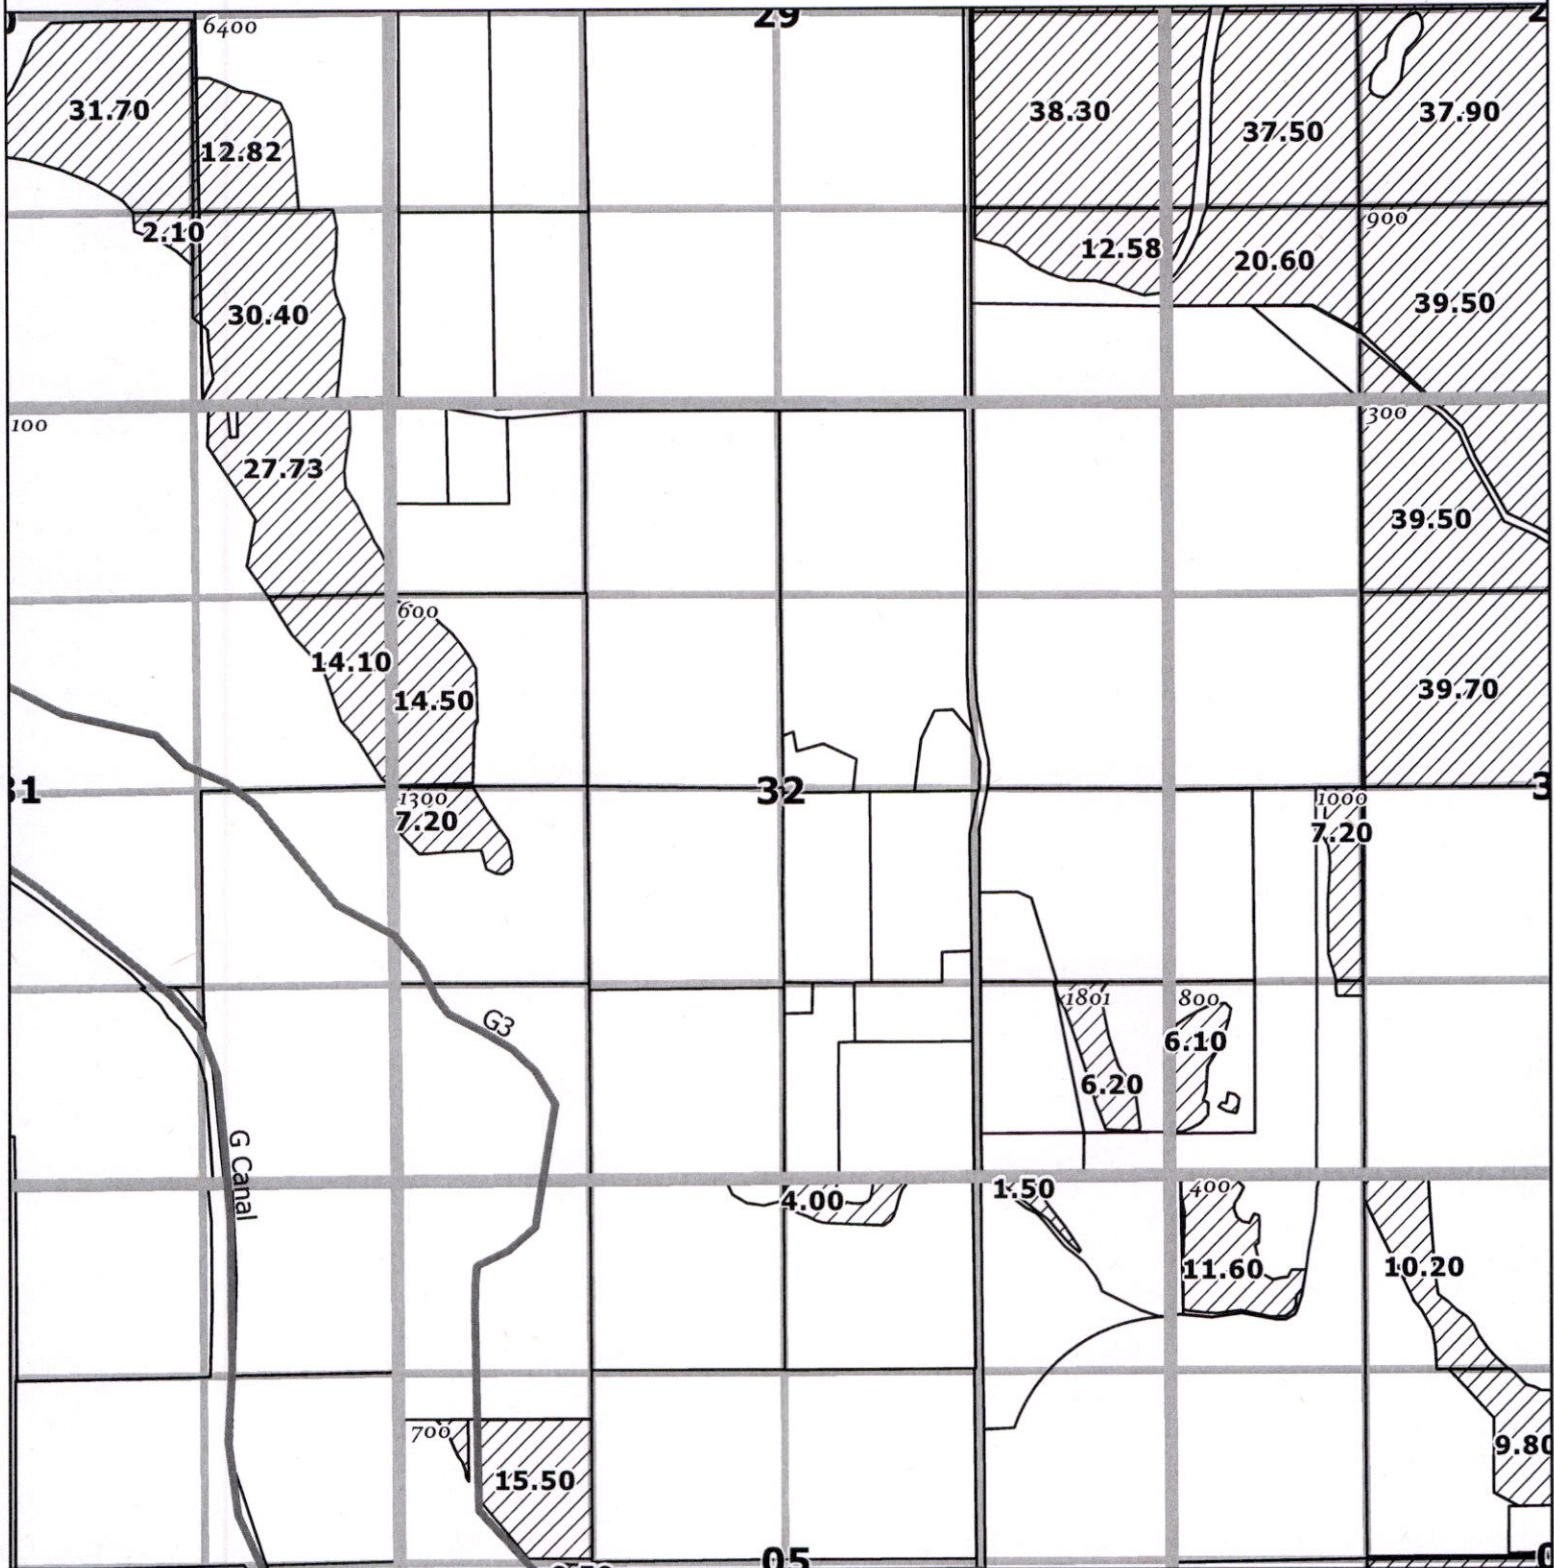

- Place of Use
- Klamath County Taxlot
- QQ Sections and Gov't Lots
- Map Series Sections
- Canal


Received
JUL 07 2025

1,320
Feet

OWRD

DISCLAIMER
This map is not intended to
provide legal dimensions or
locations of property
ownership lines


WATERSOLVING
johnw@watersolving.com

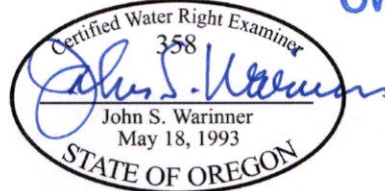

CLAIM OF BENEFICIAL USE MAP
APPLICATION G-16030
PERMIT G-18797
06/23/2025

Map No. 92

T 40 S 11 E S 33

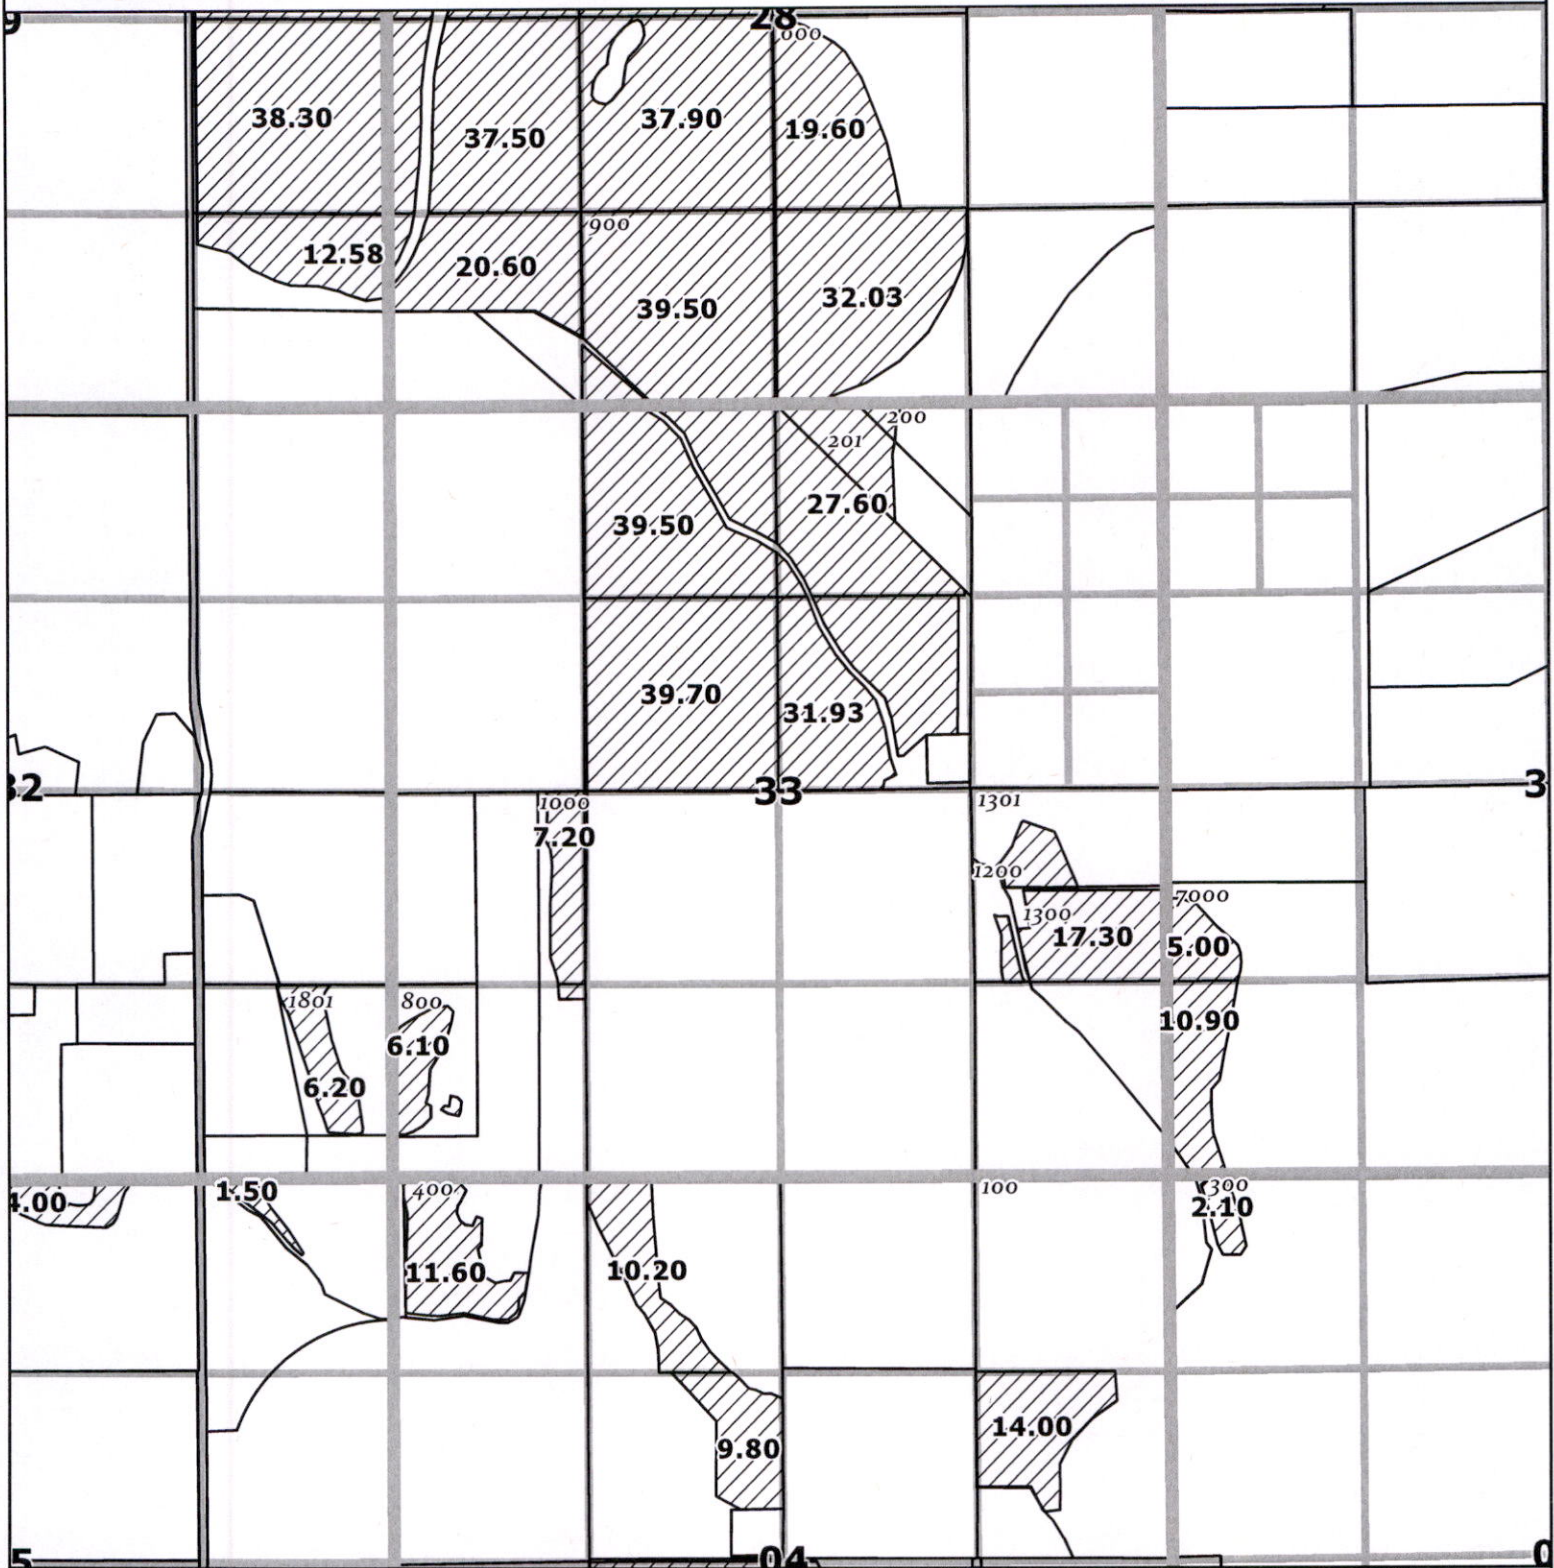

- Place of Use
- Klamath County Taxlot
- QQ Sections and Gov't Lots
- Map Series Sections
- Canal


Received
JUL 07 2025
OWRD



1,320
Feet

DISCLAIMER
This map is not intended to
provide legal dimensions or
locations of property
ownership lines


WATERSOLVING
johnw@watersolving.com

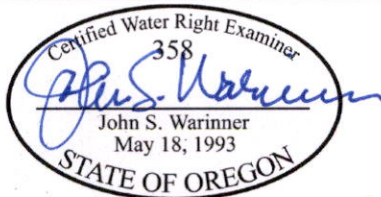

CLAIM OF BENEFICIAL USE MAP
APPLICATION G-16030
PERMIT G-18797
06/23/2025

Map No. 93

T 40 S 11 E S 34

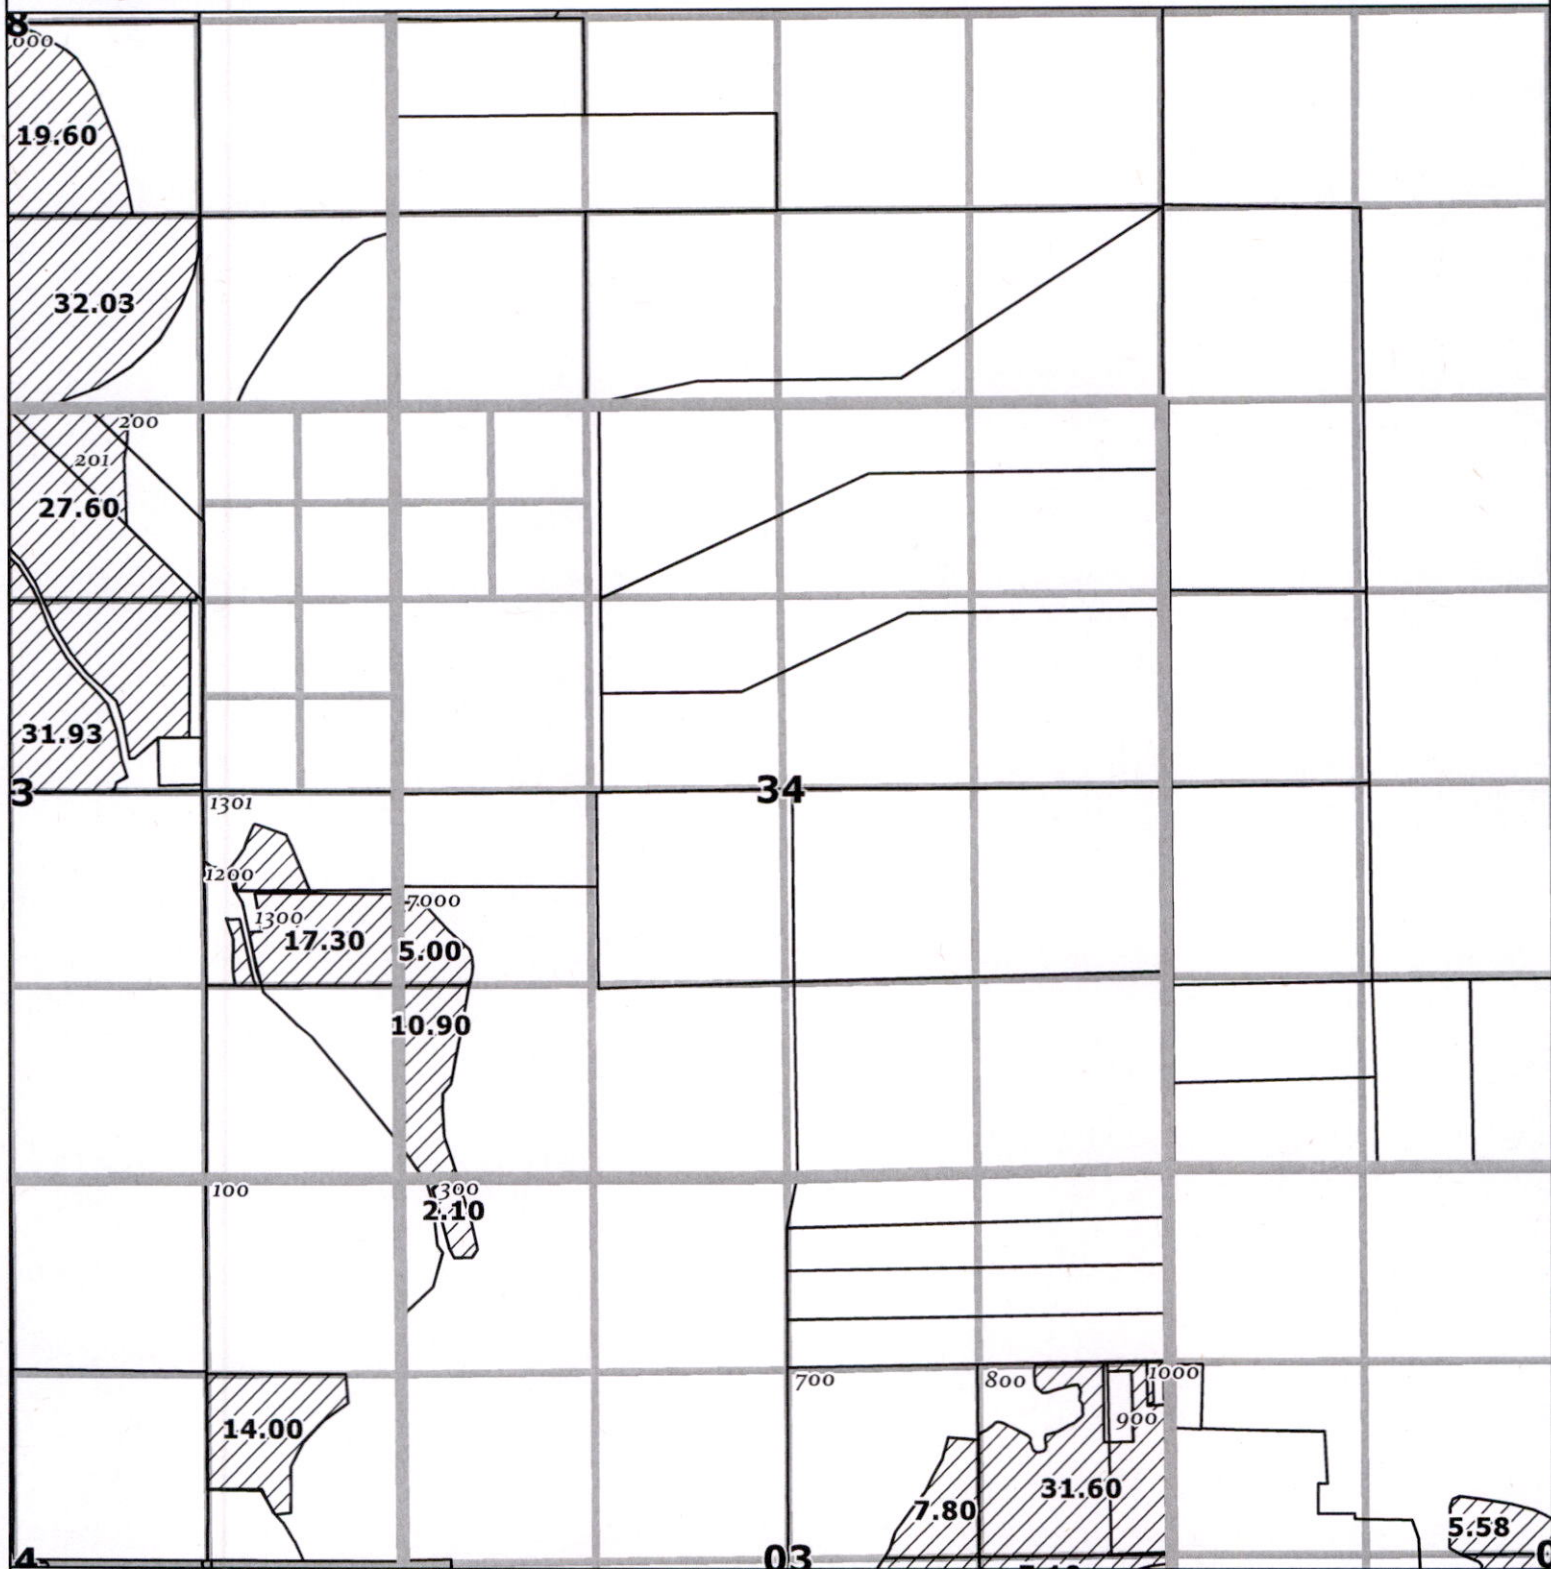

- Place of Use
- Klamath County Taxlot
- QQ Sections and Gov't Lots
- Map Series Sections
- Canal

Received
JUL 07 2025


OWRD



1,320
Feet

DISCLAIMER
This map is not intended to
provide legal dimensions or
locations of property
ownership lines


WATERSOLVING
johnw@watersolving.com

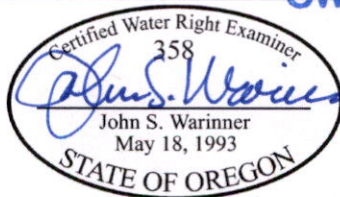

CLAIM OF BENEFICIAL USE MAP
APPLICATION G-16030
PERMIT G-18797
06/23/2025


Map No. 94

T 40 S 12 E S 28

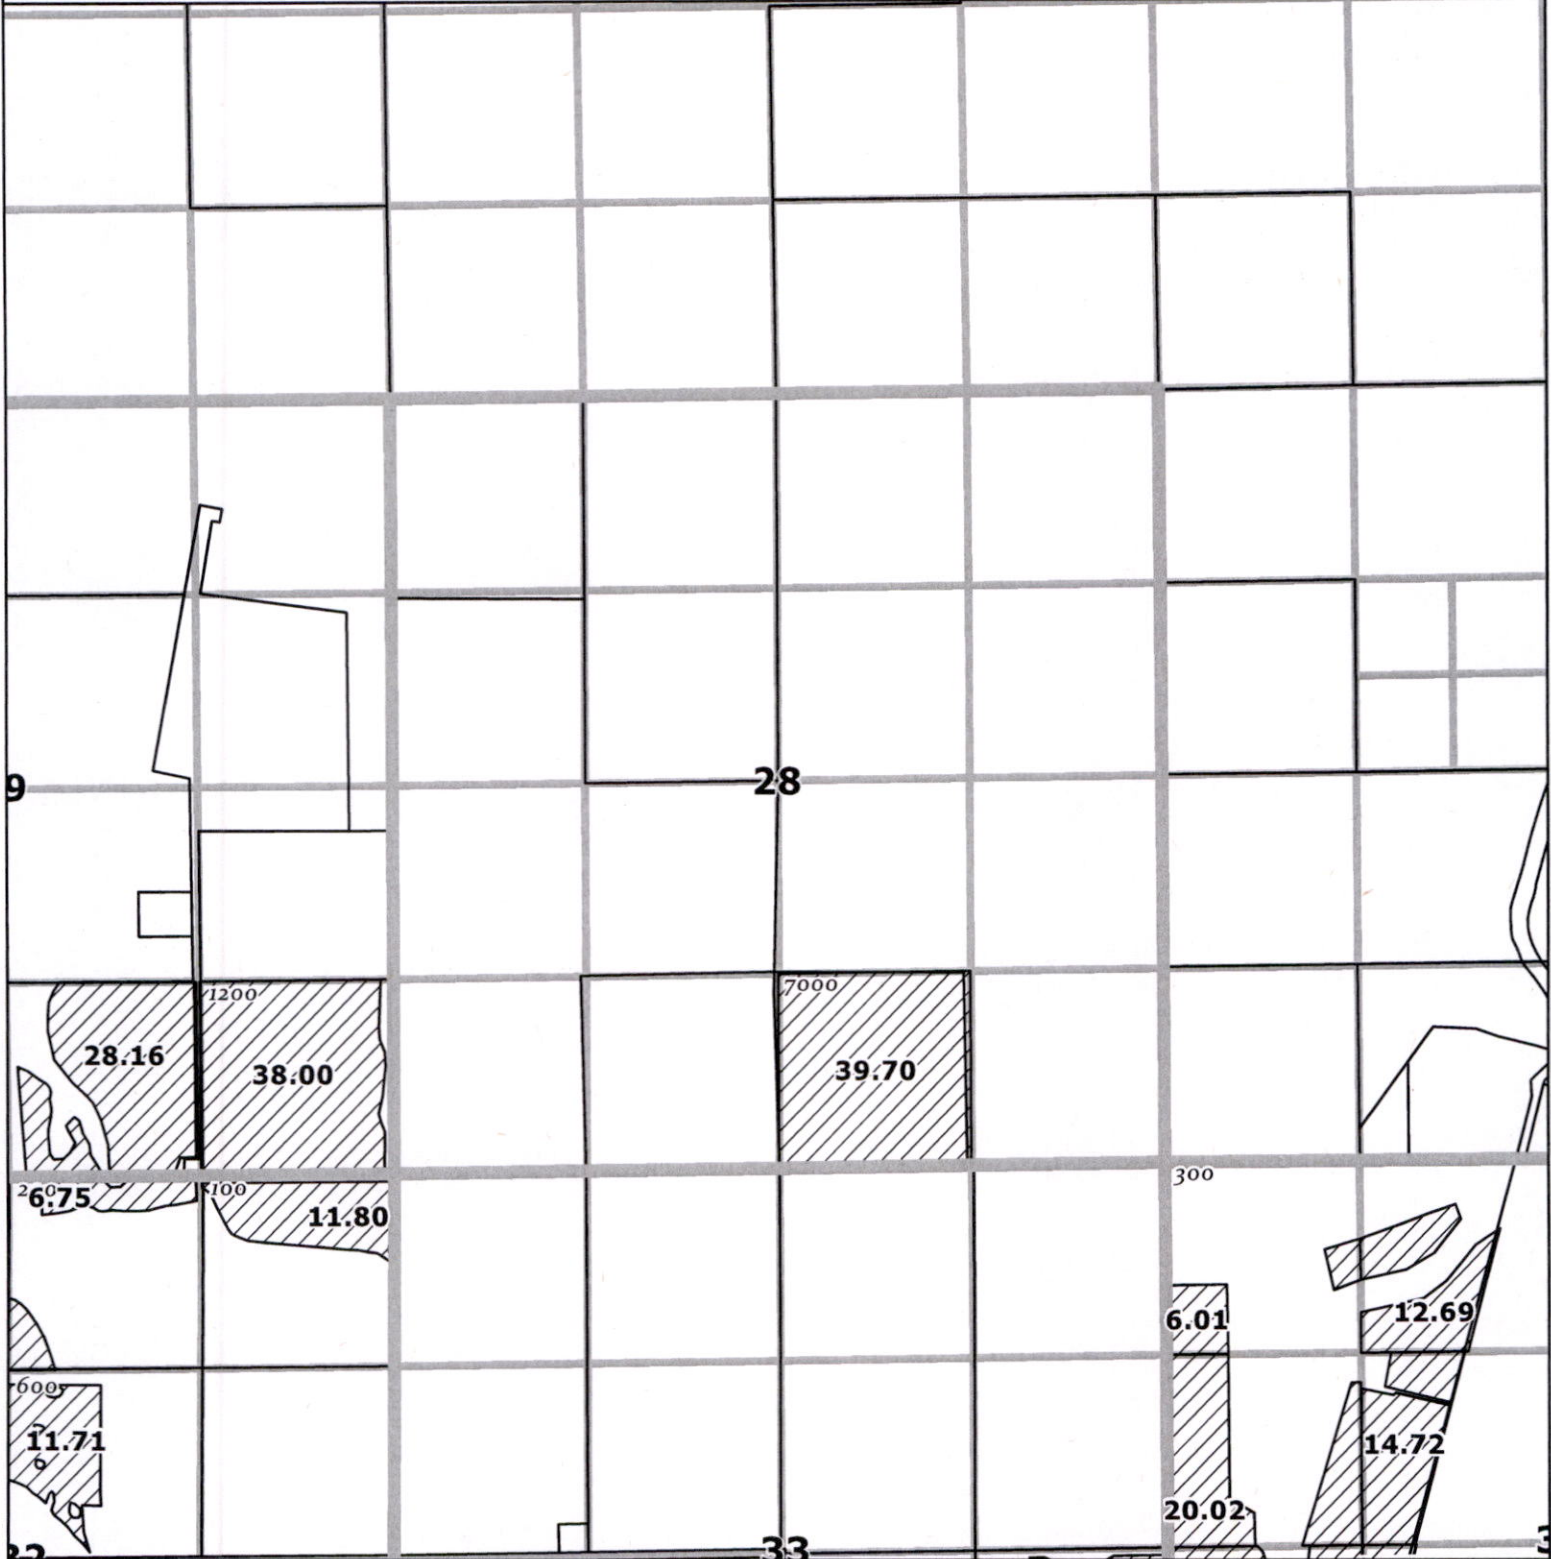


- Place of Use
- Klamath County Taxlot
- QQ Sections and Gov't Lots
- Map Series Sections
- Canal

Received
JUL 07 2025
OWRD

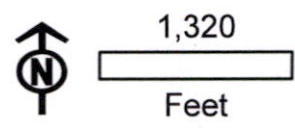

DISCLAIMER
This map is not intended to provide legal dimensions or locations of property ownership lines


WATERSOLVING
johnw@watersolving.com

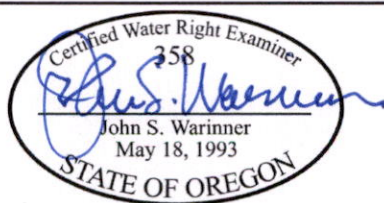

CLAIM OF BENEFICIAL USE MAP
APPLICATION G-16030
PERMIT G-18797
06/23/2025

Map No. 95

T 40 S 12 E S 29

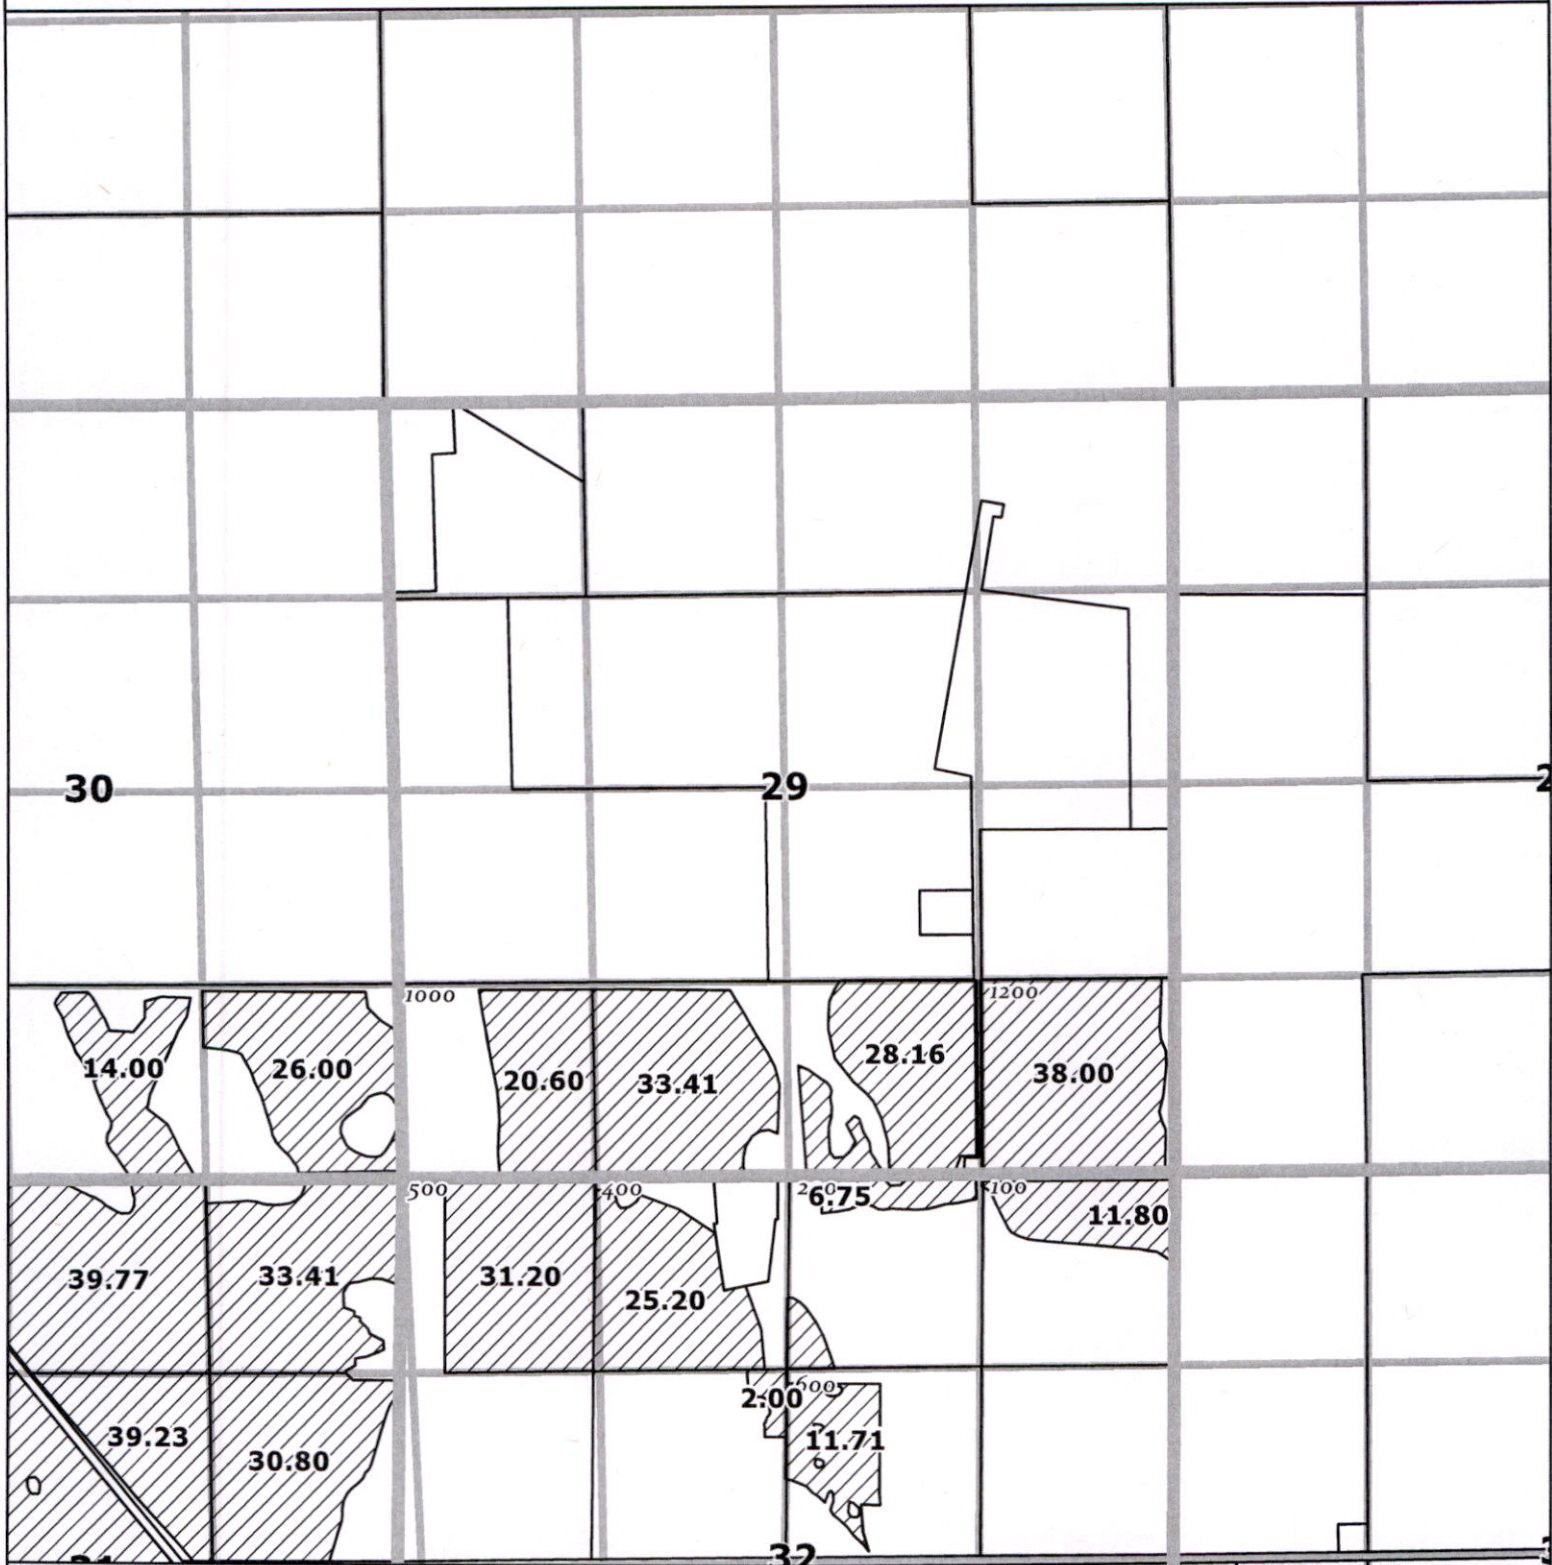

- Place of Use
- Map Series Sections
- Klamath County Taxlot
- Canal
- QQ Sections and Gov't Lots

Received

JUL 07 2025


OWRD



1,320
Feet

DISCLAIMER
This map is not intended to
provide legal dimensions or
locations of property
ownership lines


WATERSOLVING
johnw@watersolving.com

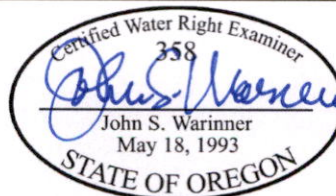

CLAIM OF BENEFICIAL USE MAP
APPLICATION G-16030
PERMIT G-18797
06/23/2025

Map No. 96


T 40 S 12 E S 30

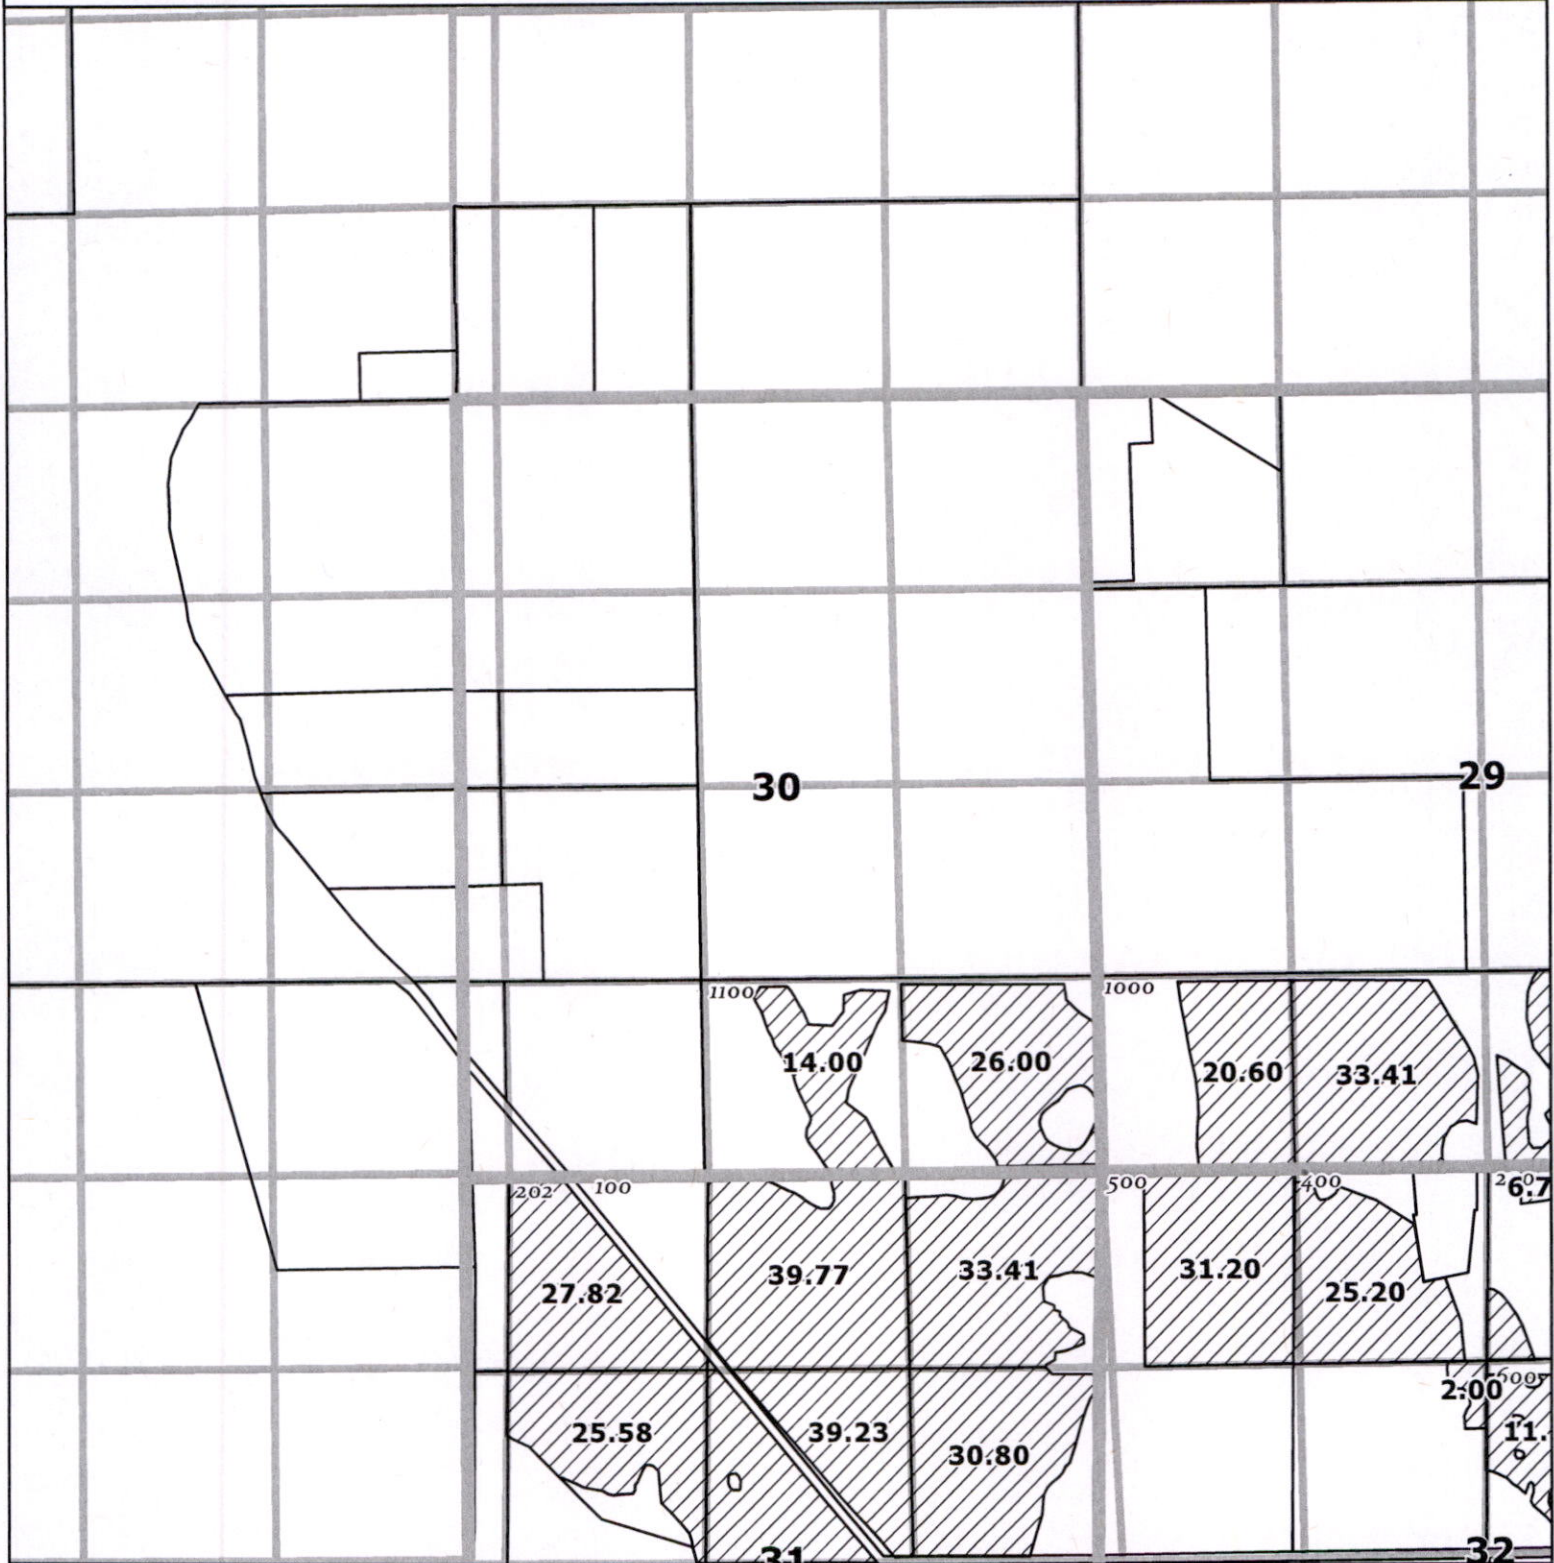

- Place of Use
- Klamath County Taxlot
- QQ Sections and Gov't Lots
- Map Series Sections
- Canal


Received
JUL 07 2025

OWRD

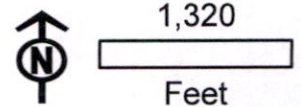

DISCLAIMER
This map is not intended to
provide legal dimensions or
locations of property
ownership lines


WATERSOLVING
johnw@watersolving.com

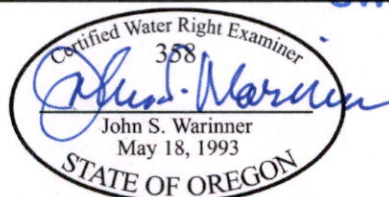

CLAIM OF BENEFICIAL USE MAP
APPLICATION G-16030
PERMIT G-18797
06/23/2025

Map No. 97

T S 40 R 12 S 31

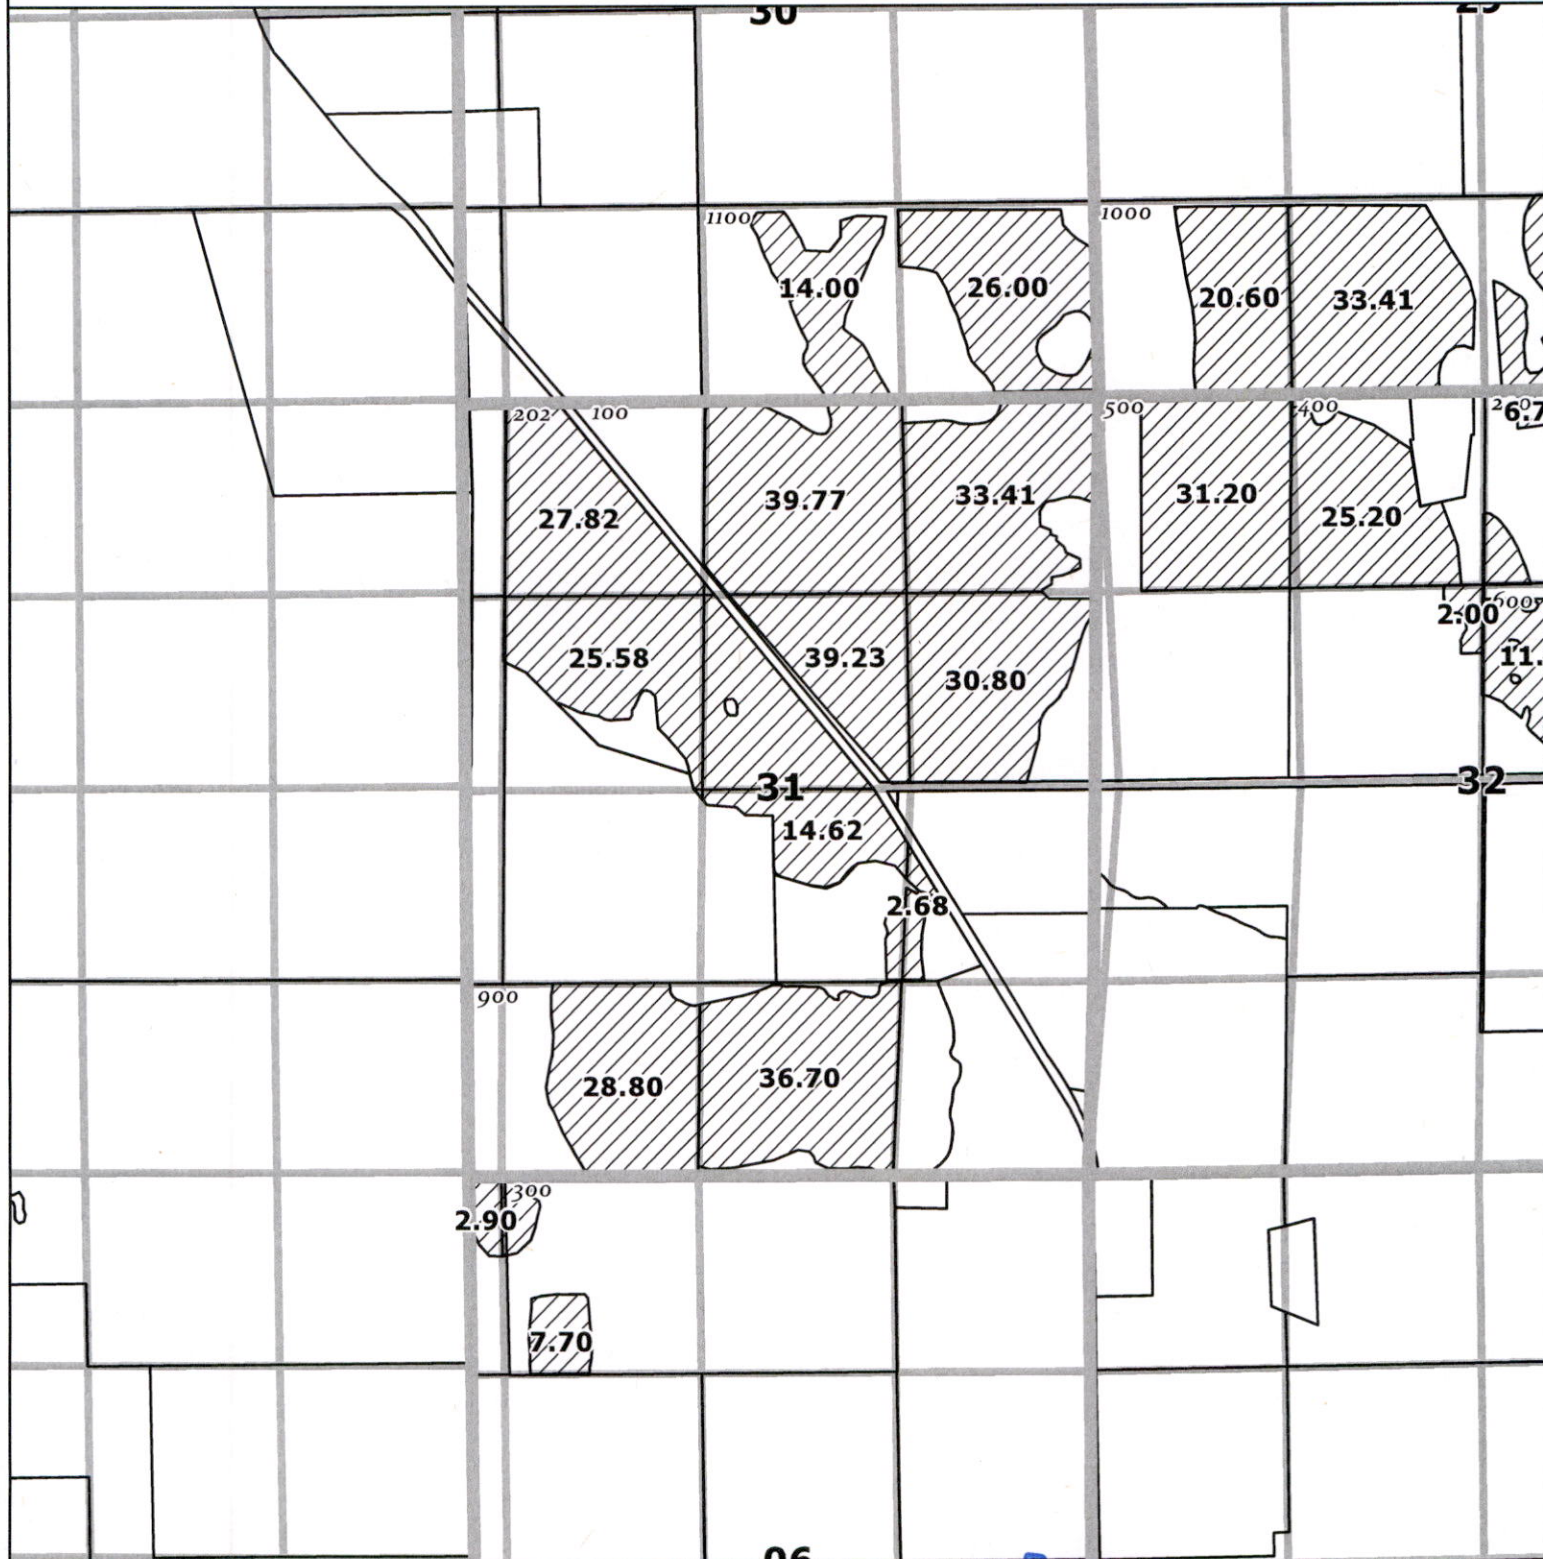

- Place of Use
- Klamath County Taxlot
- QQ Sections and Gov't Lots
- Map Series Sections
- Canal

Received

JUL 07 2025

OWRD




1,320

Feet

DISCLAIMER
This map is not intended to
provide legal dimensions or
locations of property
ownership lines


WATERSOLVING
johnw@watersolving.com

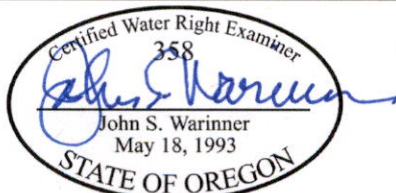

CLAIM OF BENEFICIAL USE MAP
APPLICATION G-16030
PERMIT G-18797
06/23/2025

Map No. 98

T 40 S 12 E S 32

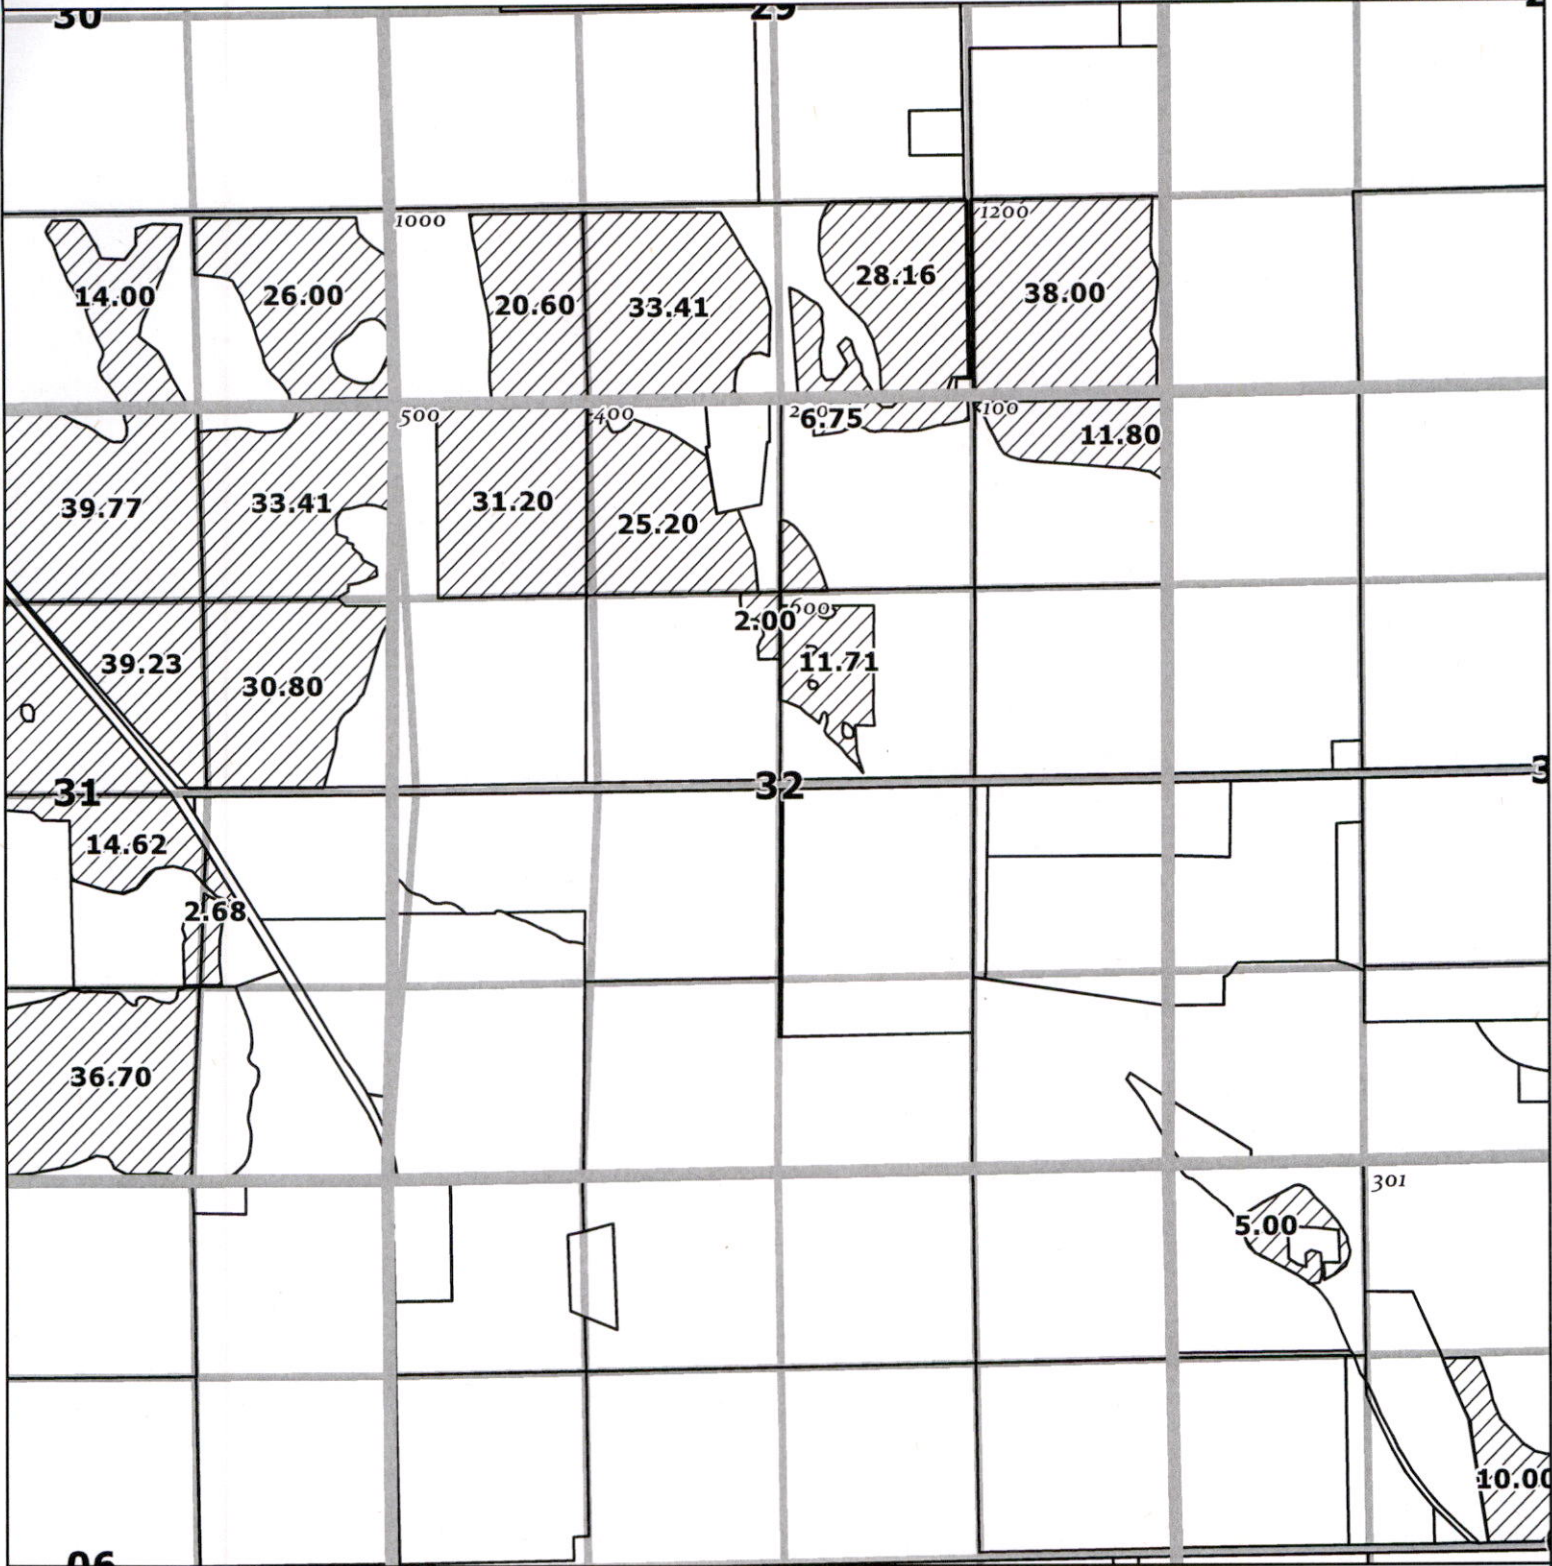

- Place of Use
- Klamath County Taxlot
- QQ Sections and Gov't Lots
- Map Series Sections
- Canal

Received
JUL 07 2025




1,320
Feet

OWRD

DISCLAIMER
This map is not intended to
provide legal dimensions or
locations of property
ownership lines


WATERSOLVING
johnw@watersolving.com

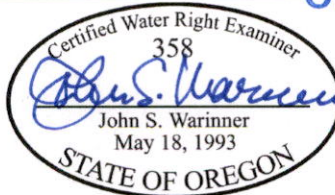

CLAIM OF BENEFICIAL USE MAP
APPLICATION G-16030
PERMIT G-18797
06/23/2025

Map No. 99

T 40 S 12 E S 33

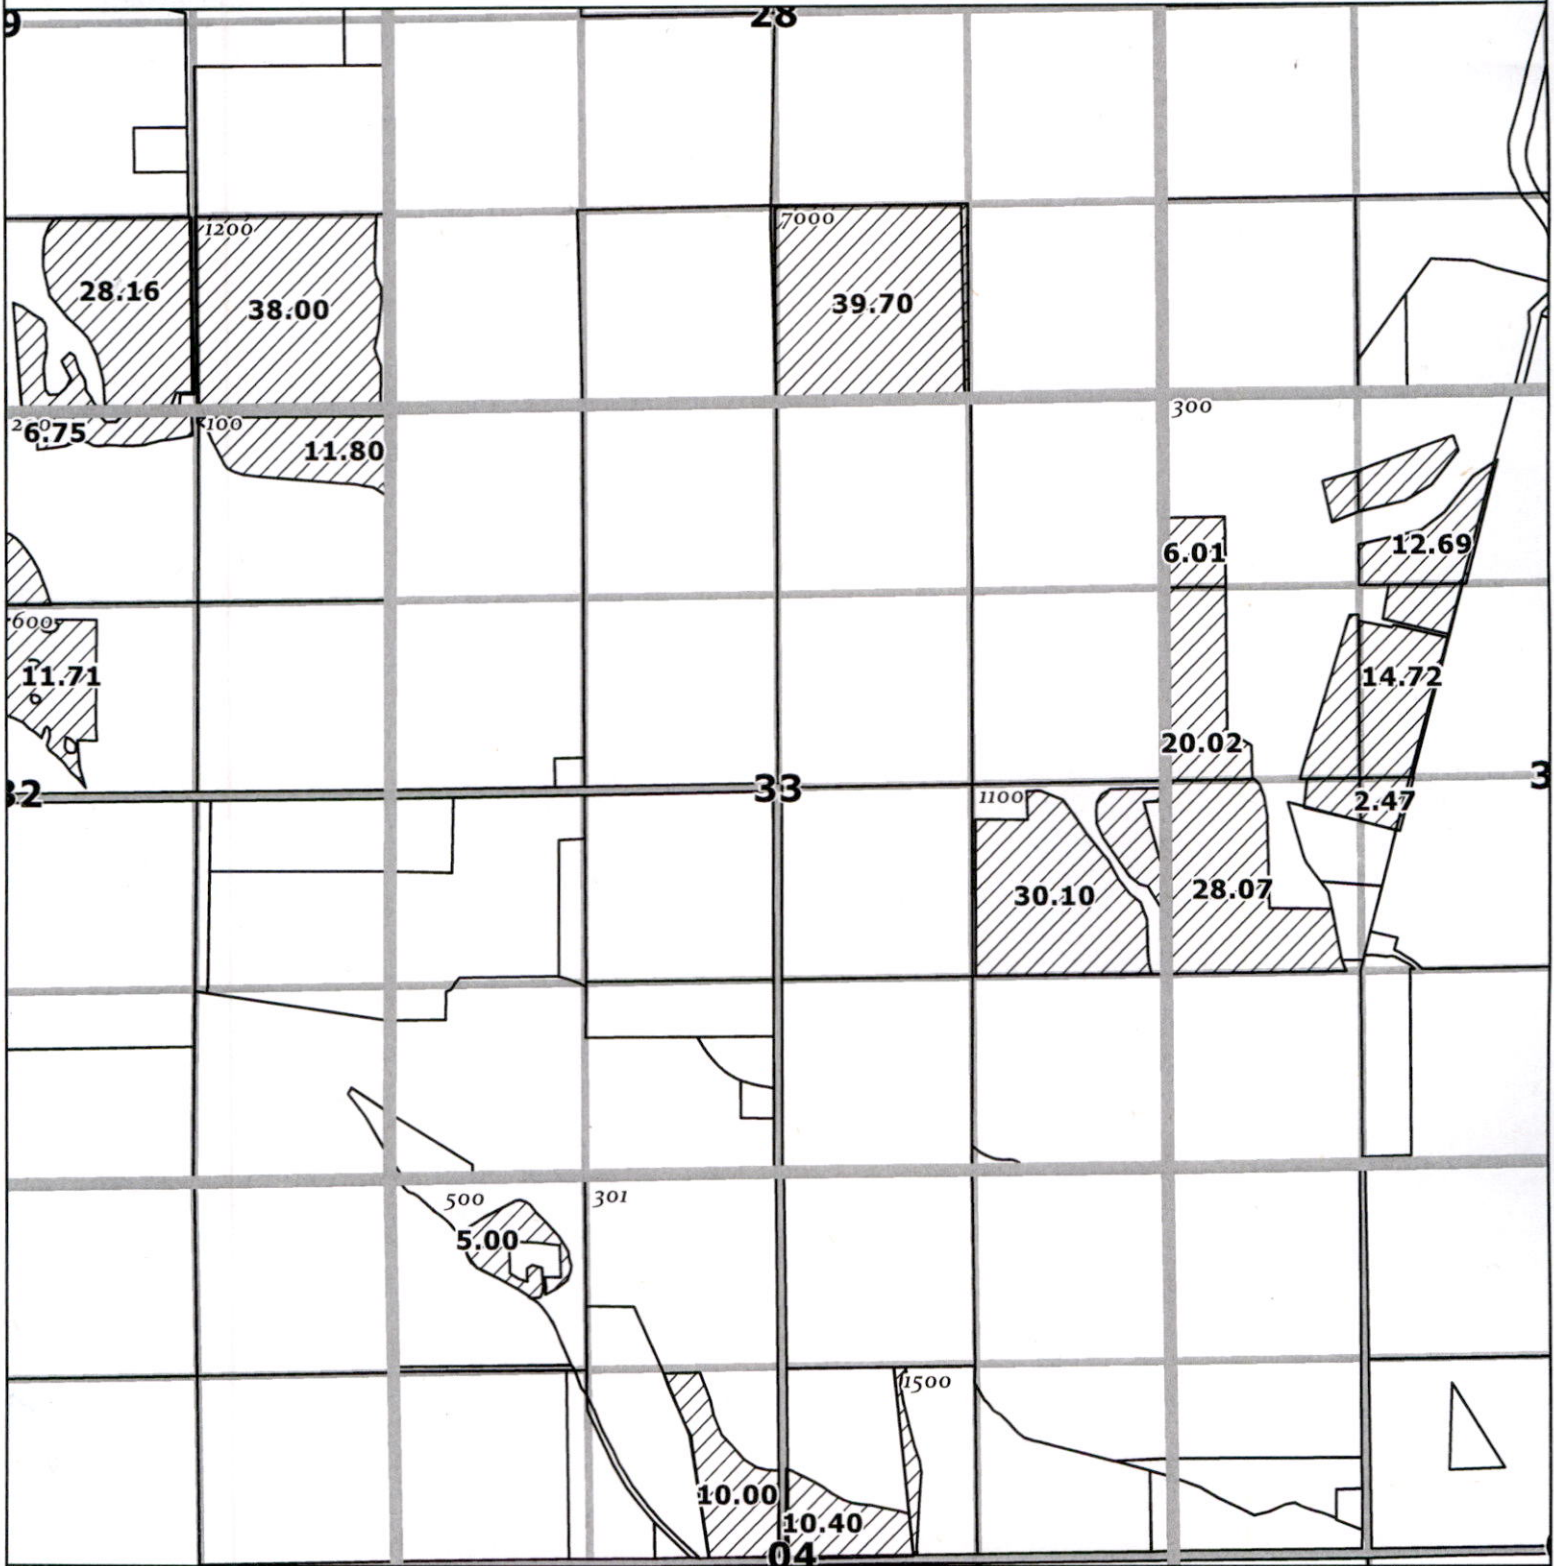

- Place of Use
- Klamath County Taxlot
- QQ Sections and Gov't Lots
- Map Series Sections
- Canal


Received
JUL 07 2025
OWRD



1,320
Feet

DISCLAIMER
This map is not intended to
provide legal dimensions or
locations of property
ownership lines


WATERSOLVING
johnw@watersolving.com

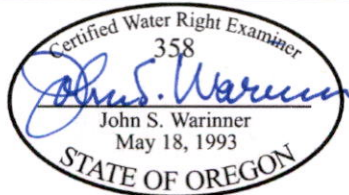

CLAIM OF BENEFICIAL USE MAP
APPLICATION G-16030
PERMIT G-18797
06/23/2025


Map No. 100

T 40 S 12 E S 34

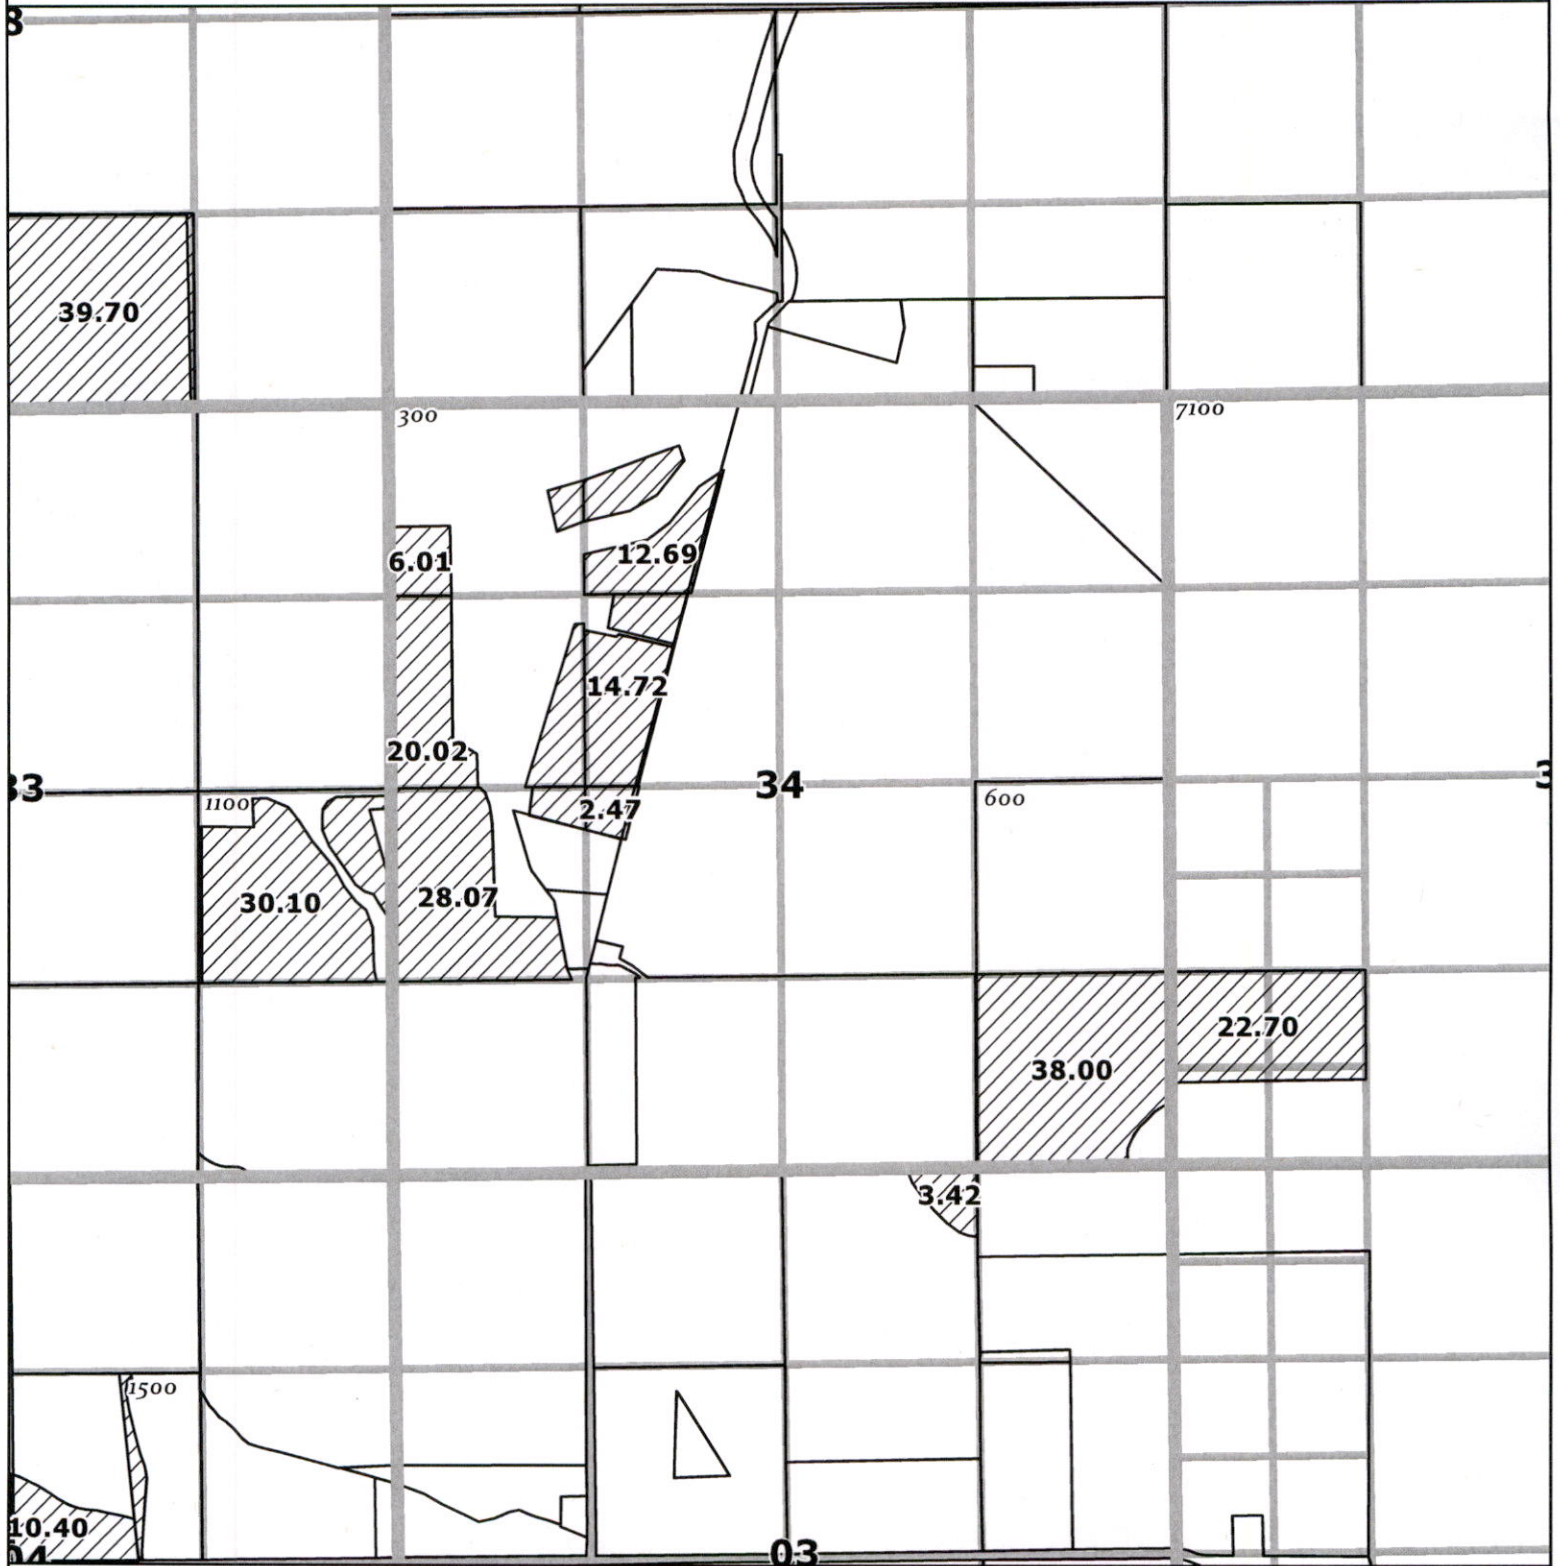

- Place of Use
- Map Series Sections
- Klamath County Taxlot
- Canal
- QQ Sections and Gov't Lots


Received
JUL 07 2025

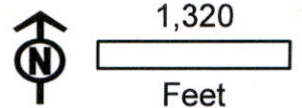

OWRD

DISCLAIMER
This map is not intended to
provide legal dimensions or
locations of property
ownership lines


WATERSOLVING
johnw@watersolving.com

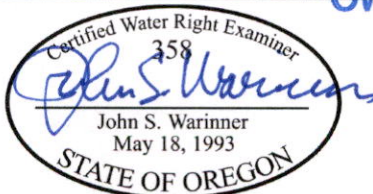

CLAIM OF BENEFICIAL USE MAP
APPLICATION G-16030
PERMIT G-18797
06/23/2025

Map No. 101

T 40 S 12 E S 35

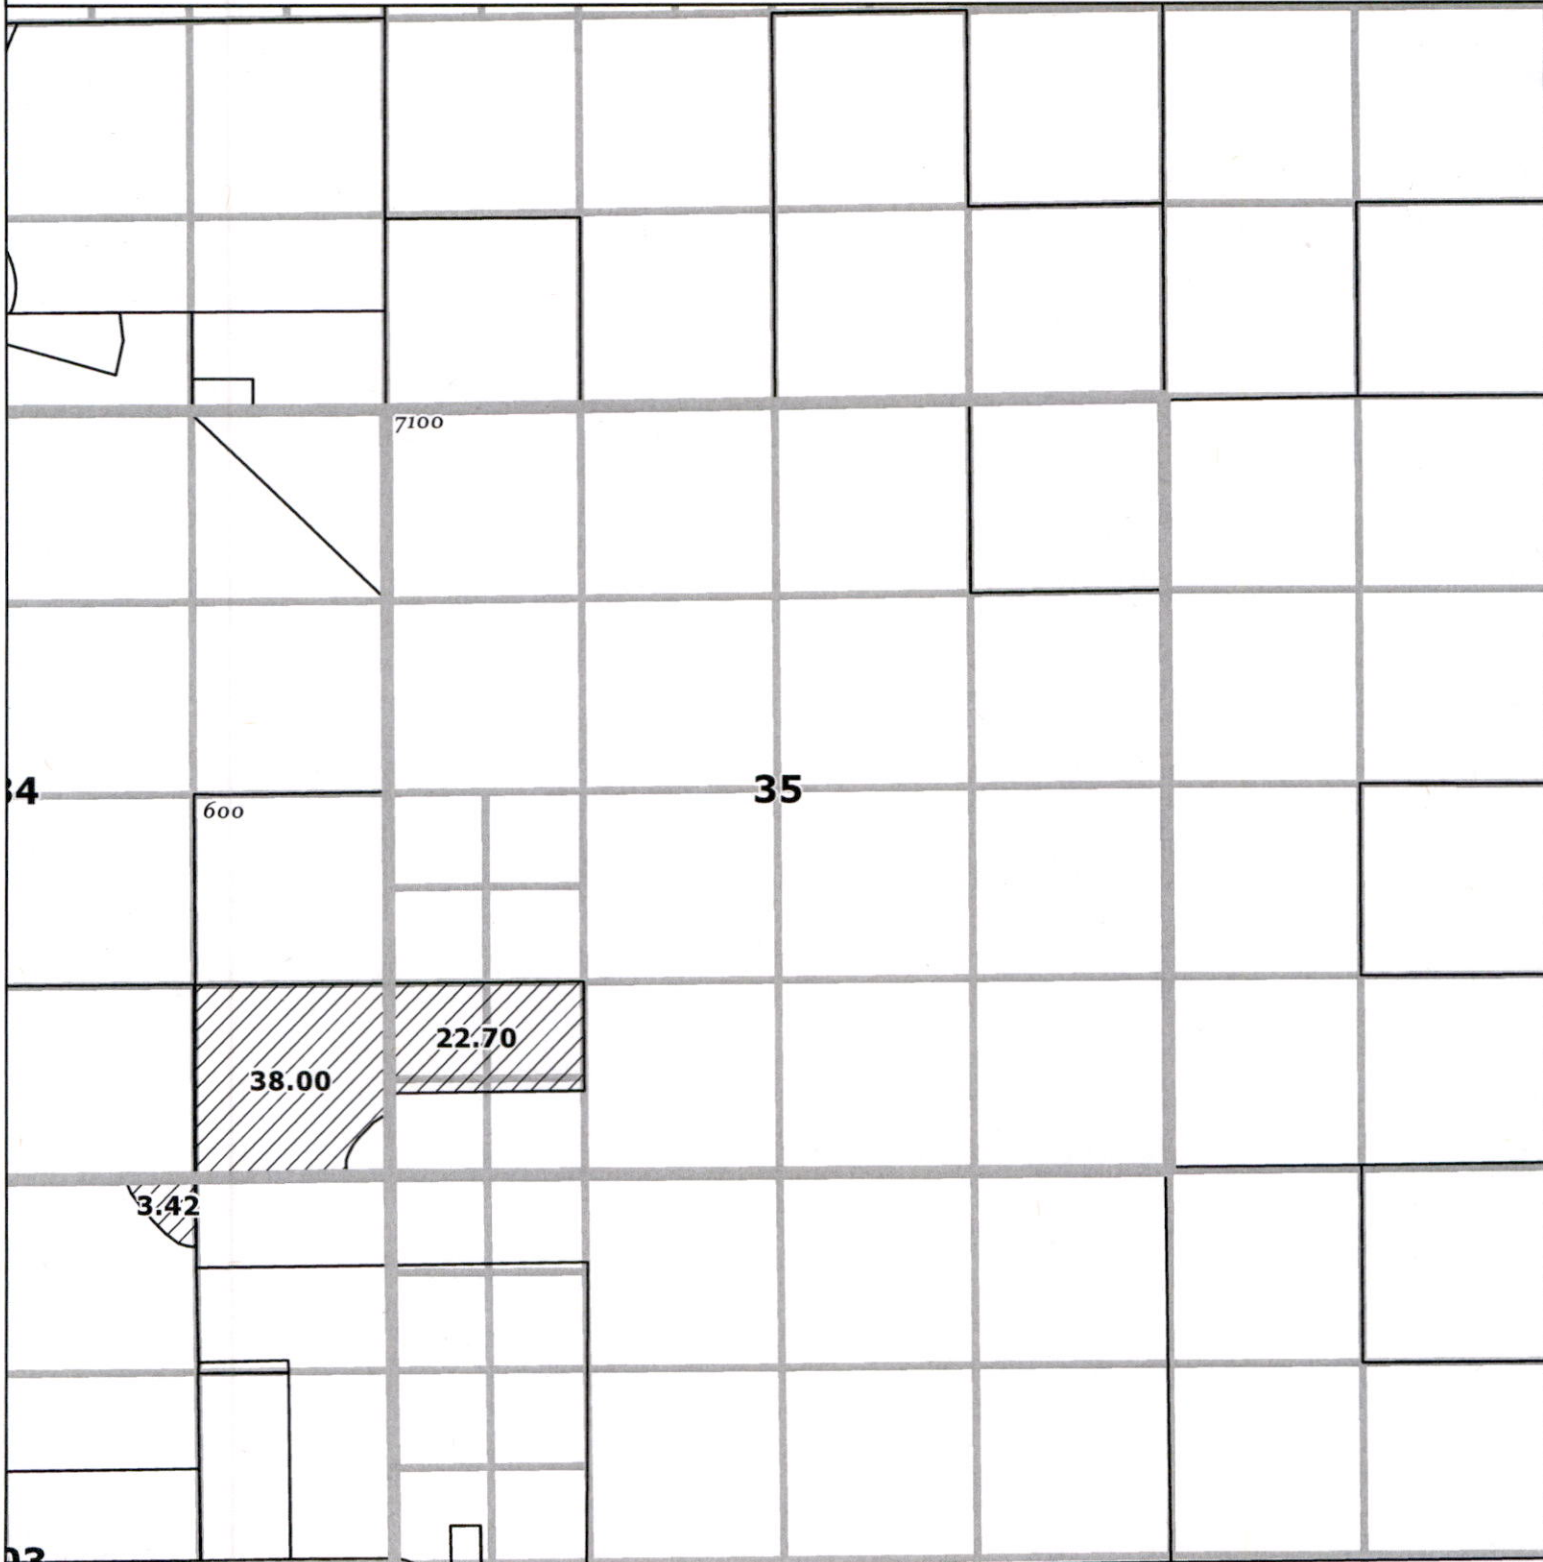

- Place of Use
- Klamath County Taxlot
- QQ Sections and Gov't Lots
- Map Series Sections
- Canal

Received
JUL 07 2025




1,320
Feet

OWRD

DISCLAIMER
This map is not intended to
provide legal dimensions or
locations of property
ownership lines


WATERSOLVING
johnw@watersolving.com

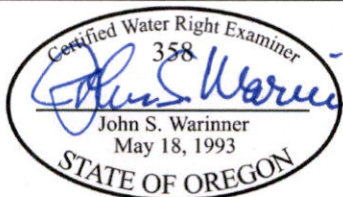

CLAIM OF BENEFICIAL USE MAP
APPLICATION G-16030
PERMIT G-18797
06/23/2025


Map No. 102

T S R S
41 S 10 E 03

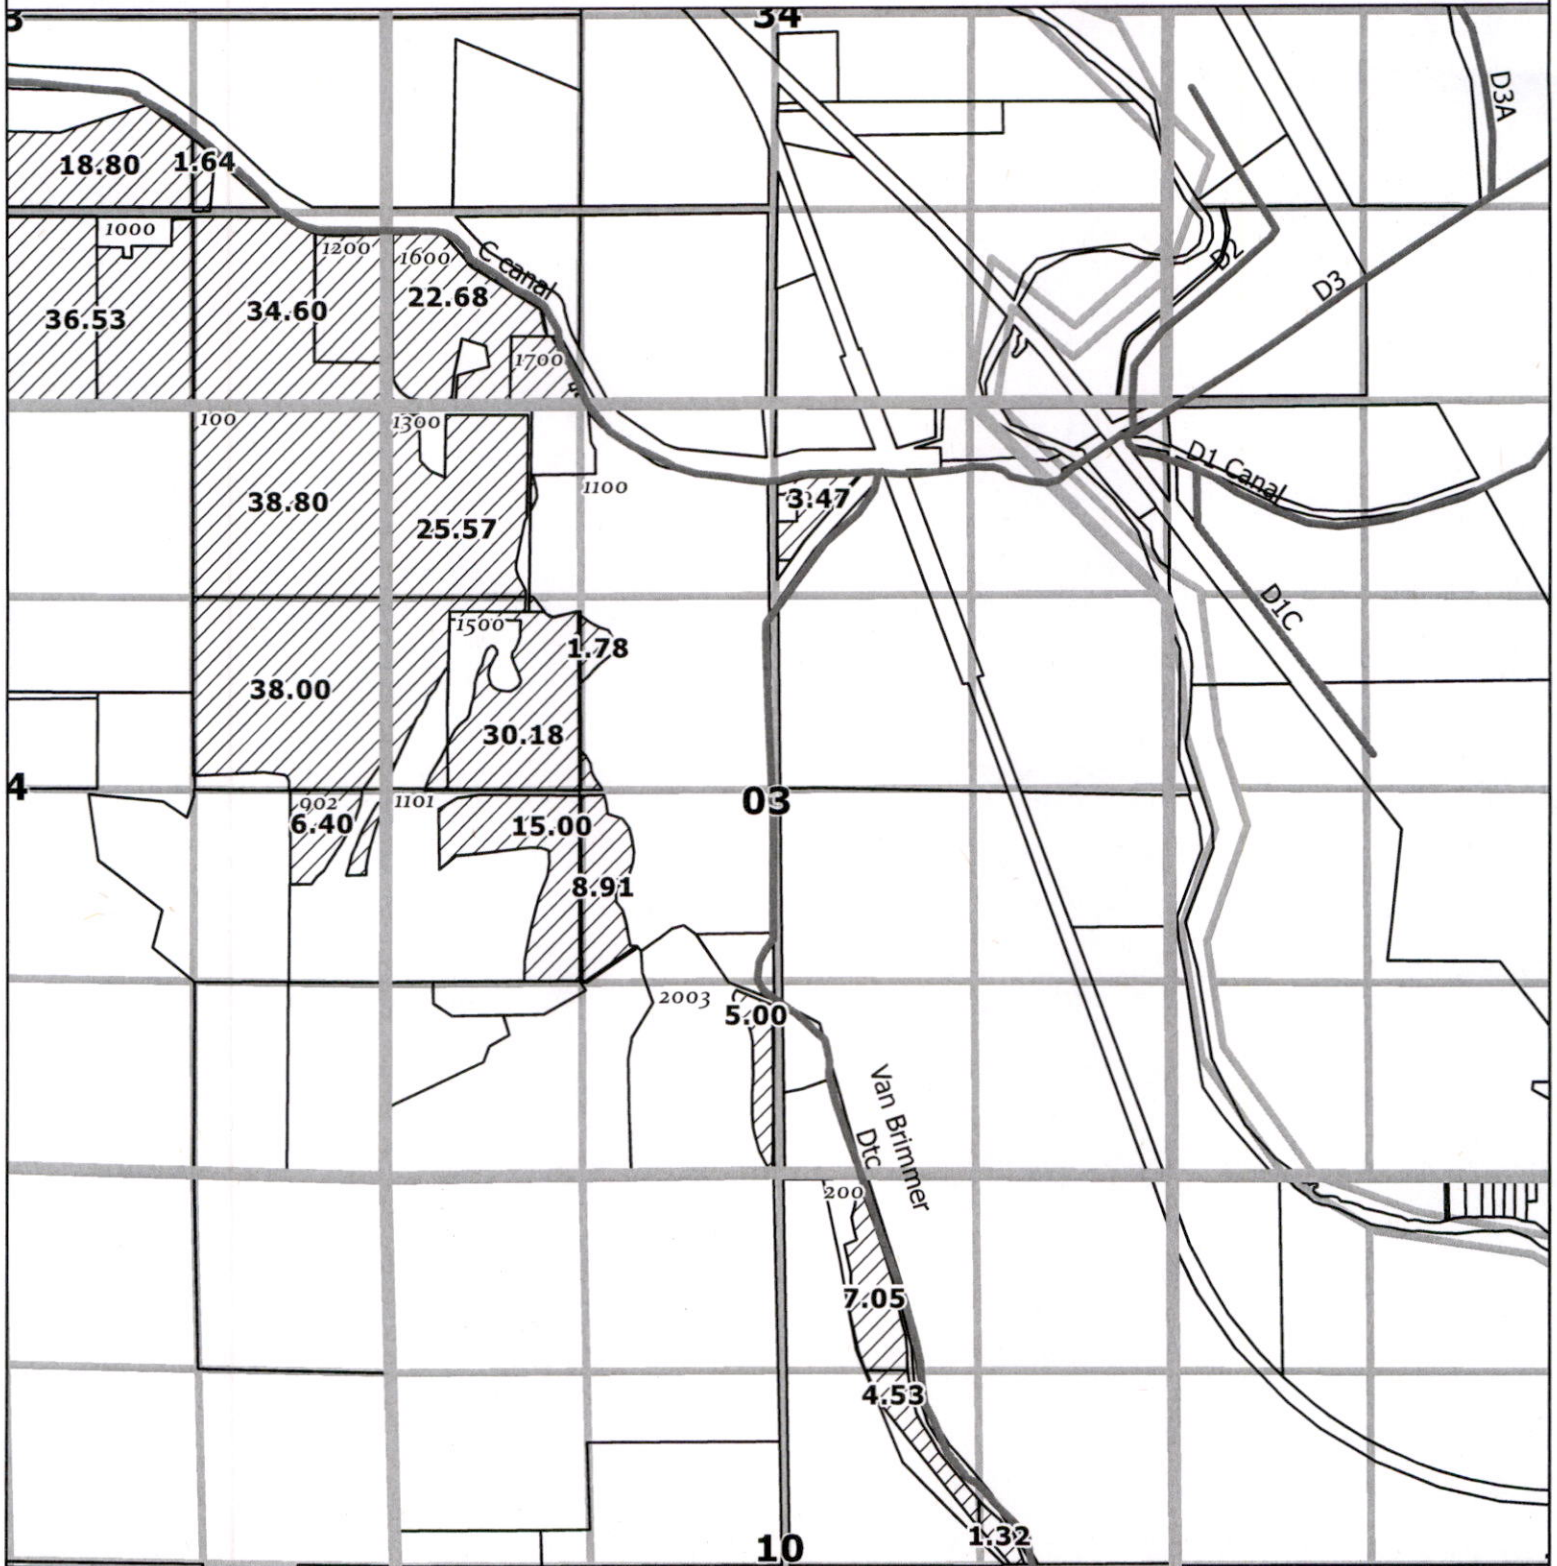


- Place of Use
- Klamath County Taxlot
- QQ Sections and Gov't Lots
- Map Series Sections
- Canal

Received
JUL 07 2025
OWRD

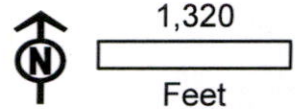

DISCLAIMER
This map is not intended to
provide legal dimensions or
locations of property
ownership lines


WATERSOLVING
johnw@watersolving.com

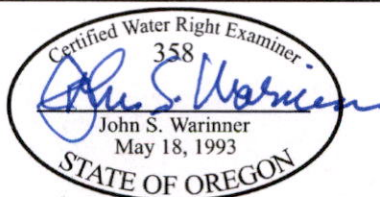

CLAIM OF BENEFICIAL USE MAP
APPLICATION G-16030
PERMIT G-18797
06/23/2025


Map No. 103

T S R S
41 S 10 E 04

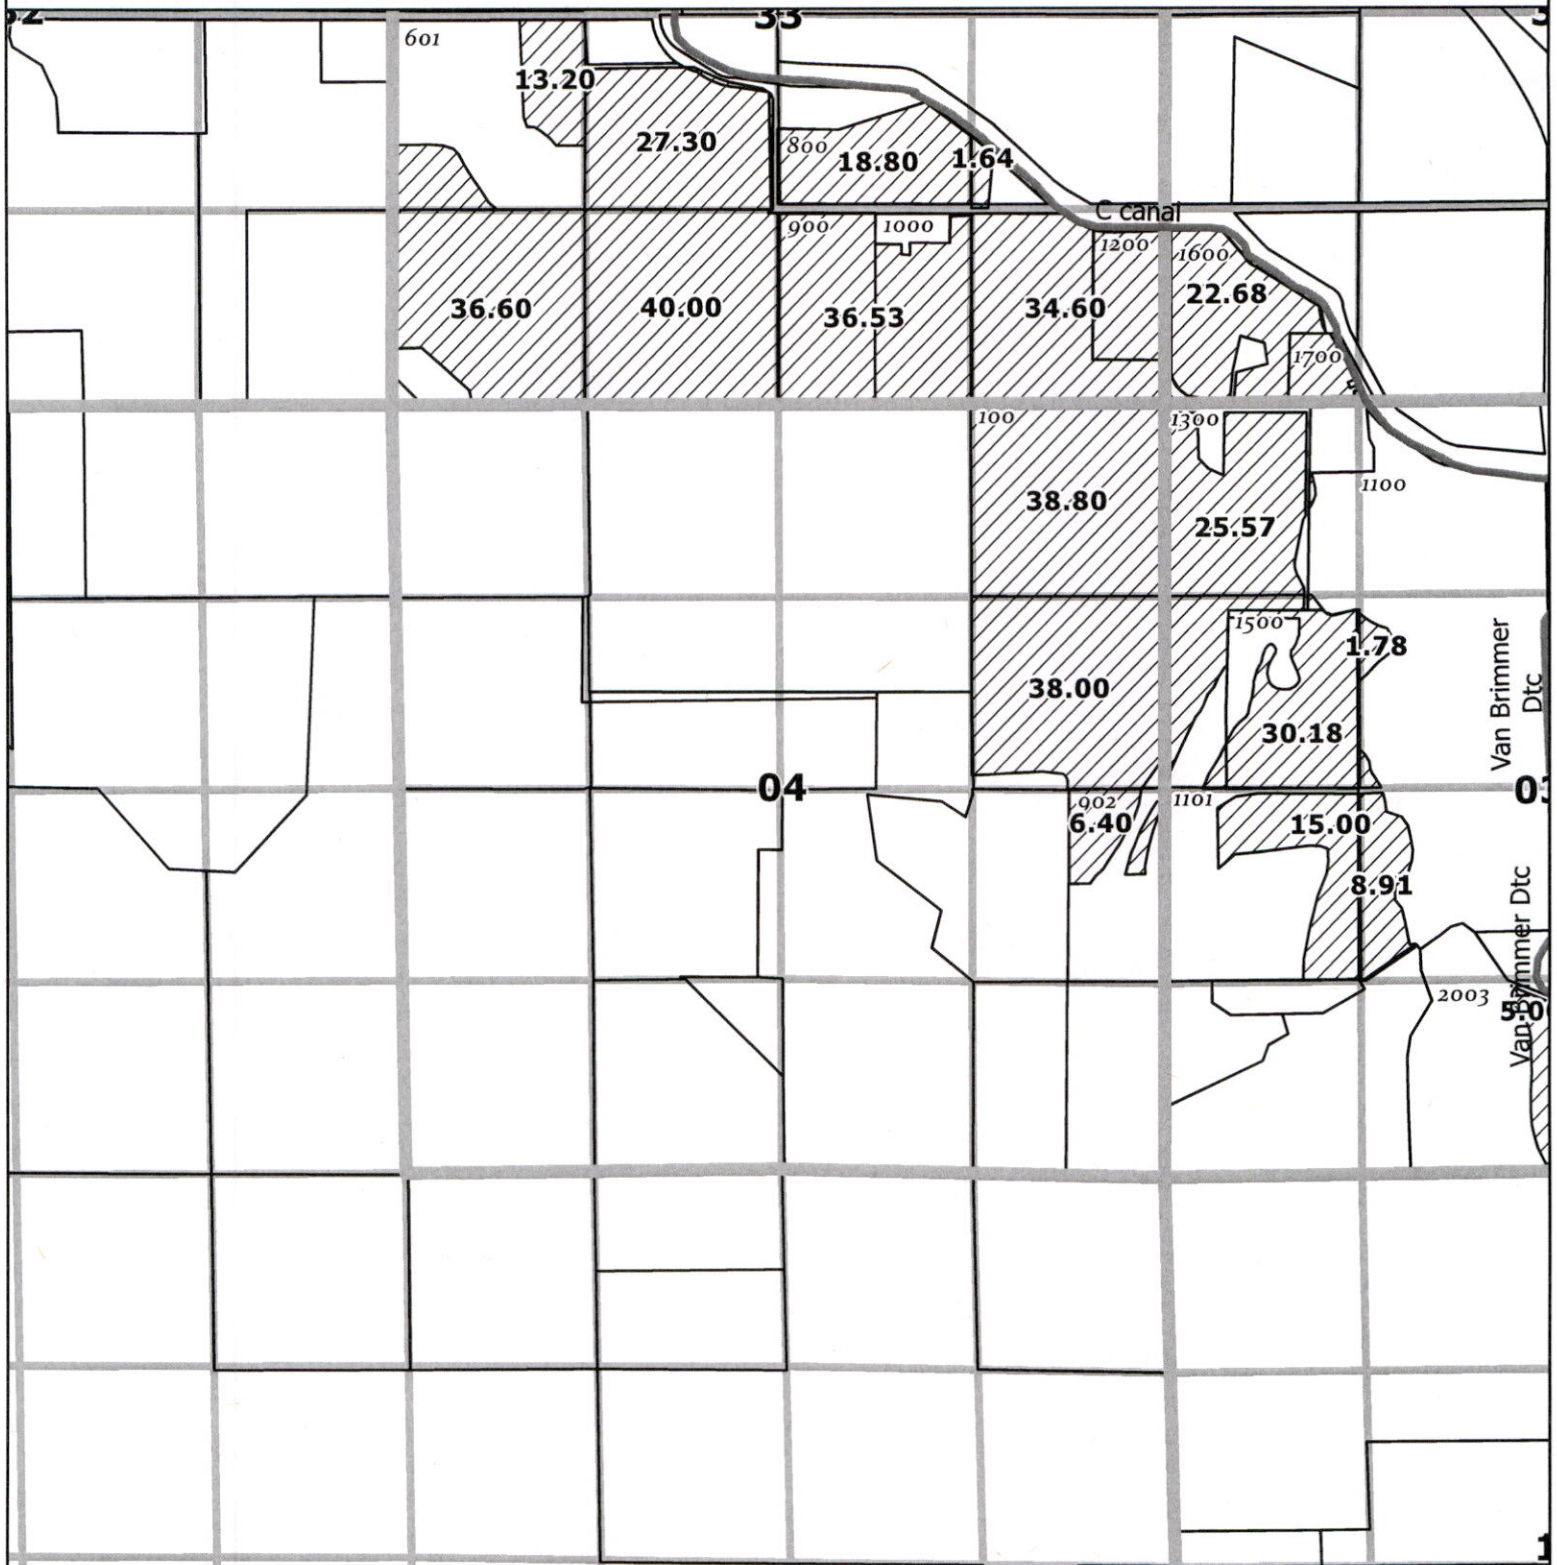


- Place of Use
- Klamath County Taxlot
- QQ Sections and Gov't Lots
- Map Series Sections
- Canal

Received
JUL 07 2025
OWRD

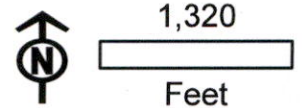

DISCLAIMER
This map is not intended to provide legal dimensions or locations of property ownership lines


WATERSOLVING
johnw@watersolving.com

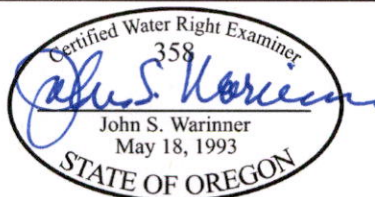

CLAIM OF BENEFICIAL USE MAP
APPLICATION G-16030
PERMIT G-18797
06/23/2025

Map No. 104

T 41 S 10 R 10 E S 10

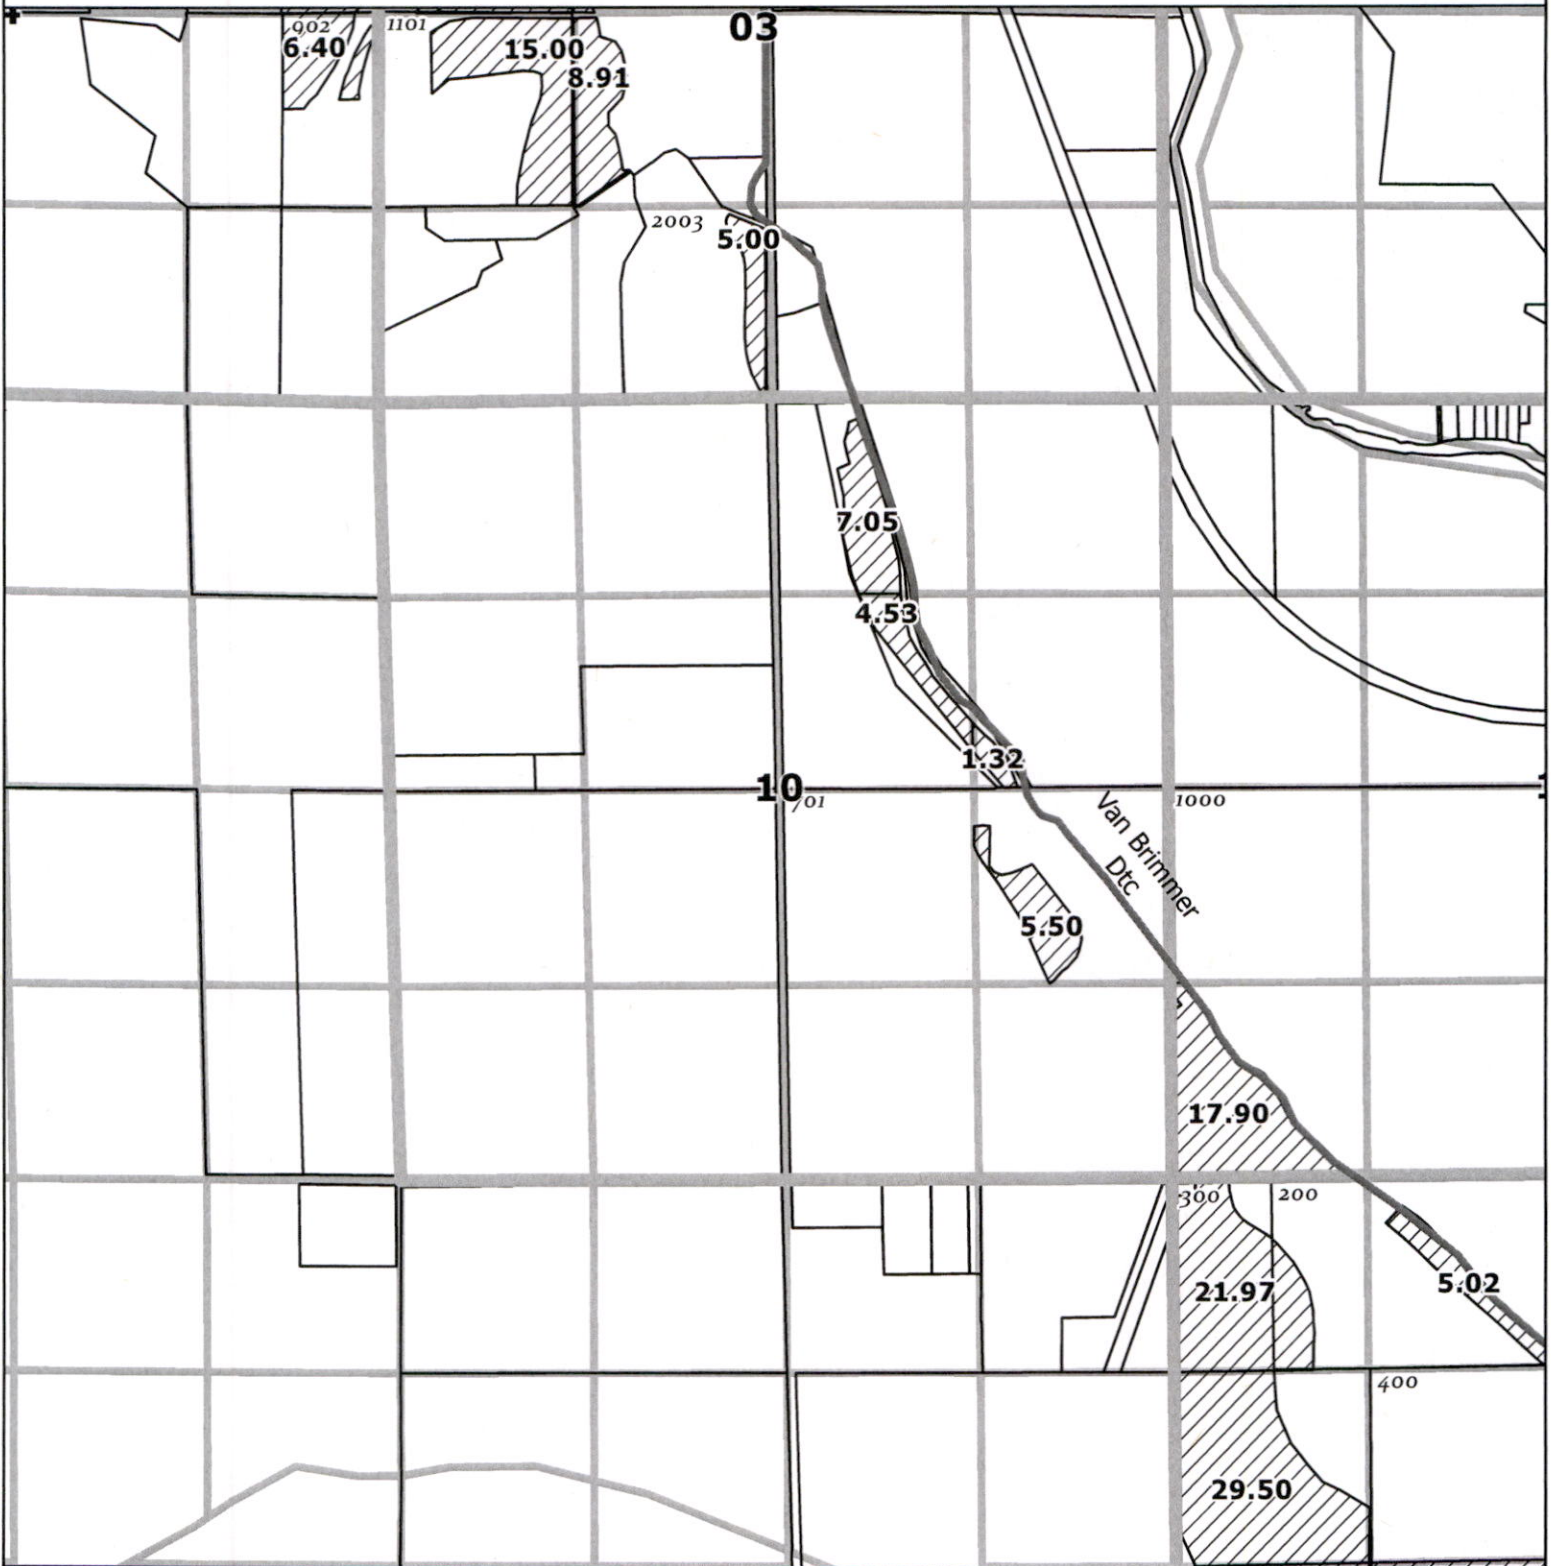

- Place of Use
- Klamath County Taxlot
- QQ Sections and Gov't Lots
- Map Series Sections
- Canal


Received
JUL 07 2025
OWBD



1,320
Feet

DISCLAIMER
This map is not intended to
provide legal dimensions or
locations of property
ownership lines


WATERSOLVING
johnw@watersolving.com

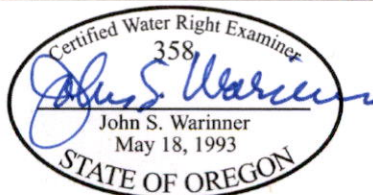

CLAIM OF BENEFICIAL USE MAP
APPLICATION G-16030
PERMIT G-18797
06/23/2025


Map No. 105

T 41 S 10 E S 11

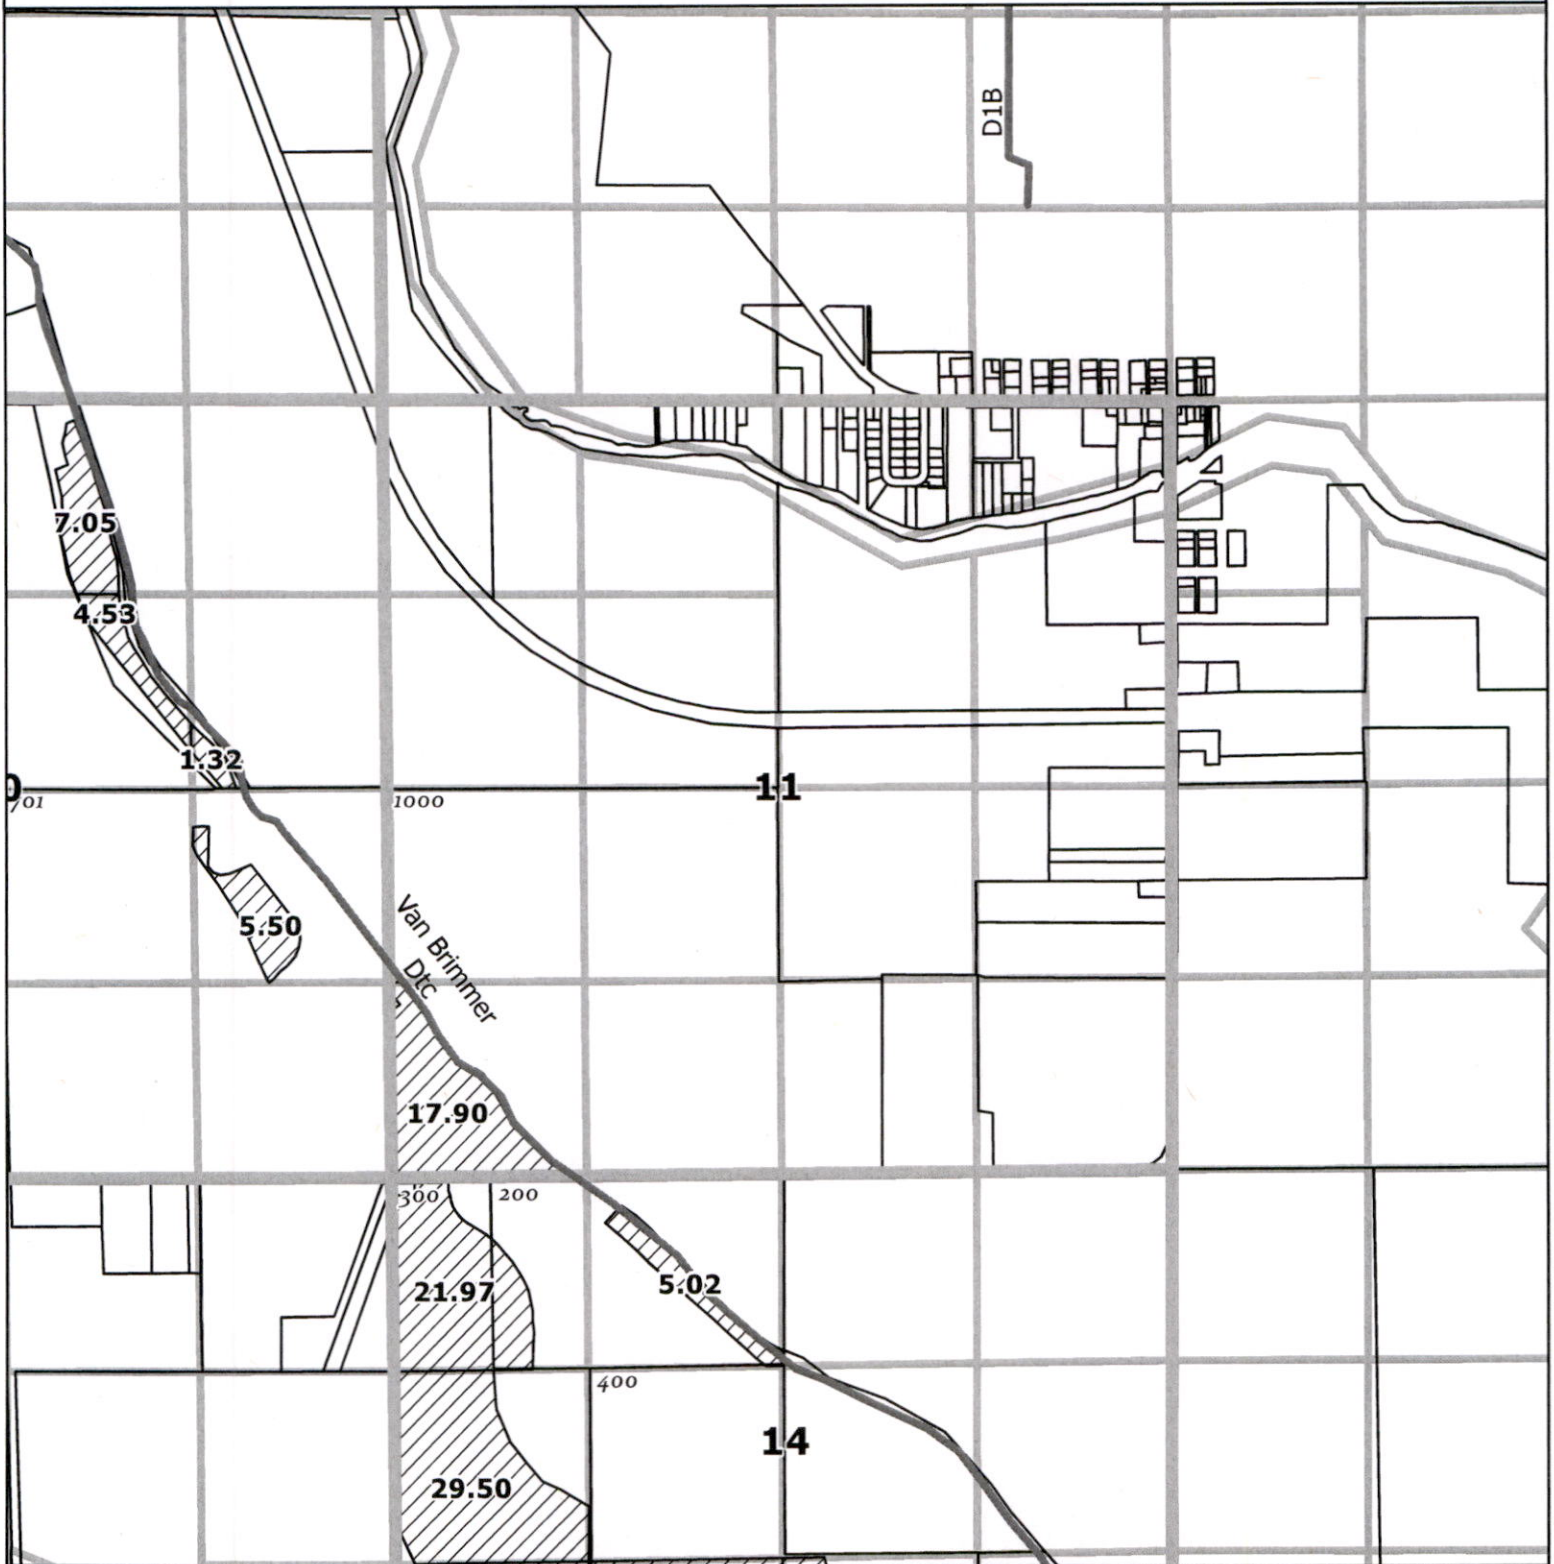


- Place of Use
- Klamath County Taxlot
- QQ Sections and Gov't Lots
- Map Series Sections
- Canal

Received
JUL 07 2025
OWRD

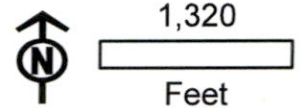

DISCLAIMER
This map is not intended to
provide legal dimensions or
locations of property
ownership lines

WATERSOLVING
johnw@watersolving.com

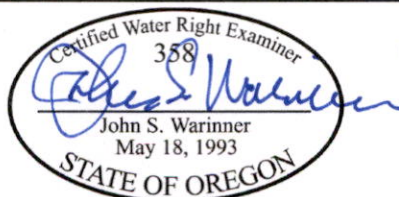

CLAIM OF BENEFICIAL USE MAP
APPLICATION G-16030
PERMIT G-18797
06/23/2025


Map No. 106

T 41 S 10 E S 14




- Place of Use
- Klamath County Taxlot
- QQ Sections and Gov't Lots
- Map Series Sections
- Canal

Received
JUL 07 2025
OWRD

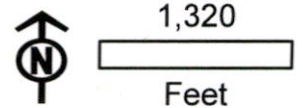

DISCLAIMER
This map is not intended to
provide legal dimensions or
locations of property
ownership lines


WATERSOLVING
johnnw@watersolving.com

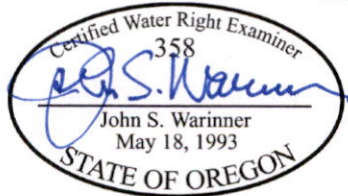

CLAIM OF BENEFICIAL USE MAP
APPLICATION G-16030
PERMIT G-18797
06/23/2025

Map No. 107

T 41 S 11 E S 01

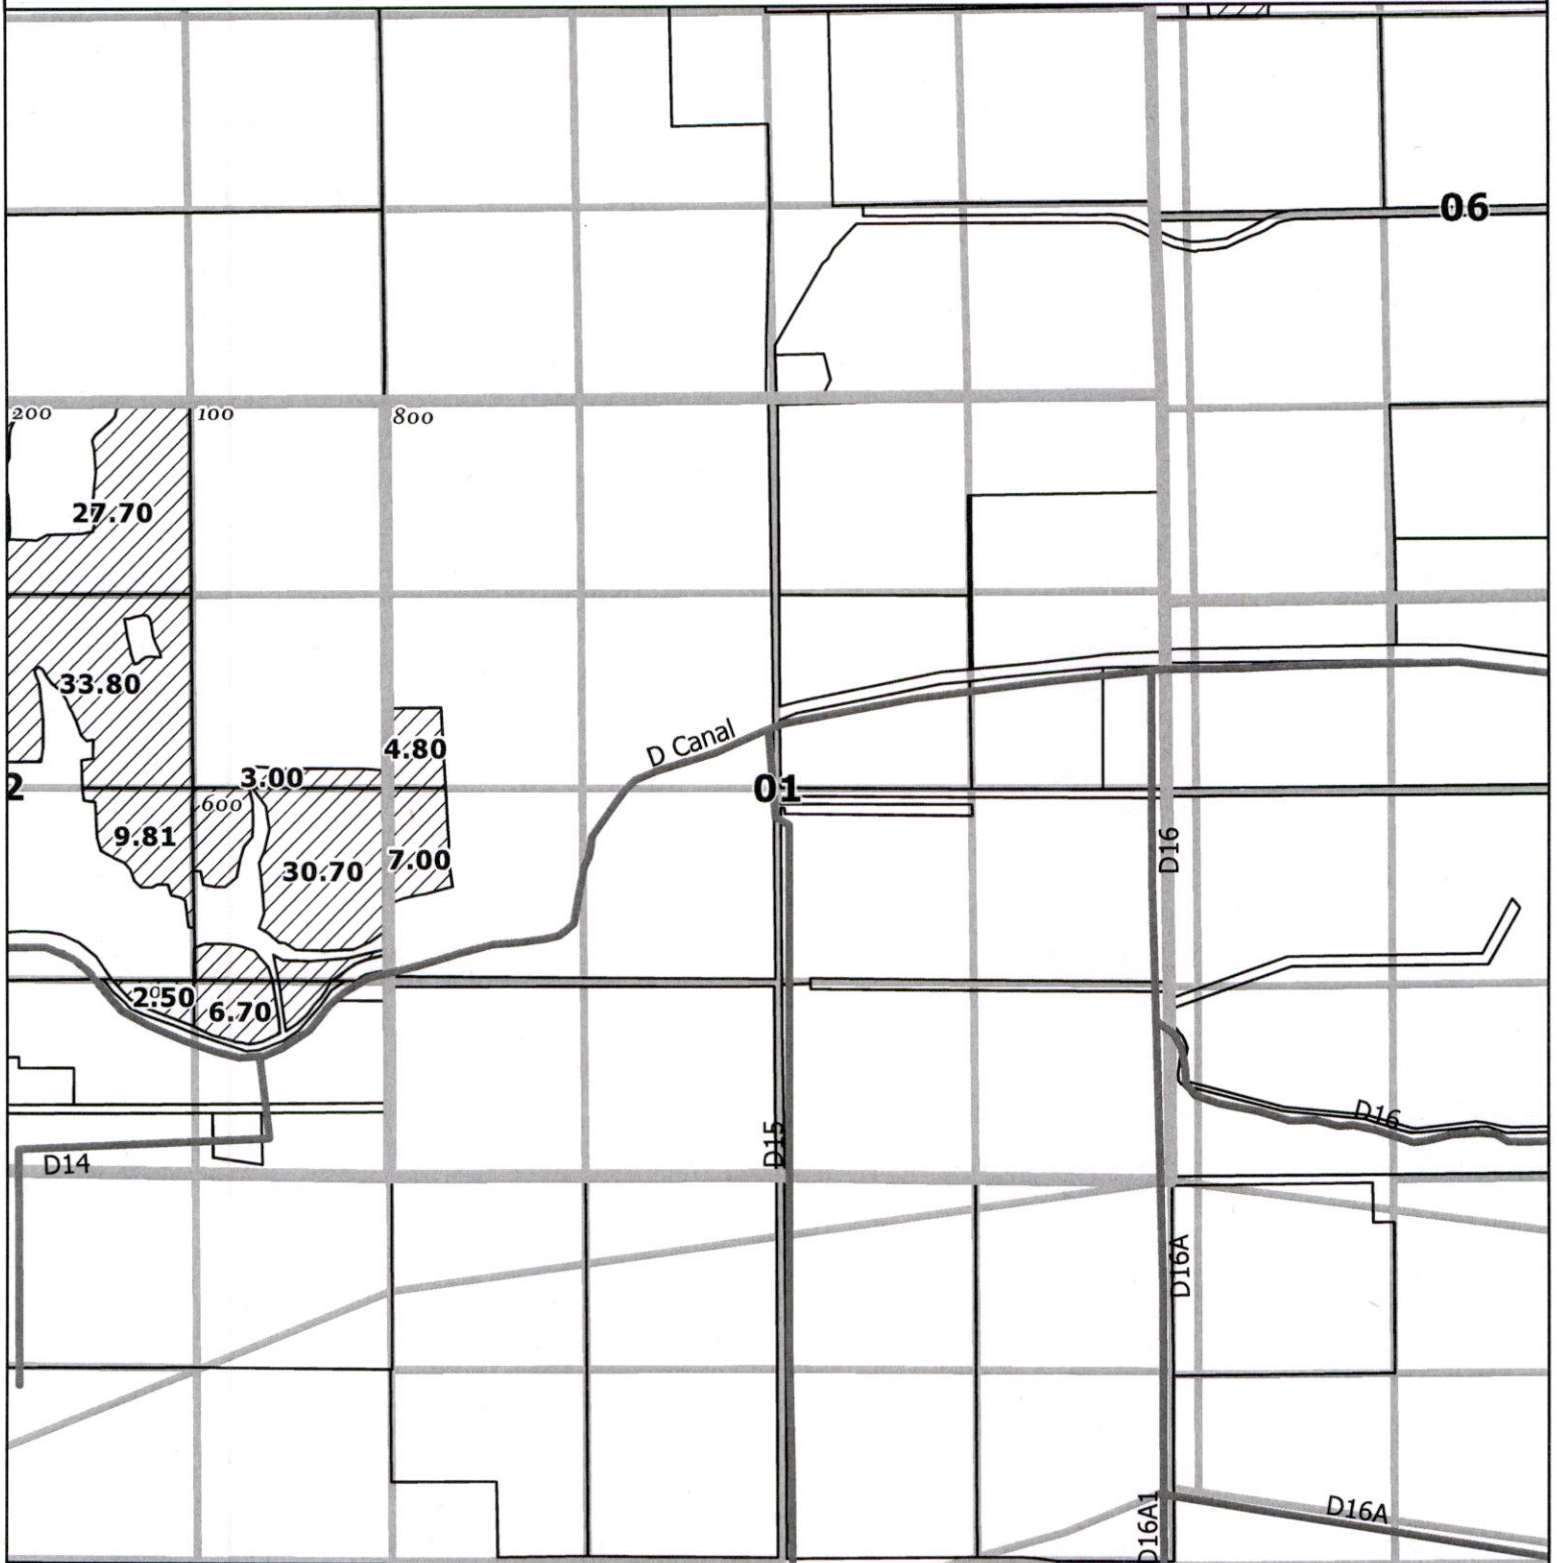


- Place of Use
- Klamath County Taxlot
- QQ Sections and Gov't Lots
- Map Series Sections
- Canal

Received
JUL 07 2025
OWRD

1,320
Feet

DISCLAIMER
This map is not intended to
provide legal dimensions or
locations of property
ownership lines


WATERSOLVING
johnw@watersolving.com

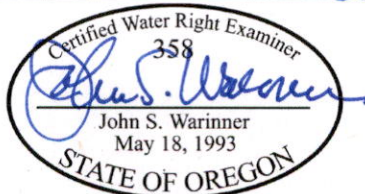

CLAIM OF BENEFICIAL USE MAP
APPLICATION G-16030
PERMIT G-18797
06/23/2025

Map No. 108

T 41 S 11 E S 02

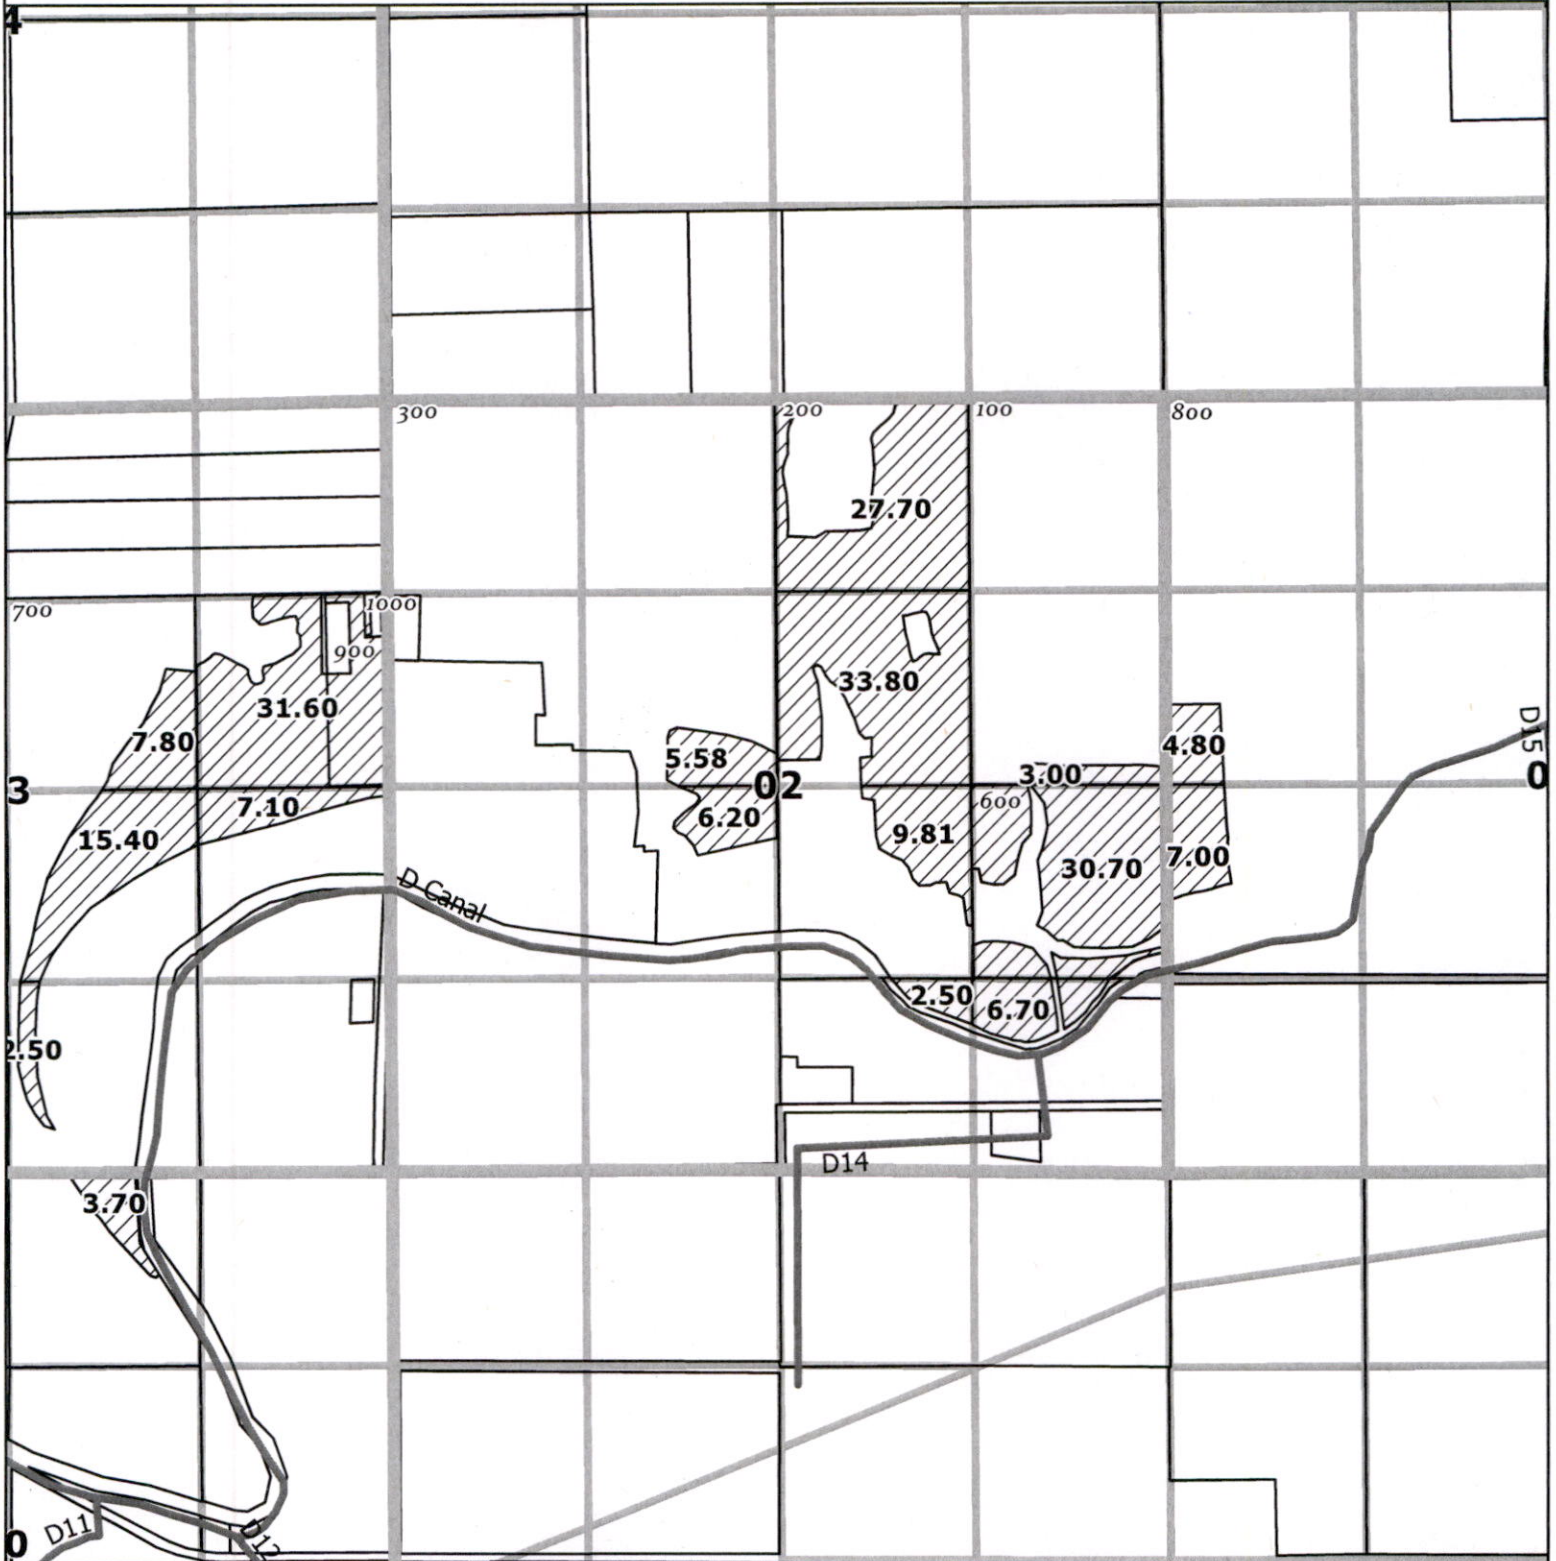

- Place of Use
- Klamath County Taxlot
- QQ Sections and Gov't Lots
- Map Series Sections
- Canal

Received
JUL 07 2025




1,320

Feet

OWRD

DISCLAIMER
This map is not intended to
provide legal dimensions or
locations of property
ownership lines


WATERSOLVING
johnw@watersolving.com

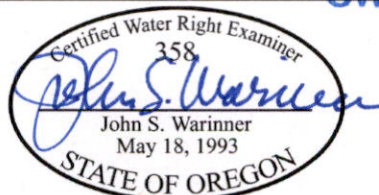

CLAIM OF BENEFICIAL USE MAP
APPLICATION G-16030
PERMIT G-18797
06/23/2025


Map No. 109

T 41 S R 11 E S 03

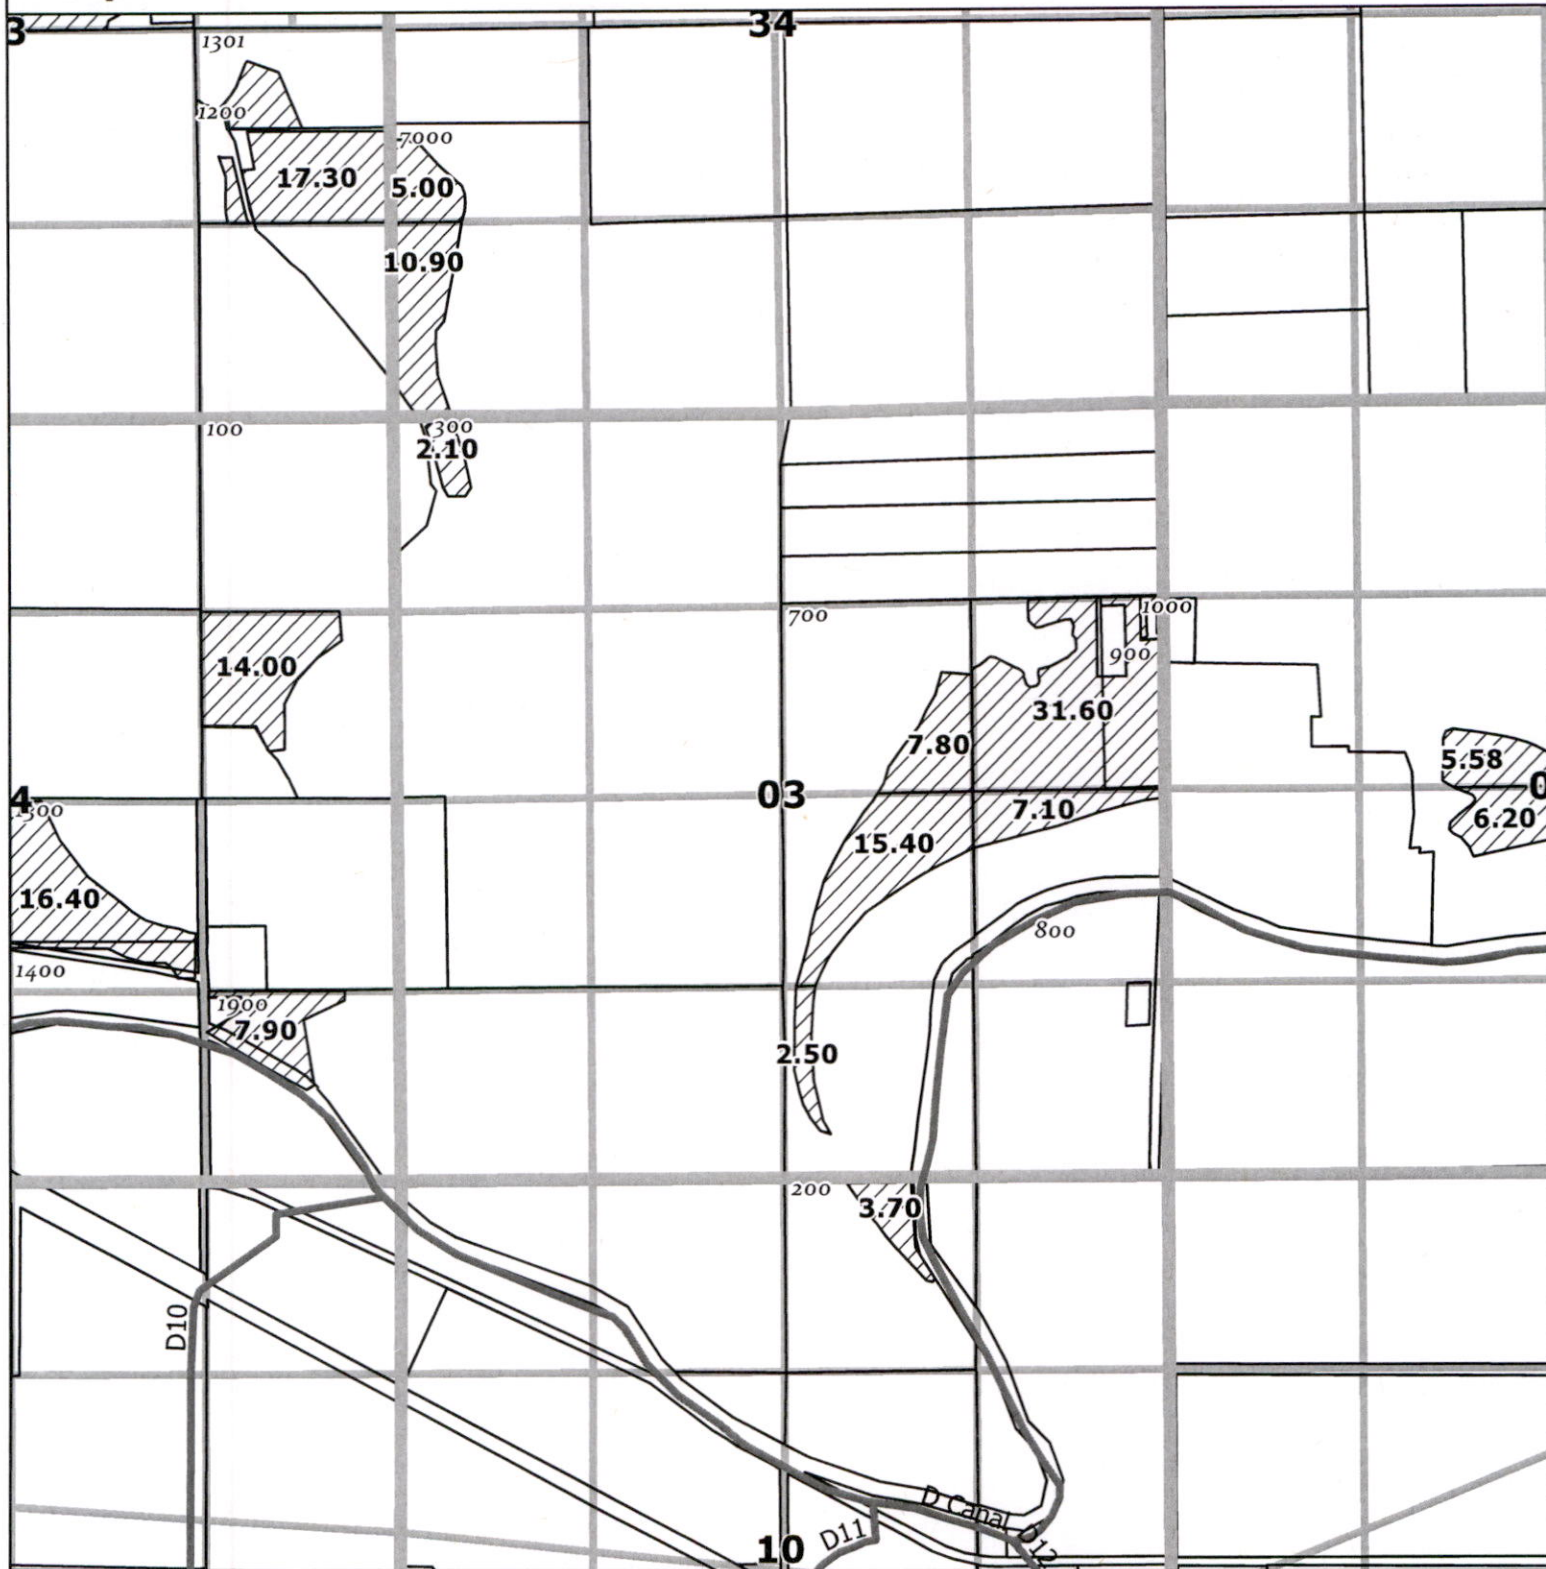


- Place of Use
- Map Series Sections
- Klamath County Taxlot
- Canal
- QQ Sections and Gov't Lots

Received
JUL 07 2025
OWRD

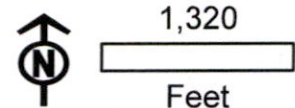


DISCLAIMER
This map is not intended to provide legal dimensions or locations of property ownership lines

WATERSOLVING
johnw@watersolving.com

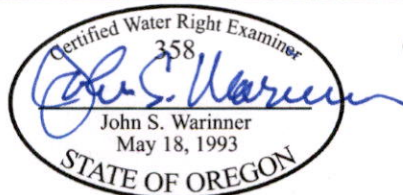

CLAIM OF BENEFICIAL USE MAP
APPLICATION G-16030
PERMIT G-18797
06/23/2025

T		R		S
41	S	11	E	04

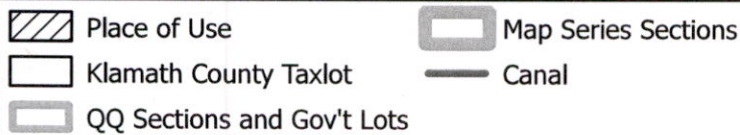


JUL 07 2025



Feet

OWRD


WATERSOLVING
johnw@watersolving.com

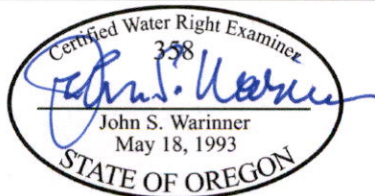

**CLAIM OF BENEFICIAL USE MAP
APPLICATION G-16030
PERMIT G-18797
06/23/2025**


Map No. 111

T 41 S R 11 E S 05

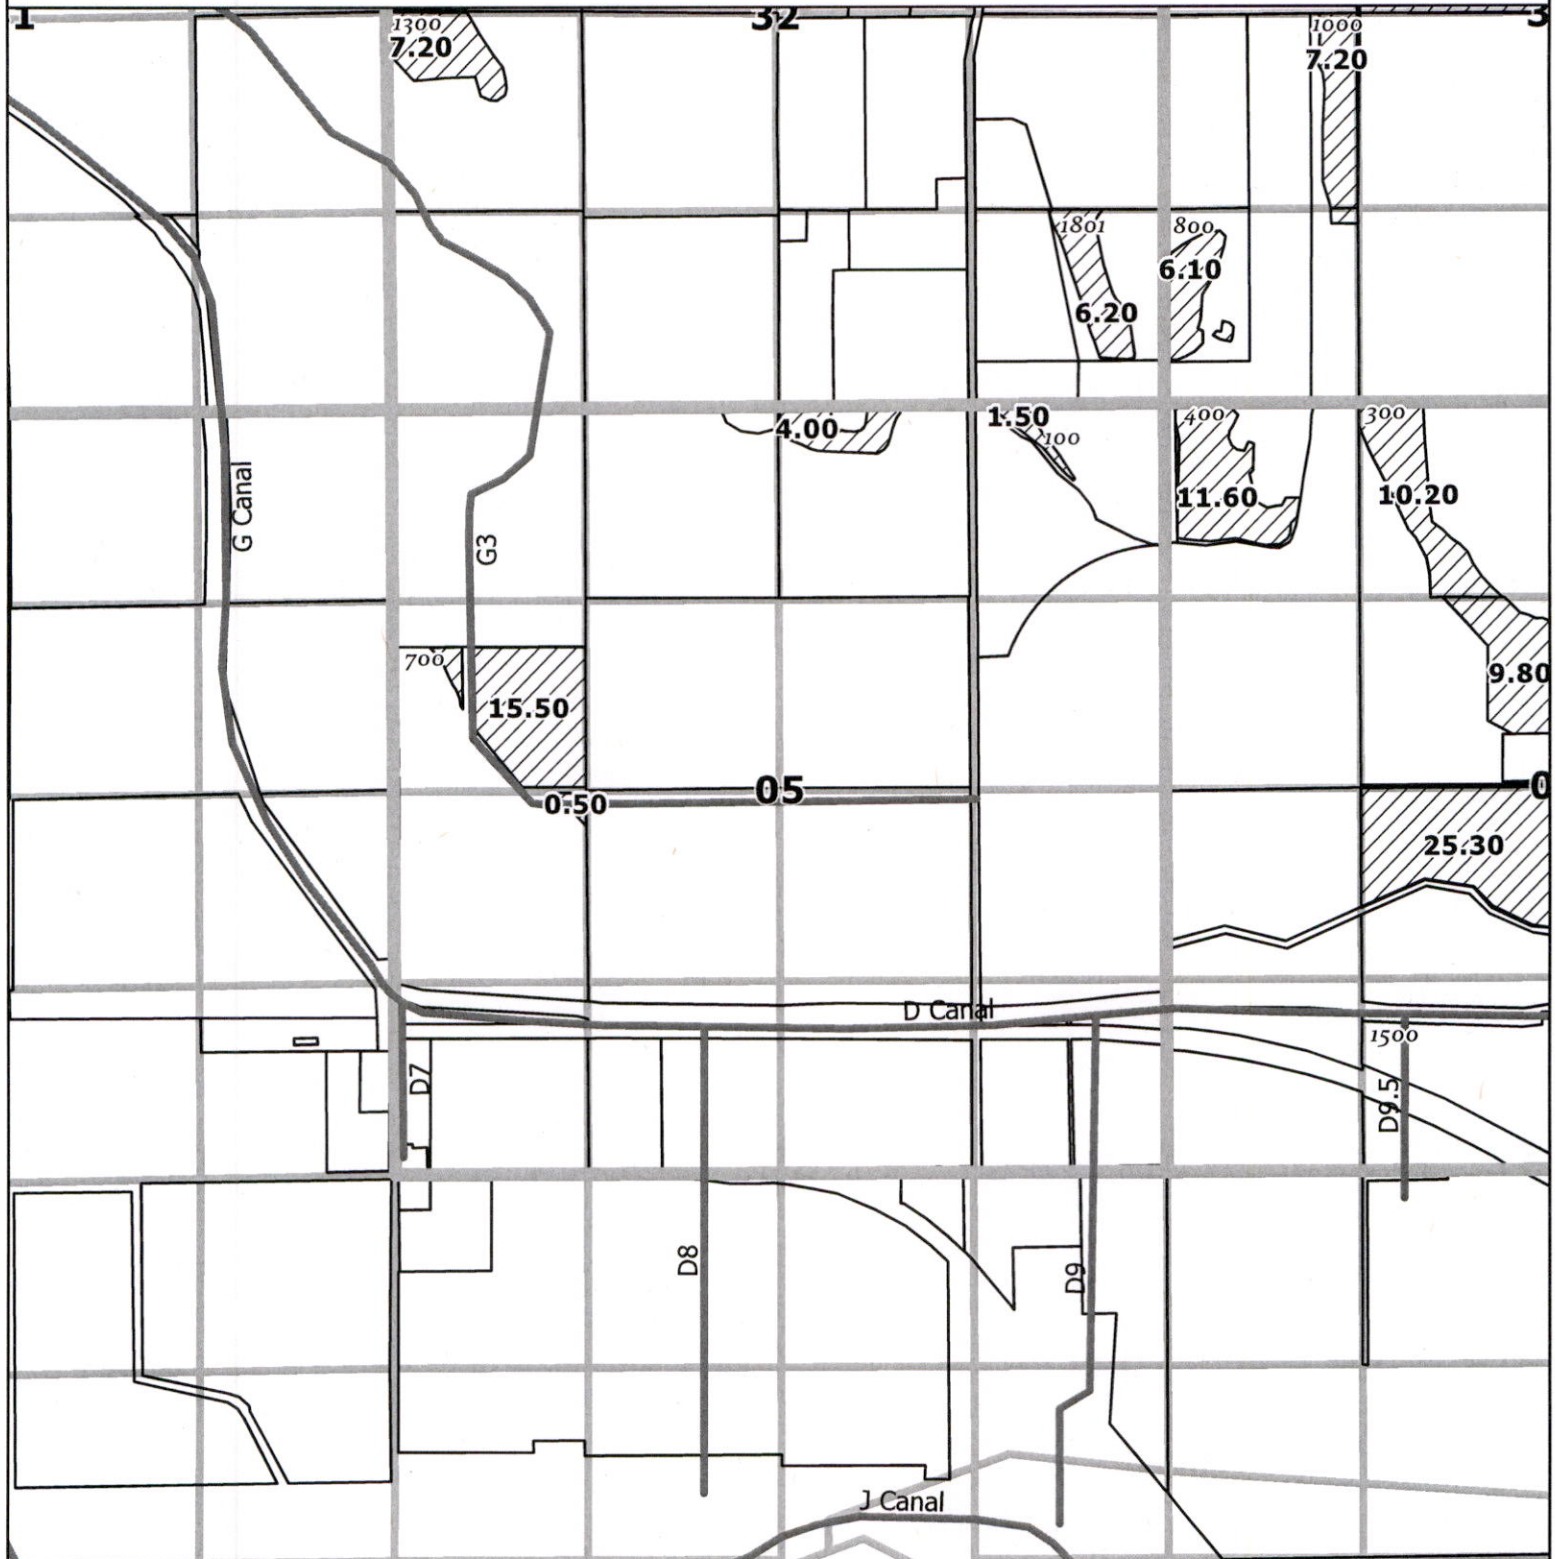


- Place of Use
- Klamath County Taxlot
- QQ Sections and Gov't Lots
- Map Series Sections
- Canal

Received
JUL 07 2025
OWRD

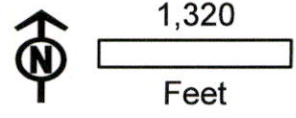

DISCLAIMER
This map is not intended to provide legal dimensions or locations of property ownership lines

WATERSOLVING
johnw@watersolving.com

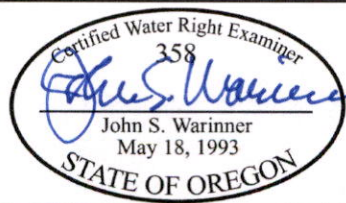

CLAIM OF BENEFICIAL USE MAP
APPLICATION G-16030
PERMIT G-18797
06/23/2025

Map No. 112

T S 41 R 11 S 10 E 10



- Place of Use
- Klamath County Taxlot
- QQ Sections and Gov't Lots
- Map Series Sections
- Canal

Received

JUL 07 2025

OWRD




1,320

Feet

DISCLAIMER

This map is not intended to provide legal dimensions or locations of property ownership lines


WATERSOLVING
johnw@watersolving.com

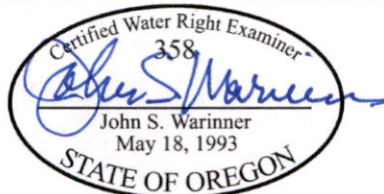

CLAIM OF BENEFICIAL USE MAP
APPLICATION G-16030
PERMIT G-18797
06/23/2025

Map No. 113

T 41 S 12 E S 03

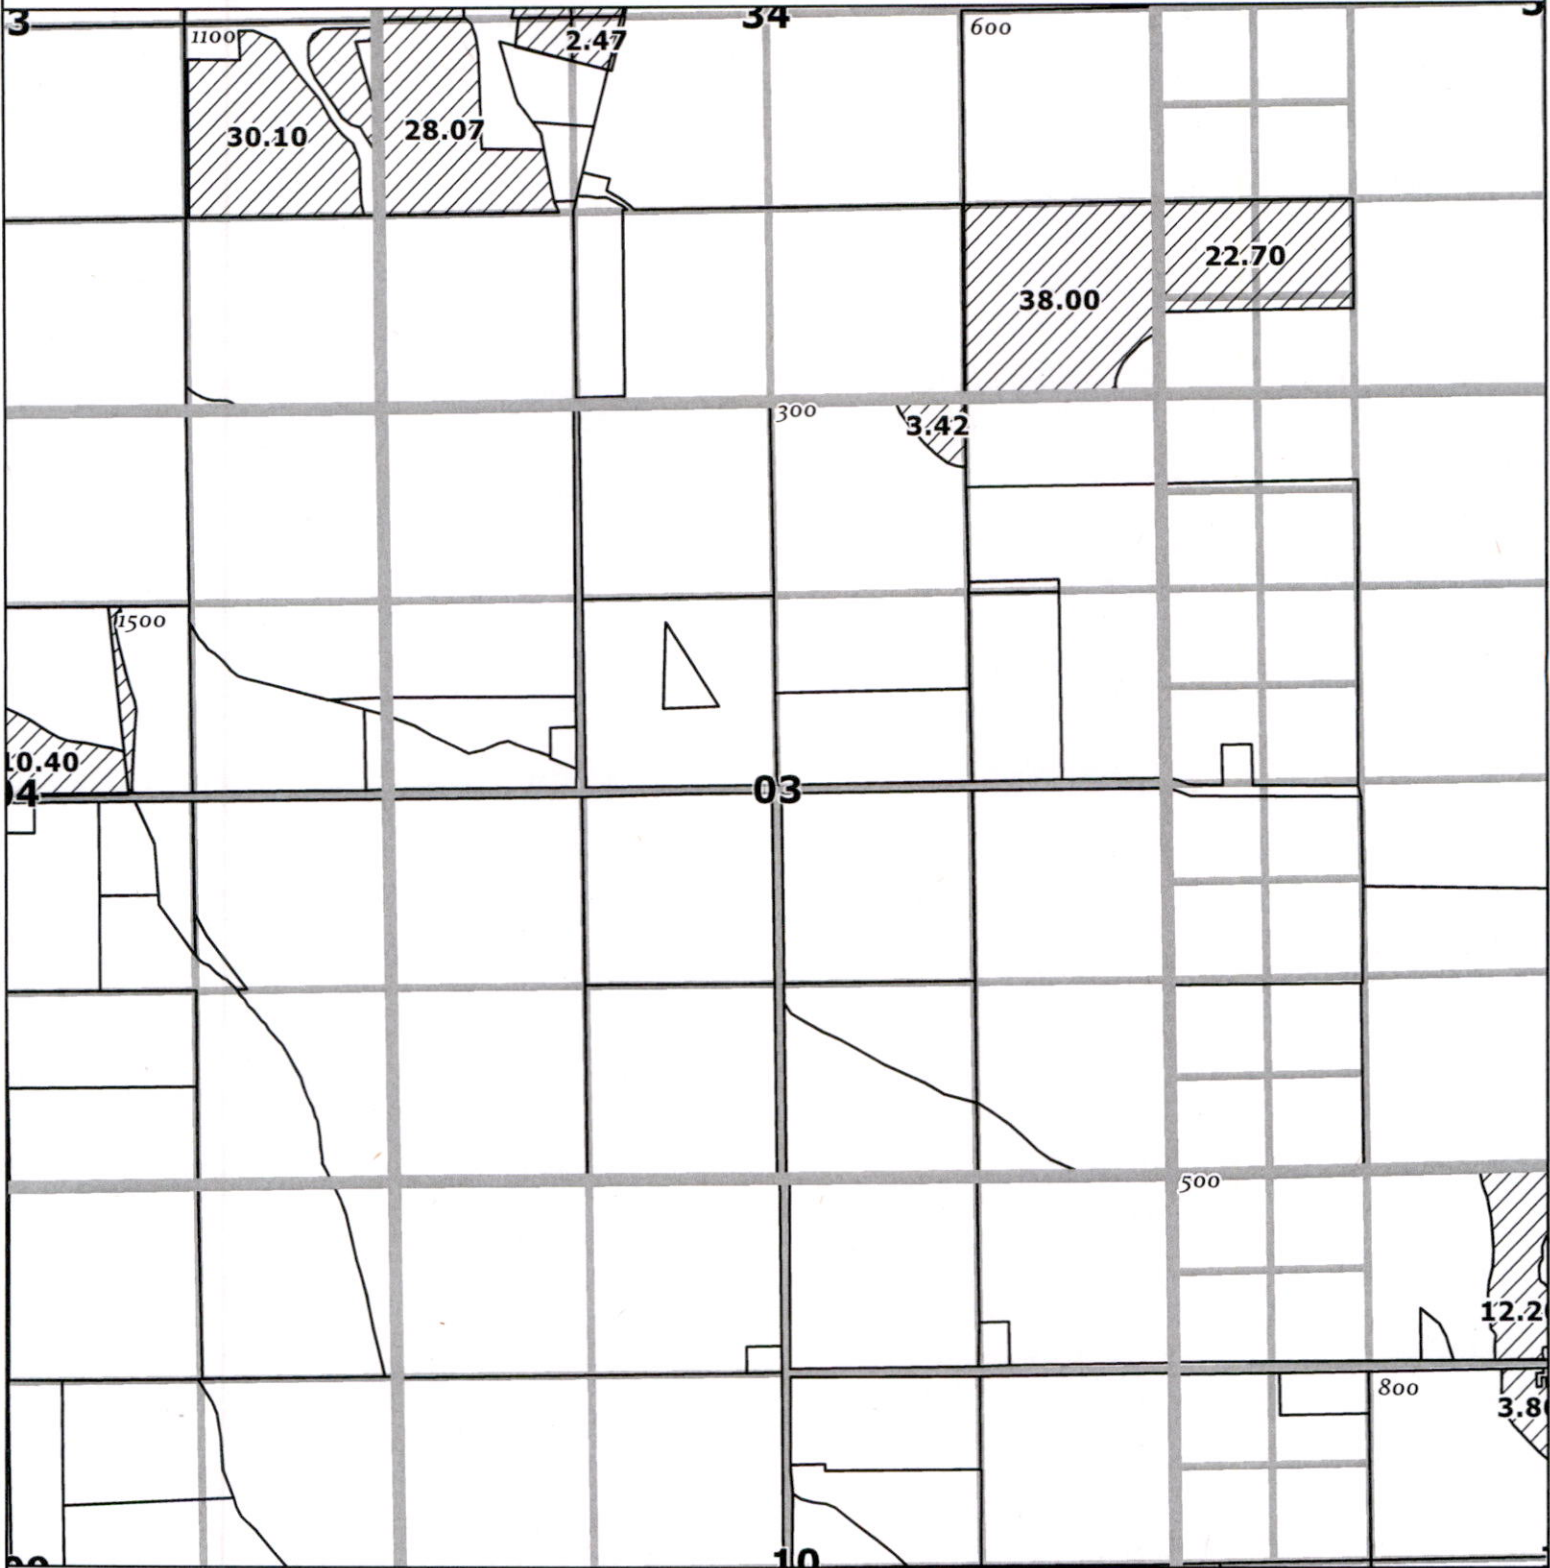

- Place of Use
- Klamath County Taxlot
- QQ Sections and Gov't Lots
- Map Series Sections
- Canal

Received

JUL 07 2025


OWRD



1,320
Feet

DISCLAIMER
This map is not intended to
provide legal dimensions or
locations of property
ownership lines


WATERSOLVING
johnw@watersolving.com

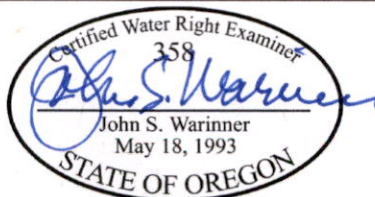

CLAIM OF BENEFICIAL USE MAP
APPLICATION G-16030
PERMIT G-18797
06/23/2025


Map No. 114

T 41 S 12 E S 04

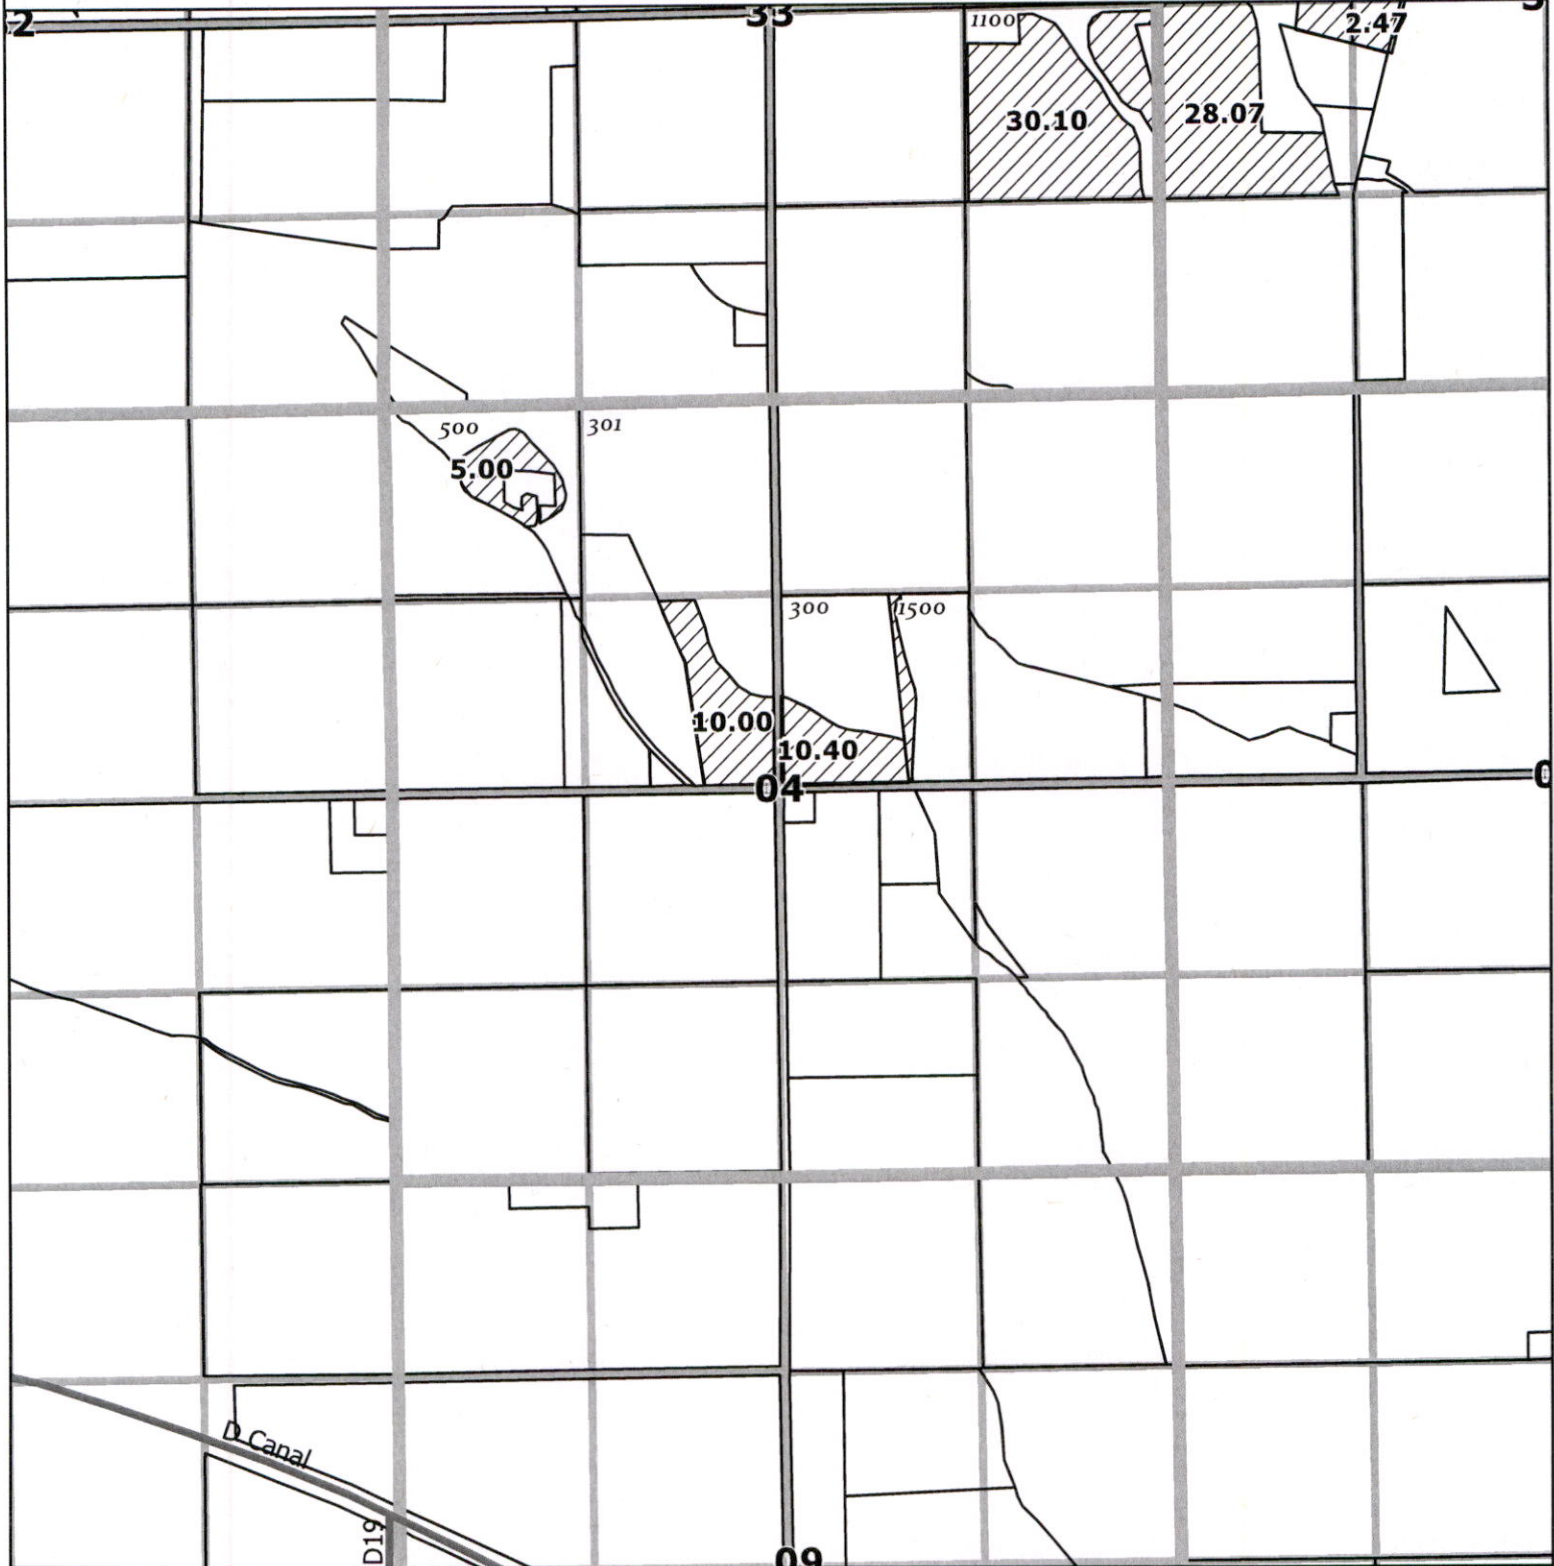


-  Place of Use
-  Klamath County Taxlot
-  QQ Sections and Gov't Lots
-  Map Series Sections
-  Canal

Received
JUL 07 2025
OWRD

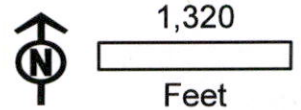

DISCLAIMER
This map is not intended to
provide legal dimensions or
locations of property
ownership lines


WATERSOLVING
johnw@watersolving.com

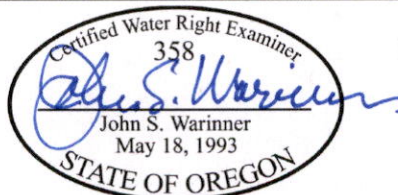

CLAIM OF BENEFICIAL USE MAP
APPLICATION G-16030
PERMIT G-18797
06/23/2025

Map No. 115

T S 41 R 12 S 06 E 06

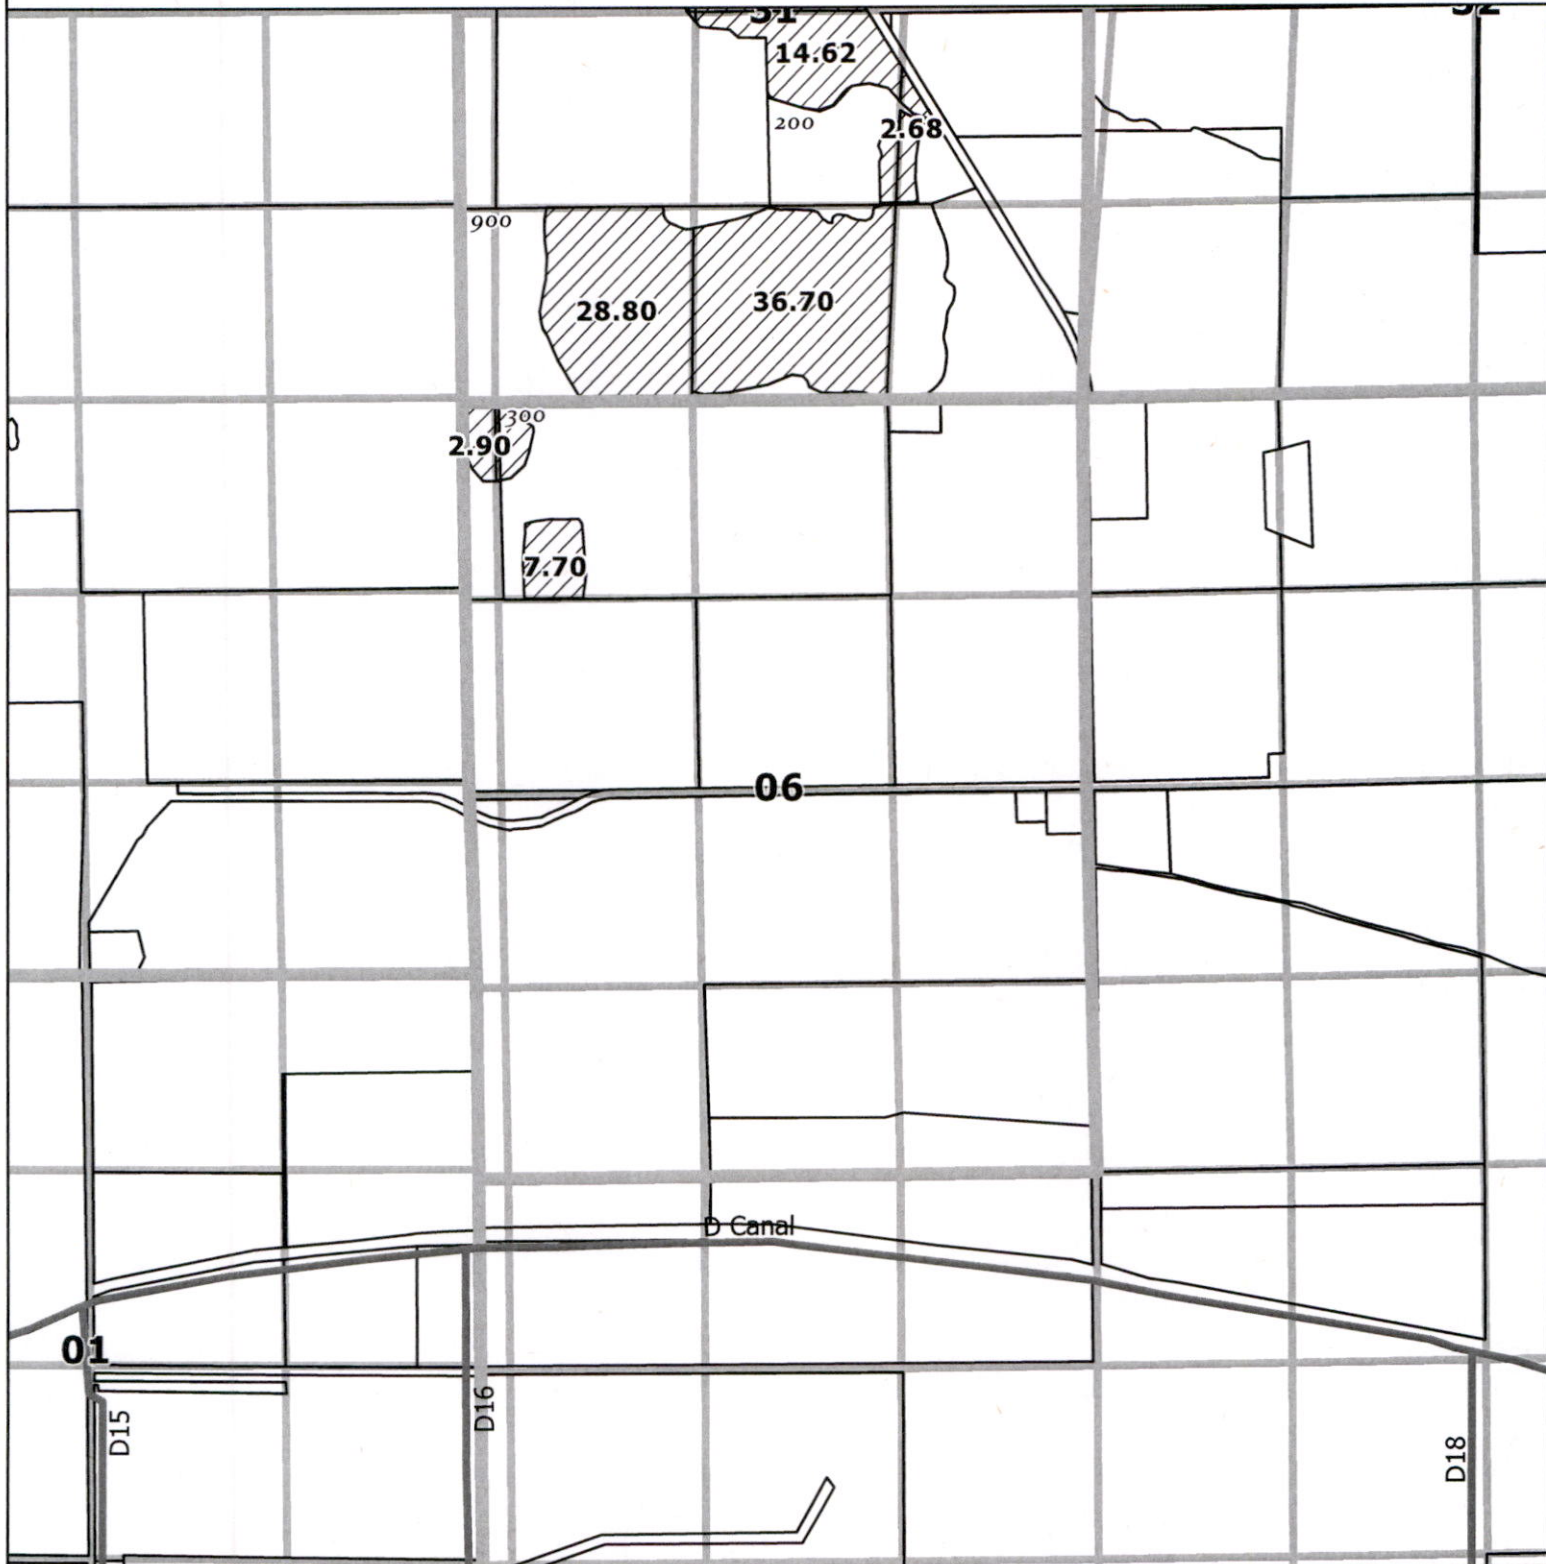

- Place of Use
- Klamath County Taxlot
- QQ Sections and Gov't Lots
- Map Series Sections
- Canal

Received
JUL 07 2025




1,320
Feet

OWRD

DISCLAIMER
This map is not intended to
provide legal dimensions or
locations of property
ownership lines


WATERSOLVING
johnw@watersolving.com

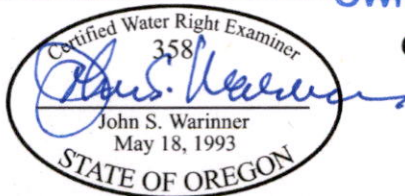

CLAIM OF BENEFICIAL USE MAP
APPLICATION G-16030
PERMIT G-18797
06/23/2025

Map No. 116

T 41 S 12 E S 09

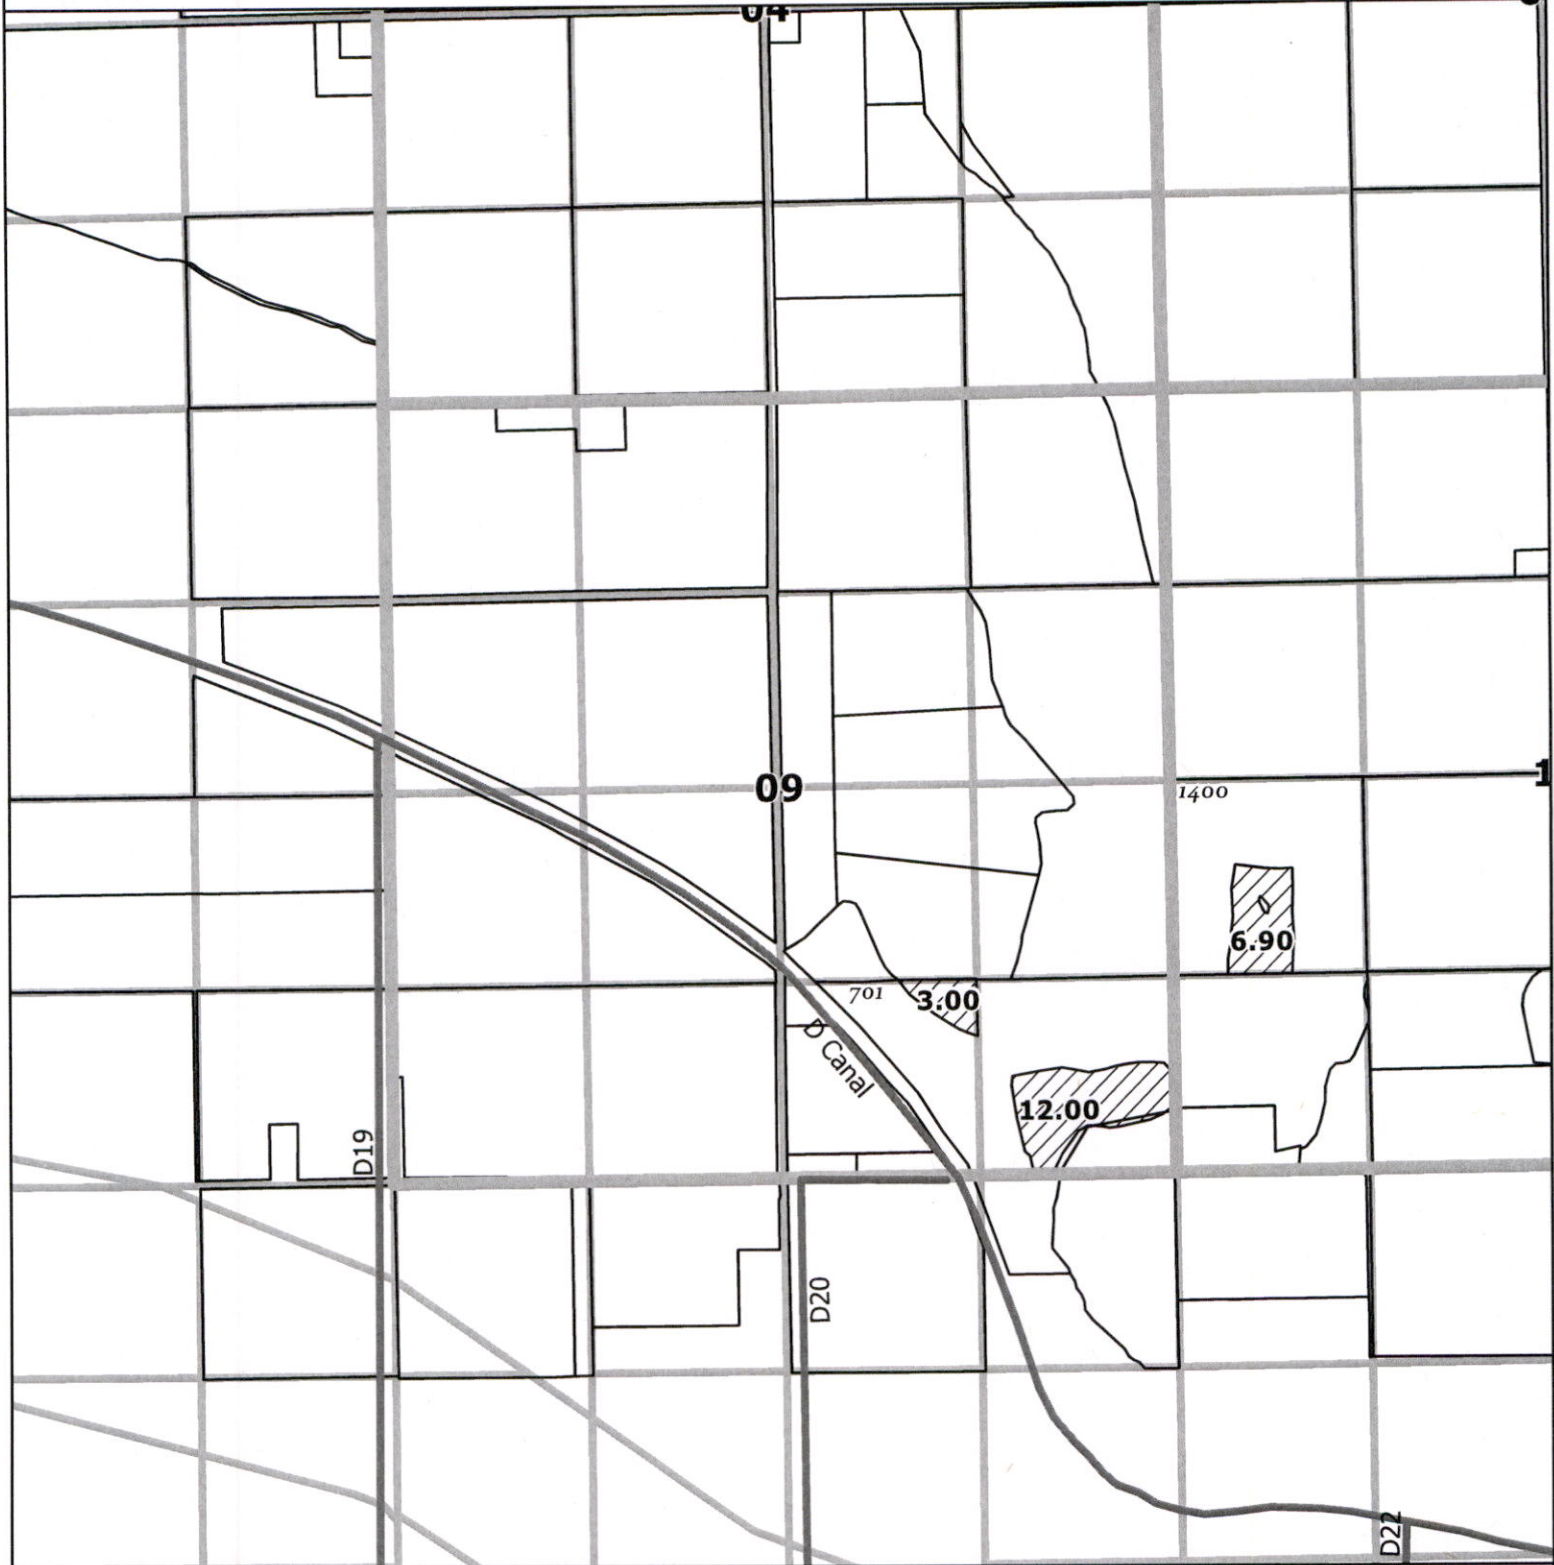

- Place of Use
- Klamath County Taxlot
- QQ Sections and Gov't Lots
- Map Series Sections
- Canal

Received

JUL 07 2025


OWRD



1,320
Feet

DISCLAIMER
This map is not intended to
provide legal dimensions or
locations of property
ownership lines


WATERSOLVING
johnw@watersolving.com

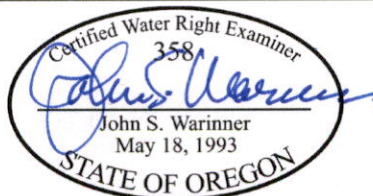

CLAIM OF BENEFICIAL USE MAP
APPLICATION G-16030
PERMIT G-18797
06/23/2025

Map No. 117

T 41 S 12 E S 10

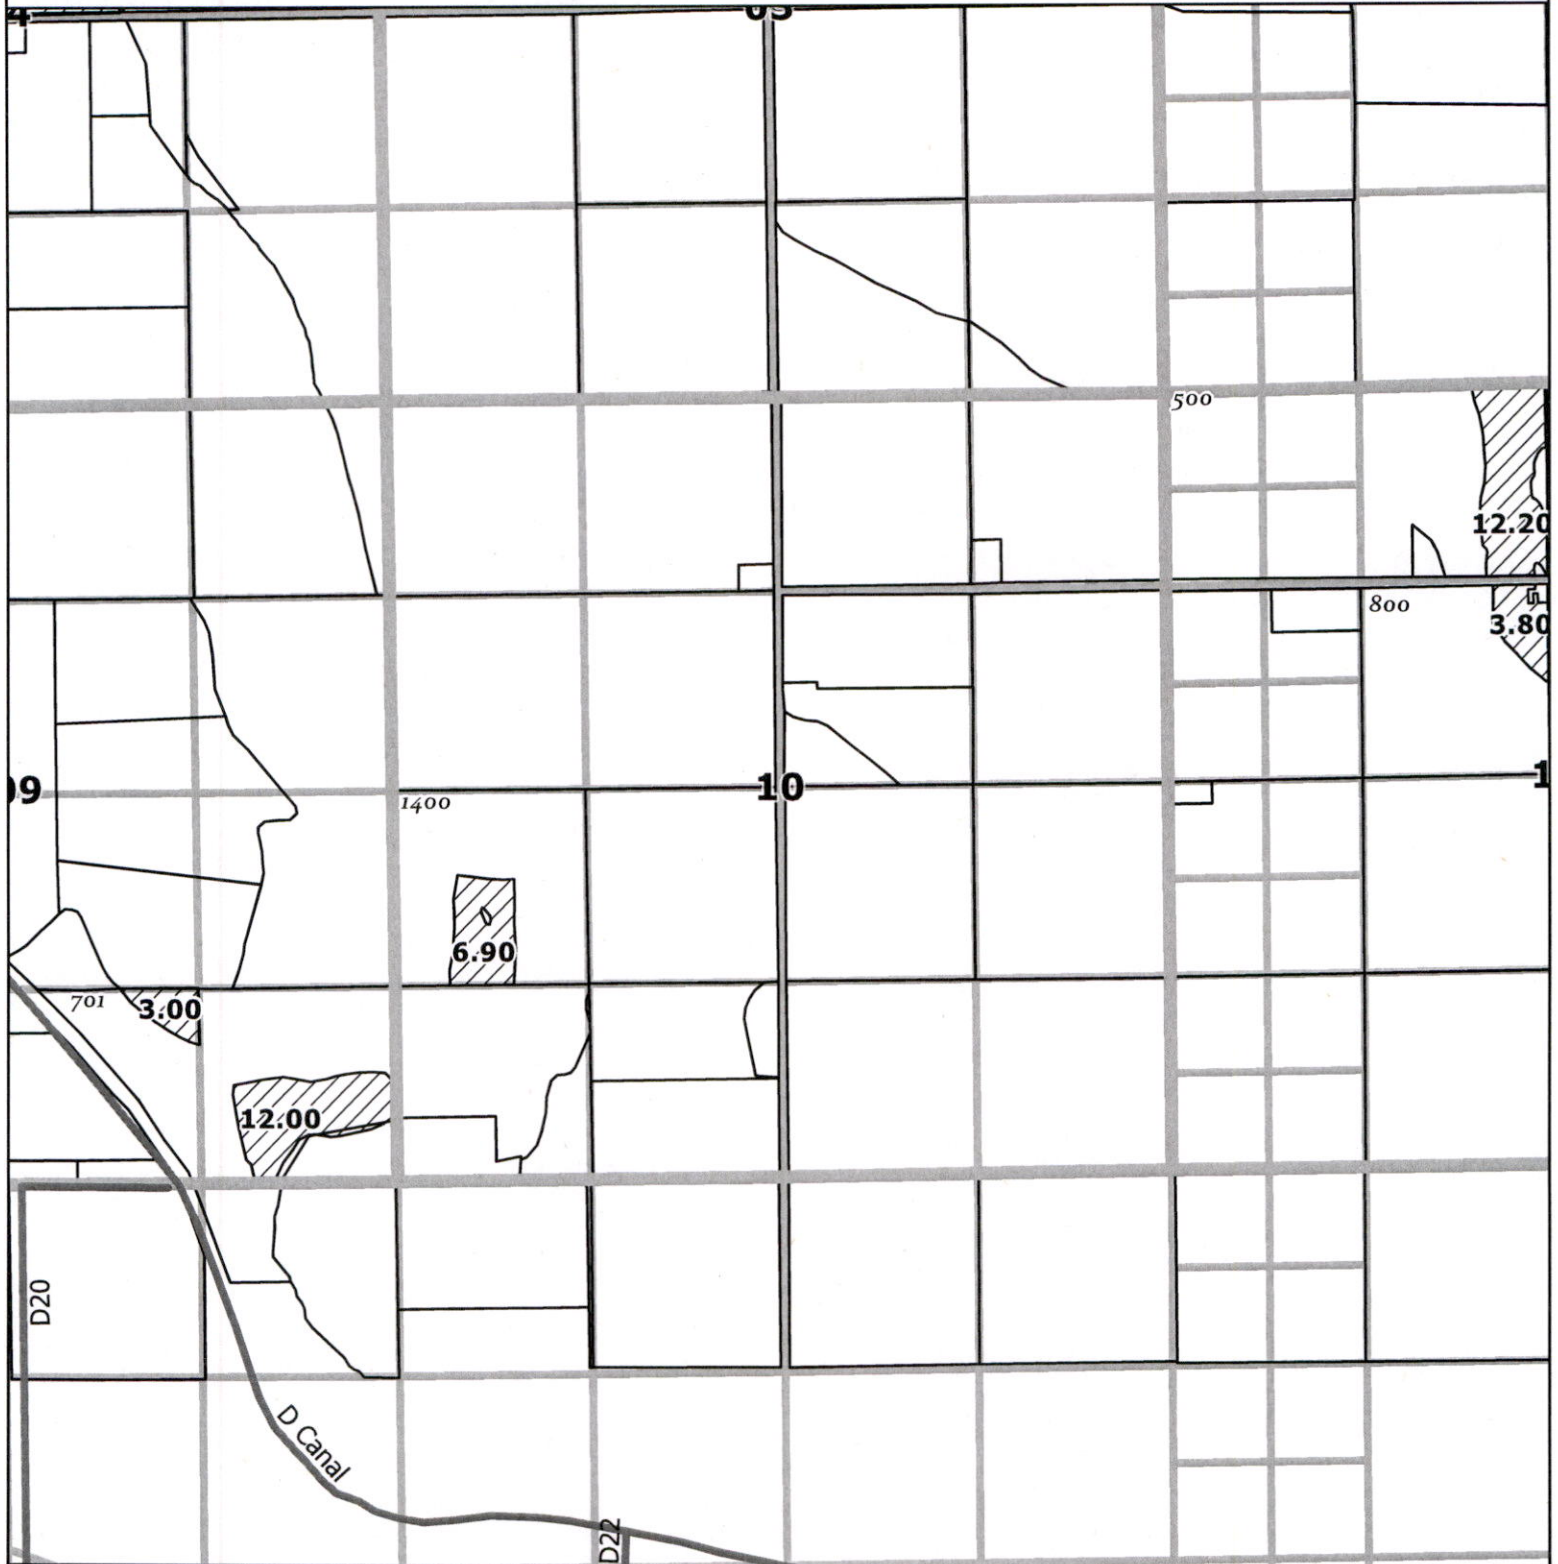

- Place of Use
- Klamath County Taxlot
- QQ Sections and Gov't Lots
- Map Series Sections
- Canal

Received
JUL 07 2025




1,320

Feet

OWRD

DISCLAIMER
This map is not intended to
provide legal dimensions or
locations of property
ownership lines


WATERSOLVING
johnw@watersolving.com

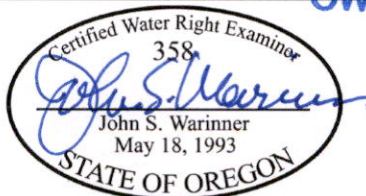

CLAIM OF BENEFICIAL USE MAP
APPLICATION G-16030
PERMIT G-18797
06/23/2025


Map No. 118

T 41 S 12 E S 11

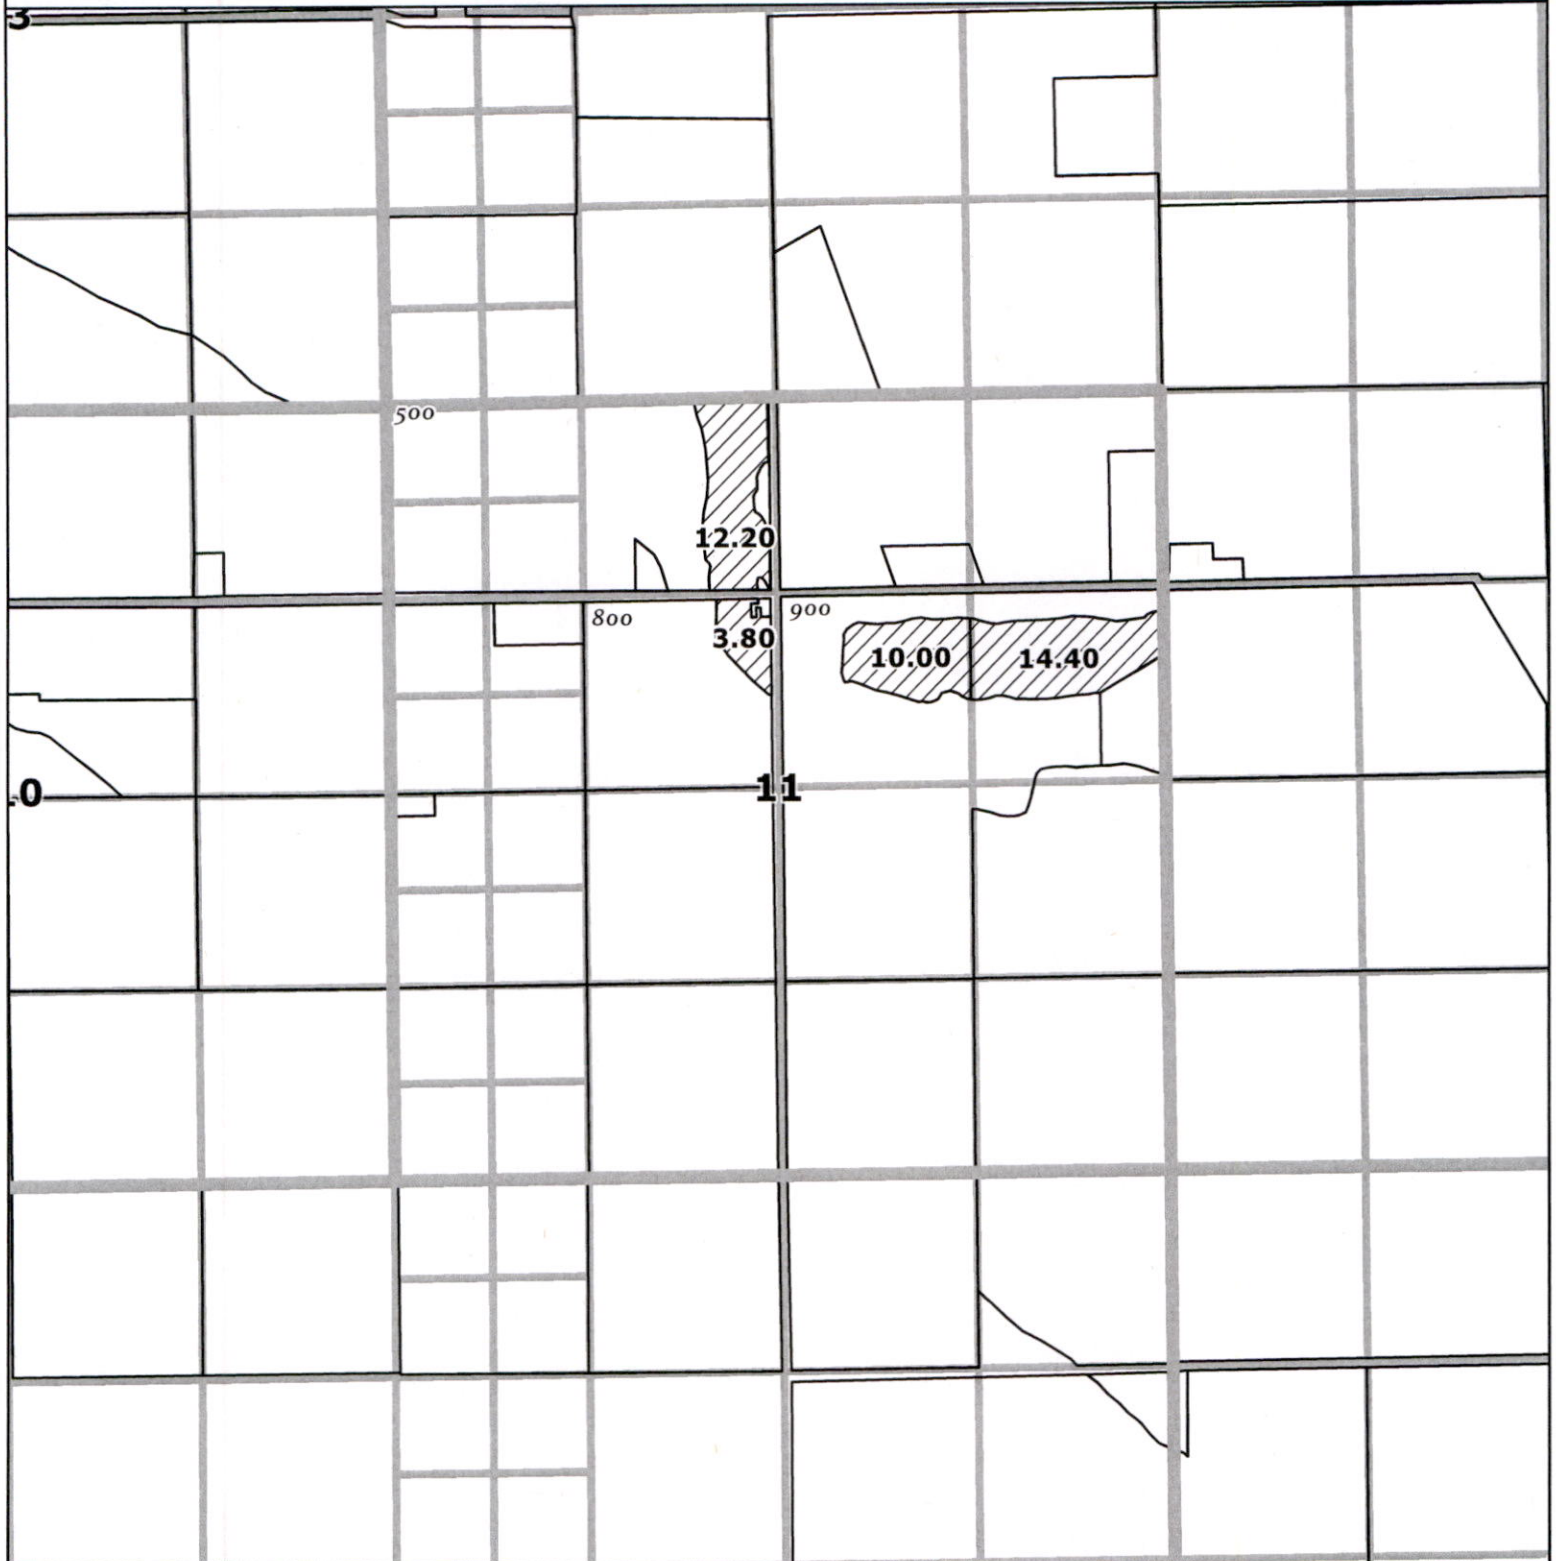


- Place of Use
- Klamath County Taxlot
- QQ Sections and Gov't Lots
- Map Series Sections
- Canal

Received
JUL 07 2025
OWRD

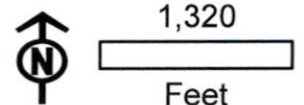

DISCLAIMER
This map is not intended to
provide legal dimensions or
locations of property
ownership lines


WATERSOLVING
johnw@watersolving.com

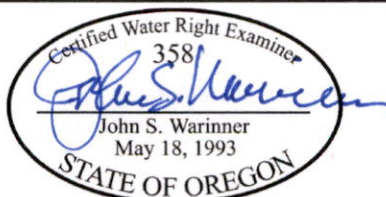

CLAIM OF BENEFICIAL USE MAP
APPLICATION G-16030
PERMIT G-18797
06/23/2025


Map No. 119

T 41 S 12 E S 13

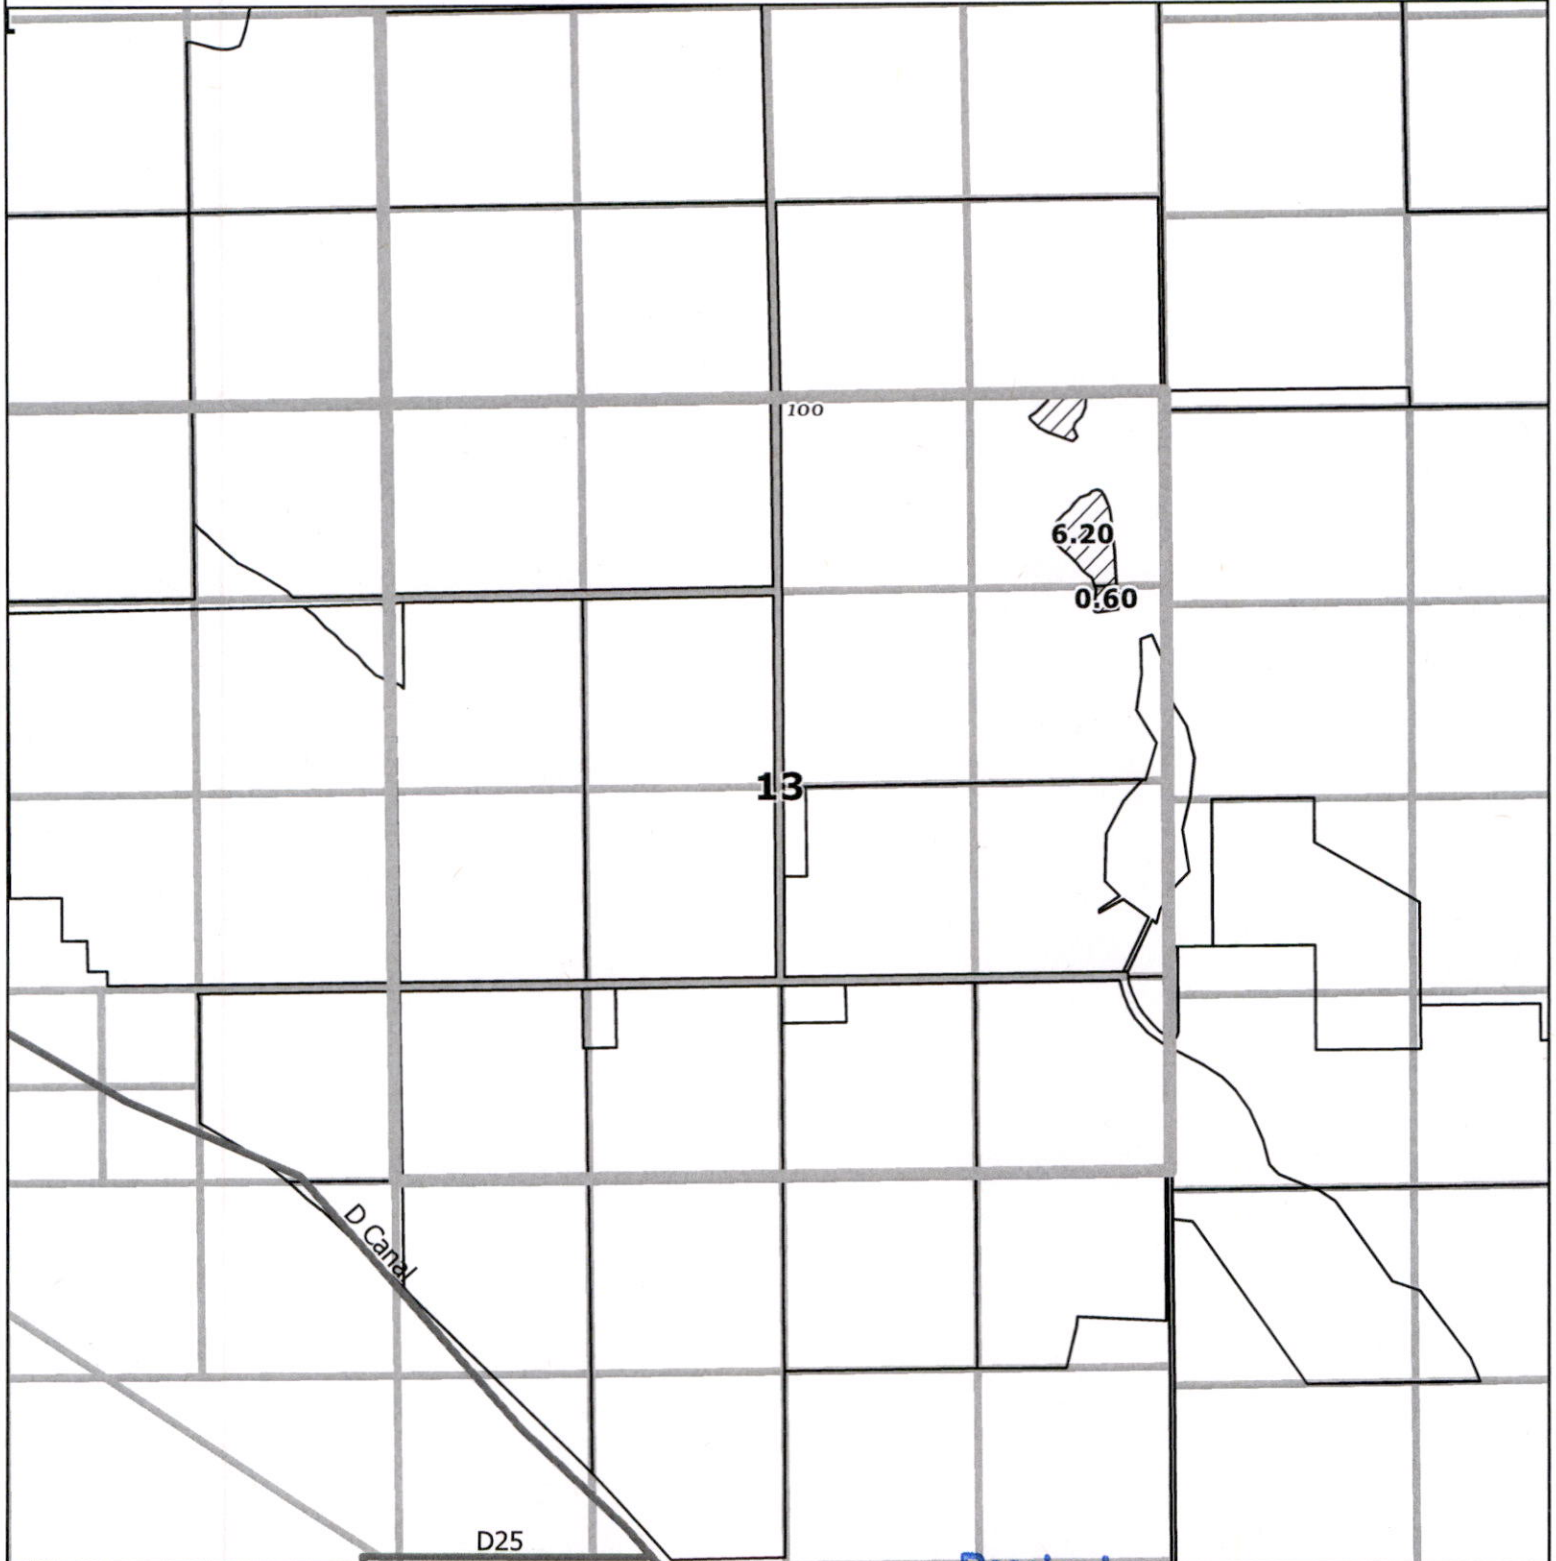


- Place of Use
- Klamath County Taxlot
- QQ Sections and Gov't Lots
- Map Series Sections
- Canal

Received
JUL 07 2025
OWRD

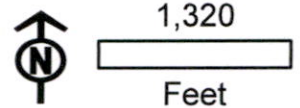

DISCLAIMER
This map is not intended to
provide legal dimensions or
locations of property
ownership lines

WATERSOLVING
johnw@watersolving.com

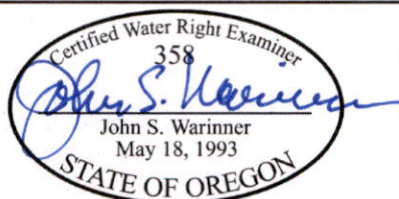

CLAIM OF BENEFICIAL USE MAP
APPLICATION G-16030
PERMIT G-18797
06/23/2025

Watersolving LLC

23321 Chisholm Trail, Bend, OR 97702 | 541.815.4103 | johnw@watersolving.com

TABLES

Received

JUL 07 2025

OWRD

TABLE 1

CBU POU BY QQ

PERMIT G-18797

TT_NS	RR_EW	SEC	QQ_40	Q_160	GOV_LOT	CBU AC
39 S	08 E	36	NE	NE	L 1	0.24
39 S	08 E	36	SE	NE		23.50
39 S	08 E	36	NE	SE		4.34
39 S	09 E	19	SE	SE		6.60
39 S	09 E	21	NE	NW	L 12	4.00
39 S	09 E	21	NW	NW	L 13	4.00
39 S	09 E	21	SW	NW		9.88
39 S	09 E	21	SW	SW		5.10
39 S	09 E	21	SE	SW		7.30
39 S	09 E	21	SW	SE	L 9	11.10
39 S	09 E	27	SW	SW		20.50
39 S	09 E	28	NW	NE		25.30
39 S	09 E	28	SW	NE		38.10
39 S	09 E	28	SE	NW		10.30
39 S	09 E	28	SW	SW		8.00
39 S	09 E	28	NE	SE		5.90
39 S	09 E	28	NW	SE		3.70
39 S	09 E	29	SW	SW		7.70
39 S	09 E	30	NE	NE		32.02
39 S	09 E	30	NW	NE	L 1	0.50
39 S	09 E	30	SE	SE		19.60
39 S	09 E	31	NE	NE		8.50
39 S	09 E	31	SE	NE		2.60
39 S	09 E	31	SE	SW		14.30
39 S	09 E	31	SW	SE		17.50
39 S	09 E	32	NE	NW		2.60
39 S	09 E	32	NW	NW		9.70
39 S	09 E	32	SW	NW		7.28
39 S	09 E	32	NE	SW		7.92
39 S	09 E	32	NW	SW		8.90
39 S	09 E	32	SW	SW		1.00
39 S	09 E	32	SE	SW		17.60
39 S	09 E	32	SW	SE		13.90
39 S	09 E	32	SE	SE		24.80
39 S	09 E	33	NW	NE		12.70
39 S	09 E	33	SW	NE		40.00
39 S	09 E	33	SE	NE		28.30
39 S	09 E	33	NE	NW		16.63
39 S	09 E	33	NW	NW		25.20
39 S	09 E	33	SW	NW		16.50
39 S	09 E	33	SE	NW		40.00
39 S	09 E	33	NE	SW		13.40
39 S	09 E	33	NW	SW		0.50
39 S	09 E	33	SW	SW		10.40
39 S	09 E	33	NE	SE		38.52
39 S	09 E	33	NW	SE		38.60
39 S	09 E	33	SW	SE		17.00
39 S	09 E	33	SE	SE		31.19
39 S	09 E	34	SW	NE		16.00
39 S	09 E	34	NE	NW		8.00
39 S	09 E	34	SE	NW		7.00
39 S	09 E	34	NW	SW		4.10
39 S	09 E	34	SW	SW		8.03
39 S	09 E	34	SE	SW		7.00
39 S	09 E	34	NE	SE		3.40
39 S	09 E	34	SW	SE		1.30
39 S	09 E	34	SE	SE		0.60

Received
JUL 07 2025
OWRD

TABLE 1

CBU POU BY QQ

PERMIT G-18797

39 S	09 E	35	SE	NW		6.00
39 S	09 E	35	NE	SW		11.57
39 S	09 E	35	SE	SW		3.81
39 S	09 E	35	NW	SE		14.15
39 S	09 E	35	SW	SE		21.07
39 S	10 E	07	SE	NE		5.70
39 S	10 E	07	NE	SE		10.51
39 S	10 E	07	SE	SE		16.49
39 S	10 E	08	NW	NE		33.44
39 S	10 E	08	SW	NE		20.66
39 S	10 E	08	SW	NW		7.10
39 S	10 E	08	NE	SE		39.00
39 S	10 E	08	NW	SE		13.88
39 S	10 E	08	SW	SE		28.49
39 S	10 E	08	SE	SE		30.41
39 S	10 E	09	NE	SW		19.70
39 S	10 E	09	NW	SW		20.60
39 S	10 E	09	SW	SW		26.40
39 S	10 E	09	SE	SW		21.00
39 S	10 E	12	NE	SW		26.50
39 S	10 E	12	NE	SE		7.60
39 S	10 E	13	SW	NW	L 6	20.00
39 S	10 E	13	SE	NW	L 7	3.60
39 S	10 E	13	NW	SW		10.60
39 S	10 E	13	SE	SW		17.09
39 S	10 E	13	SW	SE		3.41
39 S	10 E	14	SE	NE	L 11	1.00
39 S	10 E	14	NW	SW	L 8	0.20
39 S	10 E	14	SW	SW	L 7	1.60
39 S	10 E	14	NE	SE	L 10	21.50
39 S	10 E	14	NW	SE	L 9	9.20
39 S	10 E	15	NW	NW		5.66
39 S	10 E	15	SW	NW		33.86
39 S	10 E	15	NE	SW		11.00
39 S	10 E	15	NW	SW		18.88
39 S	10 E	15	SE	SW		3.92
39 S	10 E	15	SW	SE		10.23
39 S	10 E	16	NE	NE		31.63
39 S	10 E	16	NW	NE		18.65
39 S	10 E	16	SW	NE		3.70
39 S	10 E	16	SE	NE		37.07
39 S	10 E	16	NE	NW		12.00
39 S	10 E	16	SW	SW		2.00
39 S	10 E	16	NE	SE		3.30
39 S	10 E	16	SW	SE		0.50
39 S	10 E	16	SE	SE		6.60
39 S	10 E	17	NE	SW		6.50
39 S	10 E	17	NW	SW		3.66
39 S	10 E	17	SW	SW		6.35
39 S	10 E	18	NE	NE		16.80
39 S	10 E	18	SE	NE		40.10
39 S	10 E	18	NE	NW		1.50
39 S	10 E	18	NE	SE		40.18
39 S	10 E	18	NW	SE		25.35
39 S	10 E	18	SW	SE		36.43
39 S	10 E	18	SE	SE		37.34
39 S	10 E	20	NE	NE		2.00
39 S	10 E	20	NW	NW		4.10

Received
JUL 07 2025
OWRD

Received
JUL 07 2025
OWRD

TABLE 1

CBU POU BY QQ

PERMIT G-18797

39 S	10 E	21	NE	NE		11.70
39 S	10 E	21	NW	NE		12.00
39 S	10 E	21	SW	NE		1.60
39 S	10 E	21	NE	NW		18.60
39 S	10 E	21	NW	NW		15.00
39 S	10 E	21	SW	NW		4.00
39 S	10 E	21	SE	NW		9.30
39 S	10 E	21	SW	SW	L 8	1.50
39 S	10 E	22	NE	SW	L 6	23.69
39 S	10 E	22	NW	SE		14.81
39 S	10 E	24	NW	NE		1.20
39 S	10 E	24	NE	NW		9.80
39 S	10 E	27	NE	NW		9.15
39 S	10 E	27	NW	NW		9.07
39 S	10 E	27	SW	NW		0.67
39 S	10 E	27	SE	NW		0.11
39 S	10 E	27	SE	SW		2.20
39 S	10 E	28	NW	NE		1.80
39 S	10 E	28	SW	NE		3.93
39 S	10 E	28	SE	NE		10.23
39 S	10 E	28	NE	NW		3.35
39 S	10 E	28	SE	NW		1.12
39 S	10 E	28	SW	SE		12.10
39 S	10 E	28	SE	SE		0.80
39 S	10 E	29	SE	SW	L 7	1.15
39 S	10 E	29	SW	SE		6.65
39 S	10 E	29	SE	SE		18.80
39 S	10 E	31	NE	NE	L 11	2.94
39 S	10 E	32	NE	NE		21.82
39 S	10 E	32	NW	NE		19.41
39 S	10 E	32	NE	NW		15.39
39 S	10 E	32	NW	NW	L 1	6.70
39 S	10 E	33	NE	NE		16.70
39 S	10 E	33	NW	NE		15.84
39 S	10 E	33	SW	NE		10.57
39 S	10 E	33	NE	NW		0.67
39 S	10 E	33	NW	NW		14.79
39 S	10 E	33	SE	NW		5.66
39 S	10 E	33	NE	SW		1.64
39 S	10 E	33	NW	SE		7.22
39 S	10 E	34	NE	NW		9.47
39 S	10 E	34	NW	NW		10.93
39 S	11 S	18	SW	NE		7.91
39 S	11 S	18	SW	NW	L 2	9.78
39 S	11 S	18	SE	NW		38.36
39 S	11 S	18	NE	SW		4.22
39 S	11 S	18	NE	SE		0.93
39 S	11 S	18	NW	SE		21.96
39 S	11 S	18	SW	SE		0.37
39 S	11 S	18	SE	SE		9.67
39 S	11 S	19	SE	SW		2.40
39 S	11 S	20	SW	NE		11.10
39 S	11 S	20	SE	NE		5.03
39 S	11 S	20	NE	NW		6.24
39 S	11 S	20	NW	NW		14.76
39 S	11 S	20	SE	NW		4.20
39 S	11 S	21	SW	NE		6.10
39 S	11 S	21	SE	NW	L 2	5.50

Received
JUL 07 2025
OWRD

TABLE 1

CBU POU BY QQ

PERMIT G-18797

39 S	11 5	22	NW	NW		2.65
39 S	11 5	22	SW	NW		19.88
39 S	11 5	22	NW	SW		15.95
39 S	11 5	29	SW	NE		13.61
39 S	11 5	29	SW	NW		13.38
39 S	11 5	29	SE	NW		22.71
39 S	11 5	29	NE	SW		26.90
39 S	11 5	29	SE	SW		12.00
39 S	11 5	29	NE	SE		0.20
39 S	11 5	29	NW	SE		5.80
39 S	11 5	29	SW	SE		17.40
39 S	11 5	29	SE	SE		3.70
39 S	11 5	32	NW	NE		11.17
39 S	11 5	32	SW	NE		2.13
39 S	11 5	32	SE	NE		15.60
39 S	11 5	32	SE	SE		22.04
39 S	11 5	33	SW	NW		6.30
39 S	11 5	33	NE	SW		0.04
39 S	11 5	33	NW	SW		3.52
39 S	11 5	33	SW	SW		22.78
39 S	11 5	33	SE	SW		10.90
39 S	11 5	34	SW	SW		4.30
39 S	11 5	35	SE	SE		9.50
40 S	09 E	01	NW	SW		3.00
40 S	09 E	01	SW	SW		0.40
40 S	09 E	02	NW	NE		6.70
40 S	09 E	02	SE	NE		10.70
40 S	09 E	02	NE	NW		6.60
40 S	09 E	02	SW	NW		4.60
40 S	09 E	02	SE	NW		8.30
40 S	09 E	02	NE	SW		10.74
40 S	09 E	02	SE	SW		12.56
40 S	09 E	02	NE	SE		10.30
40 S	09 E	02	NW	SE		26.25
40 S	09 E	02	SW	SE		39.65
40 S	09 E	02	SE	SE		40.00
40 S	09 E	03	NW	NE	L 2	18.43
40 S	09 E	03	SW	NE		41.07
40 S	09 E	03	SE	NE		9.10
40 S	09 E	03	NE	NW	L 3	31.94
40 S	09 E	03	NW	NW	L 4	17.26
40 S	09 E	03	SW	NW		1.78
40 S	09 E	03	NW	SE		14.30
40 S	09 E	03	SW	SE		5.13
40 S	09 E	03	SE	SE		3.57
40 S	09 E	04	NE	NE	L 1	37.75
40 S	09 E	04	NW	NE	L 2	11.25
40 S	09 E	04	SE	NE		8.55
40 S	09 E	04	NE	NW	L 3	0.20
40 S	09 E	04	SW	NW		3.00
40 S	09 E	04	SE	NW		13.50
40 S	09 E	04	NE	SW		0.40
40 S	09 E	04	NW	SW		26.70
40 S	09 E	04	SW	SW		31.20
40 S	09 E	04	SE	SW		14.20
40 S	09 E	04	NW	SE		12.00
40 S	09 E	04	SW	SE		4.30
40 S	09 E	04	SE	SE		8.50

Received
JUL 07 2025
OWRD

TABLE 1

CBU POU BY QQ

PERMIT G-18797

40 S	09 E	05	NE	NW	4.07
40 S	09 E	05	NW	NW	11.00
40 S	09 E	05	SE	SW	34.00
40 S	09 E	05	SW	SE	40.00
40 S	09 E	05	SE	SE	38.80
40 S	09 E	08	NE	NE	4.50
40 S	09 E	08	NE	SE	12.10
40 S	09 E	09	NE	NE	7.80
40 S	09 E	09	NW	NE	2.85
40 S	09 E	09	SW	NE	22.30
40 S	09 E	09	NE	NW	9.00
40 S	09 E	09	SW	NW	10.55
40 S	09 E	09	SE	NW	33.70
40 S	09 E	09	NE	SW	3.44
40 S	09 E	09	NW	SW	10.16
40 S	09 E	10	NE	NE	11.90
40 S	09 E	10	NW	NE	29.00
40 S	09 E	10	SW	NE	16.30
40 S	09 E	10	SE	NE	11.30
40 S	09 E	10	NE	NW	5.42
40 S	09 E	10	NW	NW	3.60
40 S	09 E	10	SW	NW	2.50
40 S	09 E	10	NE	SW	19.40
40 S	09 E	10	NW	SW	30.40
40 S	09 E	10	SW	SW	2.80
40 S	09 E	10	NE	SE	13.50
40 S	09 E	10	NW	SE	8.10
40 S	09 E	10	SE	SE	4.53
40 S	09 E	11	NE	NE	13.60
40 S	09 E	11	NW	NE	2.40
40 S	09 E	11	SW	NE	15.00
40 S	09 E	11	SE	NE	37.10
40 S	09 E	11	SW	SW	4.90
40 S	09 E	11	NE	SE	10.40
40 S	09 E	11	SE	SE	10.40
40 S	09 E	12	NW	NW	18.64
40 S	09 E	12	SW	NW	39.10
40 S	09 E	12	SE	NW	9.30
40 S	09 E	12	NE	SW	25.00
40 S	09 E	12	NW	SW	35.60
40 S	09 E	12	SW	SW	17.20
40 S	09 E	12	SE	SW	23.80
40 S	09 E	13	NW	NE	3.00
40 S	09 E	13	NE	NW	6.30
40 S	09 E	13	NW	NW	36.40
40 S	09 E	13	SW	NW	22.30
40 S	09 E	13	NW	SW	22.80
40 S	09 E	13	SW	SW	36.10
40 S	09 E	13	SE	SW	16.50
40 S	09 E	13	SW	SE	23.00
40 S	09 E	13	SE	SE	13.65
40 S	09 E	14	NE	NE	13.40
40 S	09 E	14	NW	NE	1.00
40 S	09 E	14	SE	NE	23.10
40 S	09 E	14	NW	NW	0.50
40 S	09 E	14	NE	SE	21.80
40 S	09 E	14	NW	SE	0.10
40 S	09 E	14	SW	SE	24.60

Received
JUL 07 2025
OWRD

TABLE 1

CBU POU BY QQ

PERMIT G-18797

40 S	09 E	14	SE	SE		37.50
40 S	09 E	16	NE	NE		4.00
40 S	09 E	23	NE	NE		40.00
40 S	09 E	23	SW	NE		6.10
40 S	09 E	23	SE	NE		23.00
40 S	09 E	23	SE	NW		1.70
40 S	09 E	24	NE	NE		15.00
40 S	09 E	24	NW	NE		9.00
40 S	09 E	24	NW	NW		27.30
40 S	09 E	24	SW	NW		12.40
40 S	10 E	05	NW	NW	L 4	6.00
40 S	10 E	05	SW	NW		3.50
40 S	10 E	05	SE	NW		10.60
40 S	10 E	05	NW	SE		3.10
40 S	10 E	05	SW	SE		19.60
40 S	10 E	06	NE	SE		0.30
40 S	10 E	06	SE	SE		3.50
40 S	10 E	08	NW	NE		19.90
40 S	10 E	08	SW	NE		3.00
40 S	10 E	08	SW	SE	L 3	10.55
40 S	10 E	16	SW	SW		37.10
40 S	10 E	17	SW	NE	L 9	4.50
40 S	10 E	17	SE	NE		25.03
40 S	10 E	17	NE	SE		29.30
40 S	10 E	17	SE	SE	L 6	12.95
40 S	10 E	18	SW	SW	L 4	3.90
40 S	10 E	18	SE	SW		9.50
40 S	10 E	19	NW	NE		0.70
40 S	10 E	19	SW	NE		2.50
40 S	10 E	19	SE	NE		4.00
40 S	10 E	19	NE	NW		2.00
40 S	10 E	19	SE	NW		0.80
40 S	10 E	19	NE	SE		31.00
40 S	10 E	19	SE	SE		31.20
40 S	10 E	20	NW	SW		7.50
40 S	10 E	20	SW	SW		33.67
40 S	10 E	20	SE	SW		4.23
40 S	10 E	21	NW	NW	L 11	14.60
40 S	10 E	21	SE	NW	L 8	7.90
40 S	10 E	21	NE	SE		17.90
40 S	10 E	22	NW	SW		2.10
40 S	10 E	22	SW	SW		6.60
40 S	10 E	22	SE	SW		0.70
40 S	10 E	25	SE	SE		7.90
40 S	10 E	26	SW	NW		14.50
40 S	10 E	26	NW	SW		7.80
40 S	10 E	27	NW	NE		6.20
40 S	10 E	27	SW	NE		3.40
40 S	10 E	27	SE	NE		13.55
40 S	10 E	27	NE	NW		2.90
40 S	10 E	28	SW	SW		1.16
40 S	10 E	28	SE	SW		1.80
40 S	10 E	29	NE	NE		4.00
40 S	10 E	29	SW	NE		1.70
40 S	10 E	29	NE	NW		33.30
40 S	10 E	29	NW	NW		36.20
40 S	10 E	29	SW	NW		37.69
40 S	10 E	29	SE	NW		28.30

Received
JUL 07 2025
OWRD

TABLE 1

CBU POU BY QQ

PERMIT G-18797

40 S	10 E	29	NW	SW		5.00
40 S	10 E	29	SW	SW		23.00
40 S	10 E	29	SE	SW		20.07
40 S	10 E	29	SW	SE		14.30
40 S	10 E	29	SE	SE		3.40
40 S	10 E	30	NE	NE		13.80
40 S	10 E	30	SW	NE		3.08
40 S	10 E	30	SE	NE		8.00
40 S	10 E	30	NW	SE		6.04
40 S	10 E	30	SW	SE		20.27
40 S	10 E	31	NE	NE		23.25
40 S	10 E	31	NW	NE		8.60
40 S	10 E	32	NE	NE		35.80
40 S	10 E	32	NW	NE		0.70
40 S	10 E	32	SW	NE		39.10
40 S	10 E	32	SE	NE		38.20
40 S	10 E	32	NE	NW		40.00
40 S	10 E	32	NW	NW		35.00
40 S	10 E	32	SW	NW		6.00
40 S	10 E	32	SE	NW		26.10
40 S	10 E	33	NE	NW		0.40
40 S	10 E	33	NW	NW		13.44
40 S	10 E	33	SW	NW		20.94
40 S	10 E	33	NE	SW		27.30
40 S	10 E	33	NW	SW		13.20
40 S	10 E	33	SW	SW		36.60
40 S	10 E	33	SE	SW		40.00
40 S	10 E	33	NE	SE		1.64
40 S	10 E	33	NW	SE		18.80
40 S	10 E	33	SW	SE		36.53
40 S	10 E	33	SE	SE		34.60
40 S	10 E	34	SW	SW		22.68
40 S	11 E	01	SW	NW	L 5	39.60
40 S	11 E	01	SE	NW	L 6	19.60
40 S	11 E	01	NE	SW	L 11	39.70
40 S	11 E	01	NW	SW	L 12	40.00
40 S	11 E	01	SW	SW	L 13	39.40
40 S	11 E	01	SE	SW	L 14	31.90
40 S	11 E	02	NE	NE	L 1	1.10
40 S	11 E	02	NE	NE	L 17	39.40
40 S	11 E	02	NW	NE	L 18	39.10
40 S	11 E	02	NW	NE	L 2	3.30
40 S	11 E	02	SW	NE	L 7	4.40
40 S	11 E	02	SE	NE	L 8	18.10
40 S	11 E	02	SE	NW	L 19	23.39
40 S	11 E	02	NE	SW		39.70
40 S	11 E	02	NW	SW		38.30
40 S	11 E	02	SW	SW		18.80
40 S	11 E	02	SW	SW	L 13	3.20
40 S	11 E	02	SE	SW		40.00
40 S	11 E	02	NE	SE		37.40
40 S	11 E	02	NE	SE	L 9	29.20
40 S	11 E	02	NW	SE		40.00
40 S	11 E	02	SW	SE		40.00
40 S	11 E	02	SW	SE	L 15	14.30
40 S	11 E	02	SE	SE		13.90
40 S	11 E	02	SE	SE	L 16	35.20
40 S	11 E	02			L 20	23.00

Received
JUL 07 2025
OWRD

TABLE 1

CBU POU BY QQ

PERMIT G-18797

40 S	11 E	03	NE	SW		16.30
40 S	11 E	03	NE	SW	L 11	19.18
40 S	11 E	03	NW	SW	L 12	32.21
40 S	11 E	03	SW	SW	L 13	36.70
40 S	11 E	03	SW	SW	L 16	6.30
40 S	11 E	03	SE	SW		27.80
40 S	11 E	03	SE	SW	L 14	38.90
40 S	11 E	03	NE	SE		36.00
40 S	11 E	03	NW	SE		40.00
40 S	11 E	03	SW	SE		40.00
40 S	11 E	03	SW	SE	L 15	12.20
40 S	11 E	03	SE	SE		40.00
40 S	11 E	03			L 17	11.60
40 S	11 E	03			L 18	38.50
40 S	11 E	03			L 19	31.40
40 S	11 E	03			L 20	33.90
40 S	11 E	03			L 4	7.42
40 S	11 E	04			L 10	36.50
40 S	11 E	04			L 11	39.50
40 S	11 E	04			L 12	13.01
40 S	11 E	04			L 13	0.10
40 S	11 E	04			L 14	33.10
40 S	11 E	04			L 15	36.50
40 S	11 E	04			L 16	32.22
40 S	11 E	04			L 18	22.60
40 S	11 E	04			L 19	21.36
40 S	11 E	04			L 3	1.00
40 S	11 E	04			L 4	6.30
40 S	11 E	04			L 5	18.49
40 S	11 E	04			L 6	8.50
40 S	11 E	04			L 7	25.40
40 S	11 E	04			L 9	2.50
40 S	11 E	05			L 1	14.90
40 S	11 E	10	NE	NE		15.52
40 S	11 E	11	NE	NE		0.20
40 S	11 E	11	NW	NE		34.30
40 S	11 E	11	SW	NE		9.00
40 S	11 E	11	NE	NW		24.33
40 S	11 E	11	NW	NW		0.20
40 S	11 E	11	SE	NW		0.10
40 S	11 E	28	SW	NW		17.70
40 S	11 E	28	SE	NW		19.70
40 S	11 E	28	NE	SW		37.90
40 S	11 E	28	NW	SW		37.50
40 S	11 E	28	SW	SW		20.60
40 S	11 E	28	SE	SW		39.50
40 S	11 E	28	NW	SE		19.60
40 S	11 E	28	SW	SE		32.03
40 S	11 E	29	SE	NE		17.23
40 S	11 E	29	NE	SE		38.30
40 S	11 E	29	SE	SE		12.58
40 S	11 E	30	NE	SW		10.56
40 S	11 E	30	NW	SW	L 3	9.70
40 S	11 E	30	SW	SW	L 4	0.90
40 S	11 E	30	NE	SE		12.82
40 S	11 E	30	NW	SE		31.70
40 S	11 E	30	SW	SE		2.10
40 S	11 E	30	SE	SE		30.40

Received
JUL 07 2025
OWRD

TABLE 1

CBU POU BY QQ

PERMIT G-18797

40 S	11 E	31	NE	NE		27.73
40 S	11 E	31	SE	NE		14.10
40 S	11 E	31	NE	NW		4.00
40 S	11 E	32	SW	NW		14.50
40 S	11 E	32	NW	SW		7.20
40 S	11 E	32	SE	SE		6.20
40 S	11 E	33	NW	NE		27.60
40 S	11 E	33	SW	NE		31.93
40 S	11 E	33	NE	NW		39.50
40 S	11 E	33	SE	NW		39.70
40 S	11 E	33	NW	SW		7.20
40 S	11 E	33	SW	SW		6.10
40 S	11 E	33	NE	SE		17.30
40 S	11 E	34	NW	SW		5.00
40 S	11 E	34	SW	SW		10.90
40 S	12 E	28	SW	SE		39.70
40 S	12 E	29	SW	SW		20.60
40 S	12 E	29	SE	SW		33.41
40 S	12 E	29	SW	SE		28.16
40 S	12 E	29	SE	SE		38.00
40 S	12 E	30	SW	SE		14.00
40 S	12 E	30	SE	SE		26.00
40 S	12 E	31	NE	NE		33.41
40 S	12 E	31	NW	NE		39.77
40 S	12 E	31	SW	NE		39.23
40 S	12 E	31	SE	NE		30.80
40 S	12 E	31	NE	NW		27.82
40 S	12 E	31	SE	NW		25.58
40 S	12 E	31	SE	SW		28.80
40 S	12 E	31	NE	SE		2.68
40 S	12 E	31	NW	SE		14.62
40 S	12 E	31	SW	SE		36.70
40 S	12 E	32	NE	NE		11.80
40 S	12 E	32	NW	NE		6.75
40 S	12 E	32	SW	NE		11.71
40 S	12 E	32	NE	NW		25.20
40 S	12 E	32	NW	NW		31.20
40 S	12 E	32	SE	NW		2.00
40 S	12 E	33	NE	SE		30.10
40 S	12 E	34	NE	NW		12.69
40 S	12 E	34	NW	NW		6.01
40 S	12 E	34	SW	NW		20.02
40 S	12 E	34	SE	NW		14.72
40 S	12 E	34	NE	SW		2.47
40 S	12 E	34	NW	SW		28.07
40 S	12 E	34	SE	SE		38.00
40 S	12 E	35	SW	SW		22.70
41 S	10 E	03	NW	NE	L 1	3.47
41 S	10 E	03	NW	NW	L 3	25.57
41 S	10 E	03	SW	NW		30.18
41 S	10 E	03	SE	NW		1.78
41 S	10 E	03	NE	SW		8.91
41 S	10 E	03	NW	SW		15.00
41 S	10 E	03	SE	SW		5.00
41 S	10 E	04	NE	NE	L 1	38.80
41 S	10 E	04	SE	NE		38.00
41 S	10 E	04	NE	SE		6.40
41 S	10 E	10	NW	NE		7.05

Received
JUL 07 2025
OWRD

TABLE 1

CBU POU BY QQ

PERMIT G-18797

41 S	10 E	10	SW	NE		4.53
41 S	10 E	10	SE	NE		1.32
41 S	10 E	10	NE	SE		5.50
41 S	10 E	11	SW	SW		17.90
41 S	10 E	14	NE	NW		5.02
41 S	10 E	14	NW	NW		21.97
41 S	10 E	14	SW	NW		29.50
41 S	10 E	14	NE	SW	L 3	25.30
41 S	10 E	14	NW	SW	L 4	11.90
41 S	10 E	14	NW	SE	L 2	13.76
41 S	11 E	01	SW	NW		4.80
41 S	11 E	01	NW	SW		7.00
41 S	11 E	02	NW	NE	L 2	27.70
41 S	11 E	02	SW	NE		33.80
41 S	11 E	02	SE	NE		3.00
41 S	11 E	02	SE	NW		5.58
41 S	11 E	02	NE	SW		6.20
41 S	11 E	02	NE	SE		30.70
41 S	11 E	02	NW	SE		9.81
41 S	11 E	02	SW	SE		2.50
41 S	11 E	02	SE	SE		6.70
41 S	11 E	03	SW	NE		7.80
41 S	11 E	03	SE	NE		31.60
41 S	11 E	03	NW	NW	L 4	2.10
41 S	11 E	03	NE	SE		7.10
41 S	11 E	03	NW	SE		15.40
41 S	11 E	03	SW	SE		2.50
41 S	11 E	04	SE	NE		14.00
41 S	11 E	04	NE	NW	L 3	10.20
41 S	11 E	04	NW	NW	L 4	11.60
41 S	11 E	04	SE	NW		9.80
41 S	11 E	04	NE	SW		25.30
41 S	11 E	04	NW	SE		16.40
41 S	11 E	04	SE	SE		7.90
41 S	11 E	05	NE	NE	L 1	1.50
41 S	11 E	05	NW	NE	L 2	4.00
41 S	11 E	05	SW	NW		15.50
41 S	11 E	05	NW	SW		0.50
41 S	11 E	10	NW	NE		3.70
41 S	12 E	03	NW	NE		3.42
41 S	12 E	04	SW	NE		10.40
41 S	12 E	04	NW	NW		5.00
41 S	12 E	04	SE	NW		10.00
41 S	12 E	06	NE	NW		7.70
41 S	12 E	06	NW	NW	L 1	2.90
41 S	12 E	09	SW	SE		3.00
41 S	12 E	09	SE	SE		12.00
41 S	12 E	10	NW	SW		6.90
41 S	12 E	11	SW	NE		10.00
41 S	12 E	11	SE	NE		14.40
41 S	12 E	11	NE	NW		12.20
41 S	12 E	11	SE	NW		3.80
41 S	12 E	13	NE	NE		6.20
41 S	12 E	13	SE	NE		0.60
TOTAL						8,959.82

Received
JUL 07 2025
OWRD

TABLE 2

CBU POU BY QQ+TL

PERMIT G-18797

TT_NS	RR_EW	SEC	QQ_40	Q_160	Gov Lot	Taxlot	CBU_AC
39 S	08 E	36	NE	NE	L 1	400	0.24
39 S	08 E	36	SE	NE		400	1.50
39 S	08 E	36	SE	NE		500	15.40
39 S	08 E	36	SE	NE		600	6.08
39 S	08 E	36	SE	NE		700	0.52
39 S	08 E	36	NE	SE		100	0.50
39 S	08 E	36	NE	SE		200	1.03
39 S	08 E	36	NE	SE		300	0.52
39 S	08 E	36	NE	SE		400	0.69
39 S	08 E	36	NE	SE		600	0.33
39 S	08 E	36	NE	SE		700	0.15
39 S	08 E	36	NE	SE		800	1.12
39 S	09 E	19	SE	SE		800	6.60
39 S	09 E	21	NE	NW	L 12	200	4.00
39 S	09 E	21	NW	NW	L 13	200	3.36
39 S	09 E	21	NW	NW	L 13	300	0.64
39 S	09 E	21	SW	NW		1700	9.88
39 S	09 E	21	SW	SW		1700	1.00
39 S	09 E	21	SW	SW		1701	0.40
39 S	09 E	21	SW	SW		1800	1.30
39 S	09 E	21	SW	SW		1900	1.90
39 S	09 E	21	SW	SW		2000	0.50
39 S	09 E	21	SE	SW		2000	4.40
39 S	09 E	21	SE	SW		2100	2.90
39 S	09 E	21	SW	SE	L 9	2200	11.10
39 S	09 E	27	SW	SW		1500	20.50
39 S	09 E	28	NW	NE		500	25.30
39 S	09 E	28	SW	NE		500	38.10
39 S	09 E	28	SE	NW		600	10.30
39 S	09 E	28	SW	SW		2101	3.93
39 S	09 E	28	SW	SW		2102	1.25
39 S	09 E	28	SW	SW		2103	1.45
39 S	09 E	28	SW	SW		2104	1.37
39 S	09 E	28	NE	SE		1800	5.90
39 S	09 E	28	NW	SE		1800	3.70
39 S	09 E	29	SW	SW		2000	7.70
39 S	09 E	30	NE	NE		100	32.02
39 S	09 E	30	NW	NE	L 1	100	0.50
39 S	09 E	30	SE	SE		2200	19.60
39 S	09 E	31	NE	NE		100	8.50
39 S	09 E	31	SE	NE		100	2.60
39 S	09 E	31	SE	SW		1100	14.30
39 S	09 E	31	SW	SE		1100	17.50
39 S	09 E	32	NE	NW		200	2.60
39 S	09 E	32	NW	NW		300	9.70
39 S	09 E	32	SW	NW		400	7.28
39 S	09 E	32	NE	SW		400	7.92
39 S	09 E	32	NW	SW		400	8.90
39 S	09 E	32	SW	SW		1200	1.00
39 S	09 E	32	SE	SW		1100	17.60
39 S	09 E	32	SW	SE		500	12.14
39 S	09 E	32	SW	SE		1000	1.76
39 S	09 E	32	SE	SE		800	24.01
39 S	09 E	32	SE	SE		900	0.79
39 S	09 E	33	NW	NE		500	12.70
39 S	09 E	33	SW	NE		500	40.00

Received
JUL 07 2025
OWRD

TABLE 2

CBU POU BY QQ+TL

PERMIT G-18797

39 S	09 E	33	SE	NE		600	19.10
39 S	09 E	33	SE	NE		700	5.59
39 S	09 E	33	SE	NE		800	3.15
39 S	09 E	33	SE	NE		ROW	0.46
39 S	09 E	33	NE	NW		300	9.63
39 S	09 E	33	NE	NW		500	7.00
39 S	09 E	33	NW	NW		300	25.20
39 S	09 E	33	SW	NW		500	16.50
39 S	09 E	33	SE	NW		500	40.00
39 S	09 E	33	NE	SW		500	13.40
39 S	09 E	33	NW	SW		500	0.50
39 S	09 E	33	SW	SW		1200	10.40
39 S	09 E	33	NE	SE		200	32.02
39 S	09 E	33	NE	SE		400	1.10
39 S	09 E	33	NE	SE		500	1.10
39 S	09 E	33	NE	SE		600	1.10
39 S	09 E	33	NE	SE		700	1.10
39 S	09 E	33	NE	SE		800	1.41
39 S	09 E	33	NE	SE		900	0.69
39 S	09 E	33	NW	SE		500	38.60
39 S	09 E	33	SW	SE		1300	17.00
39 S	09 E	33	SE	SE		200	10.36
39 S	09 E	33	SE	SE		900	0.73
39 S	09 E	33	SE	SE		1000	1.04
39 S	09 E	33	SE	SE		1100	1.10
39 S	09 E	33	SE	SE		1200	17.96
39 S	09 E	34	SW	NE		600	16.00
39 S	09 E	34	NE	NW		600	8.00
39 S	09 E	34	SE	NW		600	7.00
39 S	09 E	34	NW	SW		1500	3.50
39 S	09 E	34	NW	SW		1700	0.60
39 S	09 E	34	SW	SW		1700	4.40
39 S	09 E	34	SW	SW		2500	3.63
39 S	09 E	34	SE	SW		1900	7.00
39 S	09 E	34	NE	SE		2300	3.40
39 S	09 E	34	SW	SE		1100	1.30
39 S	09 E	34	SE	SE		2300	0.60
39 S	09 E	35	SE	NW		500	4.00
39 S	09 E	35	SE	NW		501	2.00
39 S	09 E	35	NE	SW		1500	1.30
39 S	09 E	35	NE	SW		1600	10.27
39 S	09 E	35	SE	SW		1600	3.81
39 S	09 E	35	NW	SE		1500	0.60
39 S	09 E	35	NW	SE		1600	13.55
39 S	09 E	35	SW	SE		1600	6.47
39 S	09 E	35	SW	SE		2400	14.60
39 S	10 E	07	SE	NE		2100	3.90
39 S	10 E	07	SE	NE		2200	1.80
39 S	10 E	07	NE	SE		200	7.00
39 S	10 E	07	NE	SE		201	3.51
39 S	10 E	07	SE	SE		200	5.39
39 S	10 E	07	SE	SE		900	11.10
39 S	10 E	08	NW	NE		103	33.44
39 S	10 E	08	SW	NE		200	20.66
39 S	10 E	08	SW	NW		2200	7.10
39 S	10 E	08	NE	SE		700	39.00
39 S	10 E	08	NW	SE		2000	9.53

Received
JUL 07 2025
OWRD

TABLE 2

CBU POU BY QQ+TL

PERMIT G-18797

39 S	10 E	08	NW	SE		2200	1.34
39 S	10 E	08	NW	SE		2201	2.98
39 S	10 E	08	NW	SE		2300	0.03
39 S	10 E	08	SW	SE		2200	2.40
39 S	10 E	08	SW	SE		2201	9.76
39 S	10 E	08	SW	SE		2202	4.66
39 S	10 E	08	SW	SE		2300	11.67
39 S	10 E	08	SE	SE		2400	17.00
39 S	10 E	08	SE	SE		2500	12.41
39 S	10 E	08	SE	SE		2600	1.00
39 S	10 E	09	NE	SW		100	4.00
39 S	10 E	09	NE	SW		101	4.03
39 S	10 E	09	NE	SW		200	1.07
39 S	10 E	09	NE	SW		300	1.30
39 S	10 E	09	NE	SW		400	0.90
39 S	10 E	09	NE	SW		500	0.60
39 S	10 E	09	NE	SW		600	4.10
39 S	10 E	09	NE	SW		700	1.50
39 S	10 E	09	NE	SW		1400	2.20
39 S	10 E	09	NW	SW		1600	20.60
39 S	10 E	09	SW	SW		1600	25.50
39 S	10 E	09	SW	SW		1900	0.90
39 S	10 E	09	SE	SW		1600	21.00
39 S	10 E	12	NE	SW		600	26.50
39 S	10 E	12	NE	SE		1100	3.00
39 S	10 E	12	NE	SE		1200	4.60
39 S	10 E	13	SW	NW	L 6	501	20.00
39 S	10 E	13	SE	NW	L 7	602	3.60
39 S	10 E	13	NW	SW		501	10.60
39 S	10 E	13	SE	SW		600	3.77
39 S	10 E	13	SE	SW		601	13.32
39 S	10 E	13	SW	SE		600	3.41
39 S	10 E	14	SE	NE	L 11	903	1.00
39 S	10 E	14	NW	SW	L 8	600	0.20
39 S	10 E	14	SW	SW	L 7	600	1.60
39 S	10 E	14	NE	SE	L 10	903	21.50
39 S	10 E	14	NW	SE	L 9	901	1.00
39 S	10 E	14	NW	SE	L 9	903	8.20
39 S	10 E	15	NW	NW		700	0.12
39 S	10 E	15	NW	NW		800	5.54
39 S	10 E	15	SW	NW		500	5.61
39 S	10 E	15	SW	NW		600	7.90
39 S	10 E	15	SW	NW		700	9.58
39 S	10 E	15	SW	NW		800	10.77
39 S	10 E	15	NE	SW		900	11.00
39 S	10 E	15	NW	SW		500	6.49
39 S	10 E	15	NW	SW		600	4.40
39 S	10 E	15	NW	SW		700	4.30
39 S	10 E	15	NW	SW		800	3.69
39 S	10 E	15	SE	SW		401	1.52
39 S	10 E	15	SE	SW		900	1.80
39 S	10 E	15	SE	SW		1600	0.60
39 S	10 E	15	SW	SE		300	3.00
39 S	10 E	15	SW	SE		400	3.31
39 S	10 E	15	SW	SE		500	0.19
39 S	10 E	15	SW	SE		600	1.04
39 S	10 E	15	SW	SE		601	1.19

Received
JUL 07 2025
OWRD

TABLE 2

CBU POU BY QQ+TL

PERMIT G-18797

39 S	10 E	15	SW	SE		700	1.50
39 S	10 E	16	NE	NE		100	10.35
39 S	10 E	16	NE	NE		200	6.70
39 S	10 E	16	NE	NE		300	6.98
39 S	10 E	16	NE	NE		400	7.60
39 S	10 E	16	NW	NE		500	5.90
39 S	10 E	16	NW	NE		700	2.15
39 S	10 E	16	NW	NE		900	6.30
39 S	10 E	16	NW	NE		1000	4.30
39 S	10 E	16	SW	NE		1300	3.70
39 S	10 E	16	SE	NE		100	10.25
39 S	10 E	16	SE	NE		200	10.40
39 S	10 E	16	SE	NE		300	9.97
39 S	10 E	16	SE	NE		400	5.90
39 S	10 E	16	SE	NE		1500	0.55
39 S	10 E	16	NE	NW		1100	12.00
39 S	10 E	16	SW	SW		2301	2.00
39 S	10 E	16	NE	SE		100	1.05
39 S	10 E	16	NE	SE		200	0.60
39 S	10 E	16	NE	SE		1600	0.40
39 S	10 E	16	NE	SE		1700	1.00
39 S	10 E	16	NE	SE		1800	0.25
39 S	10 E	16	SW	SE		1900	0.50
39 S	10 E	16	SE	SE		1501	2.50
39 S	10 E	16	SE	SE		1900	4.10
39 S	10 E	17	NE	SW		1303	6.50
39 S	10 E	17	NW	SW		1200	3.66
39 S	10 E	17	SW	SW		1200	6.35
39 S	10 E	18	NE	NE		100	15.69
39 S	10 E	18	NE	NE		200	1.11
39 S	10 E	18	SE	NE		800	40.10
39 S	10 E	18	NE	NW		100	1.50
39 S	10 E	18	NE	SE		800	40.18
39 S	10 E	18	NW	SE		800	25.35
39 S	10 E	18	SW	SE		800	36.43
39 S	10 E	18	SE	SE		800	34.04
39 S	10 E	18	SE	SE		1500	0.55
39 S	10 E	18	SE	SE		1600	0.80
39 S	10 E	18	SE	SE		1700	0.80
39 S	10 E	18	SE	SE		1800	0.80
39 S	10 E	18	SE	SE		1900	0.35
39 S	10 E	20	NE	NE		900	2.00
39 S	10 E	20	NW	NW		400	4.10
39 S	10 E	21	NE	NE		200	2.20
39 S	10 E	21	NE	NE		300	9.50
39 S	10 E	21	NW	NE		300	3.30
39 S	10 E	21	NW	NE		900	8.70
39 S	10 E	21	SW	NE		900	1.60
39 S	10 E	21	NE	NW		700	18.60
39 S	10 E	21	NW	NW		700	15.00
39 S	10 E	21	SW	NW		700	4.00
39 S	10 E	21	SE	NW		700	9.30
39 S	10 E	21	SW	SW	L 8	1500	0.60
39 S	10 E	21	SW	SW	L 8	1600	0.90
39 S	10 E	22	NE	SW	L 6	500	23.69
39 S	10 E	22	NW	SE		500	14.81
39 S	10 E	24	NW	NE		2300	1.20

Received
JUL 07 2025
OWRD

TABLE 2

CBU POU BY QQ+TL

PERMIT G-18797

39 S	10 E	24	NE	NW		2200	9.80
39 S	10 E	27	NE	NW		3202	3.00
39 S	10 E	27	NE	NW		3300	5.00
39 S	10 E	27	NE	NW		3303	1.15
39 S	10 E	27	NW	NW		3303	9.07
39 S	10 E	27	SW	NW		3303	0.67
39 S	10 E	27	SE	NW		3303	0.11
39 S	10 E	27	SE	SW		3201	2.20
39 S	10 E	28	NW	NE		1001	1.80
39 S	10 E	28	SW	NE		500	0.72
39 S	10 E	28	SW	NE		1001	0.23
39 S	10 E	28	SW	NE		1600	0.40
39 S	10 E	28	SW	NE		1700	1.98
39 S	10 E	28	SW	NE		1800	0.60
39 S	10 E	28	SE	NE		103	7.50
39 S	10 E	28	SE	NE		104	0.40
39 S	10 E	28	SE	NE		105	2.33
39 S	10 E	28	NE	NW		1001	3.35
39 S	10 E	28	SE	NW		1001	1.12
39 S	10 E	28	SW	SE		2200	11.80
39 S	10 E	28	SW	SE		2300	0.30
39 S	10 E	28	SE	SE		2400	0.80
39 S	10 E	29	SE	SW	L 7	1300	1.15
39 S	10 E	29	SW	SE		1000	4.30
39 S	10 E	29	SW	SE		2100	2.35
39 S	10 E	29	SE	SE		1100	13.15
39 S	10 E	29	SE	SE		1200	0.63
39 S	10 E	29	SE	SE		2200	1.57
39 S	10 E	29	SE	SE		2300	2.50
39 S	10 E	29	SE	SE		2400	0.95
39 S	10 E	31	NE	NE	L 11	500	2.94
39 S	10 E	32	NE	NE		101	7.29
39 S	10 E	32	NE	NE		102	8.73
39 S	10 E	32	NE	NE		200	5.80
39 S	10 E	32	NW	NE		300	10.40
39 S	10 E	32	NW	NE		400	2.16
39 S	10 E	32	NW	NE		401	2.72
39 S	10 E	32	NW	NE		402	4.13
39 S	10 E	32	NE	NW		400	0.58
39 S	10 E	32	NE	NW		402	0.61
39 S	10 E	32	NE	NW		600	3.00
39 S	10 E	32	NE	NW		700	7.27
39 S	10 E	32	NE	NW		800	1.90
39 S	10 E	32	NE	NW		900	1.68
39 S	10 E	32	NE	NW		1000	0.35
39 S	10 E	32	NW	NW	L 1	1201	5.70
39 S	10 E	32	NW	NW	L 1	2000	1.00
39 S	10 E	33	NE	NE		200	14.84
39 S	10 E	33	NE	NE		201	1.86
39 S	10 E	33	NW	NE		301	15.84
39 S	10 E	33	SW	NE		301	10.57
39 S	10 E	33	NE	NW		301	0.27
39 S	10 E	33	NE	NW		800	0.40
39 S	10 E	33	NW	NW		301	0.27
39 S	10 E	33	NW	NW		800	1.30
39 S	10 E	33	NW	NW		900	5.23
39 S	10 E	33	NW	NW		1000	3.30

Received
JUL 07 2025
OWRD

TABLE 2

CBU POU BY QQ+TL

PERMIT G-18797

39 S	10 E	33	NW	NW		1100	4.69
39 S	10 E	33	SE	NW		301	5.66
39 S	10 E	33	NE	SW		301	1.64
39 S	10 E	33	NW	SE		301	7.22
39 S	10 E	34	NE	NW		401	9.47
39 S	10 E	34	NW	NW		400	9.00
39 S	10 E	34	NW	NW		401	1.93
39 S	11 5	18	SW	NE		101	7.91
39 S	11 5	18	SW	NW	L 2	101	9.78
39 S	11 5	18	SE	NW		101	38.36
39 S	11 5	18	NE	SW		101	4.22
39 S	11 5	18	NE	SE		500	0.93
39 S	11 5	18	NW	SE		101	21.96
39 S	11 5	18	SW	SE		101	0.37
39 S	11 5	18	SE	SE		500	9.67
39 S	11 5	19	SE	SW		600	1.06
39 S	11 5	19	SE	SW		601	1.34
39 S	11 5	20	SW	NE		1100	1.40
39 S	11 5	20	SW	NE		1200	2.50
39 S	11 5	20	SW	NE		1300	2.50
39 S	11 5	20	SW	NE		1400	2.50
39 S	11 5	20	SW	NE		1500	2.20
39 S	11 5	20	SE	NE		1500	0.30
39 S	11 5	20	SE	NE		1600	0.44
39 S	11 5	20	SE	NE		1700	0.63
39 S	11 5	20	SE	NE		1800	2.10
39 S	11 5	20	SE	NE		1900	0.25
39 S	11 5	20	SE	NE		2000	1.31
39 S	11 5	20	NE	NW		400	2.30
39 S	11 5	20	NE	NW		500	2.50
39 S	11 5	20	NE	NW		800	1.44
39 S	11 5	20	NW	NW		600	8.87
39 S	11 5	20	NW	NW		800	5.89
39 S	11 5	20	SE	NW		200	1.30
39 S	11 5	20	SE	NW		400	0.80
39 S	11 5	20	SE	NW		900	0.50
39 S	11 5	20	SE	NW		1000	0.50
39 S	11 5	20	SE	NW		1100	1.10
39 S	11 5	21	SW	NE		800	6.10
39 S	11 5	21	SE	NW	L 2	300	5.50
39 S	11 5	22	NW	NW		200	2.65
39 S	11 5	22	SW	NW		200	19.88
39 S	11 5	22	NW	SW		200	15.95
39 S	11 5	29	SW	NE		500	13.61
39 S	11 5	29	SW	NW		500	13.38
39 S	11 5	29	SE	NW		500	22.71
39 S	11 5	29	NE	SW		700	26.90
39 S	11 5	29	SE	SW		700	12.00
39 S	11 5	29	NE	SE		600	0.20
39 S	11 5	29	NW	SE		700	5.80
39 S	11 5	29	SW	SE		700	17.40
39 S	11 5	29	SE	SE		600	3.70
39 S	11 5	32	NW	NE		200	8.89
39 S	11 5	32	NW	NE		201	2.28
39 S	11 5	32	SW	NE		200	0.35
39 S	11 5	32	SW	NE		201	1.78
39 S	11 5	32	SE	NE		200	3.14

Received
JUL 07 2025
OWRD

TABLE 2

CBU POU BY QQ+TL

PERMIT G-18797

39 S	11 5	32	SE	NE		201	12.46
39 S	11 5	32	SE	SE		700	22.04
39 S	11 5	33	SW	NW		400	6.30
39 S	11 5	33	NE	SW		800	0.04
39 S	11 5	33	NW	SW		900	3.52
39 S	11 5	33	SW	SW		900	22.78
39 S	11 5	33	SE	SW		800	10.90
39 S	11 5	34	SW	SW		500	4.30
39 S	11 5	35	SE	SE		100	9.50
40 S	09 E	01	NW	SW		300	3.00
40 S	09 E	01	SW	SW		300	0.40
40 S	09 E	02	NW	NE		501	6.70
40 S	09 E	02	SE	NE		1000	10.70
40 S	09 E	02	NE	NW		600	6.60
40 S	09 E	02	SW	NW		800	4.60
40 S	09 E	02	SE	NW		900	8.30
40 S	09 E	02	NE	SW		1300	10.74
40 S	09 E	02	SE	SW		1300	11.86
40 S	09 E	02	SE	SW		1700	0.70
40 S	09 E	02	NE	SE		1100	10.30
40 S	09 E	02	NW	SE		1100	26.25
40 S	09 E	02	SW	SE		1100	33.64
40 S	09 E	02	SW	SE		1200	6.01
40 S	09 E	02	SE	SE		1100	26.00
40 S	09 E	02	SE	SE		1800	9.00
40 S	09 E	02	SE	SE		1900	5.00
40 S	09 E	03	NW	NE	L 2	300	18.43
40 S	09 E	03	SW	NE		300	41.07
40 S	09 E	03	SE	NE		300	9.10
40 S	09 E	03	NE	NW	L 3	400	7.40
40 S	09 E	03	NE	NW	L 3	500	8.50
40 S	09 E	03	NE	NW	L 3	600	14.36
40 S	09 E	03	NE	NW	L 3	1000	1.68
40 S	09 E	03	NW	NW	L 4	600	7.74
40 S	09 E	03	NW	NW	L 4	700	2.40
40 S	09 E	03	NW	NW	L 4	900	0.40
40 S	09 E	03	NW	NW	L 4	1000	6.72
40 S	09 E	03	SW	NW		1100	1.78
40 S	09 E	03	NW	SE		1300	14.30
40 S	09 E	03	SW	SE		2000	5.13
40 S	09 E	03	SE	SE		2000	3.57
40 S	09 E	04	NE	NE	L 1	100	5.93
40 S	09 E	04	NE	NE	L 1	200	31.82
40 S	09 E	04	NW	NE	L 2	400	4.15
40 S	09 E	04	NW	NE	L 2	500	7.10
40 S	09 E	04	SE	NE		200	8.55
40 S	09 E	04	NE	NW	L 3	600	0.20
40 S	09 E	04	SW	NW		800	3.00
40 S	09 E	04	SE	NW		602	13.50
40 S	09 E	04	NE	SW		1000	0.40
40 S	09 E	04	NW	SW		900	26.70
40 S	09 E	04	SW	SW		900	31.20
40 S	09 E	04	SE	SW		1000	14.20
40 S	09 E	04	NW	SE		1001	12.00
40 S	09 E	04	SW	SE		1001	4.30
40 S	09 E	04	SE	SE		1100	0.70
40 S	09 E	04	SE	SE		1200	7.00

Received
JUL 07 2025

OWRD

TABLE 2

CBU POU BY QQ+TL

PERMIT G-18797

40 S	09 E	04	SE	SE		1300	0.80
40 S	09 E	05	NE	NW		700	4.07
40 S	09 E	05	NW	NW		800	11.00
40 S	09 E	05	SE	SW		1300	34.00
40 S	09 E	05	SW	SE		1300	40.00
40 S	09 E	05	SE	SE		1300	25.00
40 S	09 E	05	SE	SE		1500	13.80
40 S	09 E	08	NE	NE		200	4.50
40 S	09 E	08	NE	SE		400	12.10
40 S	09 E	09	NE	NE		100	7.80
40 S	09 E	09	NW	NE		200	2.75
40 S	09 E	09	NW	NE		400	0.10
40 S	09 E	09	SW	NE		200	0.55
40 S	09 E	09	SW	NE		400	10.20
40 S	09 E	09	SW	NE		1000	11.55
40 S	09 E	09	NE	NW		300	9.00
40 S	09 E	09	SW	NW		1000	10.55
40 S	09 E	09	SE	NW		300	3.70
40 S	09 E	09	SE	NW		1000	30.00
40 S	09 E	09	NE	SW		1000	3.44
40 S	09 E	09	NW	SW		1000	10.16
40 S	09 E	10	NE	NE		200	11.90
40 S	09 E	10	NW	NE		400	29.00
40 S	09 E	10	SW	NE		400	16.30
40 S	09 E	10	SE	NE		200	11.30
40 S	09 E	10	NE	NW		400	5.42
40 S	09 E	10	NW	NW		600	3.60
40 S	09 E	10	SW	NW		600	2.50
40 S	09 E	10	NE	SW		400	19.40
40 S	09 E	10	NW	SW		900	30.40
40 S	09 E	10	SW	SW		900	2.80
40 S	09 E	10	NE	SE		1200	8.80
40 S	09 E	10	NE	SE		1300	1.80
40 S	09 E	10	NE	SE		1400	0.25
40 S	09 E	10	NE	SE		1500	2.65
40 S	09 E	10	NW	SE		1100	1.50
40 S	09 E	10	NW	SE		1800	1.60
40 S	09 E	10	NW	SE		1900	5.00
40 S	09 E	10	SE	SE		2600	0.23
40 S	09 E	10	SE	SE		2800	4.30
40 S	09 E	11	NE	NE		100	13.60
40 S	09 E	11	NW	NE		100	2.40
40 S	09 E	11	SW	NE		500	15.00
40 S	09 E	11	SE	NE		500	37.10
40 S	09 E	11	SW	SW		800	3.40
40 S	09 E	11	SW	SW		1000	1.50
40 S	09 E	11	NE	SE		600	10.40
40 S	09 E	11	SE	SE		600	10.40
40 S	09 E	12	NW	NW		400	3.64
40 S	09 E	12	NW	NW		500	15.00
40 S	09 E	12	SW	NW		600	39.10
40 S	09 E	12	SE	NW		500	9.30
40 S	09 E	12	NE	SW		500	25.00
40 S	09 E	12	NW	SW		1200	35.60
40 S	09 E	12	SW	SW		1300	17.20
40 S	09 E	12	SE	SW		1300	23.80
40 S	09 E	13	NW	NE		200	3.00

Received
JUL 07 2025
OWRD

TABLE 2

CBU POU BY QQ+TL

PERMIT G-18797

40 S	09 E	13	NE	NW		200	5.50
40 S	09 E	13	NE	NW		300	0.80
40 S	09 E	13	NW	NW		200	27.20
40 S	09 E	13	NW	NW		300	9.20
40 S	09 E	13	SW	NW		300	22.30
40 S	09 E	13	NW	SW		800	22.80
40 S	09 E	13	SW	SW		900	36.10
40 S	09 E	13	SE	SW		900	16.50
40 S	09 E	13	SW	SE		1000	23.00
40 S	09 E	13	SE	SE		1100	13.65
40 S	09 E	14	NE	NE		102	13.40
40 S	09 E	14	NW	NE		102	1.00
40 S	09 E	14	SE	NE		101	5.00
40 S	09 E	14	SE	NE		102	18.10
40 S	09 E	14	NW	NW		400	0.50
40 S	09 E	14	NE	SE		1100	21.80
40 S	09 E	14	NW	SE		1100	0.10
40 S	09 E	14	SW	SE		1100	24.60
40 S	09 E	14	SE	SE		1100	37.50
40 S	09 E	16	NE	NE		100	4.00
40 S	09 E	23	NE	NE		2200	40.00
40 S	09 E	23	SW	NE		2000	6.10
40 S	09 E	23	SE	NE		2200	23.00
40 S	09 E	23	SE	NW		2000	1.70
40 S	09 E	24	NE	NE		3100	15.00
40 S	09 E	24	NW	NE		3100	9.00
40 S	09 E	24	NW	NW		2900	27.30
40 S	09 E	24	SW	NW		2900	12.40
40 S	10 E	05	NW	NW	L 4	1000	6.00
40 S	10 E	05	SW	NW		400	3.50
40 S	10 E	05	SE	NW		400	10.60
40 S	10 E	05	NW	SE		300	3.10
40 S	10 E	05	SW	SE		1601	9.69
40 S	10 E	05	SW	SE		1700	9.91
40 S	10 E	06	NE	SE		700	0.30
40 S	10 E	06	SE	SE		700	3.50
40 S	10 E	08	NW	NE		300	19.90
40 S	10 E	08	SW	NE		900	3.00
40 S	10 E	08	SW	SE	L 3	1400	10.55
40 S	10 E	16	SW	SW		201	32.51
40 S	10 E	16	SW	SW		700	4.59
40 S	10 E	17	SW	NE	L 9	900	4.50
40 S	10 E	17	SE	NE		900	25.03
40 S	10 E	17	NE	SE		1000	28.30
40 S	10 E	17	NE	SE		1100	1.00
40 S	10 E	17	SE	SE	L 6	2200	12.95
40 S	10 E	18	SW	SW	L 4	1100	3.90
40 S	10 E	18	SE	SW		1100	9.50
40 S	10 E	19	NW	NE		1001	0.70
40 S	10 E	19	SW	NE		1001	2.50
40 S	10 E	19	SE	NE		100	4.00
40 S	10 E	19	NE	NW		400	2.00
40 S	10 E	19	SE	NW		600	0.80
40 S	10 E	19	NE	SE		1100	31.00
40 S	10 E	19	SE	SE		1100	31.20
40 S	10 E	20	NW	SW		1301	7.50
40 S	10 E	20	SW	SW		1400	32.50

Received
JUL 07 2025
OWRD

TABLE 2

CBU POU BY QQ+TL

PERMIT G-18797

40 S	10 E	20	SW	SW		1900	1.17
40 S	10 E	20	SE	SW		1400	4.23
40 S	10 E	21	NW	NW	L 11	300	14.60
40 S	10 E	21	SE	NW	L 8	502	7.90
40 S	10 E	21	NE	SE		700	17.90
40 S	10 E	22	NW	SW		300	2.10
40 S	10 E	22	SW	SW		400	6.60
40 S	10 E	22	SE	SW		600	0.70
40 S	10 E	25	SE	SE		800	7.90
40 S	10 E	26	SW	NW		500	14.50
40 S	10 E	26	NW	SW		500	7.80
40 S	10 E	27	NW	NE		200	6.20
40 S	10 E	27	SW	NE		200	3.40
40 S	10 E	27	SE	NE		300	13.55
40 S	10 E	27	NE	NW		200	2.90
40 S	10 E	28	SW	SW		1401	1.16
40 S	10 E	28	SE	SW		1401	1.80
40 S	10 E	29	NE	NE		302	4.00
40 S	10 E	29	SW	NE		302	1.70
40 S	10 E	29	NE	NW		500	33.30
40 S	10 E	29	NW	NW		500	36.20
40 S	10 E	29	SW	NW		302	37.69
40 S	10 E	29	SE	NW		302	27.70
40 S	10 E	29	SE	NW		302	0.60
40 S	10 E	29	NW	SW		700	5.00
40 S	10 E	29	SW	SW		700	23.00
40 S	10 E	29	SE	SW		700	20.07
40 S	10 E	29	SE	SE		800	14.30
40 S	10 E	29	SE	SE		800	3.40
40 S	10 E	30	NE	NE		3000	13.80
40 S	10 E	30	SW	NE		3300	3.08
40 S	10 E	30	SE	NE		3300	8.00
40 S	10 E	30	NW	SE		3300	6.04
40 S	10 E	30	SW	SE		3300	20.27
40 S	10 E	31	NE	NE		3400	23.25
40 S	10 E	31	NW	NE		3400	8.60
40 S	10 E	32	NE	NE		100	35.80
40 S	10 E	32	NW	NE		100	0.70
40 S	10 E	32	SW	NE		100	39.10
40 S	10 E	32	SE	NE		100	38.20
40 S	10 E	32	NE	NW		100	40.00
40 S	10 E	32	NW	NW		200	35.00
40 S	10 E	32	SW	NW		200	6.00
40 S	10 E	32	SE	NW		100	26.10
40 S	10 E	33	NE	NW		400	0.40
40 S	10 E	33	NW	NW		400	13.44
40 S	10 E	33	SW	NW		400	20.94
40 S	10 E	33	NE	SW		601	27.30
40 S	10 E	33	NW	SW		601	13.20
40 S	10 E	33	SW	SW		601	36.60
40 S	10 E	33	SE	SW		601	40.00
40 S	10 E	33	NE	SE		800	1.64
40 S	10 E	33	NW	SE		800	18.80
40 S	10 E	33	SW	SE		900	19.50
40 S	10 E	33	SW	SE		1000	17.03
40 S	10 E	33	SE	SE		1100	24.60
40 S	10 E	33	SE	SE		1200	10.00

Received
JUL 07 2025
OWRD

TABLE 2

CBU POU BY QQ+TL

PERMIT G-18797

40 S	10 E	34	SW	SW		1600	18.68
40 S	10 E	34	SW	SW		1700	4.00
40 S	11 E	01	SW	NW	L 5	200	39.60
40 S	11 E	01	SE	NW	L 6	200	19.60
40 S	11 E	01	NE	SW	L 11	300	39.70
40 S	11 E	01	NW	SW	L 12	300	40.00
40 S	11 E	01	SW	SW	L 13	300	39.40
40 S	11 E	01	SE	SW	L 14	300	31.90
40 S	11 E	02	NE	NE	L 1	100	1.10
40 S	11 E	02	NE	NE	L 17	800	39.40
40 S	11 E	02	NW	NE	L 18	800	39.10
40 S	11 E	02	NW	NE	L 2	100	3.30
40 S	11 E	02	SW	NE	L 7	100	4.40
40 S	11 E	02	SE	NE	L 8	500	18.10
40 S	11 E	02	SE	NW	L 19	1000	23.39
40 S	11 E	02	NE	SW		1000	39.70
40 S	11 E	02	NW	SW		1000	38.30
40 S	11 E	02	SW	SW		1000	18.80
40 S	11 E	02	SW	SW	L 13	301	3.20
40 S	11 E	02	SE	SW		800	11.60
40 S	11 E	02	SE	SW		1000	28.40
40 S	11 E	02	NE	SE		800	37.40
40 S	11 E	02	NE	SE	L 9	500	29.20
40 S	11 E	02	NW	SE		800	40.00
40 S	11 E	02	SW	SE		800	40.00
40 S	11 E	02	SW	SE	L 15	500	14.30
40 S	11 E	02	SE	SE		800	13.90
40 S	11 E	02	SE	SE	L 16	500	35.20
40 S	11 E	02			L 20	1000	23.00
40 S	11 E	03	NE	SW		1300	16.30
40 S	11 E	03	NE	SW	L 11	500	19.18
40 S	11 E	03	NW	SW	L 12	500	32.21
40 S	11 E	03	SW	SW	L 13	900	36.70
40 S	11 E	03	SW	SW	L 16	1300	6.30
40 S	11 E	03	SE	SW		1300	27.80
40 S	11 E	03	SE	SW	L 14	900	38.90
40 S	11 E	03	NE	SE		1300	36.00
40 S	11 E	03	NW	SE		1300	40.00
40 S	11 E	03	SW	SE		1300	40.00
40 S	11 E	03	SW	SE	L 15	1300	12.20
40 S	11 E	03	SE	SE		1300	40.00
40 S	11 E	03			L 17	1300	11.60
40 S	11 E	03			L 18	1300	38.50
40 S	11 E	03			L 19	900	31.40
40 S	11 E	03			L 20	900	33.90
40 S	11 E	03			L 4	200	6.94
40 S	11 E	03			L 4	400	0.48
40 S	11 E	04			L 10	501	36.50
40 S	11 E	04			L 11	200	39.50
40 S	11 E	04			L 12	200	13.01
40 S	11 E	04			L 13	200	0.10
40 S	11 E	04			L 14	200	33.10
40 S	11 E	04			L 15	501	36.50
40 S	11 E	04			L 16	500	32.22
40 S	11 E	04			L 18	800	22.60
40 S	11 E	04			L 19	800	21.36
40 S	11 E	04			L 3	200	1.00

Received
JUL 07 2025
OWRD

TABLE 2

CBU POU BY QQ+TL

PERMIT G-18797

40 S	11 E	04			L 4	200	6.30
40 S	11 E	04			L 5	200	18.49
40 S	11 E	04			L 6	200	8.50
40 S	11 E	04			L 7	501	25.40
40 S	11 E	04			L 9	600	2.50
40 S	11 E	05			L 1	300	14.90
40 S	11 E	10	NE	NE		700	15.52
40 S	11 E	11	NE	NE		101	0.20
40 S	11 E	11	NW	NE		101	34.30
40 S	11 E	11	SW	NE		101	9.00
40 S	11 E	11	NE	NW		101	20.50
40 S	11 E	11	NE	NW		1000	1.60
40 S	11 E	11	NE	NW		1001	2.23
40 S	11 E	11	NW	NW		1000	0.20
40 S	11 E	11	SE	NW		101	0.10
40 S	11 E	28	SW	NW		500	17.70
40 S	11 E	28	SE	NW		400	19.70
40 S	11 E	28	NE	SW		400	37.90
40 S	11 E	28	NW	SW		500	37.50
40 S	11 E	28	SW	SW		500	20.60
40 S	11 E	28	SE	SW		900	37.00
40 S	11 E	28	SE	SW		1000	2.50
40 S	11 E	28	NW	SE		600	19.60
40 S	11 E	28	SW	SE		600	32.03
40 S	11 E	29	SE	NE		500	17.23
40 S	11 E	29	NE	SE		500	38.30
40 S	11 E	29	SE	SE		600	12.58
40 S	11 E	30	NE	SW		6500	10.56
40 S	11 E	30	NW	SW	L 3	6700	9.70
40 S	11 E	30	SW	SW	L 4	6700	0.90
40 S	11 E	30	NE	SE		6400	12.82
40 S	11 E	30	NW	SE		6500	31.70
40 S	11 E	30	SW	SE		6500	2.10
40 S	11 E	30	SE	SE		6400	30.40
40 S	11 E	31	NE	NE		100	27.73
40 S	11 E	31	SE	NE		100	14.10
40 S	11 E	31	NE	NW		200	4.00
40 S	11 E	32	SW	NW		600	14.50
40 S	11 E	32	NW	SW		1300	7.20
40 S	11 E	32	SE	SE		1801	6.20
40 S	11 E	33	NW	NE		200	1.00
40 S	11 E	33	NW	NE		201	6.80
40 S	11 E	33	NW	NE		300	19.80
40 S	11 E	33	SW	NE		300	31.93
40 S	11 E	33	NE	NW		300	39.50
40 S	11 E	33	SE	NW		300	39.70
40 S	11 E	33	NW	SW		1000	7.20
40 S	11 E	33	SW	SW		800	5.70
40 S	11 E	33	SW	SW		1000	0.40
40 S	11 E	33	NE	SE		1200	1.06
40 S	11 E	33	NE	SE		1300	12.46
40 S	11 E	33	NE	SE		1301	3.78
40 S	11 E	34	NW	SW		7000	5.00
40 S	11 E	34	SW	SW		7000	10.90
40 S	12 E	28	SW	SE		7000	39.70
40 S	12 E	29	SW	SW		1000	20.60
40 S	12 E	29	SE	SW		1000	33.41

Received
JUL 07 2025
OWRD

TABLE 2

CBU POU BY QQ+TL

PERMIT G-18797

40 S	12 E	29	SW	SE		1000	28.16
40 S	12 E	29	SE	SE		1200	38.00
40 S	12 E	30	SW	SE		1100	14.00
40 S	12 E	30	SE	SE		1100	26.00
40 S	12 E	31	NE	NE		100	33.41
40 S	12 E	31	NW	NE		100	39.70
40 S	12 E	31	NW	NE		202	0.07
40 S	12 E	31	SW	NE		100	20.00
40 S	12 E	31	SW	NE		202	19.23
40 S	12 E	31	SE	NE		100	30.80
40 S	12 E	31	NE	NW		202	27.82
40 S	12 E	31	SE	NW		202	25.58
40 S	12 E	31	SE	SW		900	28.80
40 S	12 E	31	NE	SE		200	1.90
40 S	12 E	31	NE	SE		202	0.78
40 S	12 E	31	NW	SE		200	1.40
40 S	12 E	31	NW	SE		202	13.22
40 S	12 E	31	SW	SE		900	36.70
40 S	12 E	32	NE	NE		100	11.80
40 S	12 E	32	NW	NE		200	6.75
40 S	12 E	32	SW	NE		600	11.71
40 S	12 E	32	NE	NW		400	25.20
40 S	12 E	32	NW	NW		500	31.20
40 S	12 E	32	SE	NW		400	2.00
40 S	12 E	33	NE	SE		1100	30.10
40 S	12 E	34	NE	NW		300	12.69
40 S	12 E	34	NW	NW		300	6.01
40 S	12 E	34	SW	NW		300	20.02
40 S	12 E	34	SE	NW		300	14.72
40 S	12 E	34	NE	SW		300	2.47
40 S	12 E	34	NW	SW		300	28.07
40 S	12 E	34	SE	SE		600	38.00
40 S	12 E	35	SW	SW		7100	22.70
41 S	10 E	03	NW	NE	L 1	800	3.47
41 S	10 E	03	NW	NW	L 3	1100	0.16
41 S	10 E	03	NW	NW	L 3	1300	25.41
41 S	10 E	03	SW	NW		1100	0.15
41 S	10 E	03	SW	NW		1300	10.13
41 S	10 E	03	SW	NW		1500	19.90
41 S	10 E	03	SE	NW		1100	1.78
41 S	10 E	03	NE	SW		1100	8.91
41 S	10 E	03	NW	SW		1101	15.00
41 S	10 E	03	SE	SW		2003	5.00
41 S	10 E	04	NE	NE	L 1	100	38.80
41 S	10 E	04	SE	NE		100	38.00
41 S	10 E	04	NE	SE		902	6.40
41 S	10 E	10	NW	NE		200	7.05
41 S	10 E	10	SW	NE		200	4.53
41 S	10 E	10	SE	NE		200	1.32
41 S	10 E	10	NE	SE		701	5.50
41 S	10 E	11	SW	SW		1000	17.90
41 S	10 E	14	NE	NW		200	5.02
41 S	10 E	14	NW	NW		200	4.07
41 S	10 E	14	NW	NW		300	17.90
41 S	10 E	14	SW	NW		300	29.50
41 S	10 E	14	NE	SW	L 3	400	25.30
41 S	10 E	14	NW	SW	L 4	300	11.90

Received
JUL 07 2025
OWRD

TABLE 2

CBU POU BY QQ+TL

PERMIT G-18797

41 S	10 E	14	NW	SE	L 2	400	13.76
41 S	11 E	01	SW	NW		800	4.80
41 S	11 E	01	NW	SW		800	7.00
41 S	11 E	02	NW	NE	L 2	200	27.70
41 S	11 E	02	SW	NE		200	33.80
41 S	11 E	02	SE	NE		100	3.00
41 S	11 E	02	SE	NW		300	5.58
41 S	11 E	02	NE	SW		300	6.20
41 S	11 E	02	NE	SE		600	30.70
41 S	11 E	02	NW	SE		200	9.81
41 S	11 E	02	SW	SE		700	2.50
41 S	11 E	02	SE	SE		700	6.70
41 S	11 E	03	SW	NE		700	7.80
41 S	11 E	03	SE	NE		800	19.70
41 S	11 E	03	SE	NE		900	11.10
41 S	11 E	03	SE	NE		1000	0.80
41 S	11 E	03	NW	NW	L 4	300	2.10
41 S	11 E	03	NE	SE		800	7.10
41 S	11 E	03	NW	SE		700	15.40
41 S	11 E	03	SW	SE		700	2.50
41 S	11 E	04	SE	NE		100	14.00
41 S	11 E	04	NE	NW	L 3	300	10.20
41 S	11 E	04	NW	NW	L 4	400	11.60
41 S	11 E	04	SE	NW		300	9.80
41 S	11 E	04	NE	SW		1500	25.30
41 S	11 E	04	NW	SE		1300	13.40
41 S	11 E	04	NW	SE		1400	3.00
41 S	11 E	04	SE	SE		1900	7.90
41 S	11 E	05	NE	NE	L 1	100	1.50
41 S	11 E	05	NW	NE	L 2	300	4.00
41 S	11 E	05	SW	NW		700	15.50
41 S	11 E	05	NW	SW		700	0.50
41 S	11 E	10	NW	NE		200	3.70
41 S	12 E	03	NW	NE		300	3.42
41 S	12 E	04	SW	NE		300	8.40
41 S	12 E	04	SW	NE		1500	2.00
41 S	12 E	04	NW	NW		500	5.00
41 S	12 E	04	SE	NW		301	10.00
41 S	12 E	06	NE	NW		300	7.70
41 S	12 E	06	NW	NW	L 1	400	2.90
41 S	12 E	09	SW	SE		701	3.00
41 S	12 E	09	SE	SE		701	12.00
41 S	12 E	10	NW	SW		1400	6.90
41 S	12 E	11	SW	NE		900	10.00
41 S	12 E	11	SE	NE		900	14.40
41 S	12 E	11	NE	NW		500	12.20
41 S	12 E	11	SE	NW		800	3.80
41 S	12 E	13	NE	NE		100	6.20
41 S	12 E	13	SE	NE		100	0.60

TOTAL CBU ACRES 8,959.82
TOTAL PERMIT ACRES 8,959.82
DIFFERENCE ACRES 0.00

Received
JUL 07 2025

OWRD