


Received by CWRD
JUL 14 2025
Salem, OR

T23S R32.5E, WM
HARNEY COUNTY, OR



0 1,320 Feet

1" = 1320'

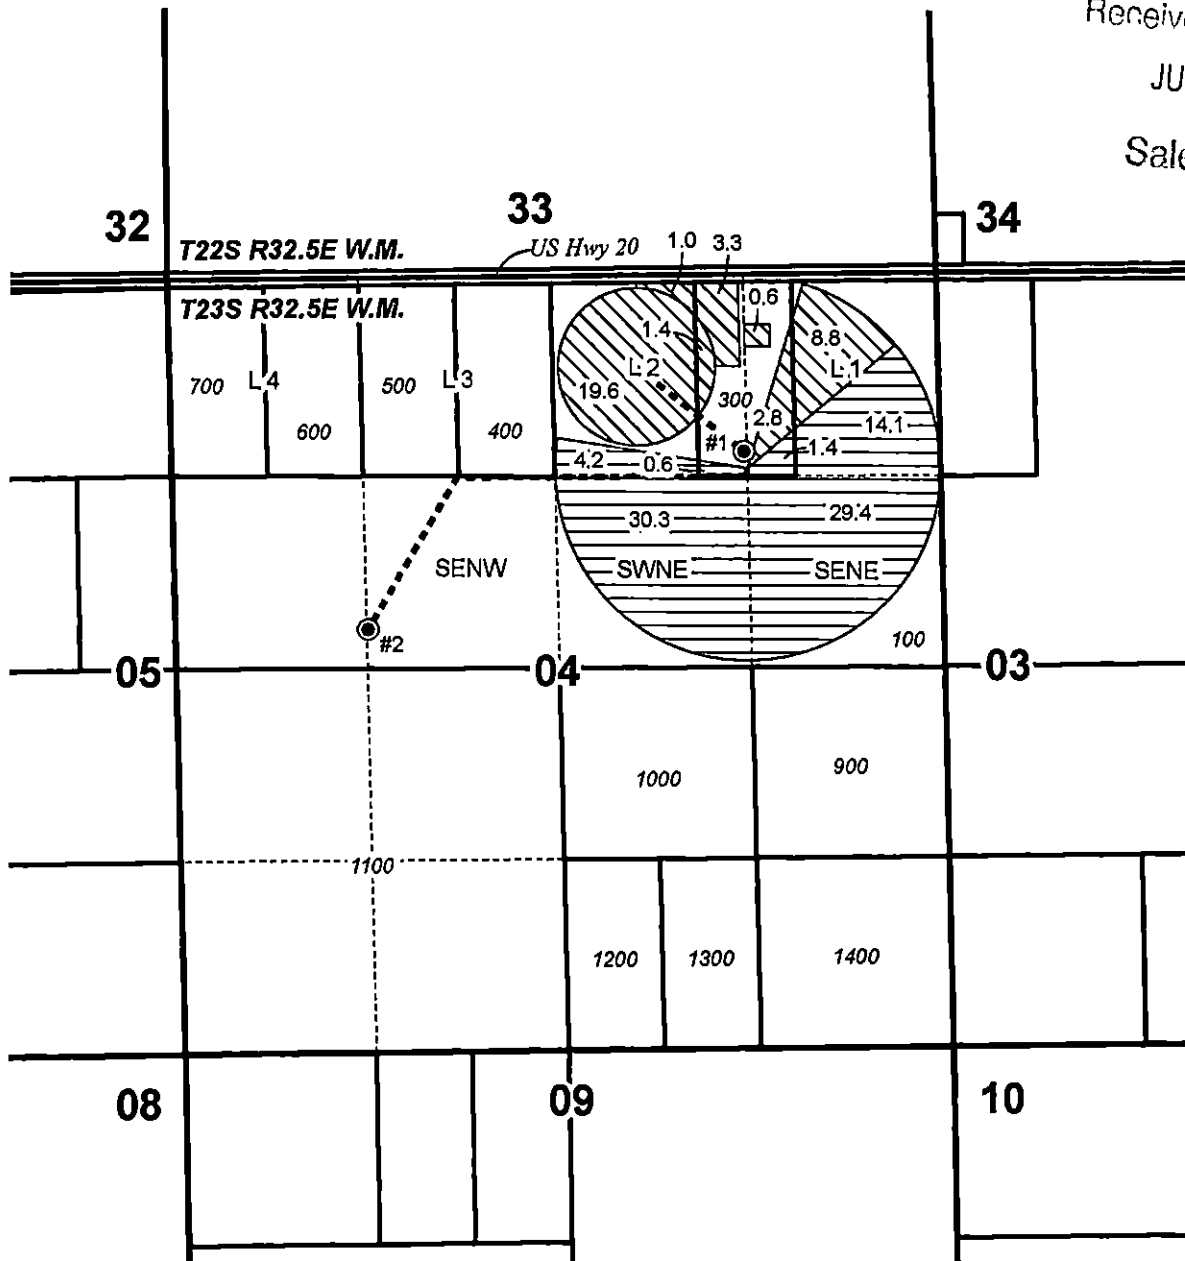

● Well & Meter

----- Pipeline

POU IR 1/8/1981 Priority

POU IR 7/3/1978 Priority

Section

----- Quarter Quarter

□ Tax Lot

Well #1 (HARN 633 & HARN 52426 / L-118172):
1010' S, 1360' W of NE Cor Sec 4

Well #2 (HARN 52924 / L-136139)
270' N, 1320' W of Cen 1/4 Cor Sec 4



RENEWED: 06/30/2026



Claim of Beneficial Use Map
Kirby Isaac

Date: 5/16/2025

T-14153

This map is not intended
to provide legal dimensions
or locations of property
ownership lines.

WATER RIGHT SERVICES, LLC
PO BOX 1830, BEND, OR 97709
WWW.OREGONWATER.US CCB # 197121
johnshort@usa.com 541-389-2837