



Oregon Water Resources Department
725 Summer Street NE, Suite A
Salem, Oregon 97301
(503) 986-0900
www.oregon.gov/OWRD

E-RECEIVED
7/16/2025
OWRD

Ownership Update for Certificated Rights Only

NO FEES ARE REQUIRED TO SUBMIT THIS FORM

NOTICE: A certificate of water right typically stays with the land. To track water right ownership, the Department requests that this form be submitted to the Department. **To update multiple rights, a separate form is required for each right.** If you have any questions about this form, please contact your local watermaster, or call the Water Resources Department at (503) 986-0900.

Note: Use the [assignment](#) form to change ownership on pending applications, permits, transfers, groundwater registrations, or limited licenses.

Current Landowner Information

Name:	MICHAEL AND LAUREL ARMSTRONG				
Mailing Address:	319 Huntley Creek Ln				
City:	ROSEBURG	State:	OR	Zip:	97470
Phone:	831-277-8889	Email:	mldldarmstrong@gmail.com		

Property Information

County:	DOUGLAS	Township:	26S	Range:	4W	Section:	18
Tax Lot #:	34						
Street Address of Water Right:	2749 Whistlers PARK Rd, Roseburg, OR 97470						

Water Right Information

Application:	71130
Permit:	52213
Certificate:	84256
Are all the lands associated with this water right owned by the requestor? <input checked="" type="checkbox"/> Yes <input type="checkbox"/> No	
(If no, include a map showing the portion of the water right involved) -map included	

Signature and Date


Name of individual completing form:	MICHAEL ARMSTRONG		
Phone or email:	831-277-8889	Date:	16 Jul 25
Signature of requestor:			

The Department does not change names on water right certificates. This form will be placed in the file for future reference only. If mailed, the Department will not provide acknowledgment of receipt.

This form can be mailed to the address above or sent by email to wrd_dl_customerservice@water.oregon.gov

CLAIM OF BENEFICIAL USE
IN THE NAME OF
ROBERT W. BISHOP
DIANA D. BISHOP
SURVEYED BY DUANE W. KIRBY

T26S, R4W, W.M.

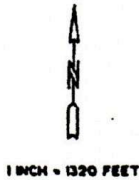

E-RECEIVED


7/16/2025

OWRD

RECEIVED

NOV 28 2001

WATER RESOURCES DEPT.
SALEM, OREGON

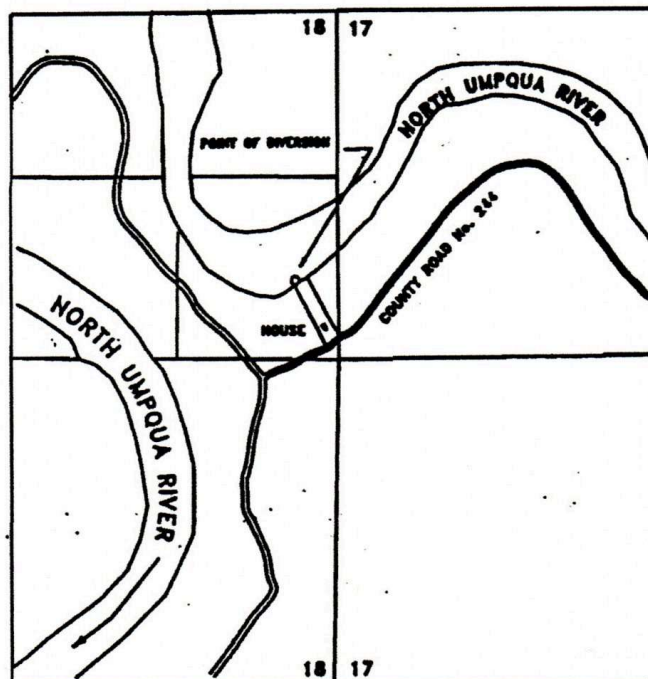

RECEIVED

SEP 27 2000

WATER RESOURCES DEPT.
SALEM, OREGON



THE POINT OF DIVERSION IS TO BE
LOCATED 575 FEET NORTH AND 100 FEET
WEST FROM THE EAST 1/4 CORNER OF
SECTION 18, BEING WITHIN THE SE 1/4 OF
THE NE 1/4 SECTION 18, TOWNSHIP 26
SOUTH, RANGE 4 WEST, W.M.

THE PURPOSE OF THIS MAP IS TO IDENTIFY
THE LOCATION OF THE WATER RIGHT. IT IS NOT
INTENDED TO PROVIDE INFORMATION RELATIVE TO
THE LOCATION OF PROPERTY OWNERSHIP
BOUNDARY LINES.

APPLICATION S-71130

PERMIT 52213