


T.20S. R.3W. Section 26

LANE COUNTY

1" = 500 ft

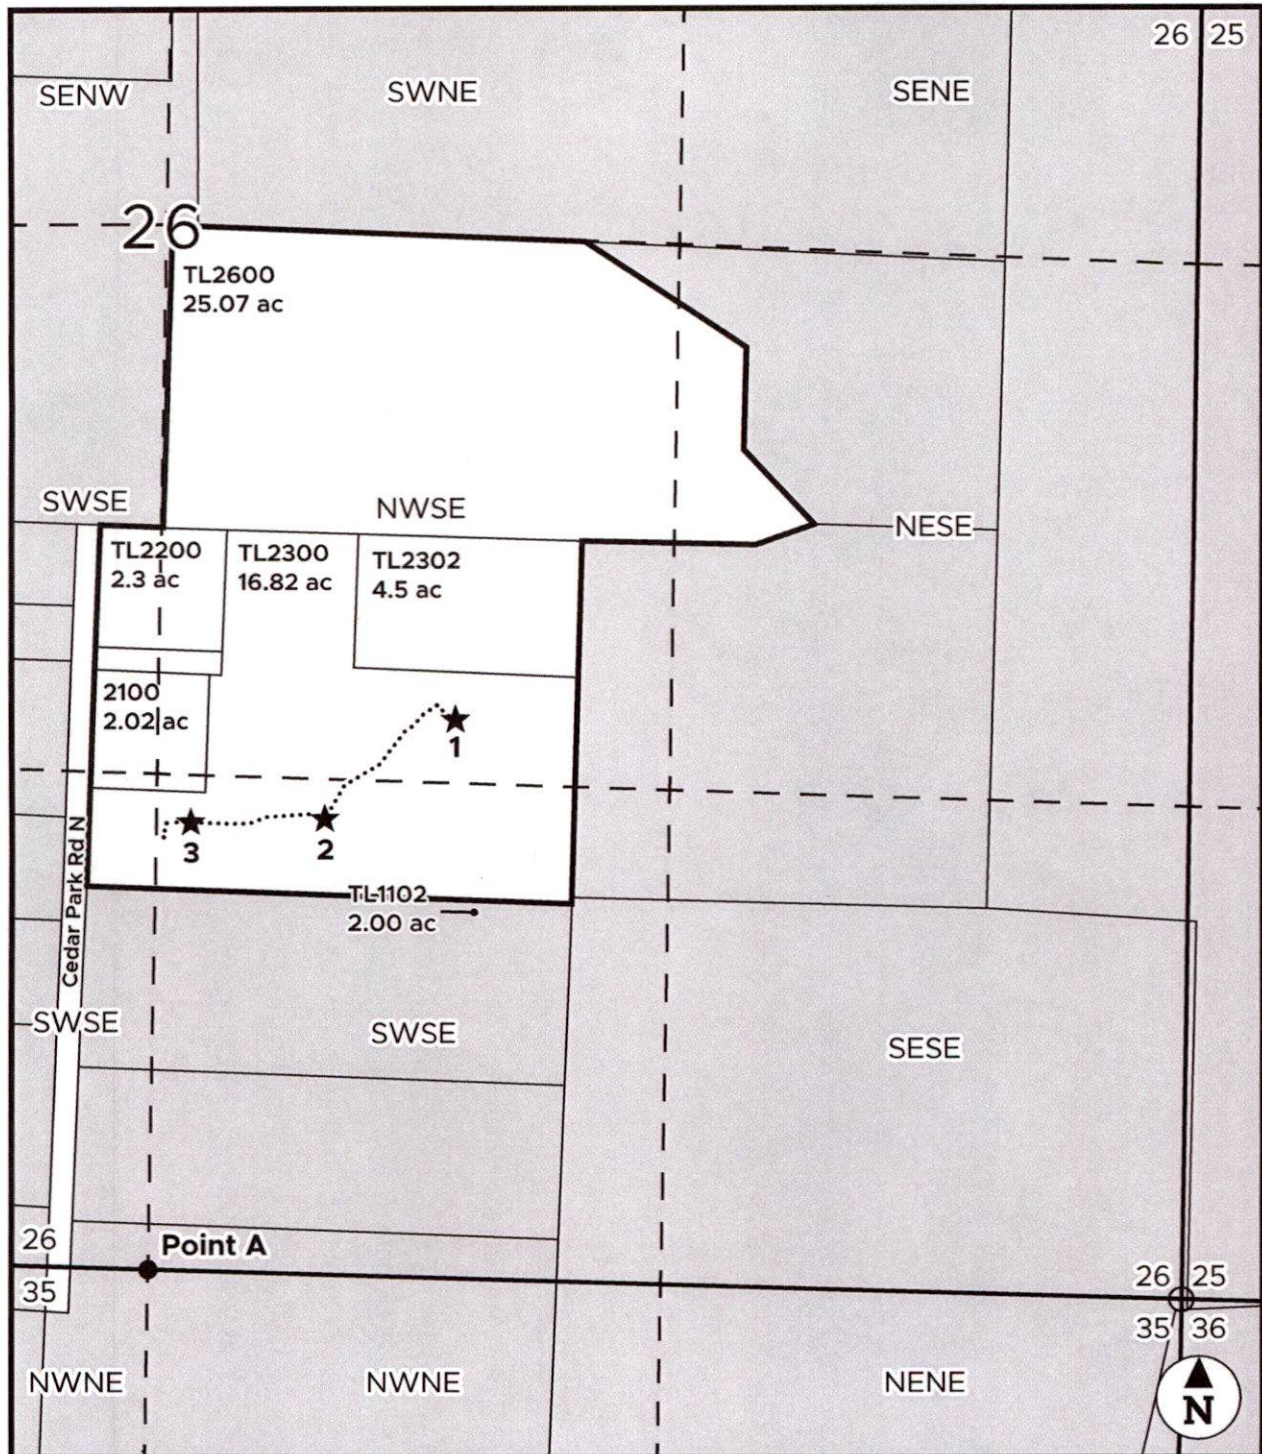

- Point A is the quarter corner between Sections 26 & 35.
- ★ Pond 1 is 1444 ft north and 773 ft east from Point A.
- ★ Pond 2 is 1178 ft north and 438 ft east from Point A.
- ★ Pond 3 is 1160 ft north and 90 ft east from Point A.

Received by OWRD

JUL 14 2025

Salem, OR