


T.13S., R.27E., W.M., GRANT COUNTY, OREGON
CLAIM OF BENEFICIAL USE MAP UNDER TRANSFER NO. T-11271
FOR AUXIER RESOURCES NO. 1, LLC

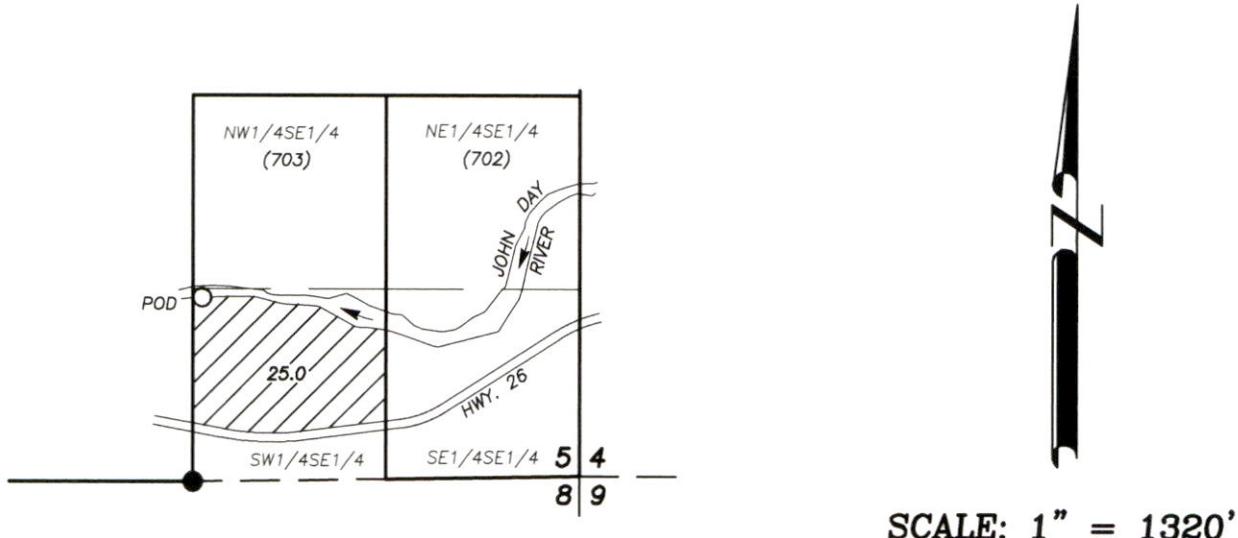

- POD WITH FISH SCREEN: 1270 FT. NORTH & 5 FT. EAST FROM S1/4 CORNER SEC. 5, T.13S., R.27E.
 PUMP BEARS S.16°W., 35 FT. FROM POD
 FLOW METER BEARS S.05°W., 61 FT. FROM POD

PLACE OF USE: PRIORITY DATE: 1900 – 25.0 AC.

TAX LOT NO.

- FOUND ALUMINUM MONUMENT AT THE S1/4 CORNER SECTION 5, T.13S., R.27E., W.M.

PREPARED BY:

ROBERT D. BAGETT, PLS, CWRE
 217 N. CANYON BLVD.
 JOHN DAY, OREGON
 (541) 620-0717
 (541) 575-1251
 FEBRUARY 5, 2025

Received
 JUL 17 2025
 OWRD



RENEWS 12/31/2025

DISCLAIMER: THIS MAP IS NOT INTENDED TO PROVIDE LEGAL DIMENSIONS OR LOCATIONS OF PROPERTY OWNERSHIP LINES.