


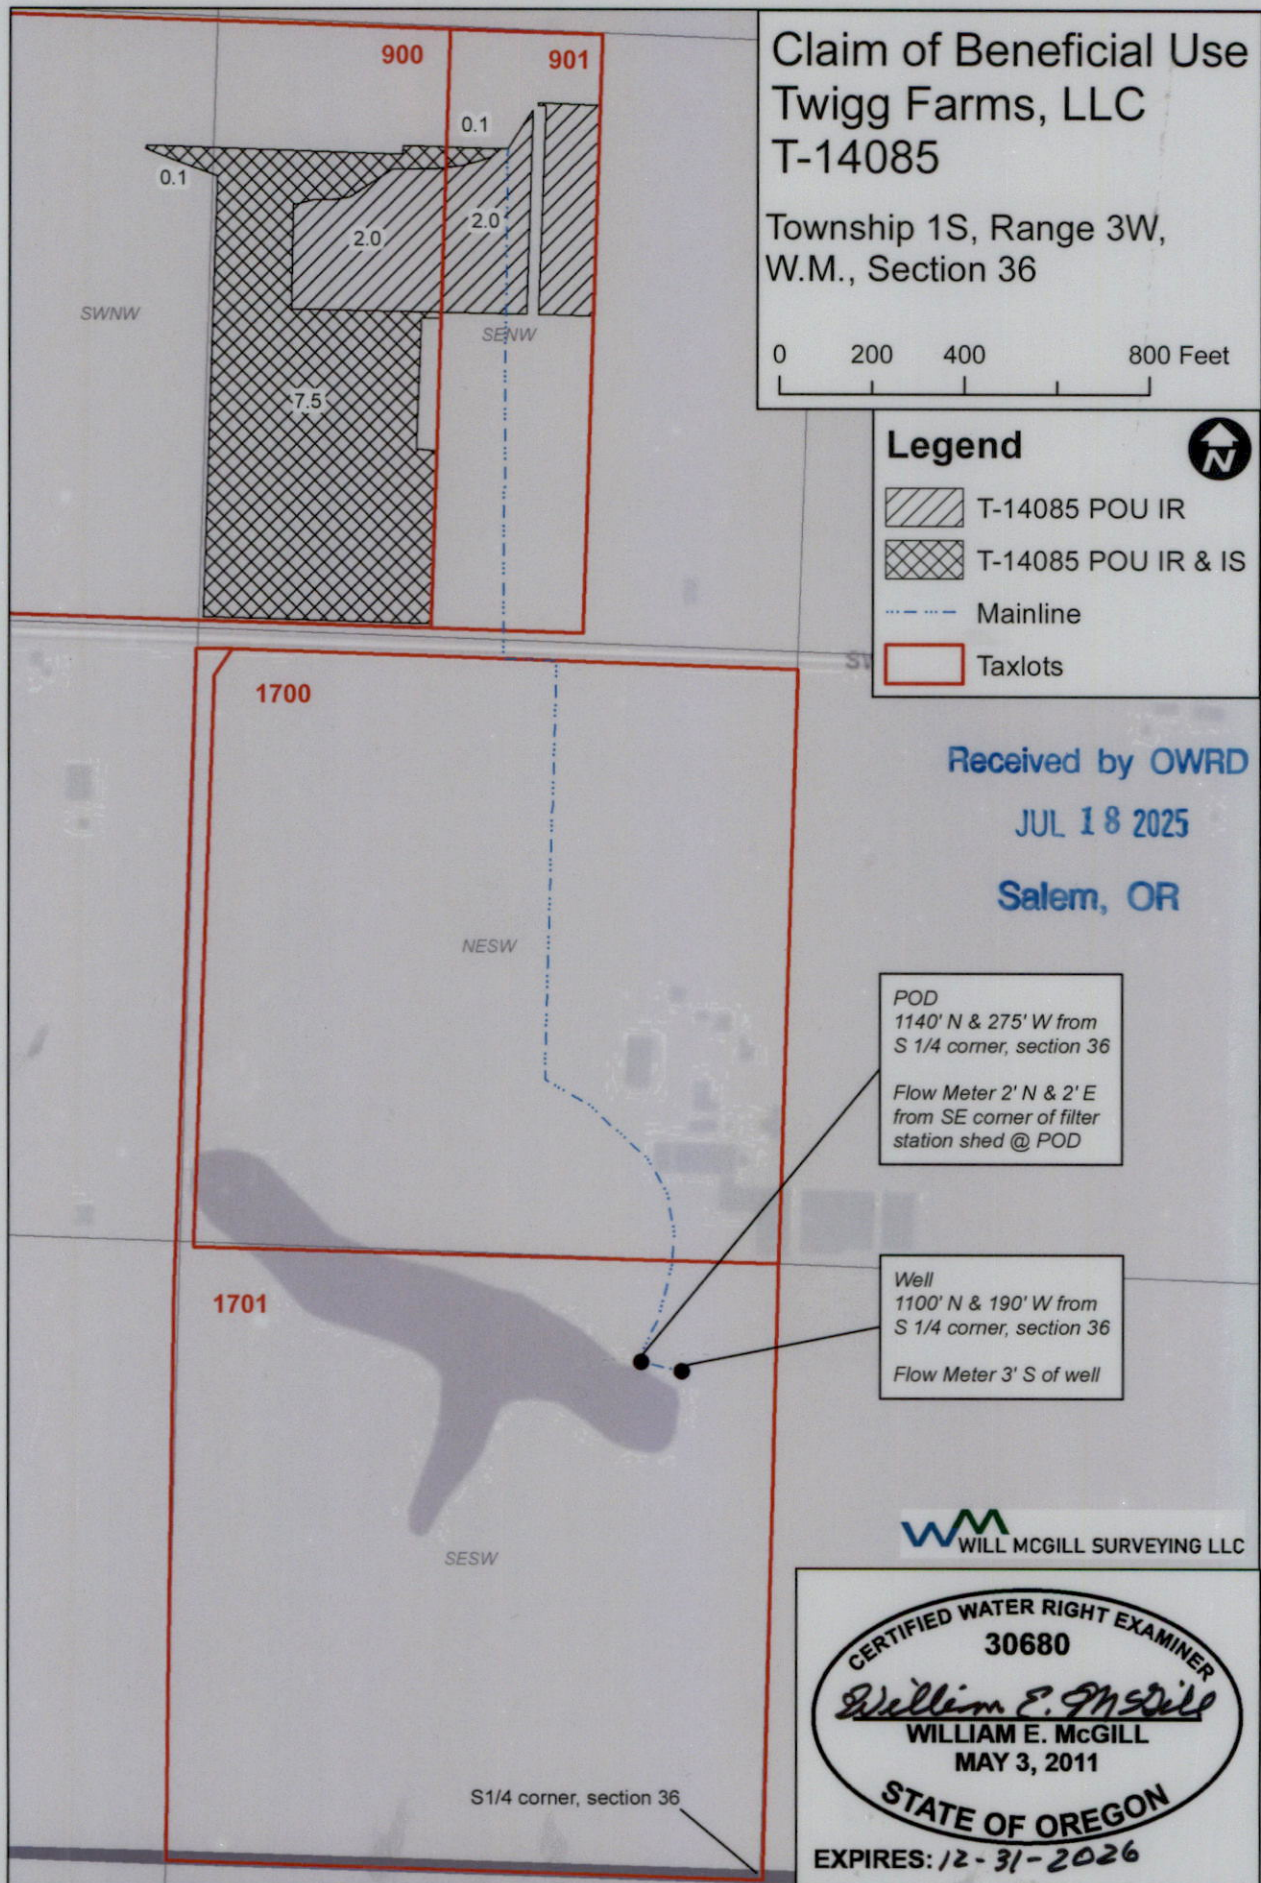

This map is not intended to provide legal dimensions or locations of property ownership lines.