


T6S, R4W, SECTIONS 23, TAX LOTS 200+300+900, W.M.
POLK COUNTY

T6S, R4W, SECTIONS 23, TAX LOTS 200+300+900, W.M.
POLK COUNTY

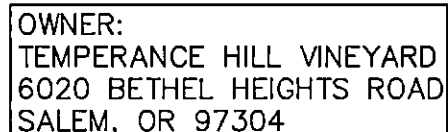

JUL 15 2025

Salem, OR

NW CORNER DLC 50 PHILLIPS

POA	TWP	RNG	SEC	Q-Q	TL	MEASURED DISTANCE
WELL	6S	4W	23	SE NE	900	178'S AND 15'E FROM SW CORNER OF THE NE 1/4, NE 1/4 OF SECTION 23

PRIMARY IRRIGATION
APP G-13820
PERMIT G-15777
111.6 ACRES (144.7 PERMITTED)

LEGEND

SECTION LINE

1/4 1/4 LINE

DLC LINE

PROPERTY LINE

WELL

SECTION CORNER

DLC CORNER


3" DIA. PVC
BURIED IRR. MAIN

PLACE OF USE							
TWP	RNG	SEC	Q-Q	TL	LOT	DLC	AC
6S	4W	23	NW NE	200	-	-	29.8
6S	4W	23	SW NE	900	-	-	0.0
6S	4W	23	SE NE	900	-	-	25.7
6S	4W	23	NE NW	300	-	-	29.4
6S	4W	23	NW NW	300	-	-	21.6
6S	4W	22	NE NE	300	-	-	5.1
TOTAL ACRES							111.6

NOTE: THIS MAP IS PRODUCED TO APPLY FOR THE BENEFICIAL USE OF A WATER RIGHT. IT IS NOT INTENDED TO PROVIDE INFORMATION RELATIVE TO THE LOCATION OF PROPERTY LINES.

**BLUNDON
ENGINEERING, LLC**

PO BOX 786
HILLSBORO, OREGON 97123
541-510-5910
NICK@BLUNDONENGINEERING.COM

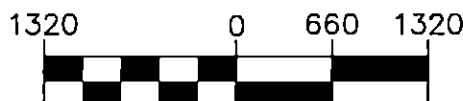

1 inch = 1320ft.
PRINT SCALE=8.5"x11"

Certified Water Right Examiner
#83725

Nicholas H. Blunden

NICHOLAS GORDON BLUNDON
MAY 14. 2019

STATE OF OREGON

EXPIRES 12/31/2025