


LEGEND	
DESCRIPTION	SYMBOLS
SECTION CORNER	
RECOGNIZED SURVEY CORNER	
POINT OF APPROPRIATION	
SECTION LINE	
QUARTER-QUARTER LINE	
TAX LOT LINE	
RIGHT OF WAY	
CANAL	
IRRIGATED AREA	
0.04 ACRES	
APPLICATION No. G-18781	
PERMIT No. G-18248	

POINT OF APPROPRIATION LOCATION:

WELL #1: 835' SOUTH & 890' WEST OF THE NE CORNER OF SECTION 23 T. 20 S., R. 46 E., W.M.

Received  
JUL 18 2025  
OWRD

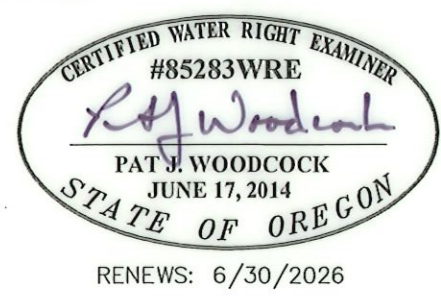

DISCLAIMER:  
THIS MAP WAS MADE TO BE A PART OF THE CLAIM OF BENEFICIAL USE FOR A WATER RIGHT. SECTIONAL LINES SHOWN ARE APPROXIMATE AND THIS MAP IS NOT INTENDED FOR ANY OTHER USE AND DOES NOT GUARANTEE LAND OWNERSHIP.

Reviewed By: PAT J. WOODCOCK  
Drawn By: PJW  
Print Date: June 16, 2025  
DWG. Scale: AS SHOWN

**CLAIM OF BENEFICIAL USE MAP**  
PERMIT No. G-18248  
SEC. 23, T. 20 S., R. 46 E. W.M.  
MALHEUR COUNTY, OREGON

**ENGINEERING NORTHWEST, LLC**  
11 NW 9th Street  
Ontario, Oregon 97914  
www.engineeringnw.com (541)889-4432

**W1**  
SHEET NO. 1 OF 1  
JOB NO. 25-056