

10 11
15 14

LOCATED IN
SECTION 15; T4S R15E W.M.
SHERMAN COUNTY, OREGON
CLAIM OF BENEFICIAL USE MAP

TAX LOT 2200
TAX MAP 04S15E

APPLICATION G-17133
PERMIT G-16729

CWRE STATEMENT

THIS MAP IS NOT INTENDED TO PROVIDE LEGAL DIMENSIONS OF
LOCATIONS OF PROPERTY OWNERSHIP LINES.

MAP INFORMATION


COORDINATE SYSTEM: STATE PLANE OREGON NORTH ZONE 3601
DATUM: NORTH AMERICAN DATUM OF 1983

DATA SOURCES

TAX LOT AND ROAD: SHERMAN COUNTY GIS
SECTION LINEWORK: SHERMAN COUNTY GIS

PREPARED FOR

SKORO RANCH, LLC
11390 SE 222ND DR, DAMASCUS, OR 97089

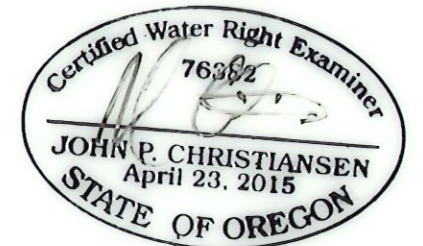

Received
JUL 21 2025
OWRD

LEGEND

POINT OF APPROPRIATION (POA)
858' s & 1082' W. OF E $\frac{1}{4}$ COR. SEC. 15


DAM
986' S. & 1670' W. OF E $\frac{1}{4}$ COR. SEC. 15

TAX LOT BOUNDARY


1/4 1/4 SECTION LINE

SECTION LINE

SKORO RESERVOIR 1
26.6 ACRE-FEET

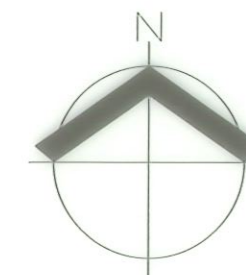

SCALE: 1" = 400 FEET

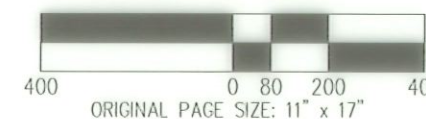

DATE: 08/28/2024

CLAIM OF BENEFICIAL USE MAP

SKORO RANCH, LLC WATER RIGHTS

AKS ENGINEERING & FORESTRY, LLC
12965 SW HERMAN RD, STE 100
TUALATIN, OR 97062
503.563.6151 WWW.AKS-ENG.COM



EXHIBIT

A

DRWN: BGZ

CHKD: SRR

AKS JOB:

11190