


OWRD

JUL 21 2025



04 1W 09

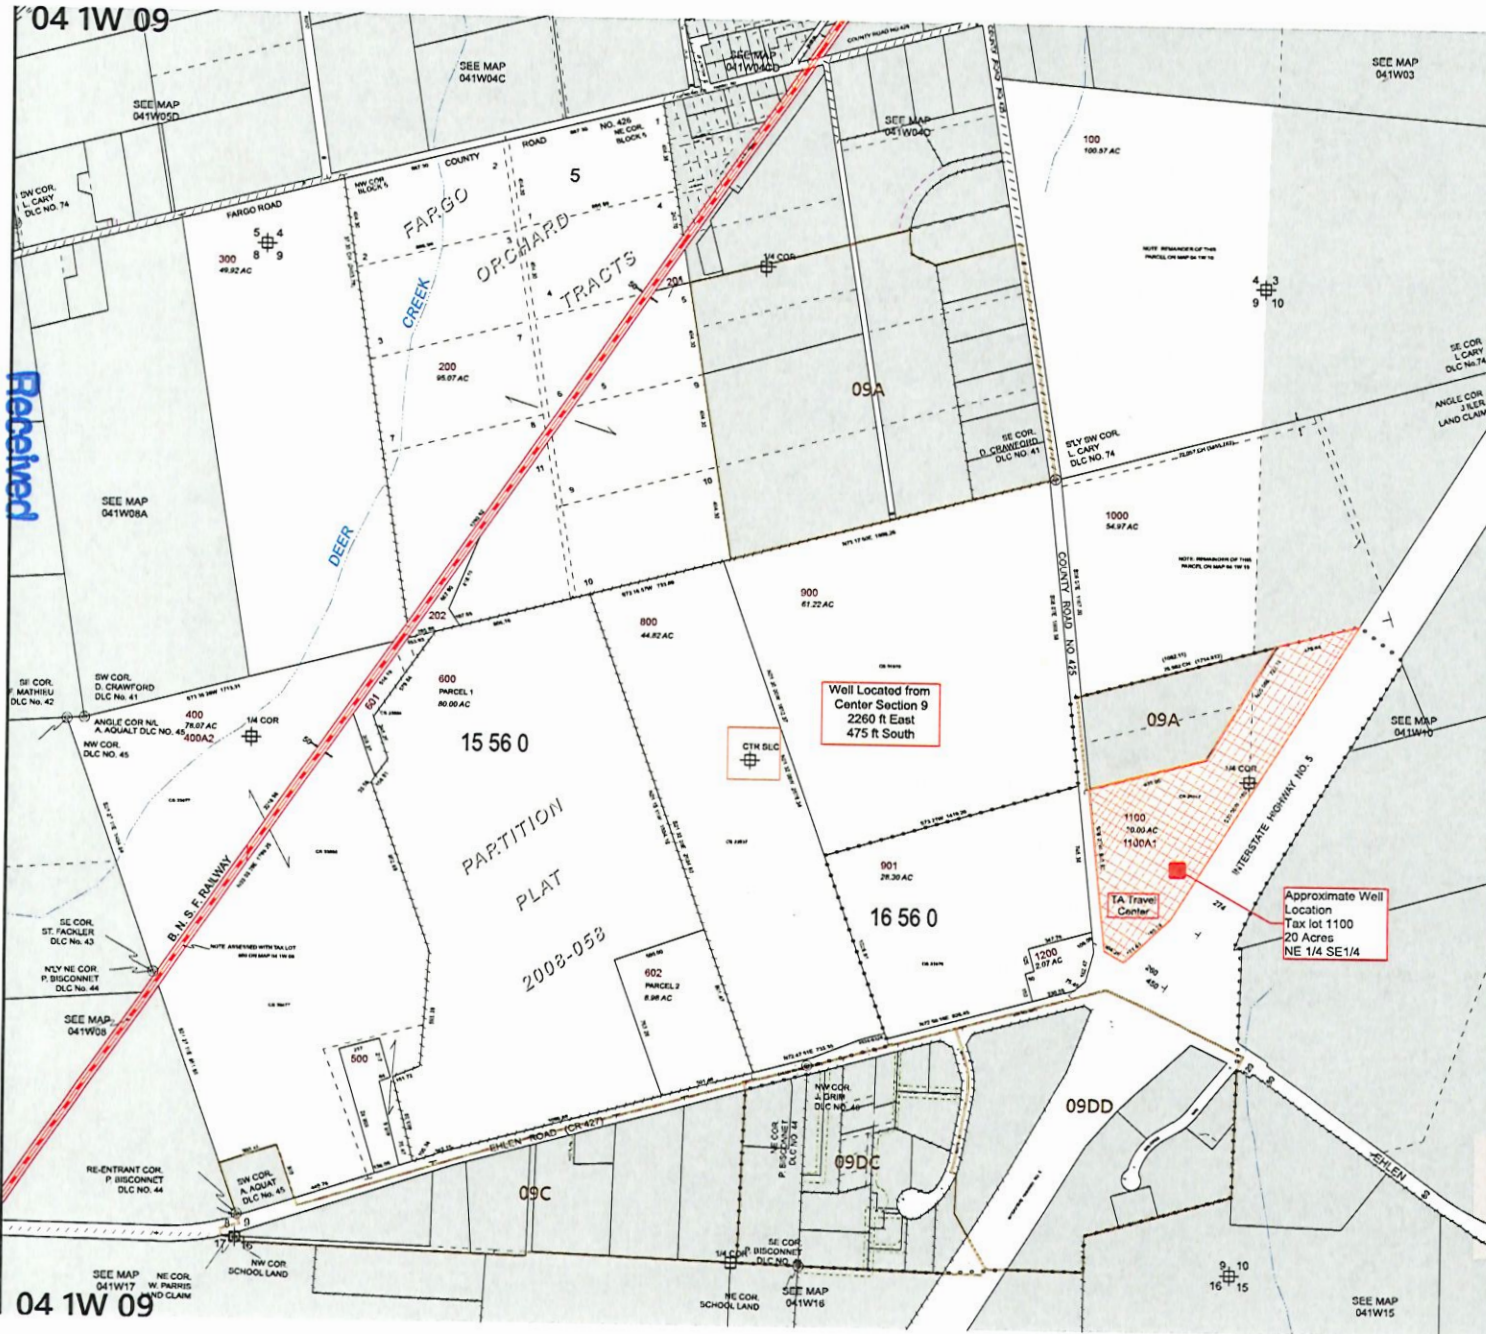

MARION COUNTY, OREGON  
SEC 9 T4S R1W W.M.  
SCALE 1" = 400'

LEGEND

- LINE TYPES
- Taxlot Boundary
  - Road Right-of-Way
  - Railroad Right-of-Way
  - Private Road ROW
  - Subdivision/Plat Bndry
  - Waterline - Taxlot Bndry
  - Historical Boundary
  - Easement
  - Railroad Centerline
  - Taxcode Line
  - Map Boundary
  - Waterline - Non Bndry

- CORNER TYPES
- + 1/16TH Section Cor
  - ⊙ DLC Corner
  - ⊕ 1/4 Section Cor
  - ⊕ 16 15 Section Corner
  - ⊕ 21 22

- NUMBERS
- Tax Code Number  
00 00 0
- Acreage  
8.29 AC
- All acres listed are Net Acres, excluding any portions of the taxlot within public ROWs.


NOTES

Tick Marks: A tick mark in the road indicates that the labeled dimension extends into the public ROW

CANCELLED NUMBERS

409A2	
401	
700	
1100A2	

DISCLAIMER: THIS MAP WAS PREPARED FOR ASSESSMENT PURPOSES ONLY

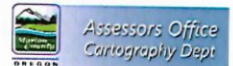

FOR ADDITIONAL MAPS VISIT OUR WEBSITE AT  
[www.co.marion.oregon.us](http://www.co.marion.oregon.us)

PLOT DATE: 1/28/2022

04 1W 09

LL-2014