


TOWNSHIP 21 SOUTH, RANGE 3 EAST, W.M.

McFARLAND ROAD

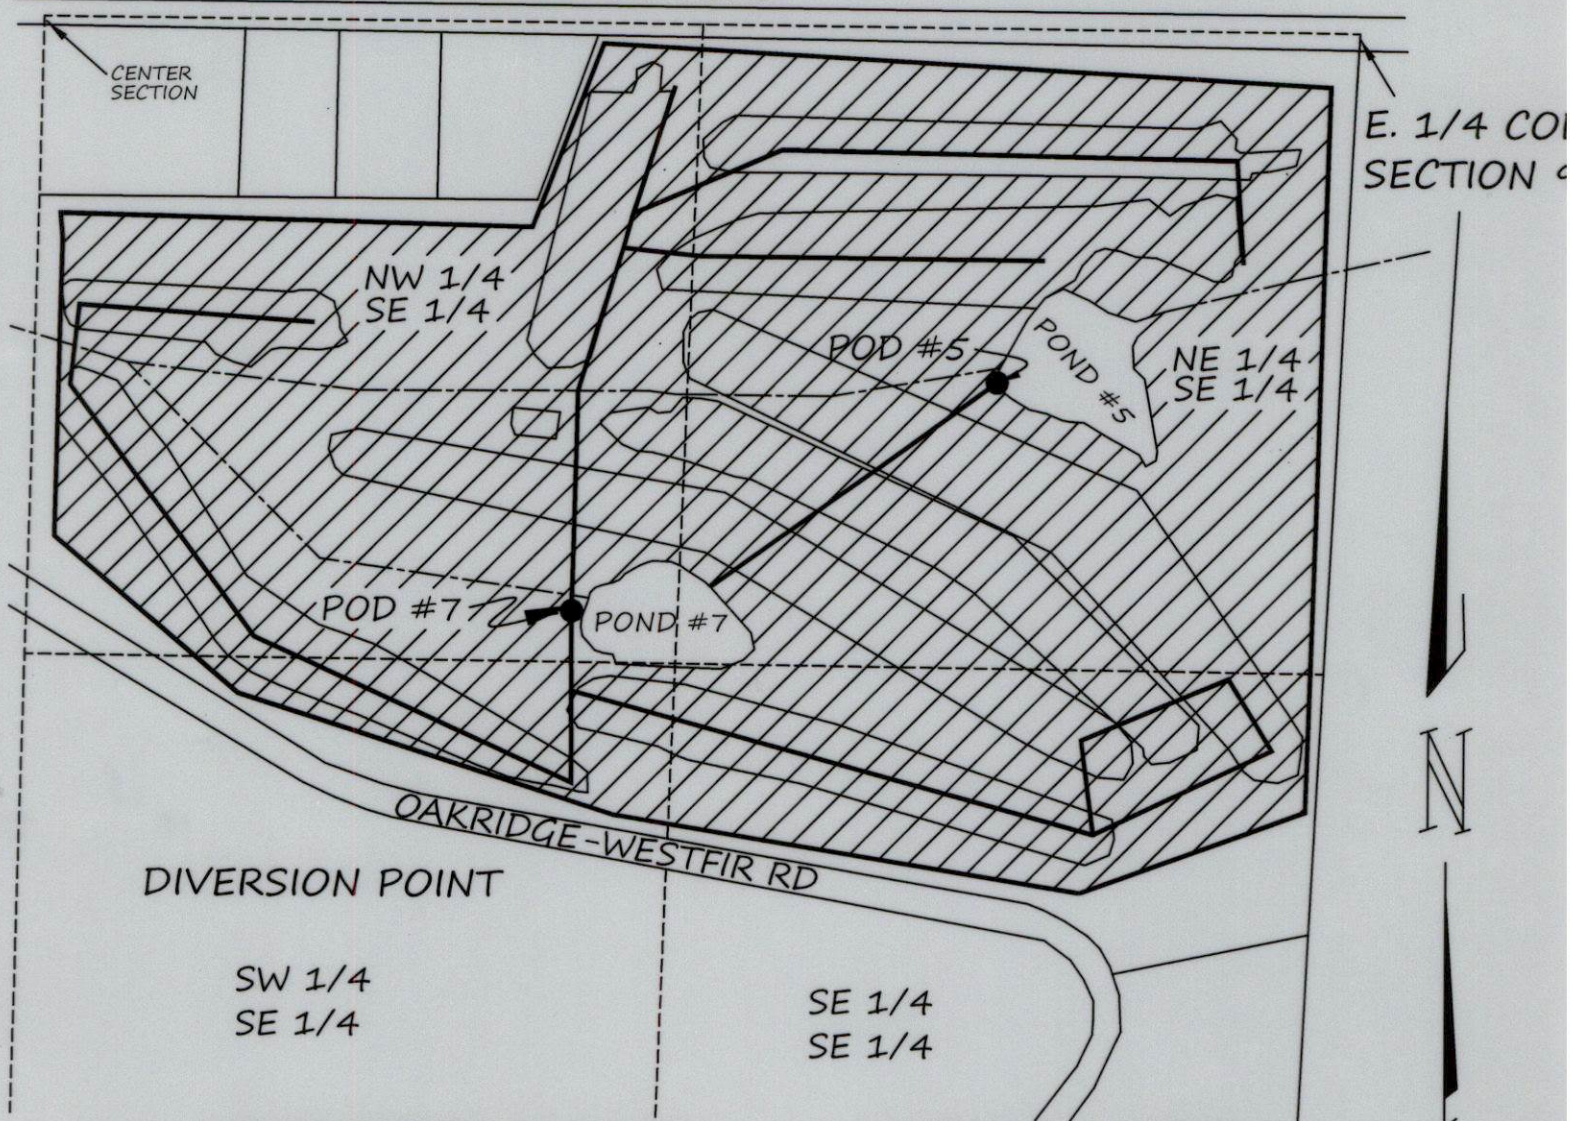

APPLICATION S-84978

PERMIT S-53859

SCALE
1" = 400'

AREA OF BENEFICIAL USE

DENOTES BURIED IRRIGATION
LINE LOCATION

DENOTES McCLANE CK

POD #7

DIVERSION POINT IS LOCATED 1202.21'
SOUTH & 1586.68' WEST OF THE WEST
1/4 COR. SEC. 9, METER AT SAME LOCTION.

POD #5

DIVERSION POINT IS LOCATED 1202.21'
S46°01'09"W 1047' FROM E1/4 COR. SEC. 9
METER AT SAME LOCATION.

THIS MAP WAS PREPARED FOR THE PURPOSE
OF IDENTIFYING THE LOCATION OF THE WATER
RIGHT ONLY. IT IS NOT INTENDED TO PROVIDE
DIMENSIONS OR LOCATION OF PROPERTY
OWNERSHIP LINES.

ALL LOCATED WITHIN TAX MAP NO.
21-35-09-40 TAX LOT 100

CLAIM OF BENEFICIAL USE MAP
FOR

CIRCLE BAR GOLF CLUB

PO BOX 214

OAKRIDGE, OR 97463

BY

H. TIMOTHY FASSBENDER, PLS, CWRE

2896 SARAH LANE

EUGENE, OR 97408

JULY 7, 2025


ACRES

NW 1/4 = 27.90
SE 1/4 = 27.90

NE 1/4 = 37.12
SE 1/4 = 37.12

SW 1/4 = 5.62
SE 1/4 = 5.62

SE 1/4 = 11.86
SE 1/4 = 11.86

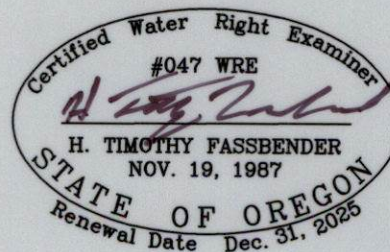

Received

JUL 25 2025

OWRD