


SEC.17 T.26S. R.4W. W.M.
DOUGLAS COUNTY
Scale 1" = 600'

Received
JUL 28 2025

Application Map

OWRD

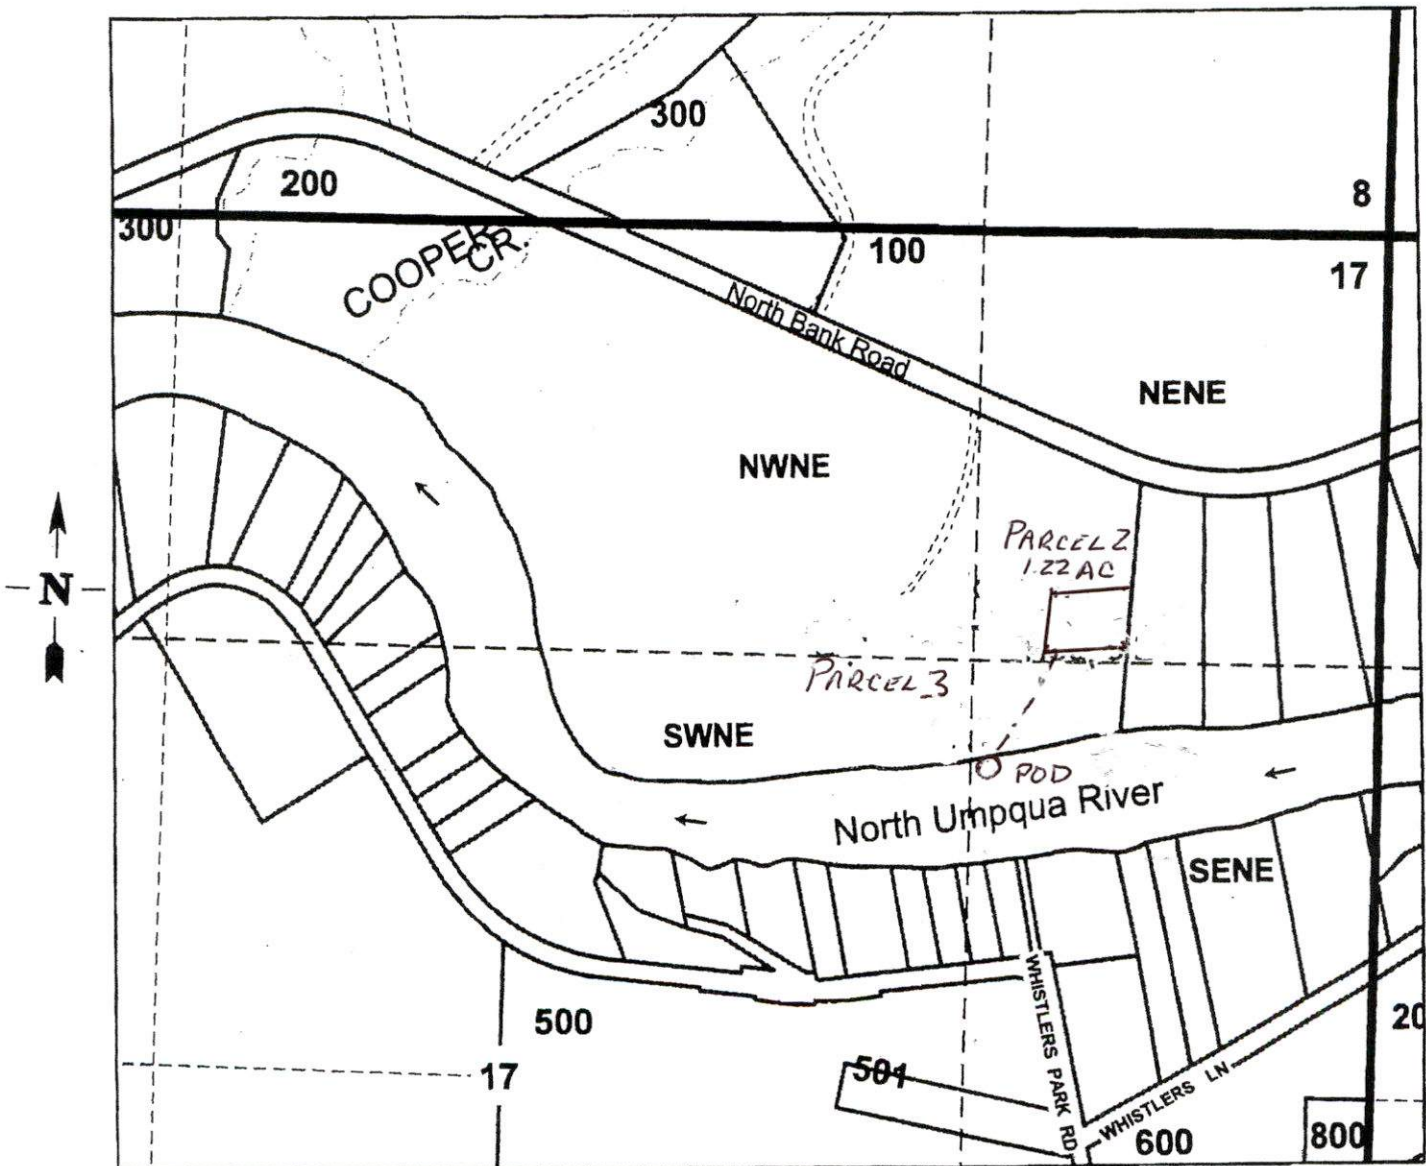

PIPE - - - -

Point of Diversion is 1670 ft. South and 1200 ft. West from the NE Corner of Section 17

S-87685