

Name GARY OLIVER WEYTHMAN
 By _____
 Address Rt. 1, Box ~~100~~ 62
Baker, Oregon 97814

Date filed June 12, 1970
 Priority June 12, 1970
 Action suspended until OK Cert

Returned to applicant _____
 Date of approval November 27, 1972

CONSTRUCTION

Date for beginning November 27, 1973
 Date for completion October 1, 1974
 Extended to _____

Date for application of water October 1, 1975
 Extended to _____

PROSECUTION OF WORK

Form "A" filed _____
 Form "B" filed _____
 Form "C" filed completed

FINAL PROOF

Blank mailed APR 20 1973
 Proof received _____
 Date certificate issued JUL 5 1973

Application No. G G 5215
 Permit No. G G 5003
 Certificate No. 39252

Stream Index, Page No. 9-46

*No Log -> BAKER 52637 created
 (4/15/2019 11:26)*

FEES PAID

Date	Amount	Receipt No.
<u>6/12/70</u>	<u>20.00</u>	<u>19259</u>
<u>5-9-73</u>	<u>\$1.50</u>	<u>33721</u>
	<u>Cert. Fee</u>	

FEES REFUNDED

Date	Amount	Check No.


ASSIGNMENTS

Date	To Whom	Address	Volume	Page

REMARKS

0.09 cfs from a well for the irrigation of 6.73 acres, and shall
be further limited to appropriation of water only to the extent
that it does not impair or substantially interfere with exist-
ing surface water rights of others

T.9S.R.39E.W.M.

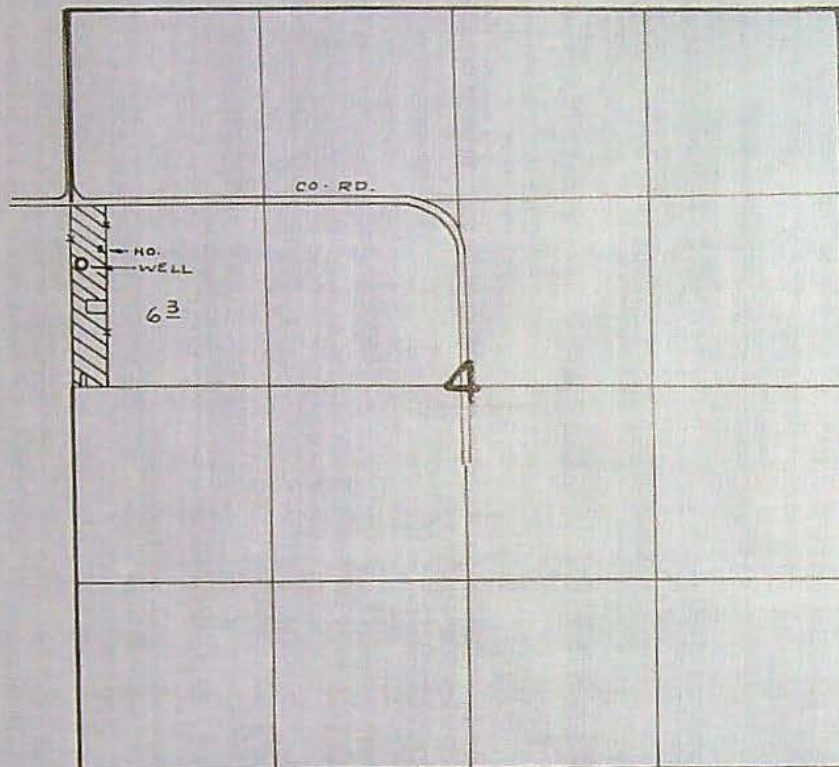

WELL LOC: 420'S. & 70'E. FROM N.W. COR. SW 1/4 NW 1/4 SEC. 4

FINAL PROOF SURVEY
UNDER

Application No. G-5215 Permit No. G-5003
IN NAME OF

GARY OLIVER WEYTHMAN

Surveyed OCT. 18, 1972, by R. MUCKEN