



# Polk County Map

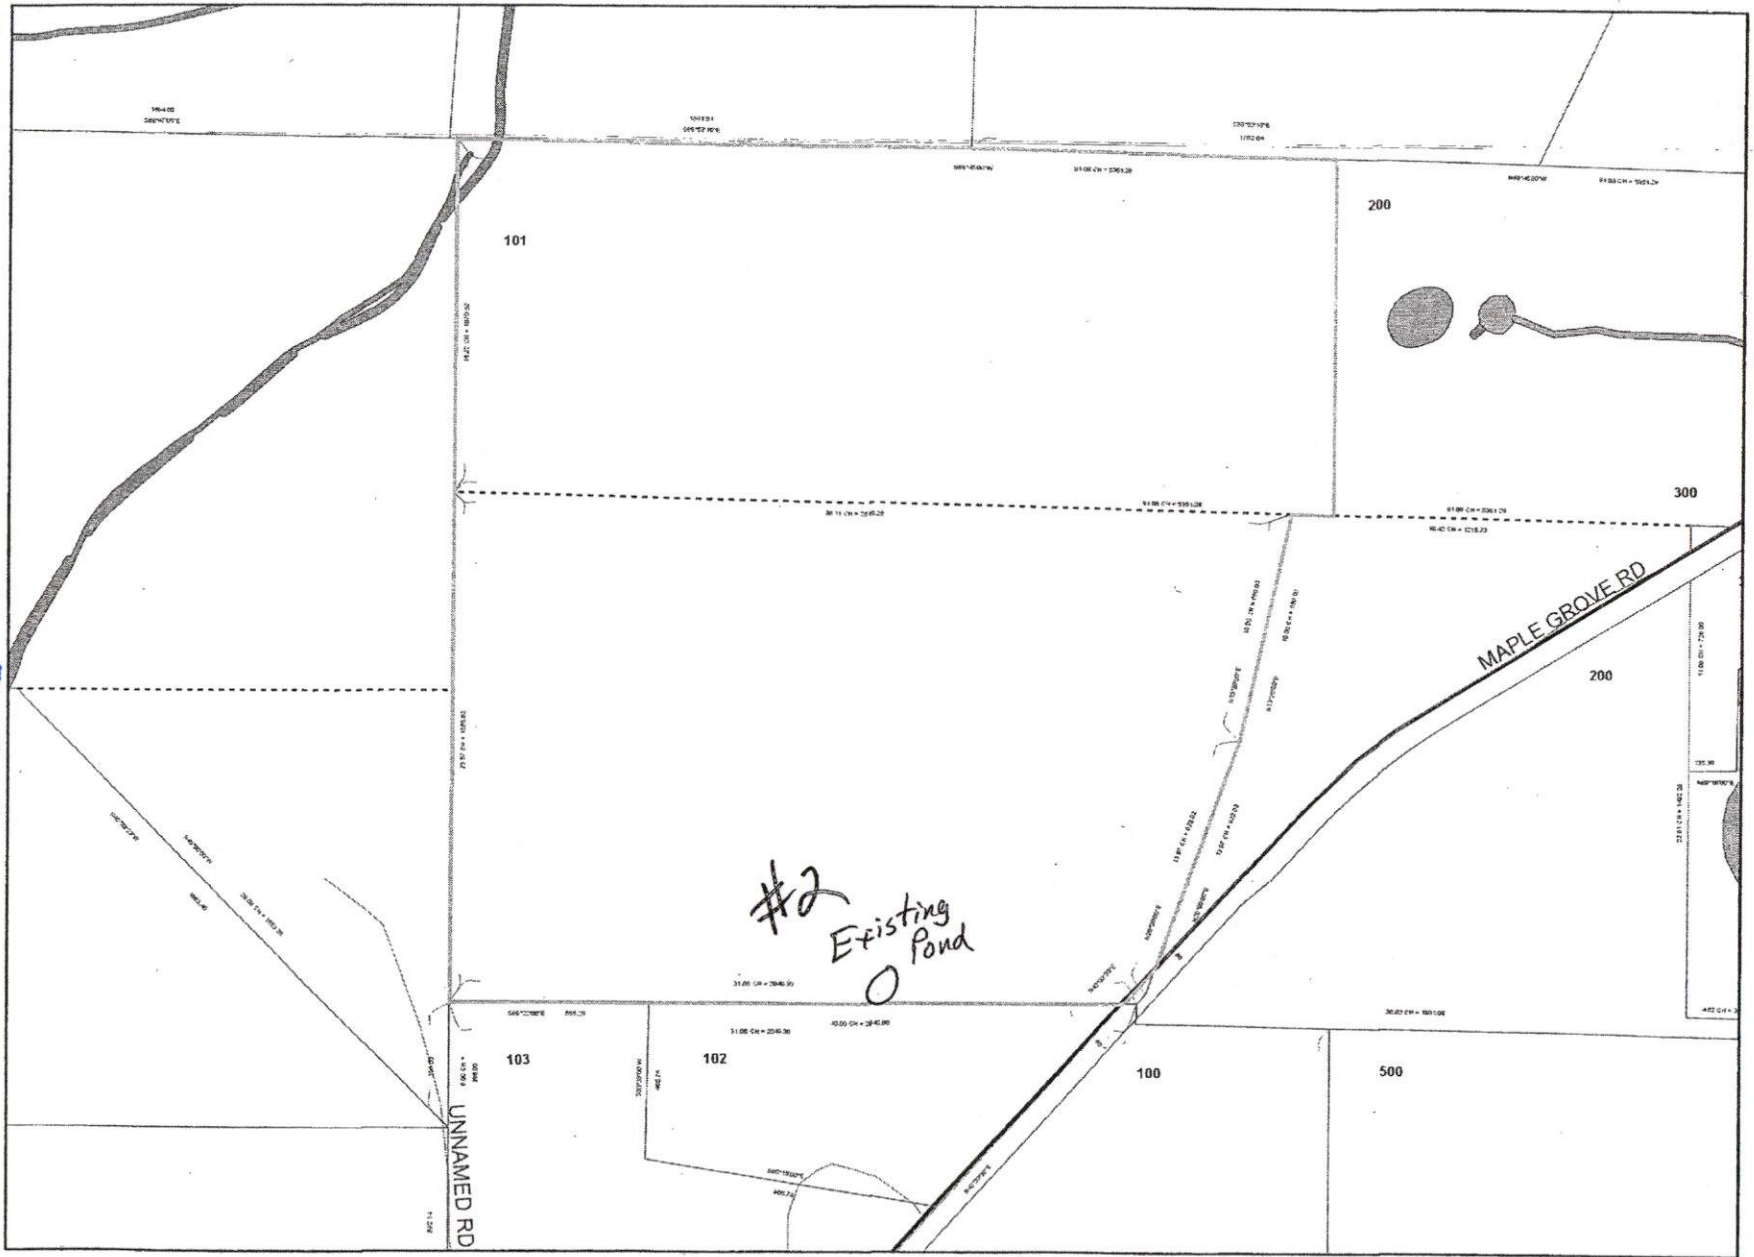

Received  
AUG 15 2025  
OWRD

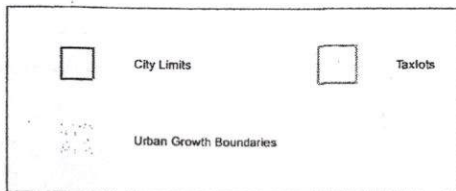

RECEIVED  
AUG 29 2019  
OWRD

Date: 7/29/2019

This map was produced from the Polk County geographic databases to support its governmental activities. This product is for informational purposes and may not have been prepared for, or be suitable for legal, engineering, or surveying purposes. The county is not responsible for any map errors, possible misuse, or misinterpretation. To report a map error, please call (503)623-0713.

Robertson Map

1" = 1320'


Tax Lot:

Township 9 South, Range 6 West, Section 23 &amp; 24, Tax Lot 101 &amp; 200

RECEIVED

AUG 29 2019

OWRD

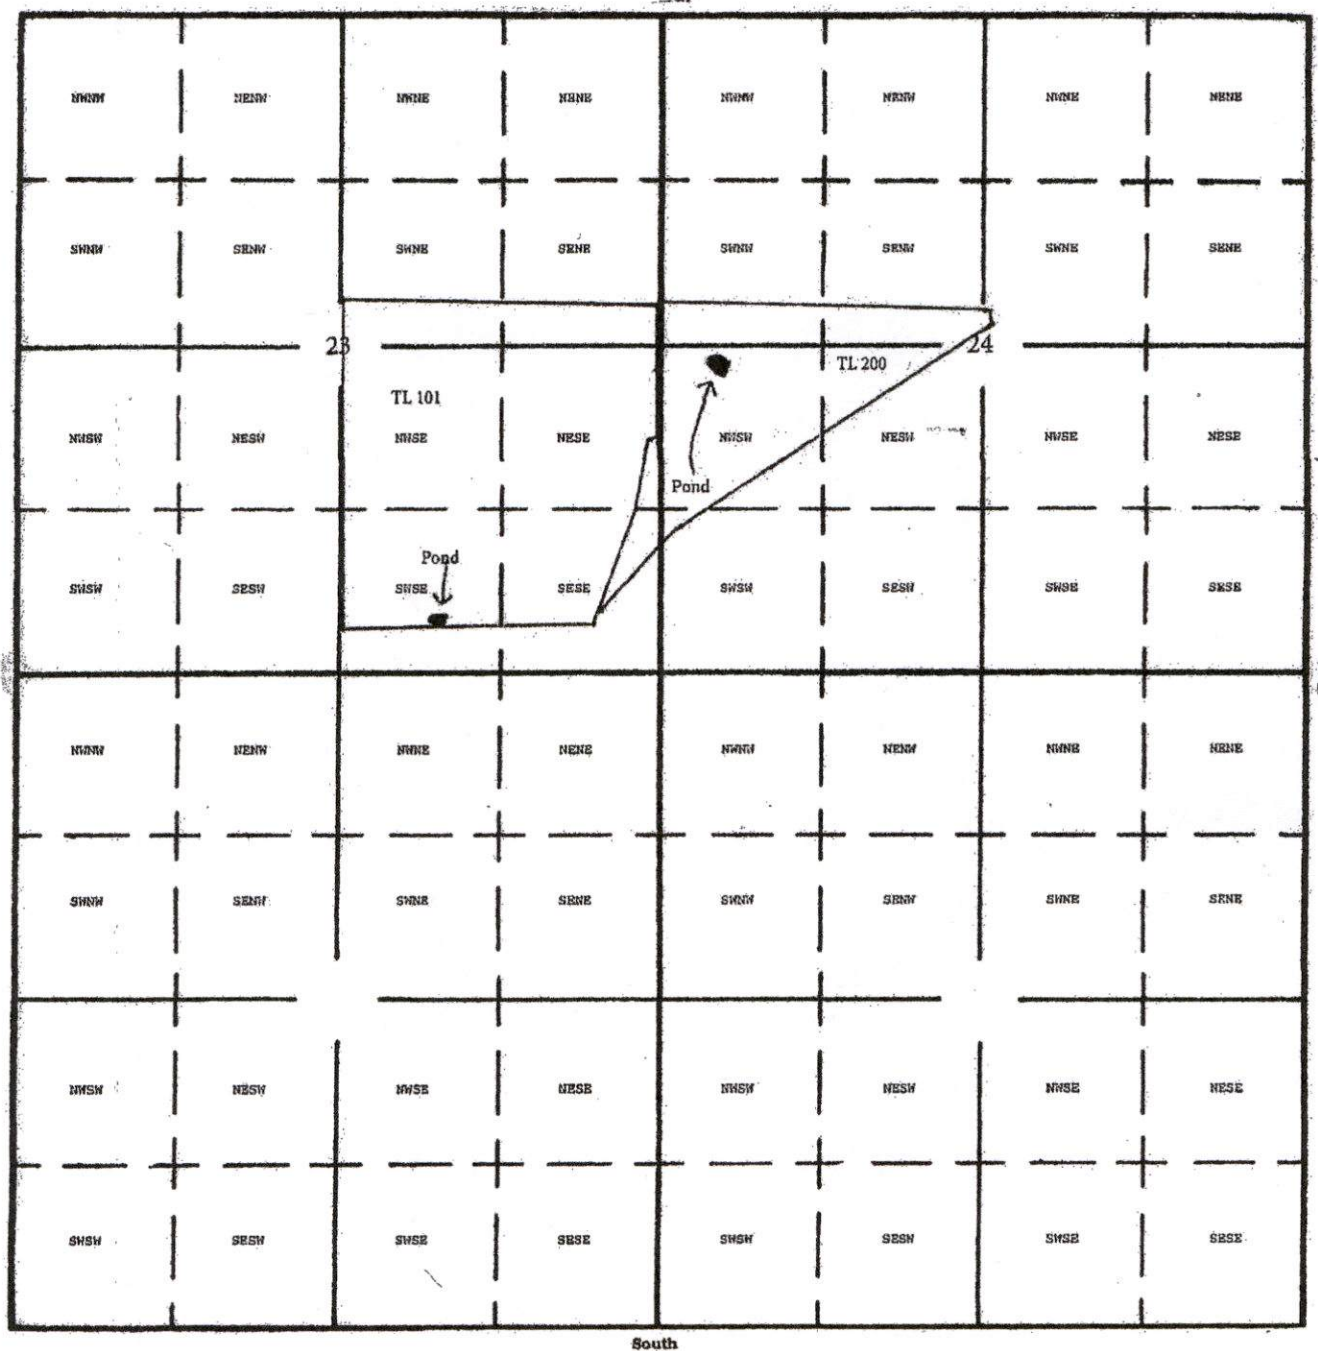

Dam: 405 North & 1725 West from SE Corner Section 23  
 Dam: 2,400 North & 525 East from SW Corner Section 24

Received  
 AUG 15 2025

OWRD

*James Robertson*  
 08-01-2019