E-RECEIVED
AUG 21 2025
OWRD

Property Location
1N 3W 12 Lot 702

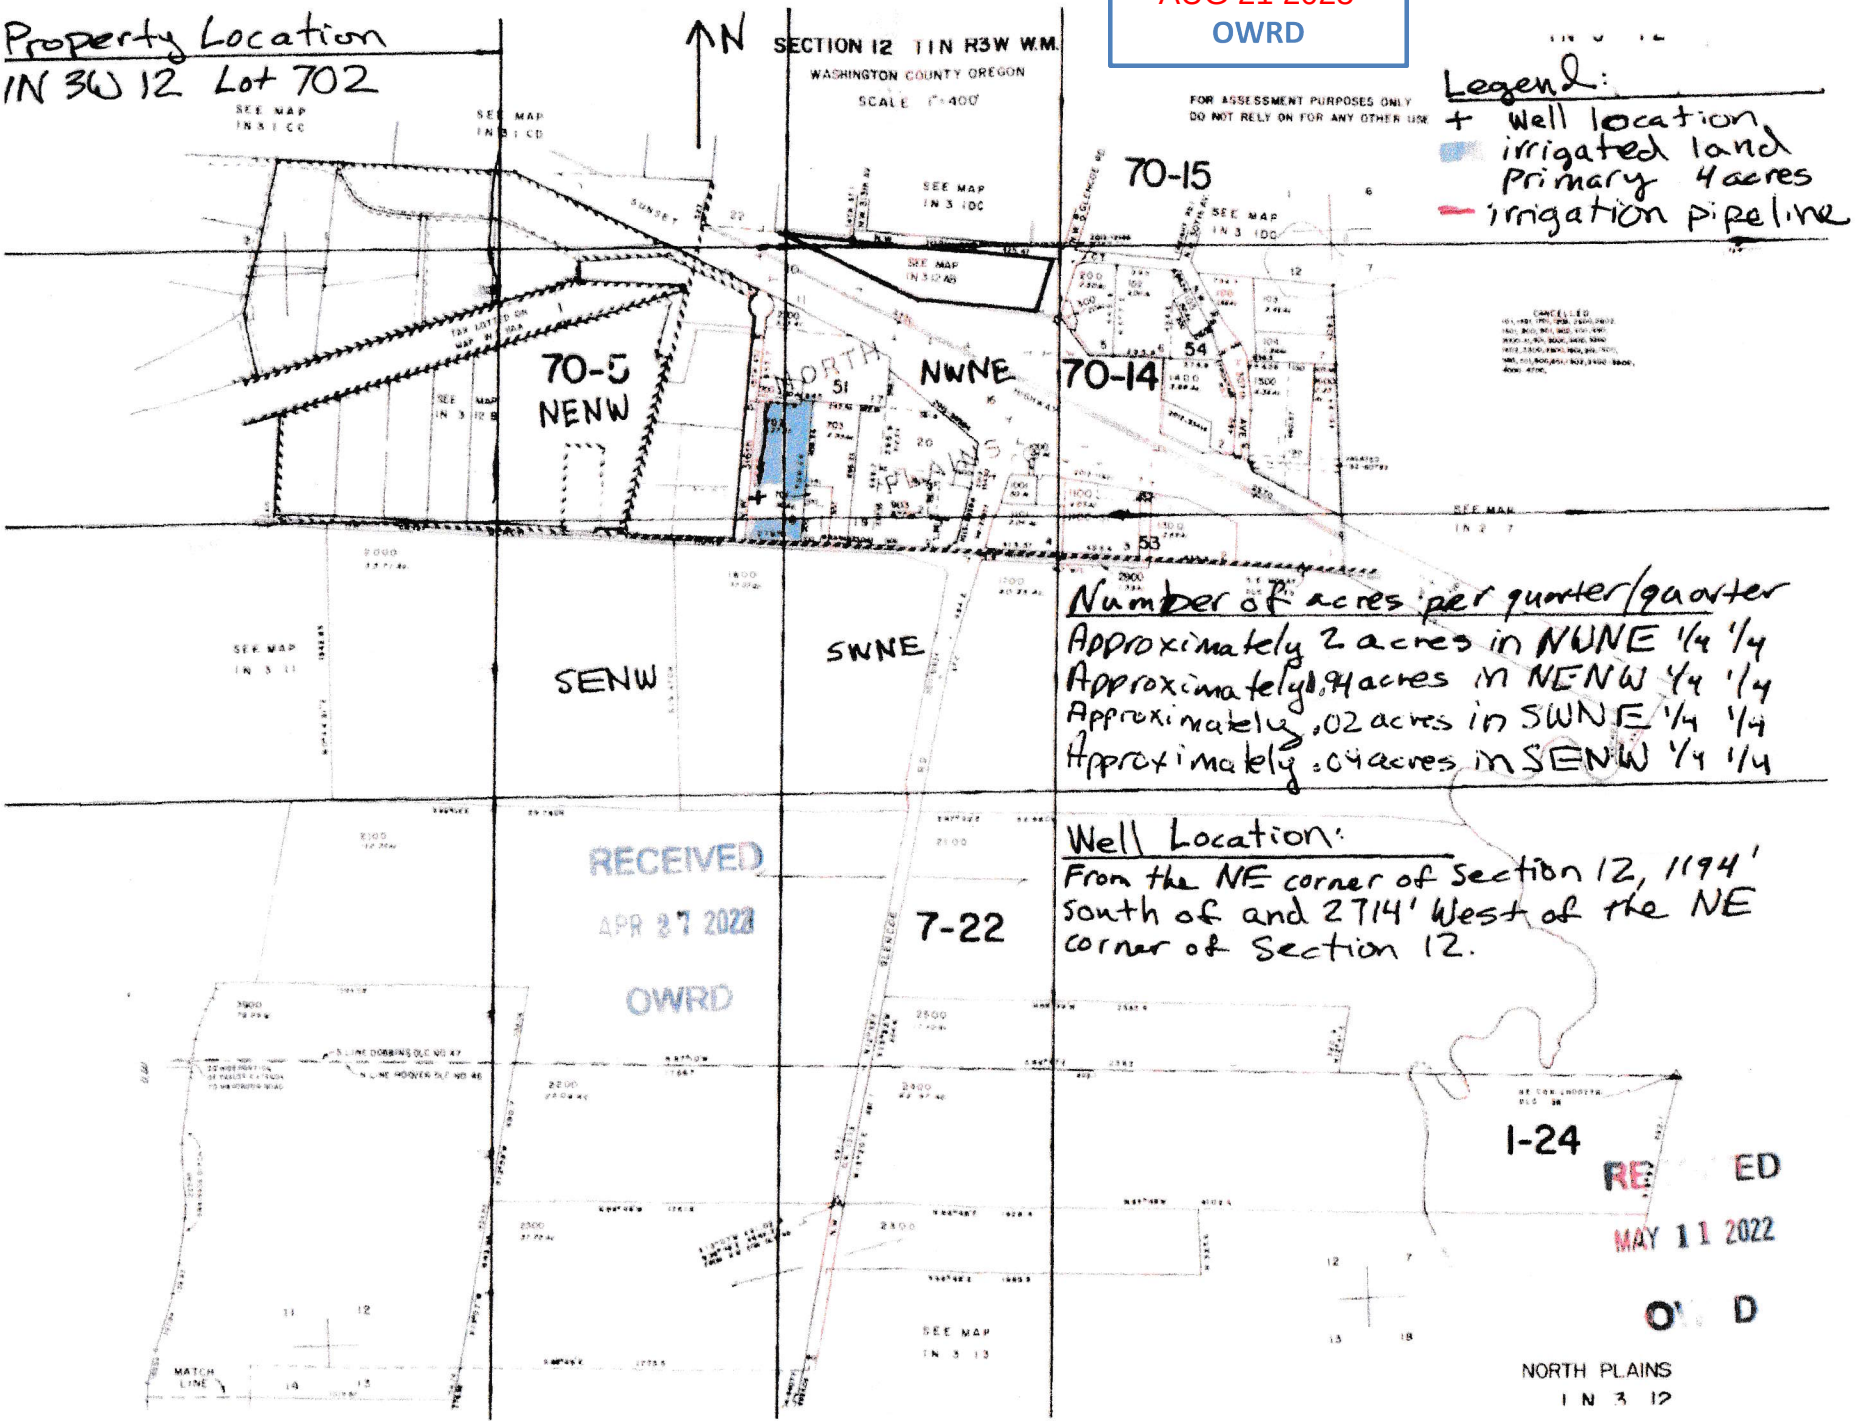

Legend:
+ Well location
irrigated land
primary 4 acres
irrigation pipeline

Number of acres per quarter/quarter
Approximately 2 acres in NWNE 1/4 1/4
Approximately .94 acres in NENW 1/4 1/4
Approximately .02 acres in SWNE 1/4 1/4
Approximately .04 acres in SENW 1/4 1/4

Well Location:
From the NE corner of Section 12, 1194' South of and 2714' West of the NE corner of Section 12.

RECEIVED
APR 27 2022
OWRD

RE ED
MAY 11 2022
O D