


T18SR47EWM

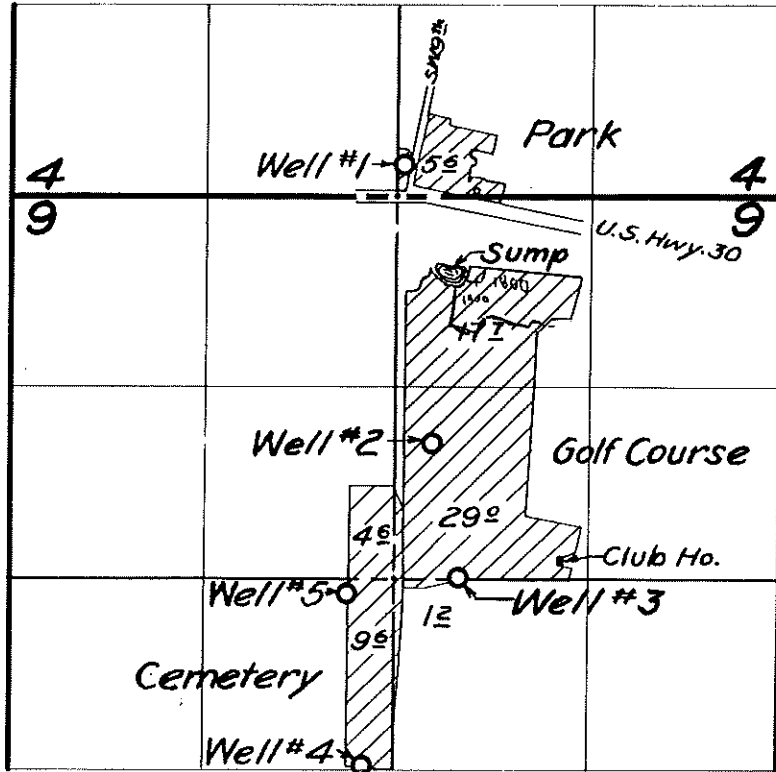

FINAL PROOF SURVEY

UNDER

Application No. U-473 U-254 Permit No. U-429 U-226

IN NAME OF


The City of Ontario

Surveyed Nov. 3 1955, by M. Bish

1955N

RECEIVED
JAN 04 2007
WATER RESOURCE DEPT.
EASTERN REGION

T-185 247E

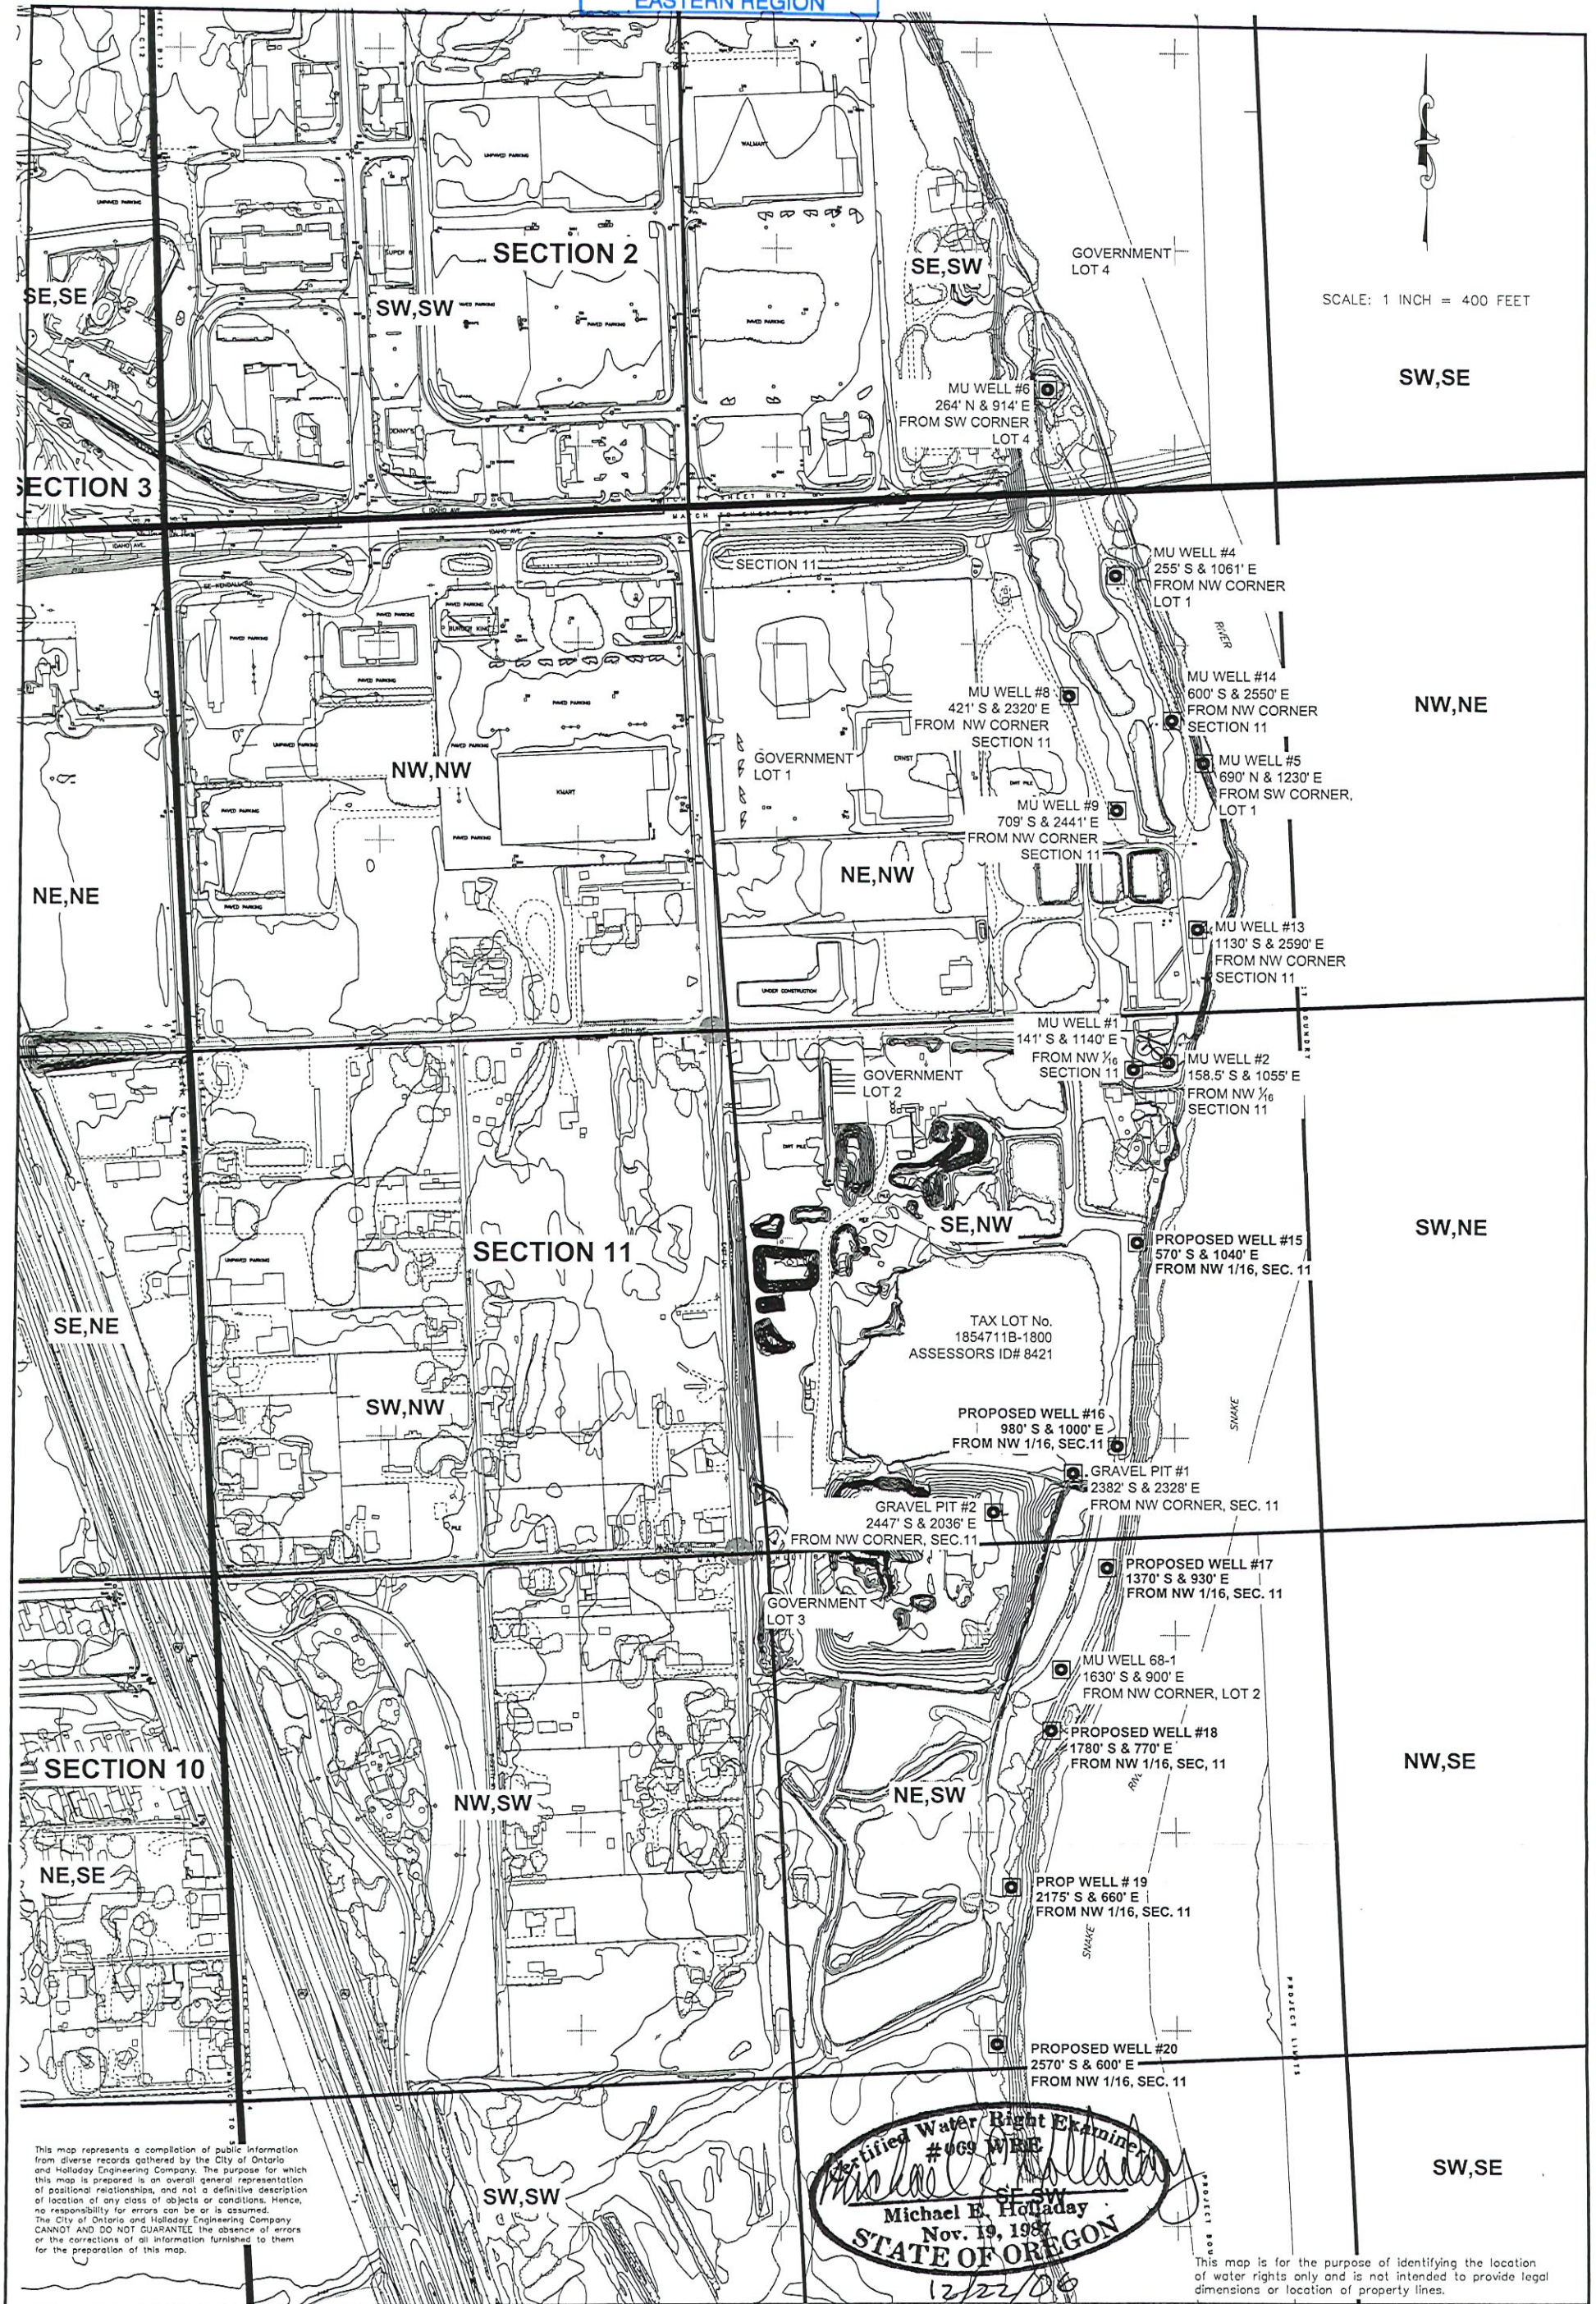

This map represents a compilation of public information from diverse records gathered by the City of Ontario and Holladay Engineering Company. The purpose for which this map is prepared is an overall general representation of positional relationships, and not a definitive description of location of any class of objects or conditions. Hence, no responsibility for errors can be or is assumed. The City of Ontario and Holladay Engineering Company CANNOT AND DO NOT GUARANTEE the absence of errors or the corrections of all information furnished to them for the preparation of this map.

Certified Water Right Examiner
Michael E. Holladay
Nov. 19, 1987
STATE OF OREGON
12/22/06

This map is for the purpose of identifying the location of water rights only and is not intended to provide legal dimensions or location of property lines.

WELL MAP CITY OF ONTARIO, OR

HOLLADAY ENGINEERING CO.
ENGINEERS • CONSULTANTS
32 N. MAIN P.O. BOX 235 PAYETTE, ID 83661
(208) 642-3304 • FAX# (208) 642-2159
EMAIL: hec@holladayengineering.com

DATE:	09/19/03
FIGURED:	11/15/06
DRAWN BY:	MEH
CHECKED BY:	MEH
DATE:	09/19/03
FIGURED:	11/15/06
DRAWN BY:	MEH
CHECKED BY:	MEH



This map is for the purpose of identifying the location of water rights only and is not intended to provide legal dimensions or location of property lines.

This map represents a compilation of public information from diverse records gathered by the City of Ontario and Holladay Engineering Company. The purpose for which this map is prepared is an overall general representation of location of any class of objects or conditions. Hence, no responsibility for errors can be or is assumed. The City of Ontario and Holladay Engineering Company CANNOT AND DO NOT GUARANTEE the absence of errors or the corrections of all information furnished to them for the preparation of this map.

SCALE: 1 INCH=400 FEET


Nov. 19, 1987
STATE OF OREGON
12/22/06

WELL MAP CITY OF ONTARIO, OR

HOLLADAY ENGINEERING CO.
ENGINEERS • CONSULTANTS
32 N. MAIN P.O. BOX 235 PAYETTE, ID 83661
(208) 642-3304 • FAX# (208) 642-2159
EMAIL: hec@holladayengineering.com

REUSE OF DOCUMENTS
THIS DOCUMENT, AND THE DATA
HEREIN, AS AN INSTRUMENT OF
SERVICE, IS THE PROPERTY OF
HOLLADAY ENGINEERING COMPANY.
IT IS TO BE USED ONLY FOR THE
PROJECT AND SITE SPECIFICALLY
IDENTIFIED HEREON. NO OTHER
PROJECTS, SITES, OR DATA
SHALL BE USED WITHOUT THE
WRITTEN PERMISSION OF
HOLLADAY ENGINEERING CO.
DATE: 09/19/03
DRAWN BY: MGH
CHECKED BY: MEH
JOB NO.: ON 031903 A
CADD FILE: C:\031903\031903A.dwg

Ontario Golf Course Map for T-8078

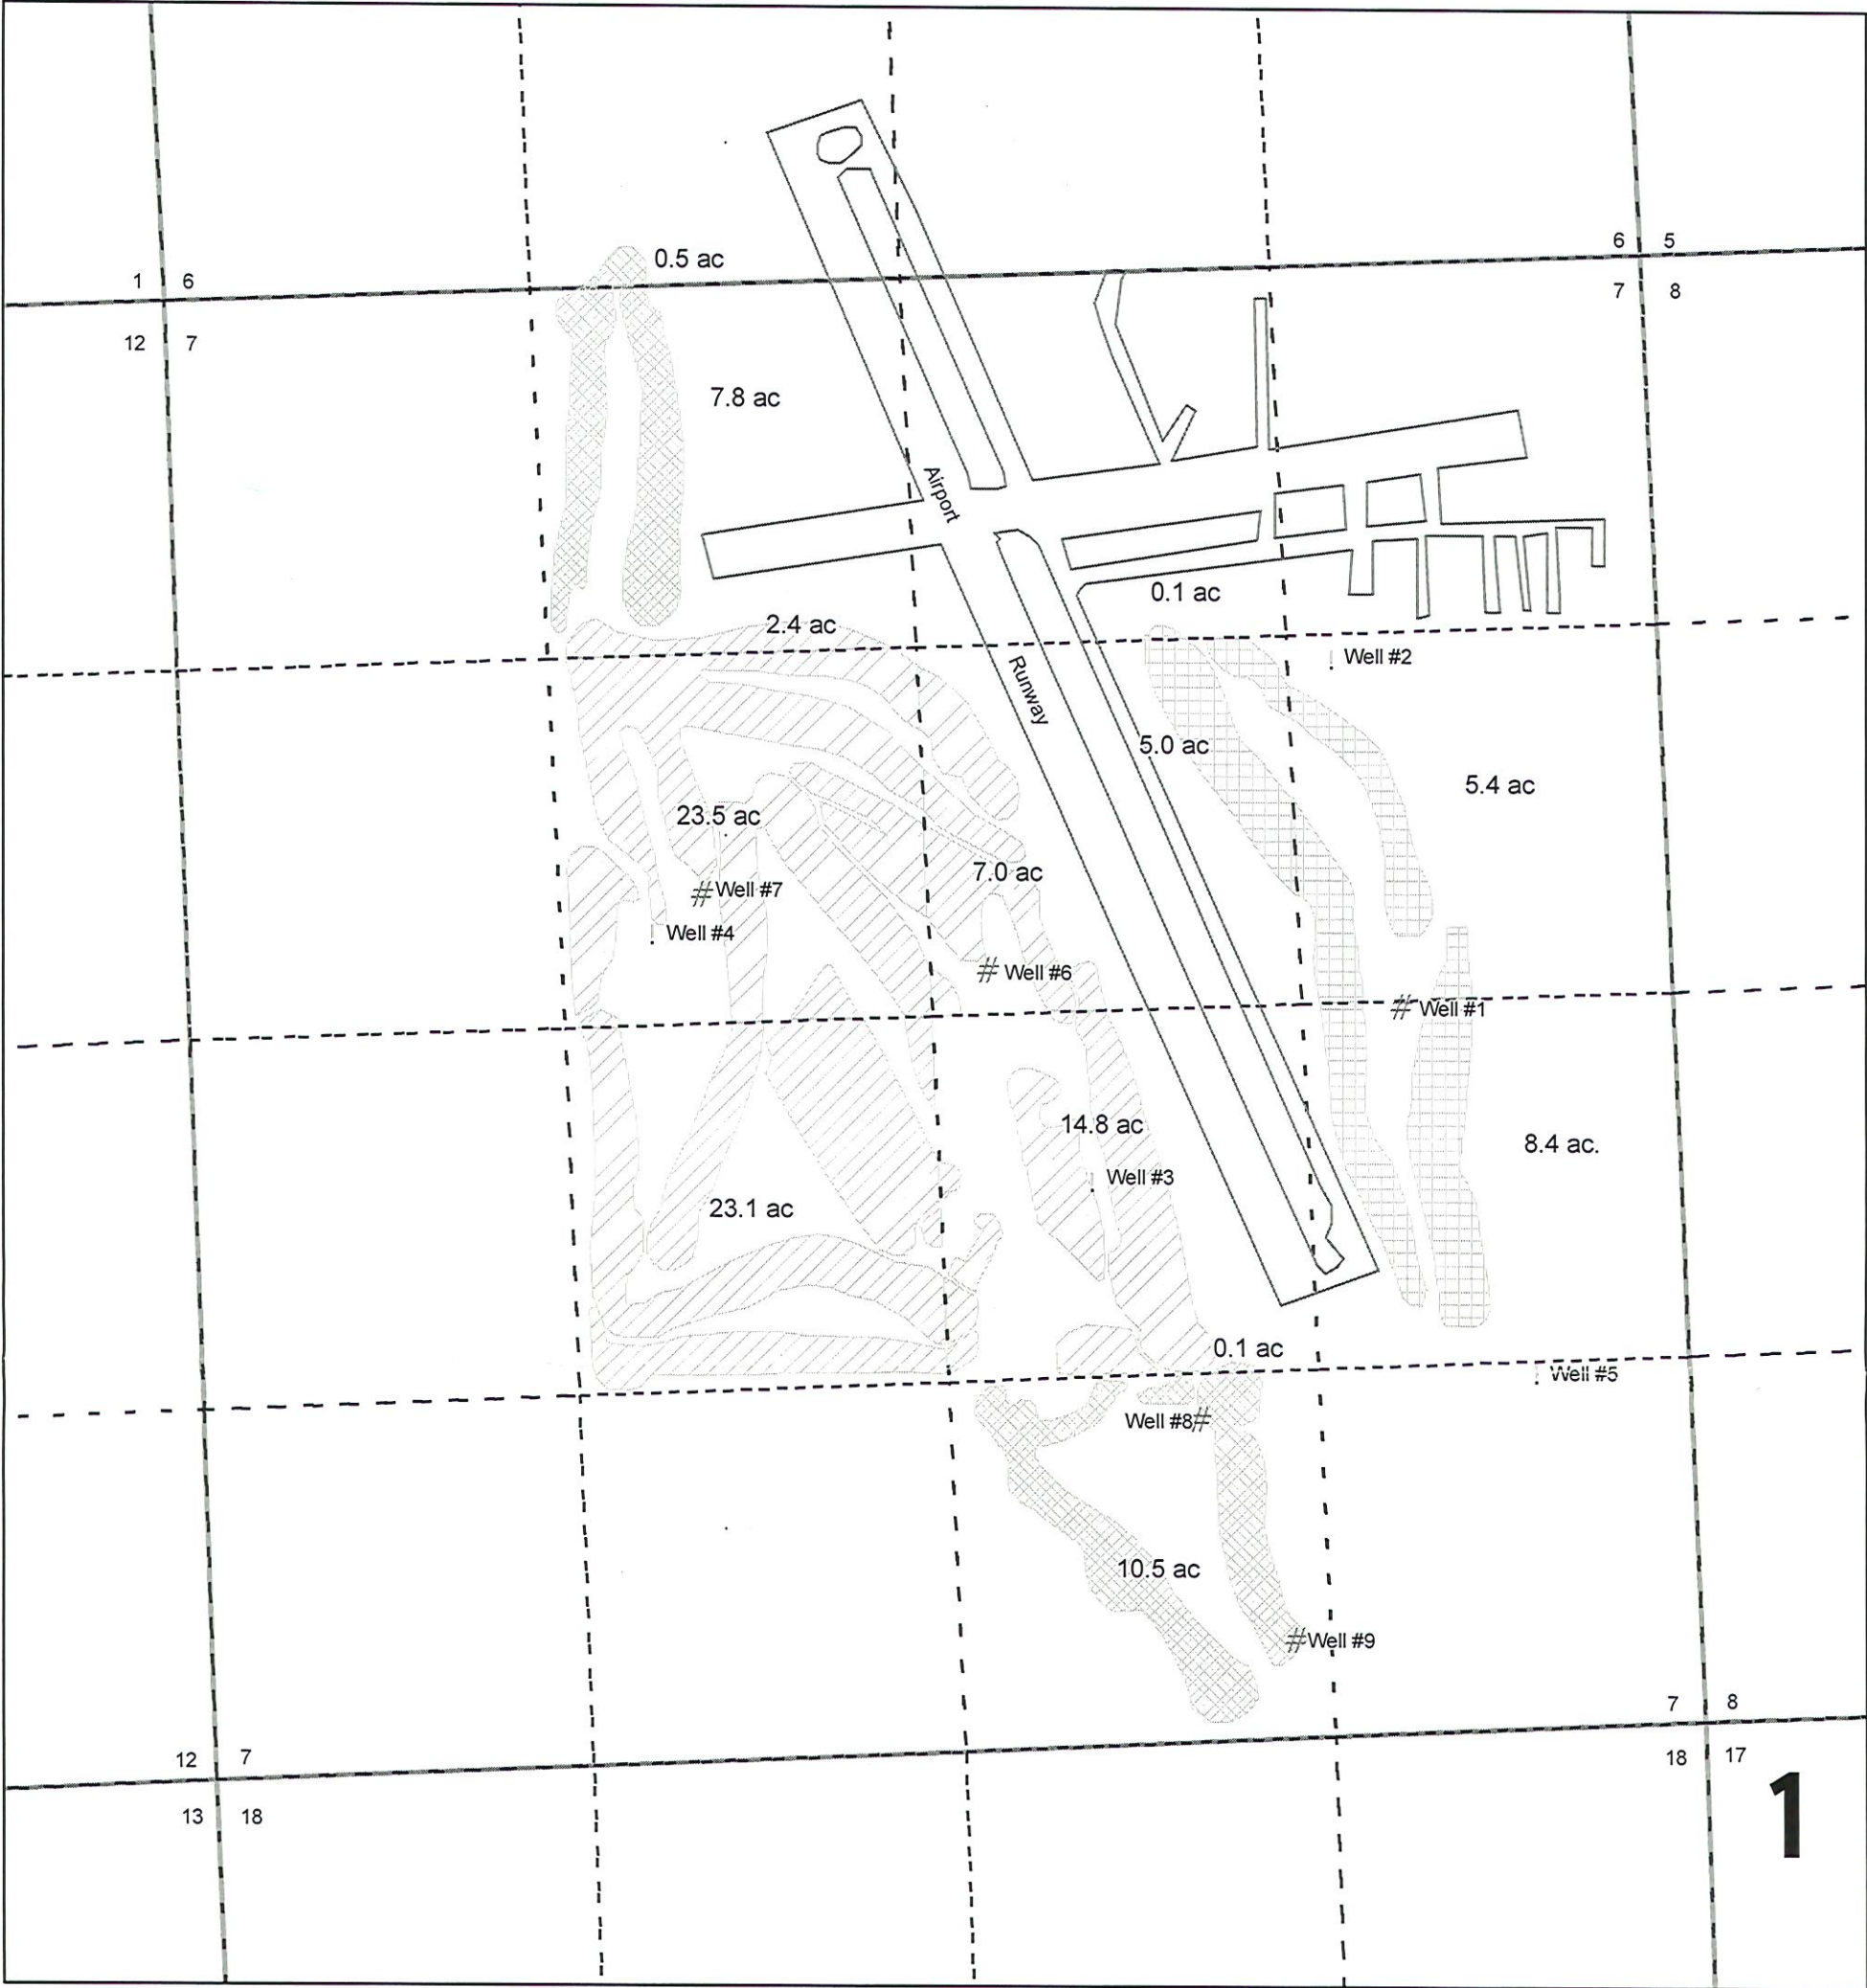

1 inch equals 660.0 feet

Legend - Proposed Changes to C-72138

Wells

Existing Points of Appropriation

- Well #2 - 1410' S & 1475' E from the N $\frac{1}{4}$ cor.
- Well #3 - 670' N & 1825' E from SW cor., NESW
- Well #4 - 2934' N & 1016' W from the S $\frac{1}{4}$ cor.
- Well #5 - 1279' N & 546' W from the SE cor.



Proposed Additional Points of Appropriation

- Well #1 - 13' S & 933' W from NE cor., NESE
- Well #6 - 2740' N & 220' E from the S $\frac{1}{4}$ cor.
- Well #7 - 3040' N & 930' W from the S $\frac{1}{4}$ cor.
- Well #8 - 1140' N & 900' E from the S $\frac{1}{4}$ cor.
- Well #9 - 375' N & 1100' E from the S $\frac{1}{4}$ cor.

Golf Course Place of Use


- To Place of Use
- From Place of Use
- Place of Use Remaining Unchanged

This map was created by the Oregon Department of Water Resources.

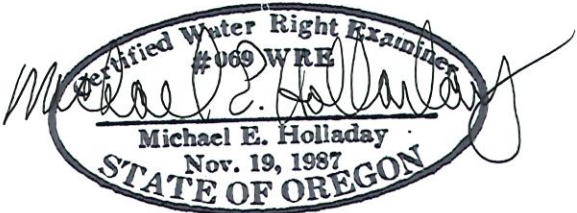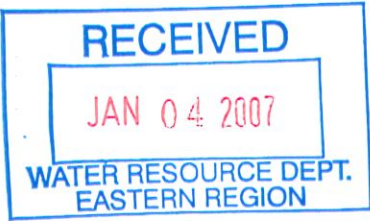

This map is for the purpose of identifying the location of water rights only and is not intended to provide legal dimensions or location of property lines.

12/28/06

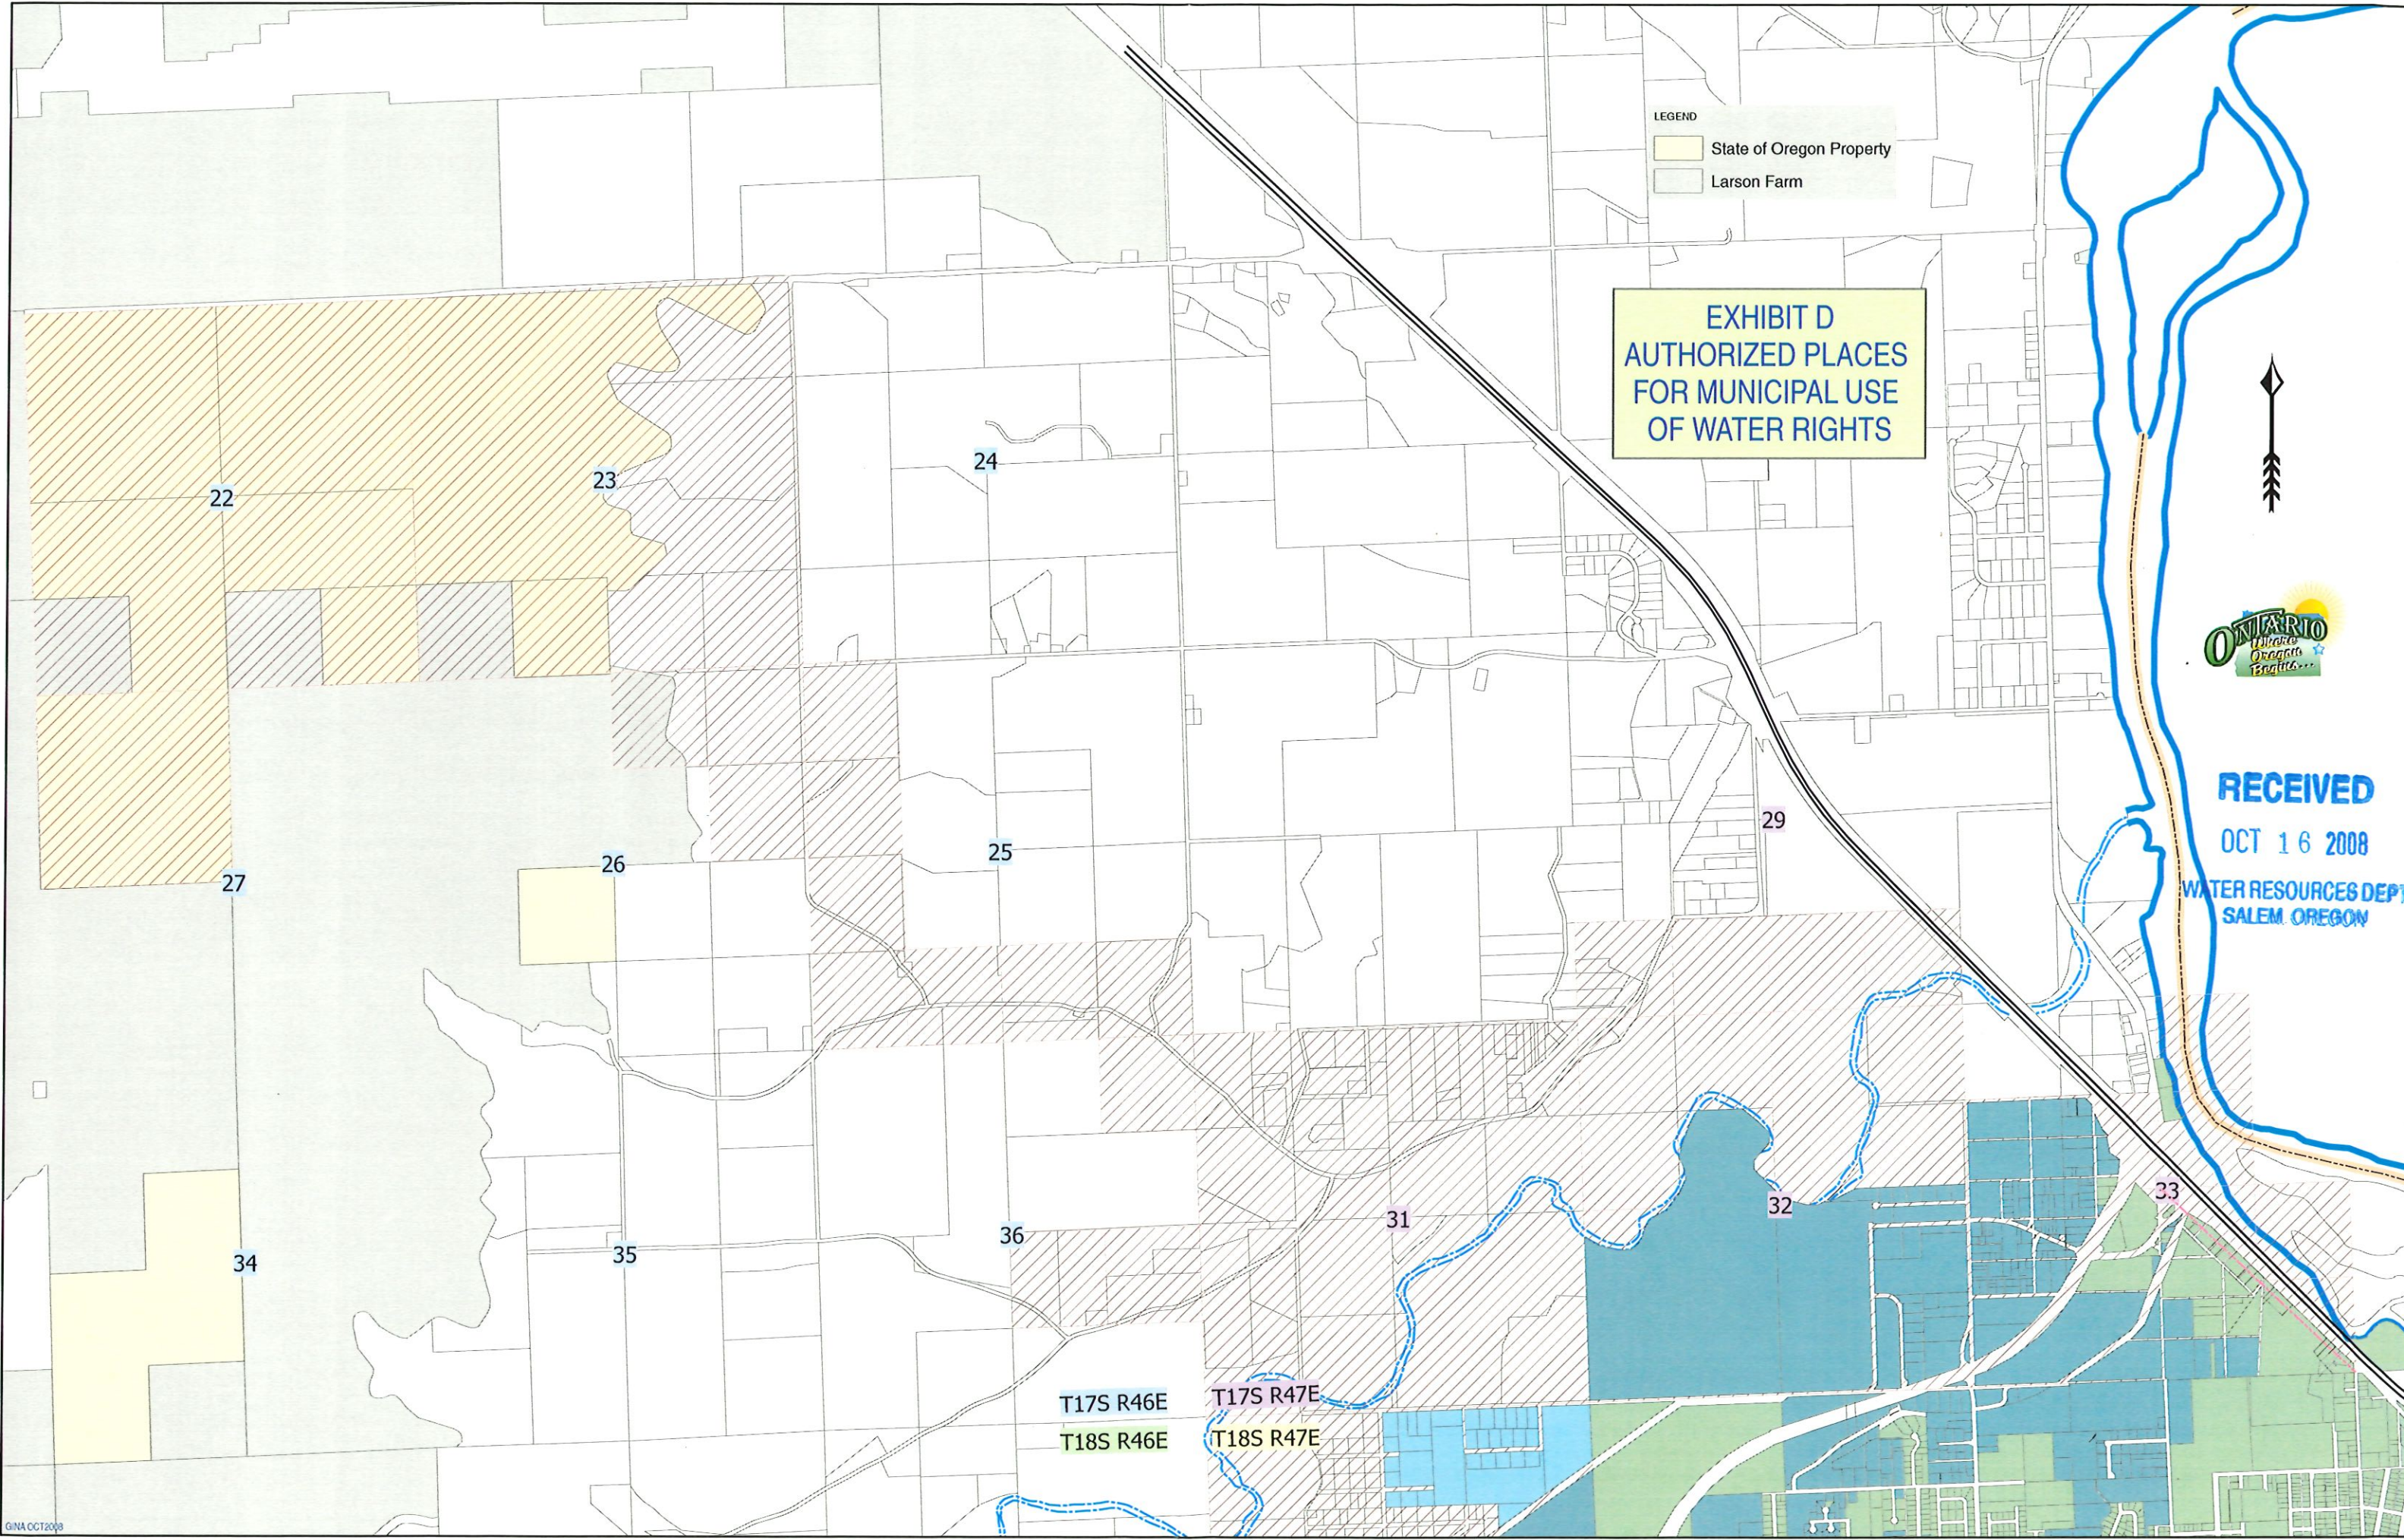

LEGEND

State of Oregon Property

Larson Farm

EXHIBIT D
AUTHORIZED PLACES
FOR MUNICIPAL USE
OF WATER RIGHTS



RECEIVED
OCT 16 2008

WATER RESOURCES DEPT
SALEM, OREGON

T17S R46E
T18S R46E

T17S R47E
T18S R47E