


Wintersogn Farms, LLC - Claim of Beneficial Use Transfer T-14093

Township 29S, Range 14W, W.M.

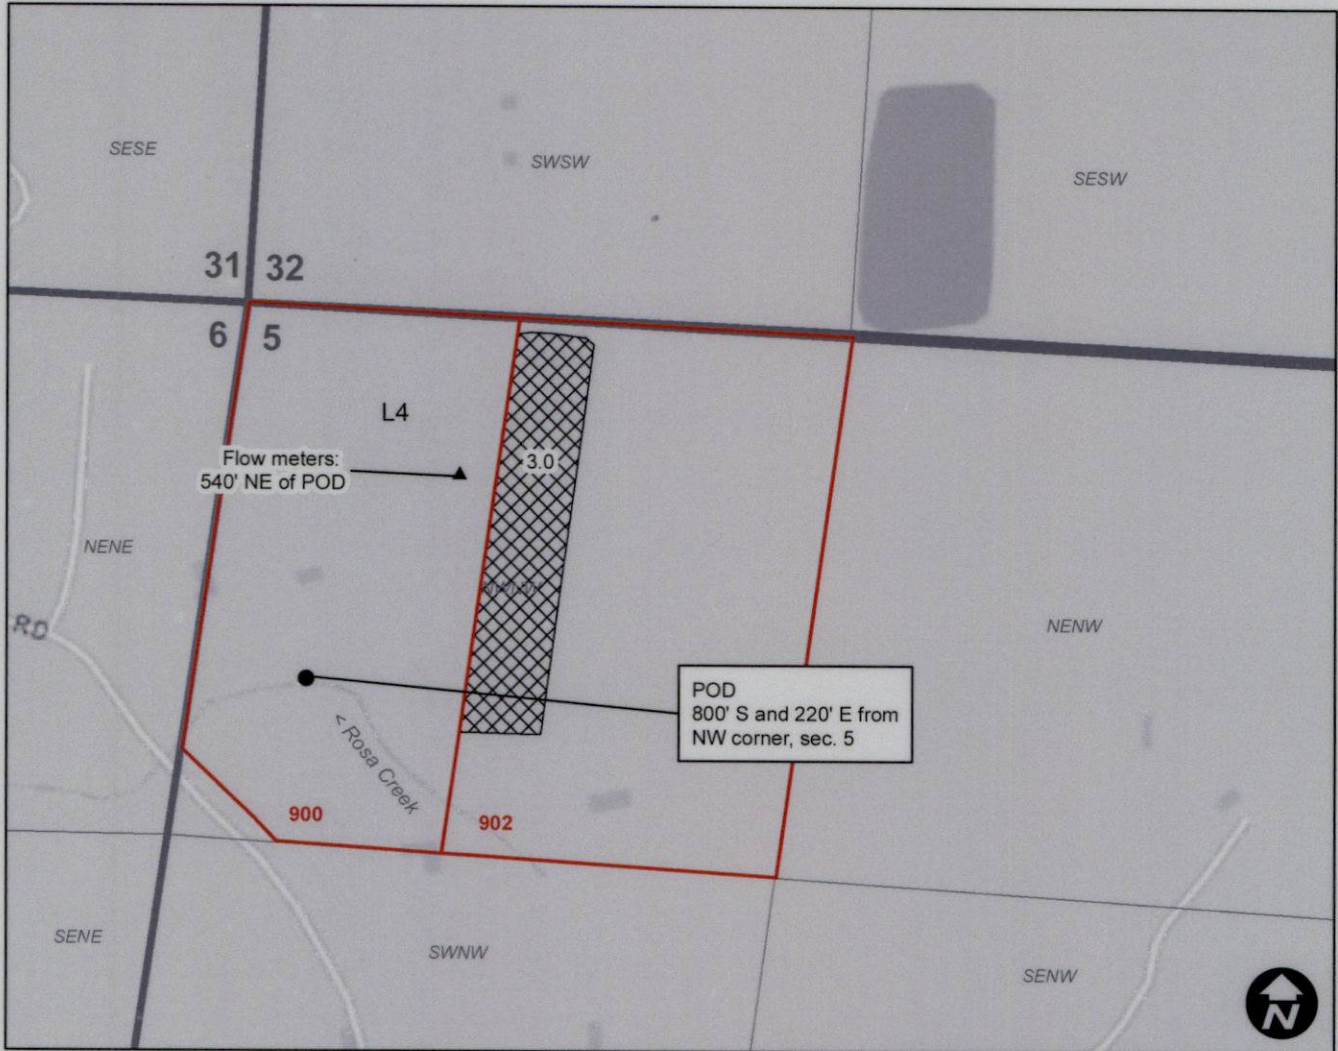

0 200 400 800 Feet

This map is not intended to provide legal dimensions or locations of property ownership lines.

Legend

 IR POU  Taxlot



EXPIRES:

Received by OWRD

AUG 26 2025

Salem, OR