


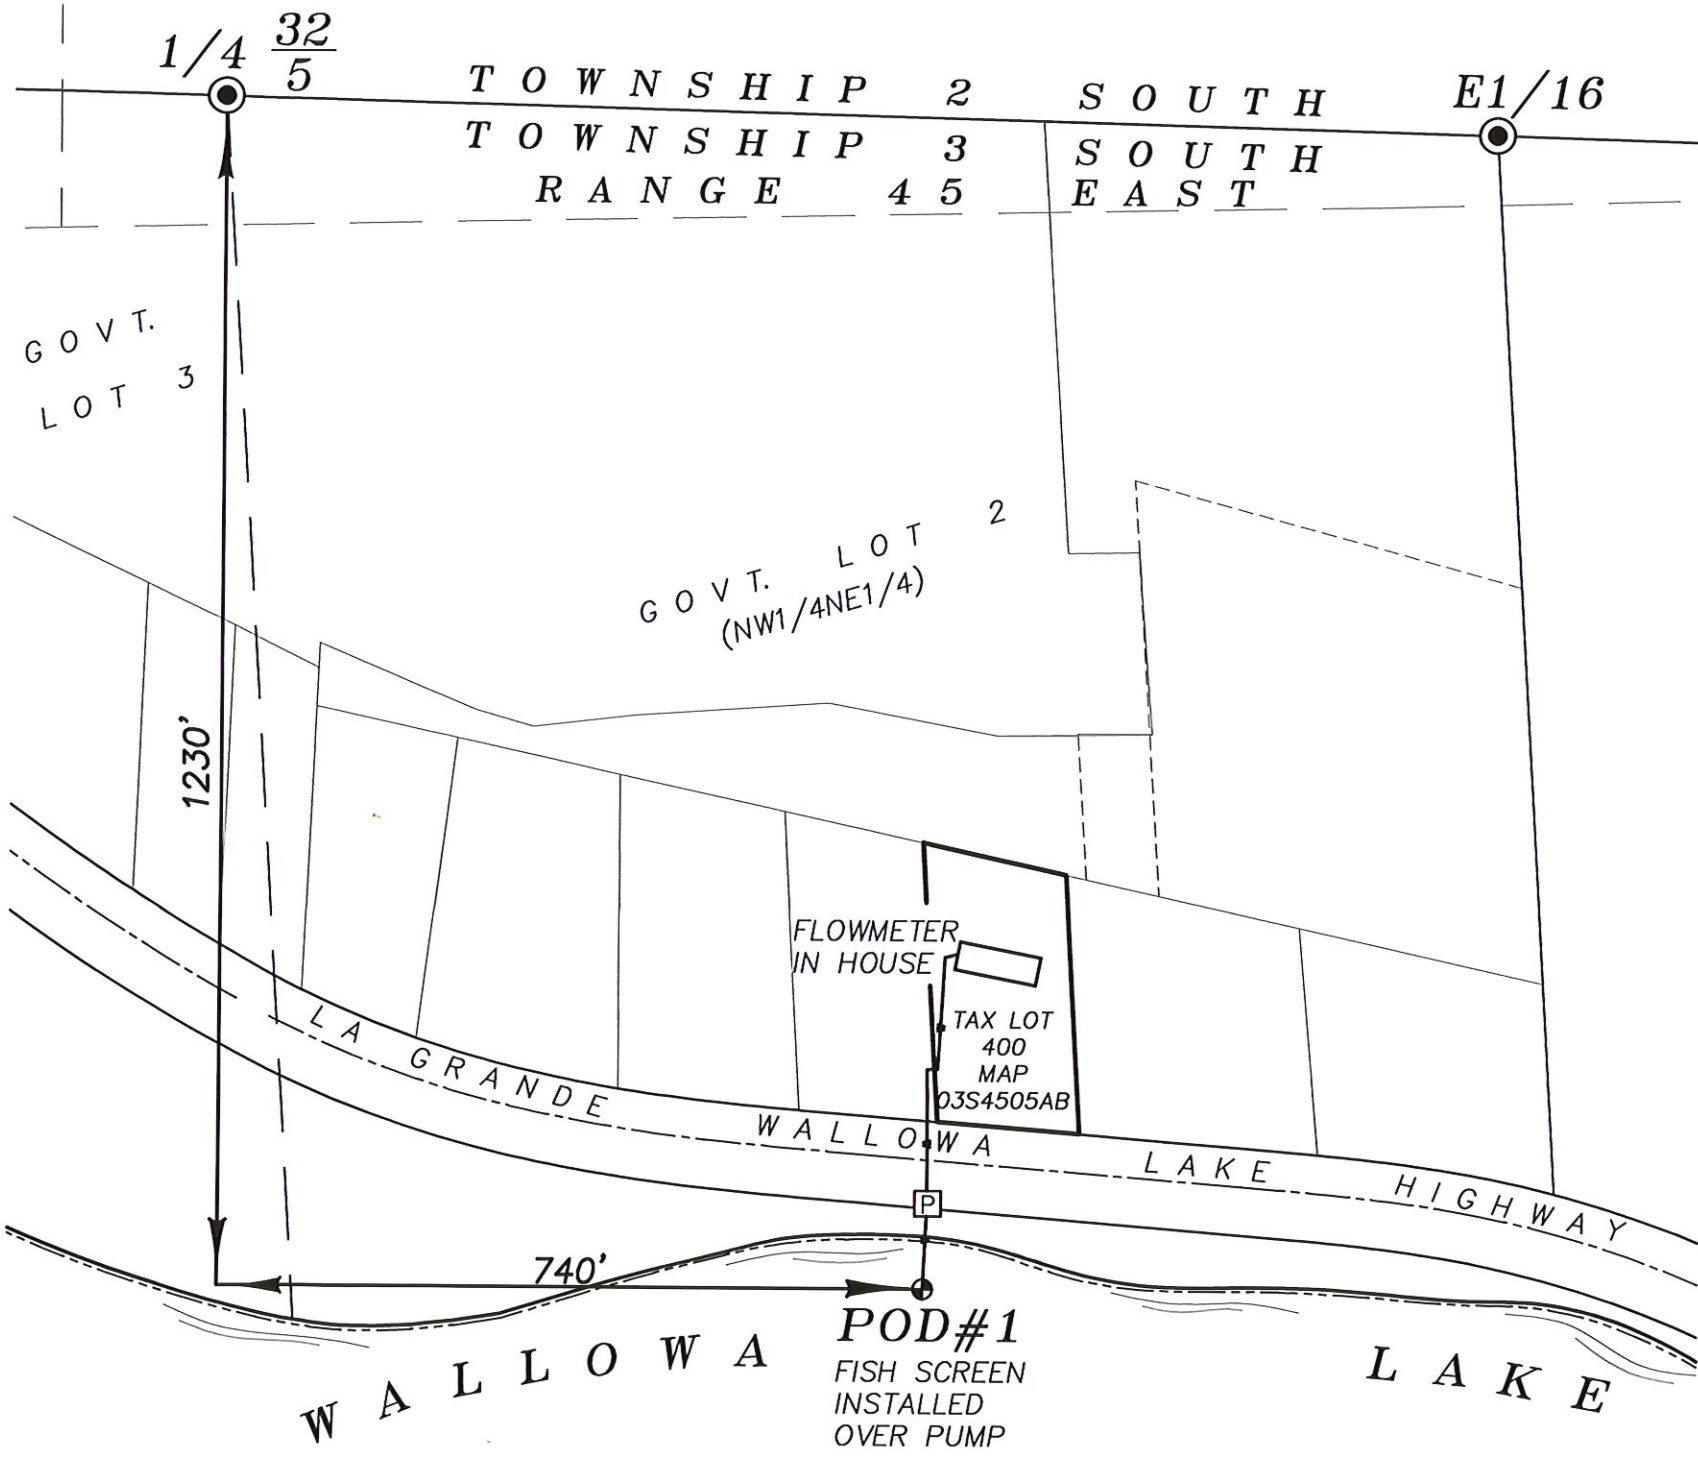

July 10, 2025
FINAL PROOF MAP OF
WATER RIGHTS FOR
DOMESTIC RIGHT
FOR
ALLEN FAMILY TRUST
BY
BAGETT-GRIFFITH & BLACKMAN
2006 ADAMS AVENUE
LA GRANDE, OREGON 97850

SCALE: 1"=200'

LEGEND

-  Pump House
-  Point of Diversion



Received
AUG 25 2025
OWRD

Renews: June 30, 2027

NOTE: The preparation of this map was for the purpose of indentifying the location of water rights and has no intent to provide dimensions or location of property ownership lines.

APPLICATION NO. S-88910
PERMIT NUMBER S-55317