


CLAIM OF BENEFICIAL USE MAP

TO CHANGE PLACE OF USE
PER T-14340 FOR GOLDEN RULE FARMS, INC.

SECTION 6, TOWNSHIP 27 SOUTH, RANGE 32 EAST, W.M.
TAX LOTS: 100, 300, & 400

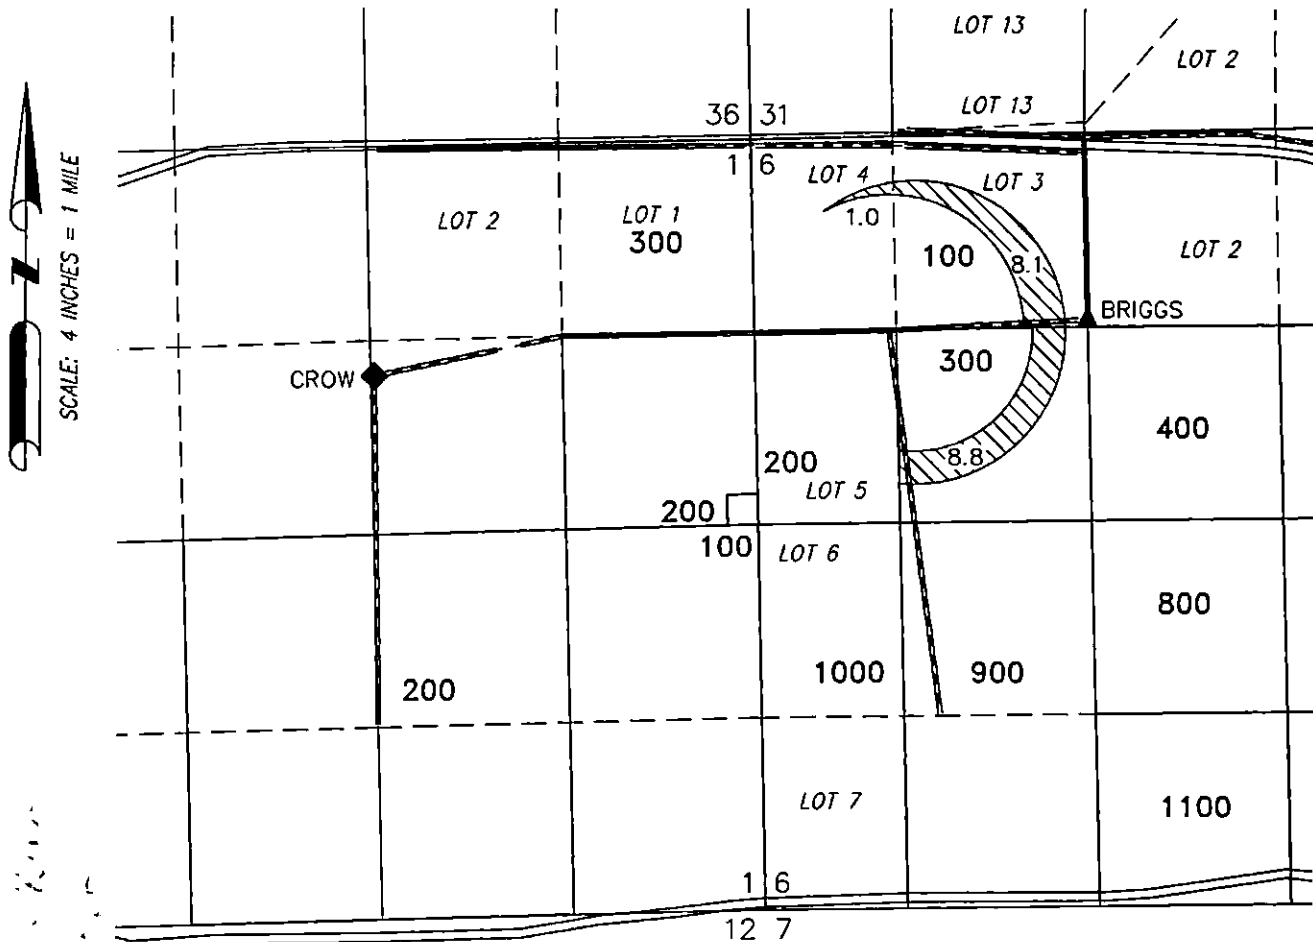


● **BRIGGS 2 (HARN 1460)**

LOCATED IN THE NE 1/4 NW 1/4 SECTION 6, T27S R32E, W.M. AND
1280 FEET SOUTH AND 1 FEET WEST FROM THE N 1/4 CORNER OF
SECTION 6.

FLOW METER LOCATED 4' SW'LY FROM WELL.



17.9 ACRES IR FROM BRIGGS 2 (G-4030), AS SHOWN.

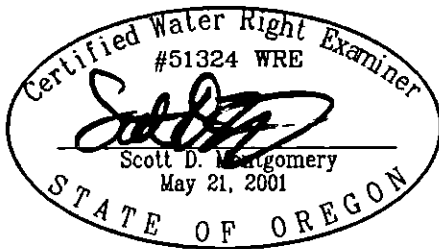

RENEWAL DATE: 12/31/2026

THIS MAP IS FOR THE PURPOSE OF LOCATING A WATER RIGHT ONLY AND HAS NO
INTENT TO PROVIDE LEGAL DIMENSIONS OR THE LOCATION OF PROPERTY LINES.

PREPARED FOR:

GOLDEN RULE FARMS, INC.
P.O. BOX 255
CHRISTMAS VALLEY, OR 97641

PREPARED BY:



ALL POINTS ENGINEERING AND SURVEYING, INC.
P.O. BOX 767
(541) 548-5833
TERREBONNE, OR 97760
www.APEandS.com