
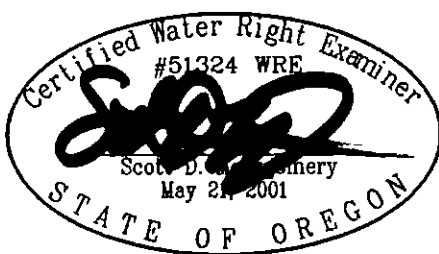


CLAIM OF BENEFICIAL USE MAP

TO CHANGE PLACE OF USE AND A POINT OF APPROPRIATION
PER APPLICATION T-14180
FOR TOELLE RANCH, LLC

TOWNSHIP 22 SOUTH, RANGE 32.5 EAST, SECTION 25, W.M.
TAX LOT 400

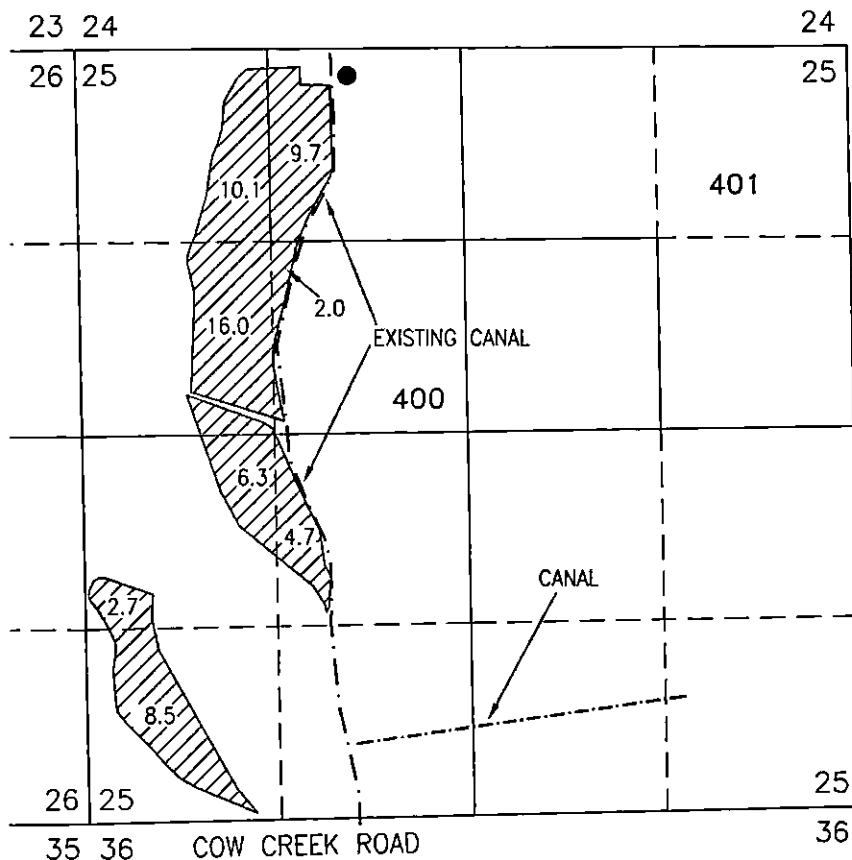

RENEWAL DATE: 12/31/2026

THIS MAP IS FOR THE PURPOSE OF LOCATING A
WATER RIGHT ONLY AND HAS NO INTENT TO
PROVIDE LEGAL DIMENSIONS OR THE LOCATION OF
PROPERTY LINES

CANAL/DITCH

BURIED CONDUIT

CREEK/STREAM

● POA 3 (HARN 52770)

APPROVED WELL IN THE NE 1/4 NW 1/4 SECTION 25,
T22S R32.5E, W.M. LOCATED 4990 FEET NORTH AND
3520 FEET WEST FROM THE SE CORNER OF SECTION 25.
METER IS APPROXIMATELY 8.0 FEET W'LY ALONG
DELIVERY PIPE FROM WELL.



60.0 ACRES IR FROM
T-14180, AS SHOWN.

PREPARED FOR:

TOELLE RANCH, LLC
72702 COW CREEK ROAD
BURNS, OR 97720

PREPARED BY:



ALL POINTS ENGINEERING AND SURVEYING, INC.
P.O. BOX 767 TERREBONNE, OR 97760
(541) 548-5833 www.APEandS.com