


Ground Water Claim of Beneficial Use
Permit G-18319 Application G-18563
T 38 S, R 4 W, W M, Portion of Section 8, Jackson County

Received

AUG 20 2025

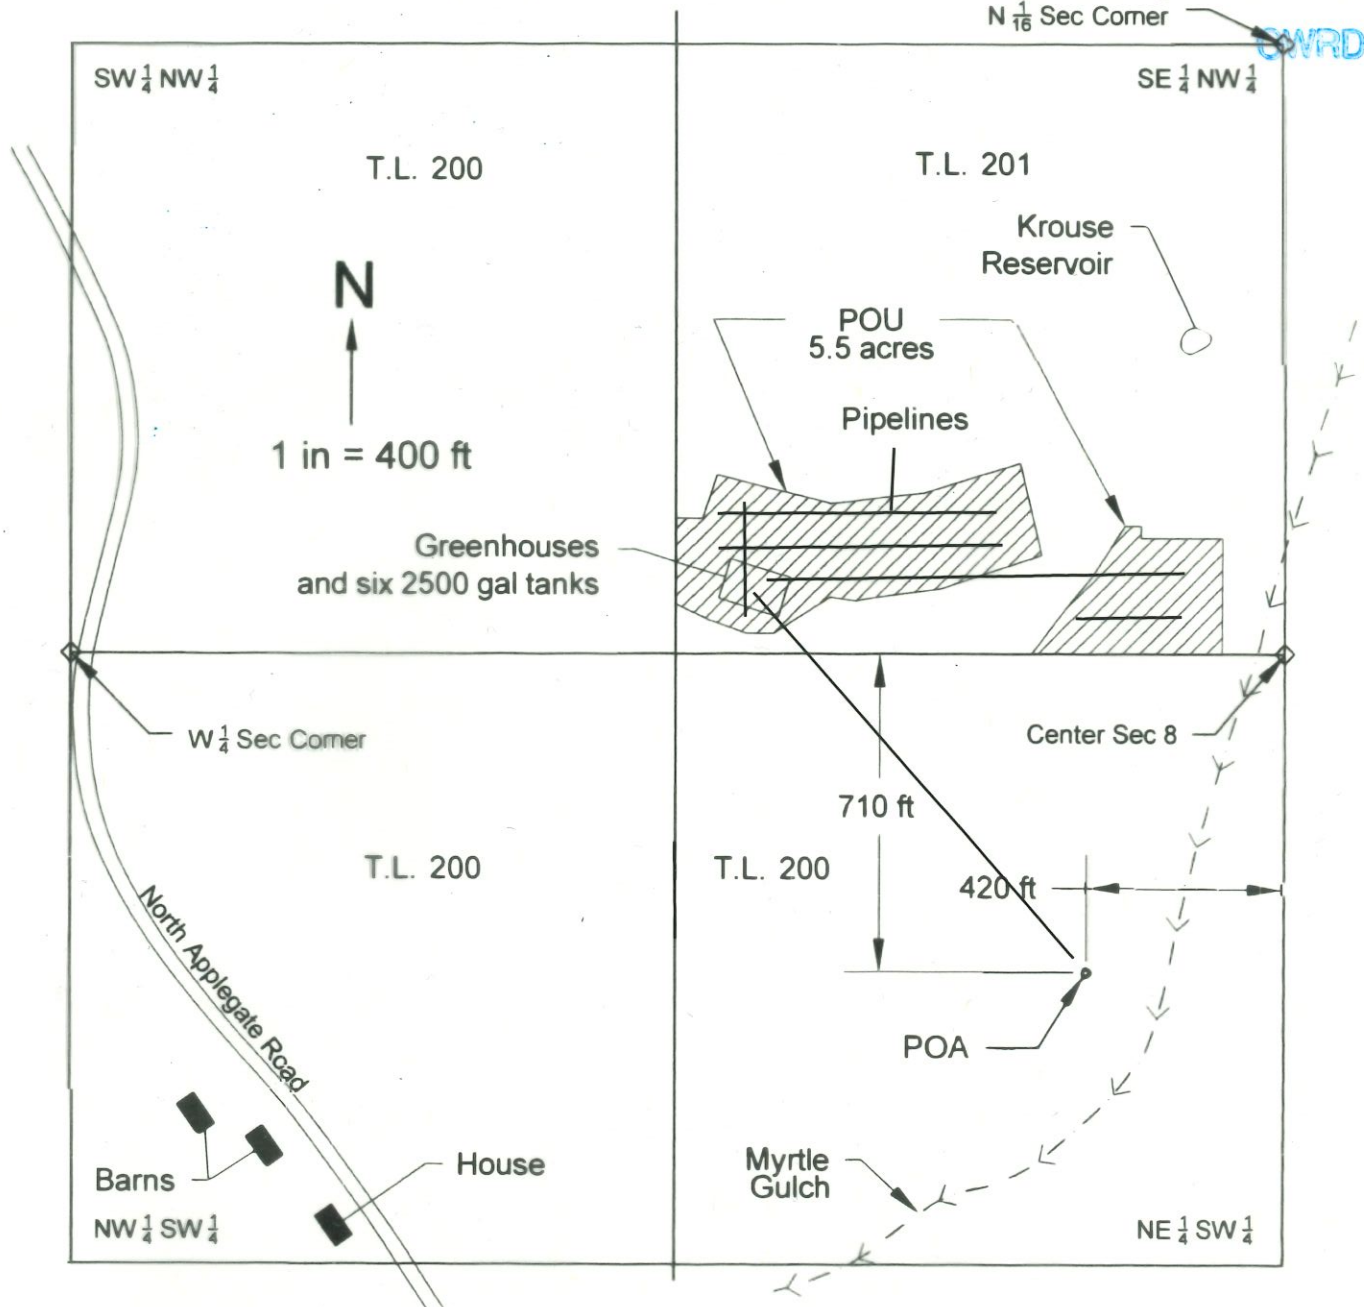

5.5 acres SE 1/4 NW 1/4

POA JOSE 55932 / JACK 17618 and meter
710 feet S and 420 feet W of Center of
Section 8

NOTE: This map is not intended to provide legal
dimensions or locations of property ownership lines.

Source: Steven P. Boyd G18563 Application

