


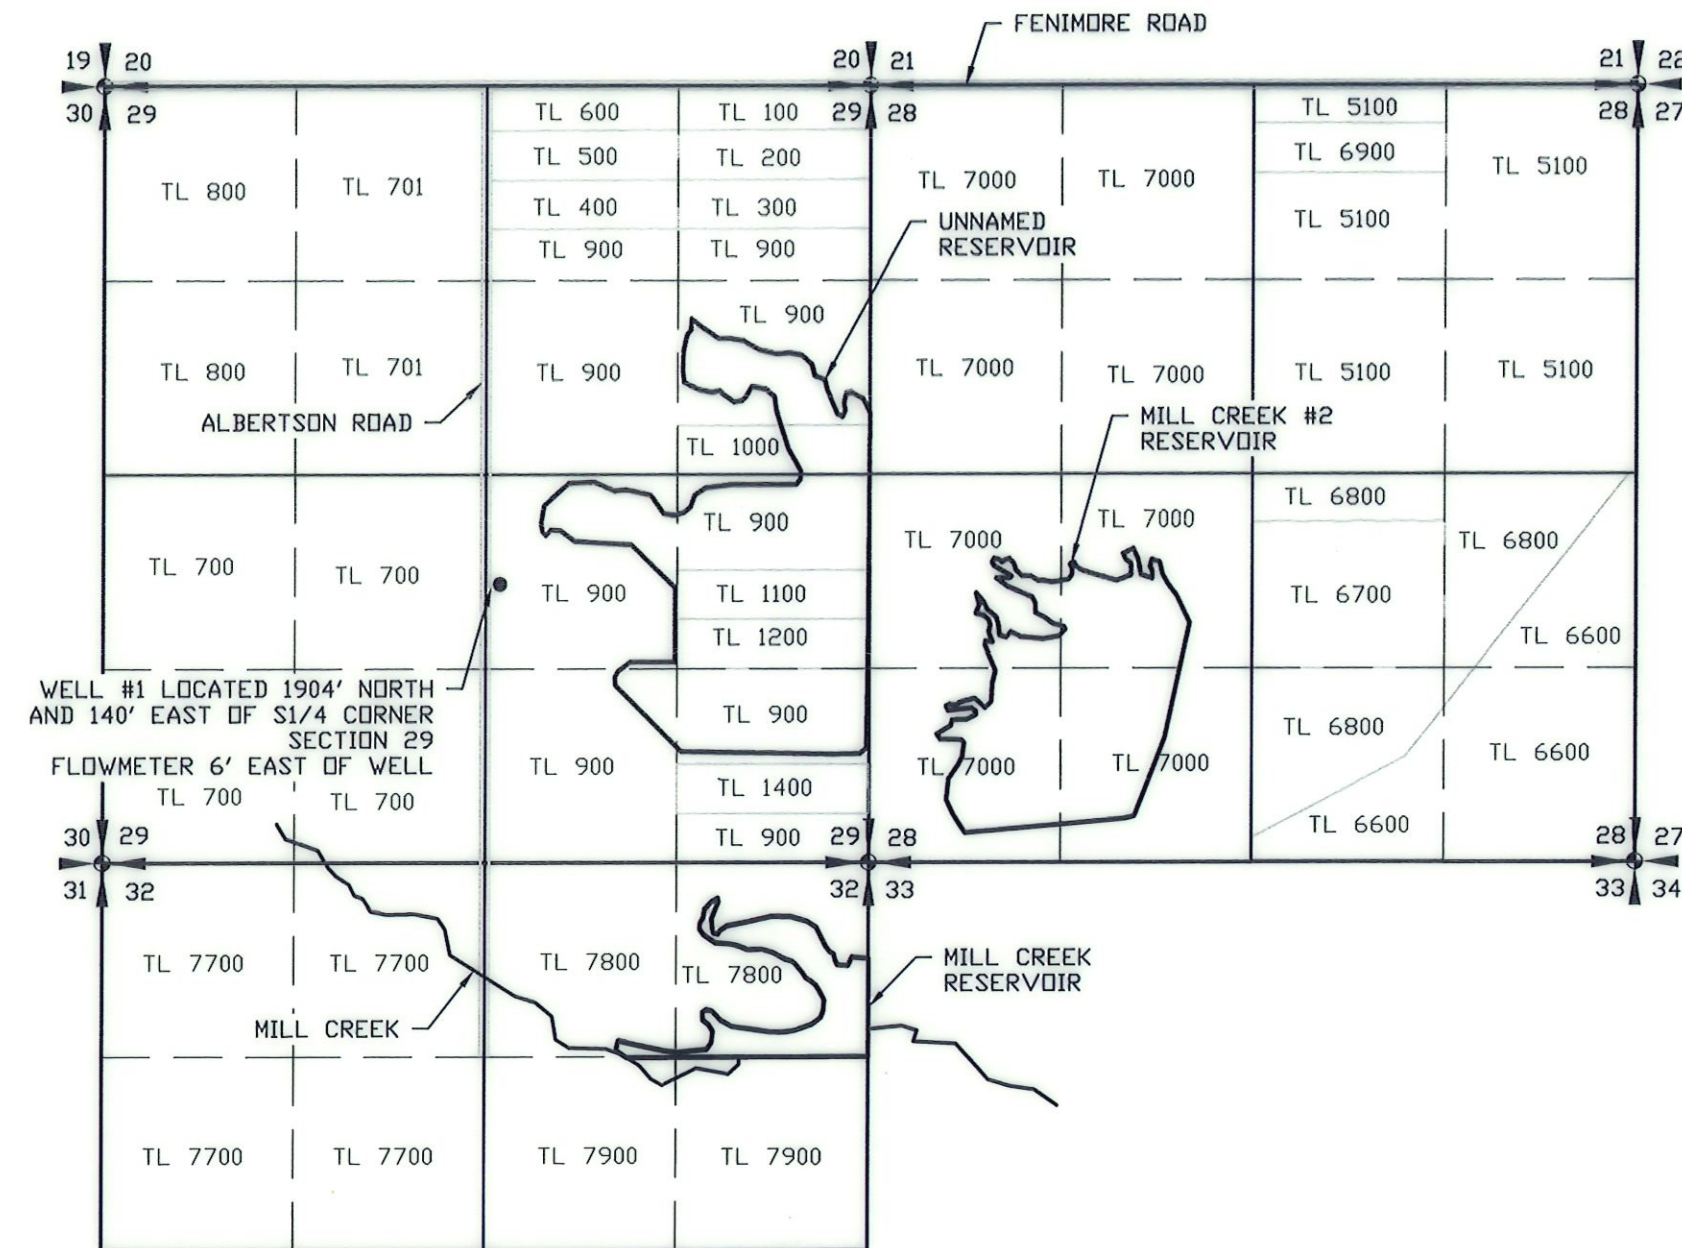

CLAIM OF BENEFICIAL USE MAP

FOR
JOHN ALBERTSON

SECTIONS 28, 29 & 32
T40S R19E W.M.
LAKE COUNTY, OREGON


LEGEND

- SECTION LINE
- 1/4 SECTION LINE
- 1/16 SECTION LINE
- RESERVIOR

TRANSFER NO. T-13851



SCALE: 1"=1320'

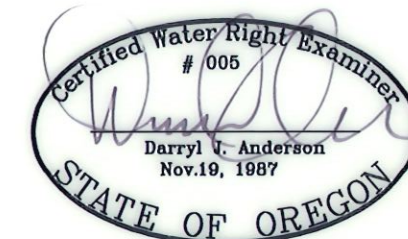

RENEWAL 12/31/25

NOTE:
PREPARATION OF THIS MAP IS FOR IDENTIFYING WATER RIGHTS ONLY. IT
HAS NO INTENT TO PROVIDE LOCATIONS OR DIMENSIONS OF PROPERTY
BOUNDARIES.

REVISION	BY

**ANDERSON ENGINEERING
AND SURVEYING, INC.**
P.O. BOX 28
LAKEVIEW, OREGON 97630
(541) 947-4407/FAX: 947-2321
WWW.ANDERSONENGINEERING.COM

FOR: **JOHN ALBERTSON**
14377 ALBERTSON RD
LAKEVIEW, OR 97630
503-550-4799

CLAIM OF BENEFICIAL USE MAP
TRANSFER NO. T-13851
SEC. 28, 29, & 32, T40S, R19E W.M.

DATE:	7/10/2025
SCALE:	1" = 1320'
DWG. BY:	R.C.
JOB:	225035
FILE:	225035
SHEET:	1 OF 1