

CLAIM OF BENEFICIAL USE MAP FOR GARRICK & KATHERINE WAALKES

SECTION 16, T41S R35E W.M.
HARNEY COUNTY, OREGON


LEGEND

- SECTION LINE
- 1/4 SECTION LINE
- 1/16 SECTION LINE
- MAIN LINE

TRANSFER NO. T-14356



SCALE: 1"=1320'

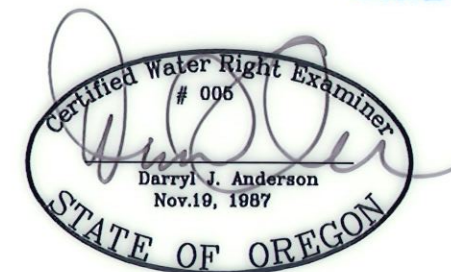

RENEWAL 12/31/25

NOTE:
PREPARATION OF THIS MAP IS FOR IDENTIFYING WATER RIGHTS ONLY. IT
HAS NO INTENT TO PROVIDE LOCATIONS OR DIMENSIONS OF PROPERTY
BOUNDARIES.

REVISION	BY

ANDERSON ENGINEERING
AND SURVEYING, INC.
P.O. BOX 28
LAKEVIEW, OREGON 97630
(541) 947-4407/FAX: 947-2321
WWW.ANDERSONENGINEERING.COM

FOR:
KATHERINE WAALKES
13549 FIELDS DENIO RD
FIELDS, OR 97710
503-550-4799

CLAIM OF BENEFICIAL USE MAP
TRANSFER NO. T-14356
SEC. 16, T41S, R35E W.M.

DATE:	9/25/2023
SCALE:	1" = 1320'
DWG. BY:	R.C.
JOB:	2023-026
FILE:	2023-026
SHEET:	1 OF 1