

2"
PIPELINE

PIPELINE SYSTEM

Not to Scale


T7S, R3W, WM

POLK COUNTY

TAX LOT:
7.3.7 208

DLC LINE

PIPELINE

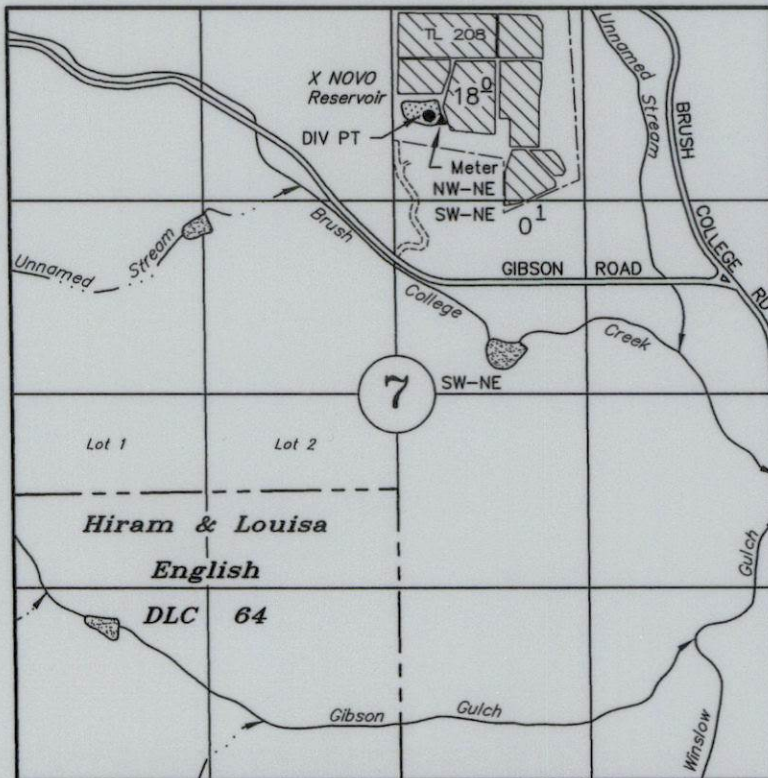

DIV PT IR: 740' SOUTH & 262' EAST OF N 1/4 COR SEC 7
METER: 775' SOUTH & 345' EAST OF N 1/4 COR SEC 7

Claim of Beneficial Use

Application No. S-88399

Permit No. S-55082

Received by OWRD

SEP 04 2025

Salem, OR

X NOVO, LLC

DECEMBER 21, 2023

SCALE 1" = 1320'

NOTE: This map is not intended to provide legal dimensions or locations of property ownership lines.



Renewal Date: December 31, 2025