


T.7S. R.1E. Section 10, W.M.

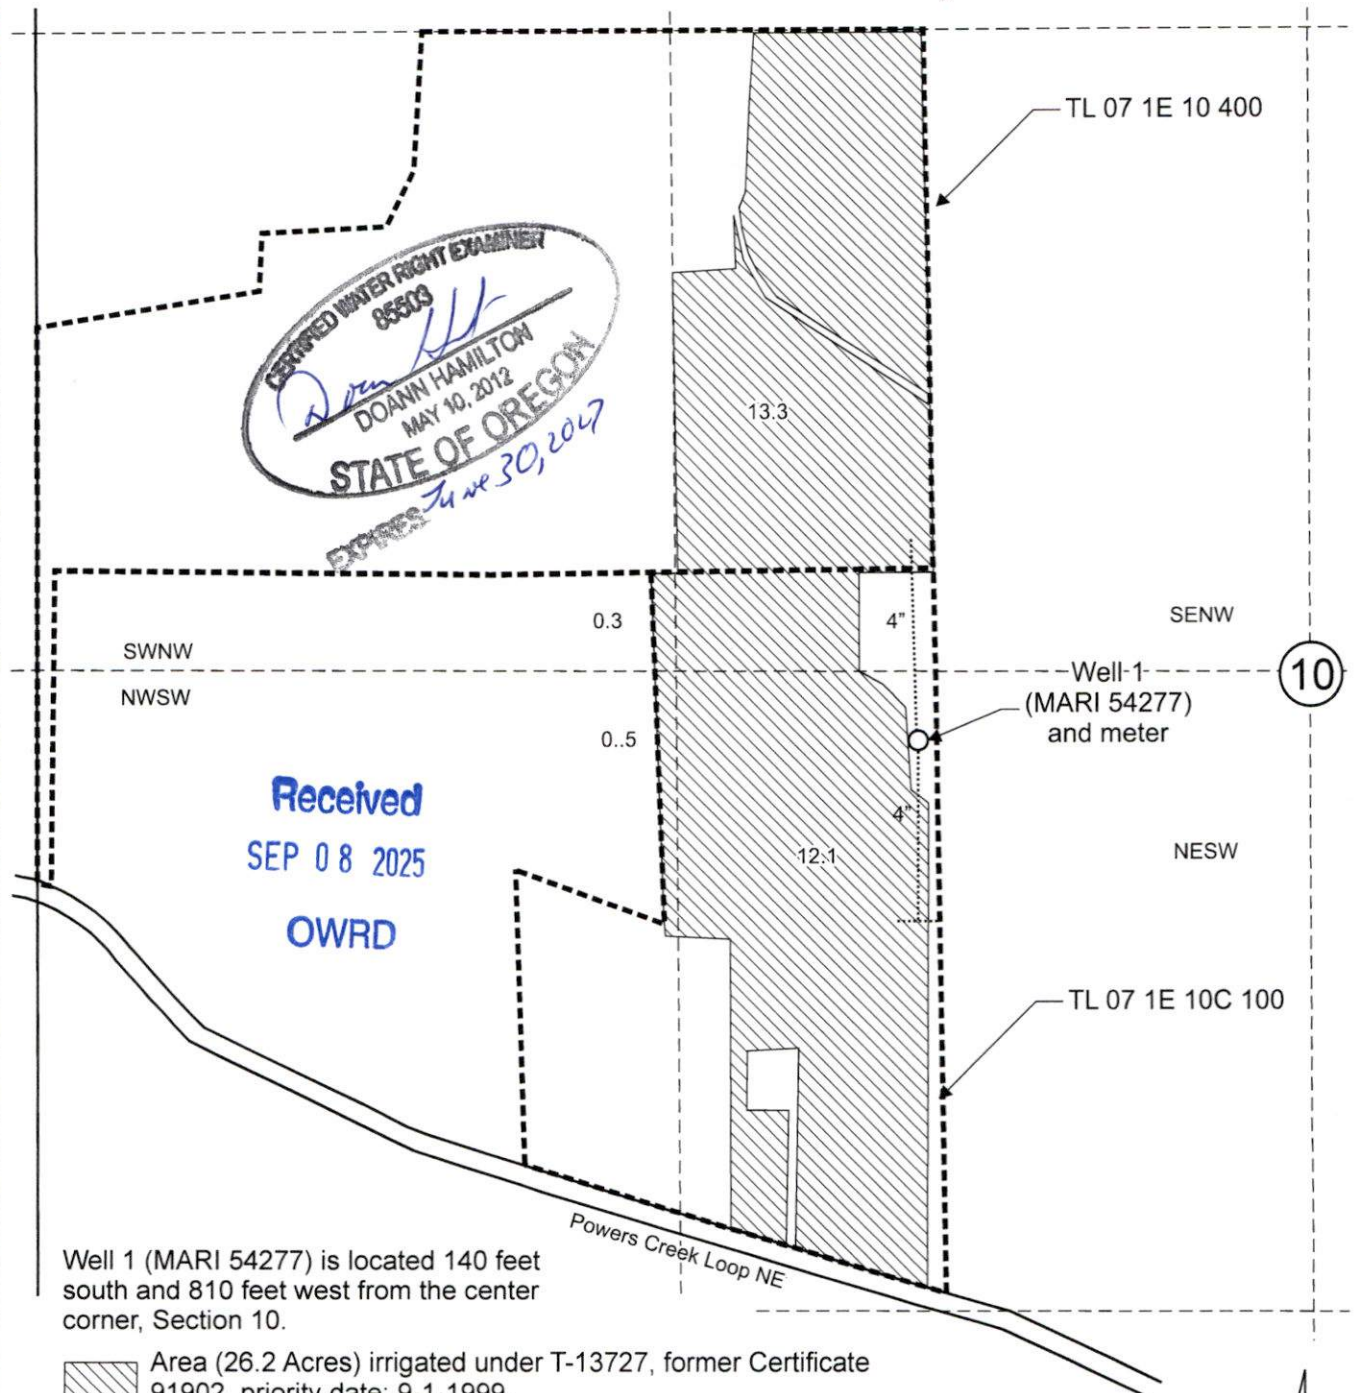

Received
SEP 08 2025
OWRD


Well 1 (MARI 54277) is located 140 feet south and 810 feet west from the center corner, Section 10.

Area (26.2 Acres) irrigated under T-13727, former Certificate 91902, priority date: 9-1-1999.

----- Tax lot boundary

..... Water main line

Scale: 1" = 400'

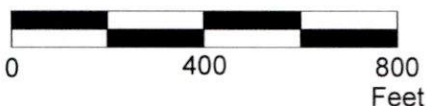

This map was prepared for the purpose of identifying the location of a water right only and is not intended to provide legal dimensions or location of property ownership lines.

Claim of Beneficial Use Map
T-13727, formerly Certificate 91902

Jan and Cynthia Hupp
T.7S. R.1E. Section 10, W.M.

09/2025

Pacific Hydro-Geology Inc.