CLAIM OF BENEFICIAL USE MAP

LOCATED IN THE SE 1/4 OF THE SW 1/4 OF SECTION 8, TOWNSHIP 23 SOUTH, RANGE 12 WEST, W.M., COOS COUNTY, OREGON
ALL BEING WITHIN TAX LOT 300

APPLICATION S-83730, PERMIT S-53907

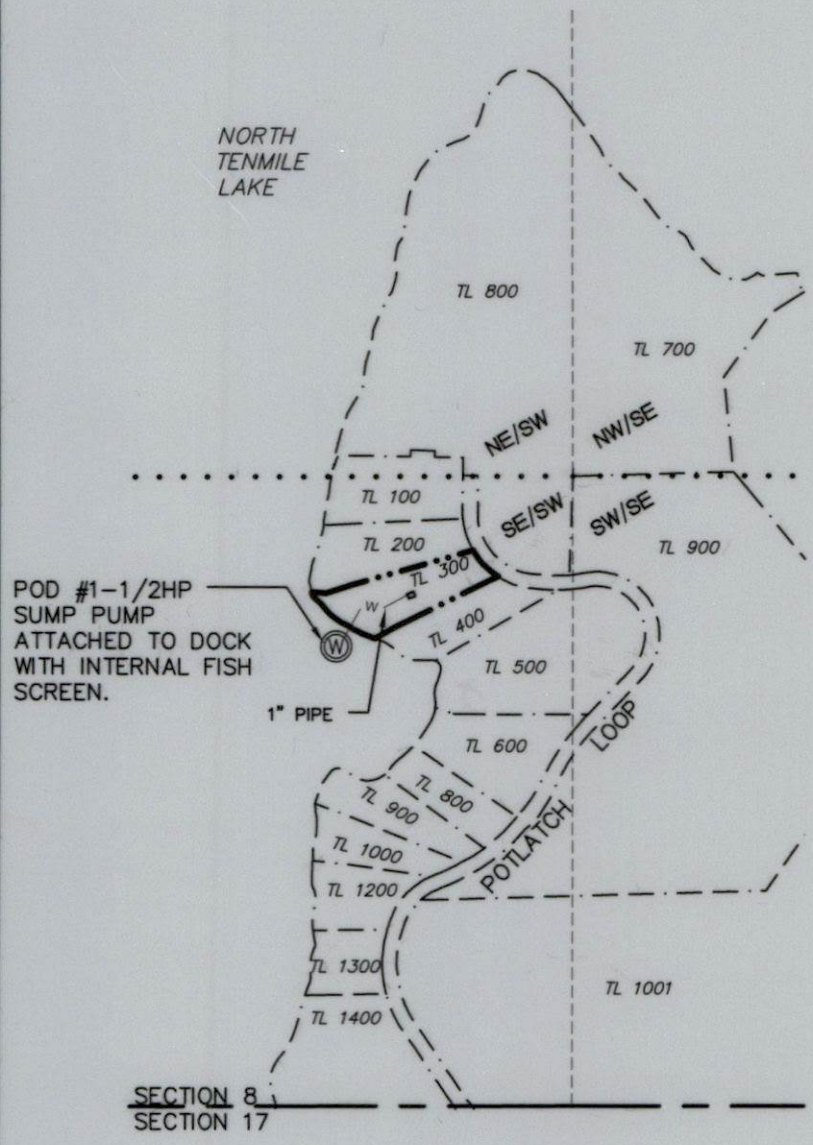

LEGEND

SYMBOL	DESCRIPTION
	PROPERTY BOUNDARY
	OTHER TAX LOTS
	SECTION LINES
	1/4 SECTION LINES
	1/16 SECTION LINES
W	POINT OF DIVERSION
—— W —— W ——	DISTRIBUTION PIPE

POD #1 – SUMP PUMP, 333 FEET SOUTH, 470 FEET WEST FROM NORTH EAST 1/16 CORNER OF SECTION 8CD

CERTIFIED WATER RIGHT EXAMINER
91975
Angela B Mosieur
ANGELA B MOSIEUR
07/11/2023
STATE OF OREGON
EXPIRES: 12/31/2026

Received
SEP 08 2025
OWRD

N

SITUS ADDRESS:
72290 POTLATCH RD
LAKESIDE, OR 97449

PRODUCED FOR:
TAMMI ELLISON
153 BRAMBLE WAY
ROSEBURG, OR 97420

400' 0 200' 400'
1 INCH = 400 FT

Stuntzner Engineering & Forestry, LLC
COOS BAY - FOREST GROVE - JUNCTION CITY - DALLAS

ENGINEERING - LAND SURVEYING - FORESTRY LAND PLANNING - WATER RIGHTS

JOB #: 125-008 REVISED: APRIL 2025
DRAWING: 125-008 Ellison COBU.dwg

705 S. 4TH ST
COOS BAY, OR 97420
PHONE: (541) 267-2872
FAX: (541) 267-0588

THE PREPARATION OF THIS MAP WAS FOR THE PURPOSE OF IDENTIFYING THE LOCATION OF THE WATER RIGHT ONLY AND IS NOT INTENDED TO PROVIDE LEGAL DIMENSIONS OR LOCATIONS OF PROPERTY OWNERSHIP LINES