


Claim of Beneficial Use - Horton
Application R-88774, Permit R-15403

Township 10S, Range 5W, W.M.

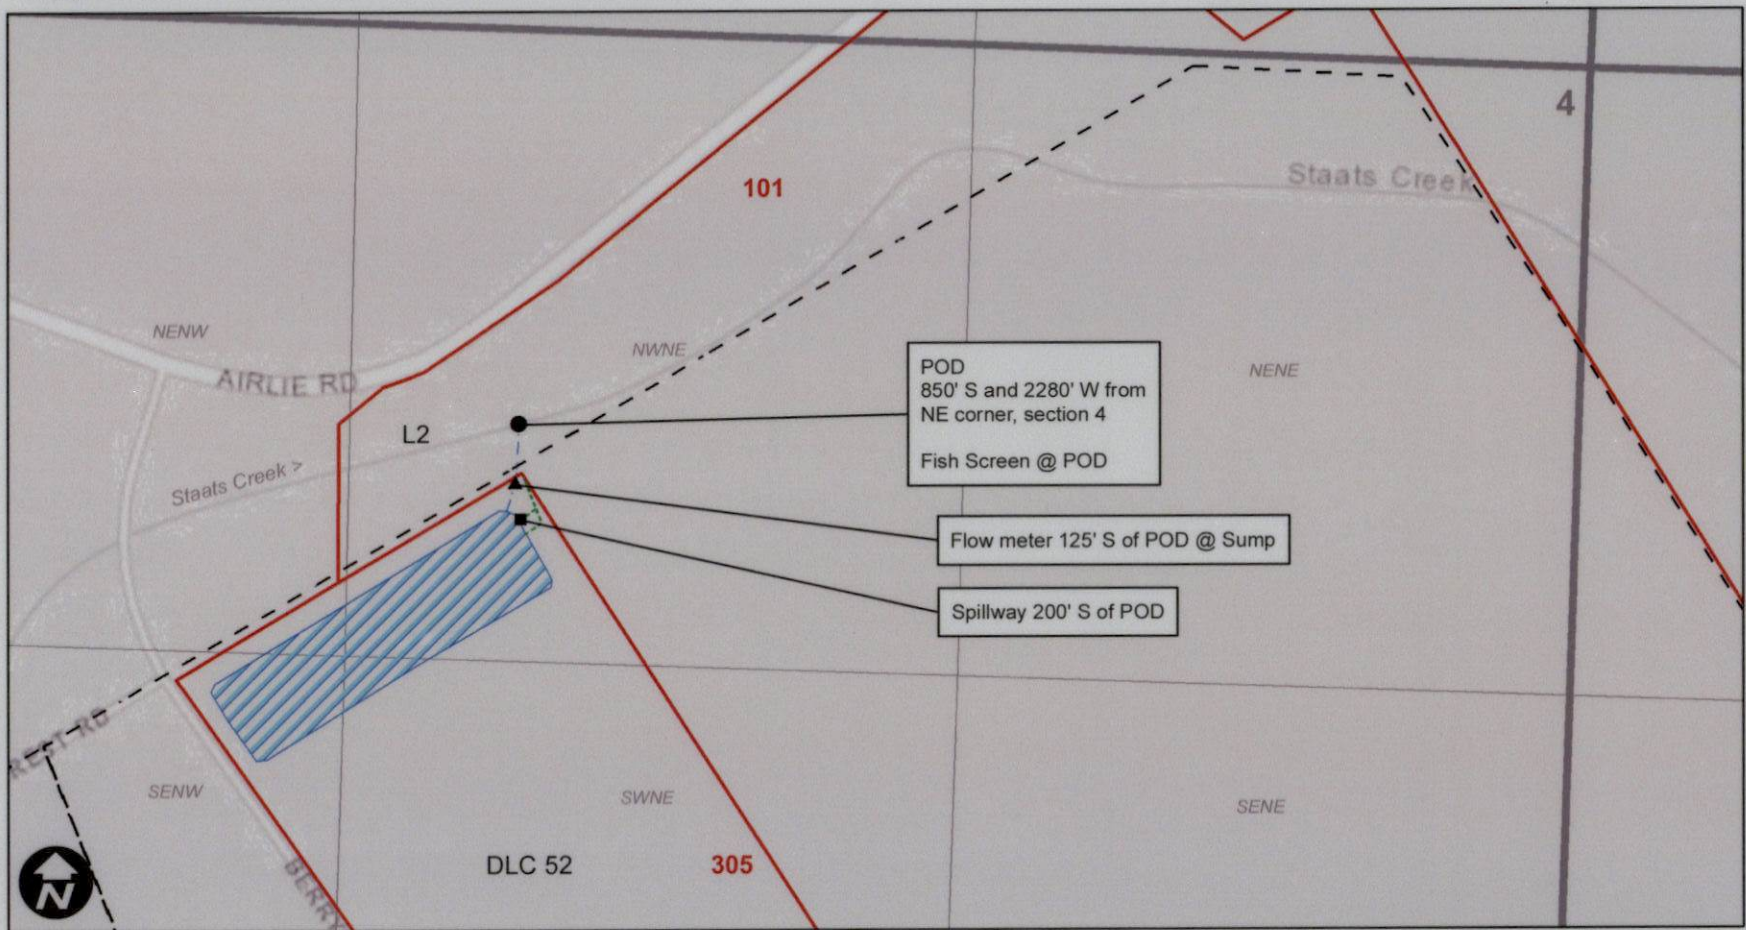

This map is not intended to provide legal dimensions or locations of property ownership lines.

Legend

- R-15403 Storage Area
- Mainline
- Outlet
- Sump
- Spillway
- DLC
- Taxlot

Received by OWRD

SEP 03 2025

Salem, OR

