


**T4S, R3W WM, Section 29
Yamhill County, Oregon
Application S-88705, Permit S-55254**

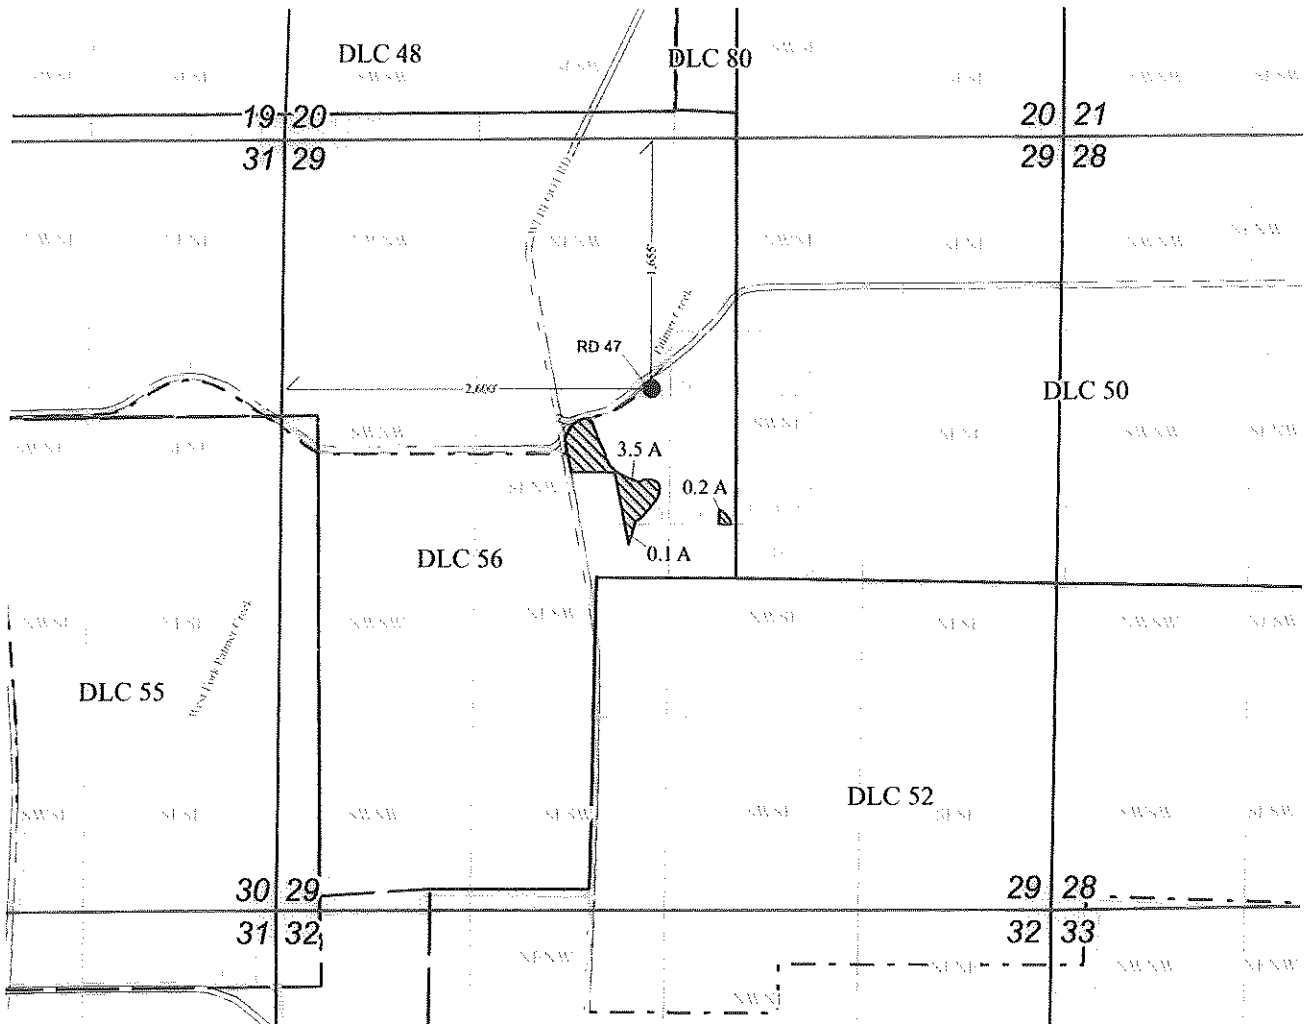

Re-diversion is located 1,655' south and 2,600' east from the NW corner of Section 29. PCWDIC POD is located 4,700' north and 1,290' east from SE corner of DLC 58 (see Map 3 of 3).

0 330 660 990 1,320 ft

1 inch = 1,320 feet

Explanation

- | | | |
|----------------------------------|-----------|--|
| Area to be irrigated (3.8 Acres) | Tax Lots | - - - Mainline |
| Section | Waterbody | Re-diversion (RD 47) Pump and Meter at Patterson Bulge |
| Qtr Qtr | Streams | |
| DLC | Roads | |

NAD 1983 HARN
Datum of 1983
Prepared Aug 11, 2025


Sources: BLM CaNSDH PLSS, roads, county lines & tax lots (Pacific Hydro-Geology), Oregon Spatial Data Library water features, DLC lines, et al.

This map was prepared for the purpose of identifying the location of a water right only and is not intended to provide legal dimensions or locations of a property.



**CLAIM OF BENEFICIAL USE
Map 1 of 3
Palmer Creek Water Improvement
District**

**T5S, R3W WM, Section 32
T6S, R3W WM, Section 04 & 05
Yamhill & Polk County, Oregon
Application S-88705, Permit S-55254**

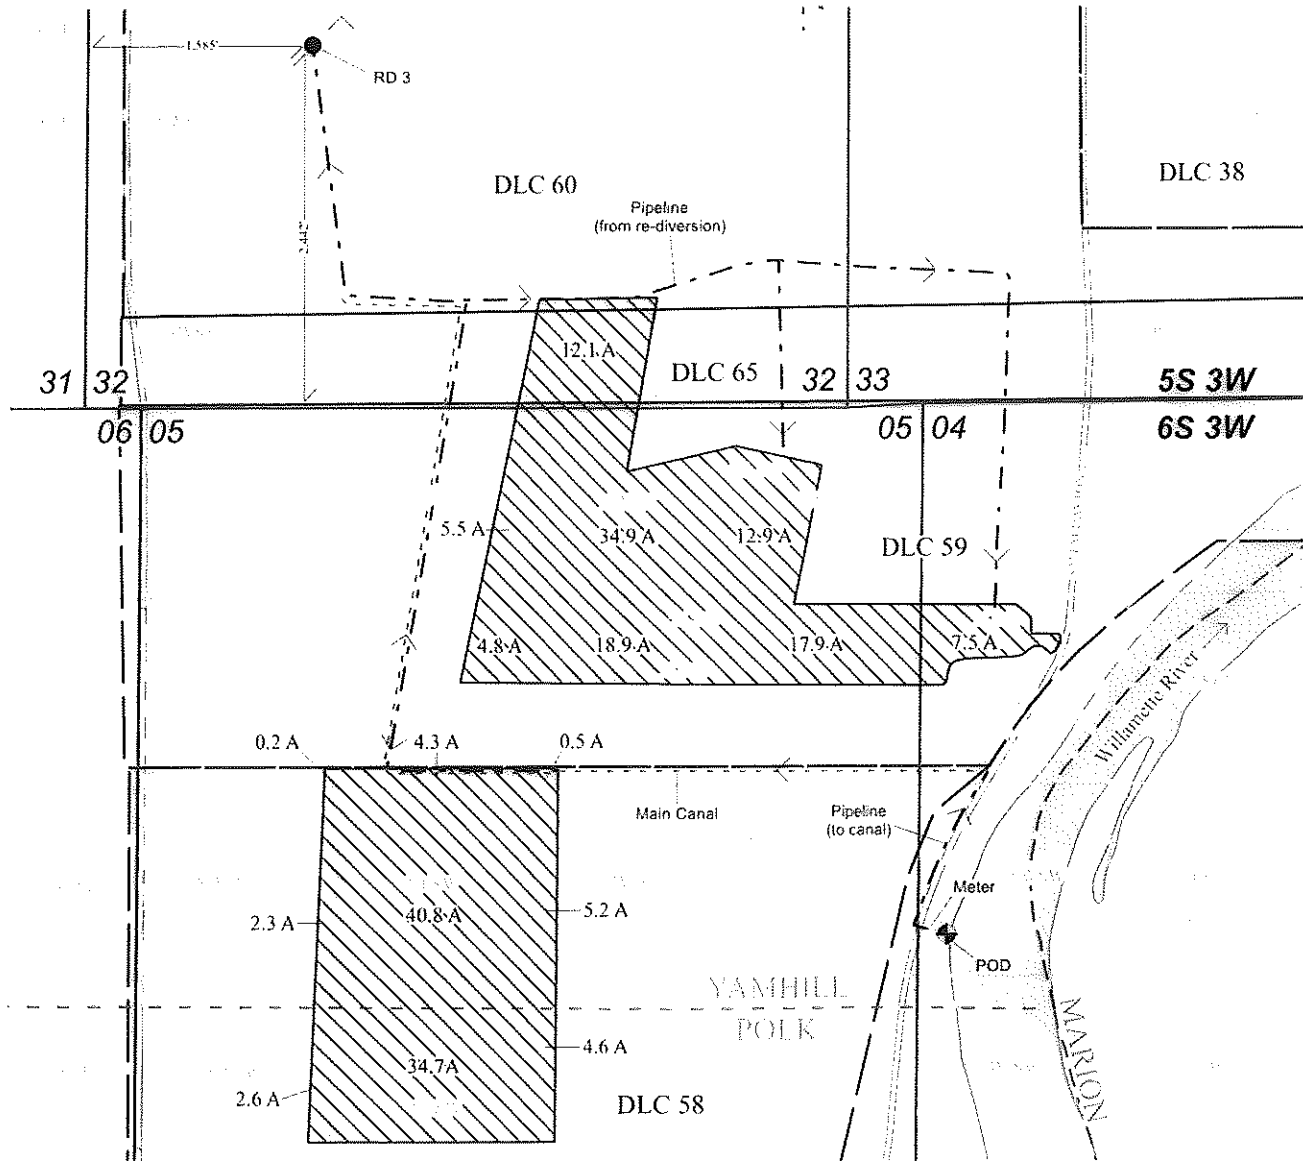

Re-diversion is located 2,442' north and 1,585' east from the SW corner of Section 32. PCWDIC POD is located 4,700' north and 1,290' east from SE corner of DLC 58 (see Map 3 of 3).

0 330 660 990 1,320 ft
1 inch = 1,320 feet

Explanation


- | | | |
|------------------------------------|-----------|------------------------------------|
| Area to be irrigated (209.7 Acres) | Tax Lots | Mainline |
| Section | Waterbody | Re-diversion (RD 3) Pump and Meter |
| Qtr Qtr | Streams | POD |
| DLC | Roads | |

NAD 1983 HARN
Datum of 1983
Prepared Aug 11, 2025

Sources: BLM CadNSDI PLSS, roads, county lines & tax lots (Pacific Hydro-Geology), Oregon Spatial Data Library water features, DLC lines, et al


This map was prepared for the purpose of identifying the location of a water right only and is not intended to provide legal dimensions or locations of a property.

EnviroLogic Resources, Inc.
ENVIRONMENTAL WATER RESOURCES SOLUTIONS

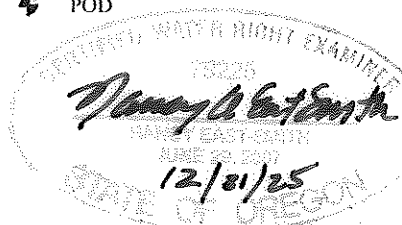

**CLAIM OF BENEFICIAL USE
Map 2 of 3
Palmer Creek Water Improvement District**

**T6S, R3W WM, Section 4 & 5
Yamhill County, Oregon
Application S-88705, Permit S-55254**

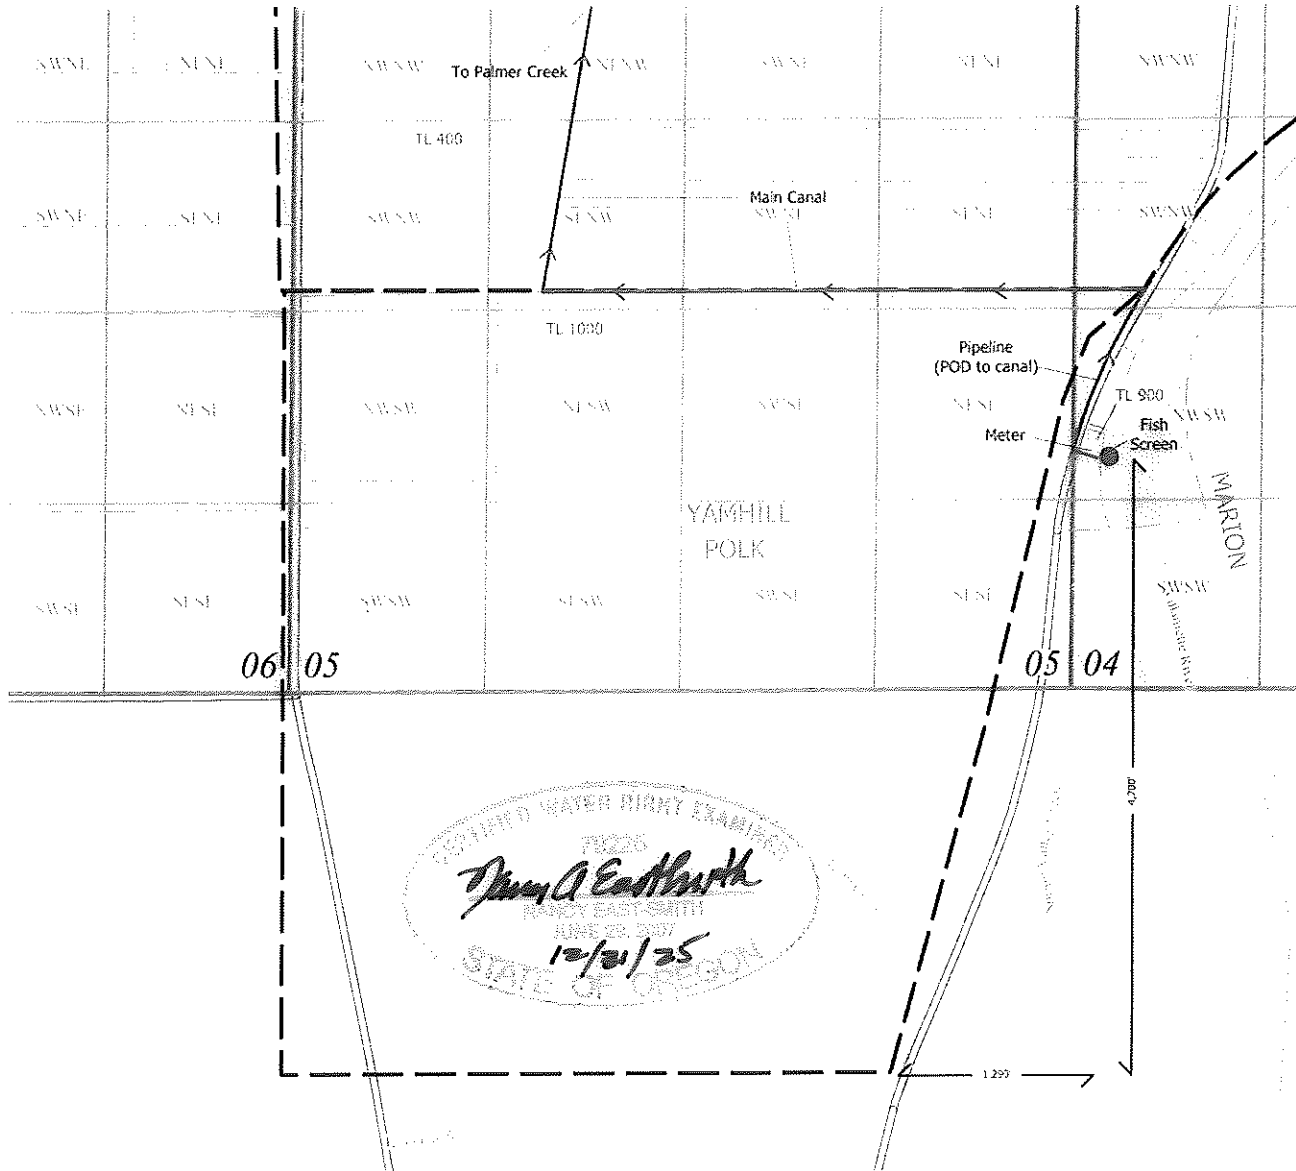

POD is located 4,700' N and 1,290' E from the SE corner of DLC 58, T6S, R3W, Sec. 4, NW 1/4 SW1/4

0 330 660 990 1,320 ft
1 inch = 1,320 feet

Explanation

- | | | | |
|-------------|---------|---------|--------------------|
| County Line | DLC | Roads | Main Canal |
| Section | Taxlots | Streams | Point of diversion |

NAD 1983 HARN
Datum of 1983
Prepared July 07, 2025

Sources: BLM CadHSD1 PLSS, roads, county lines & tax lots (Yamhill County), Oregon Spatial Data Library water features, DLC lines, et al. Locations of proposed wells and points of use provided by client.

This map was prepared for the purpose of identifying the location of a water right only and is not intended to provide legal dimensions or locations of property ownership lines.



**CLAIM OF BENEFICIAL USE
Map 3 of 3
Palmer Creek Water District
Improvement Company**

EnviroLogic Resources, Inc.
ENVIRONMENTAL • WATER RESOURCES CONSULTANTS