



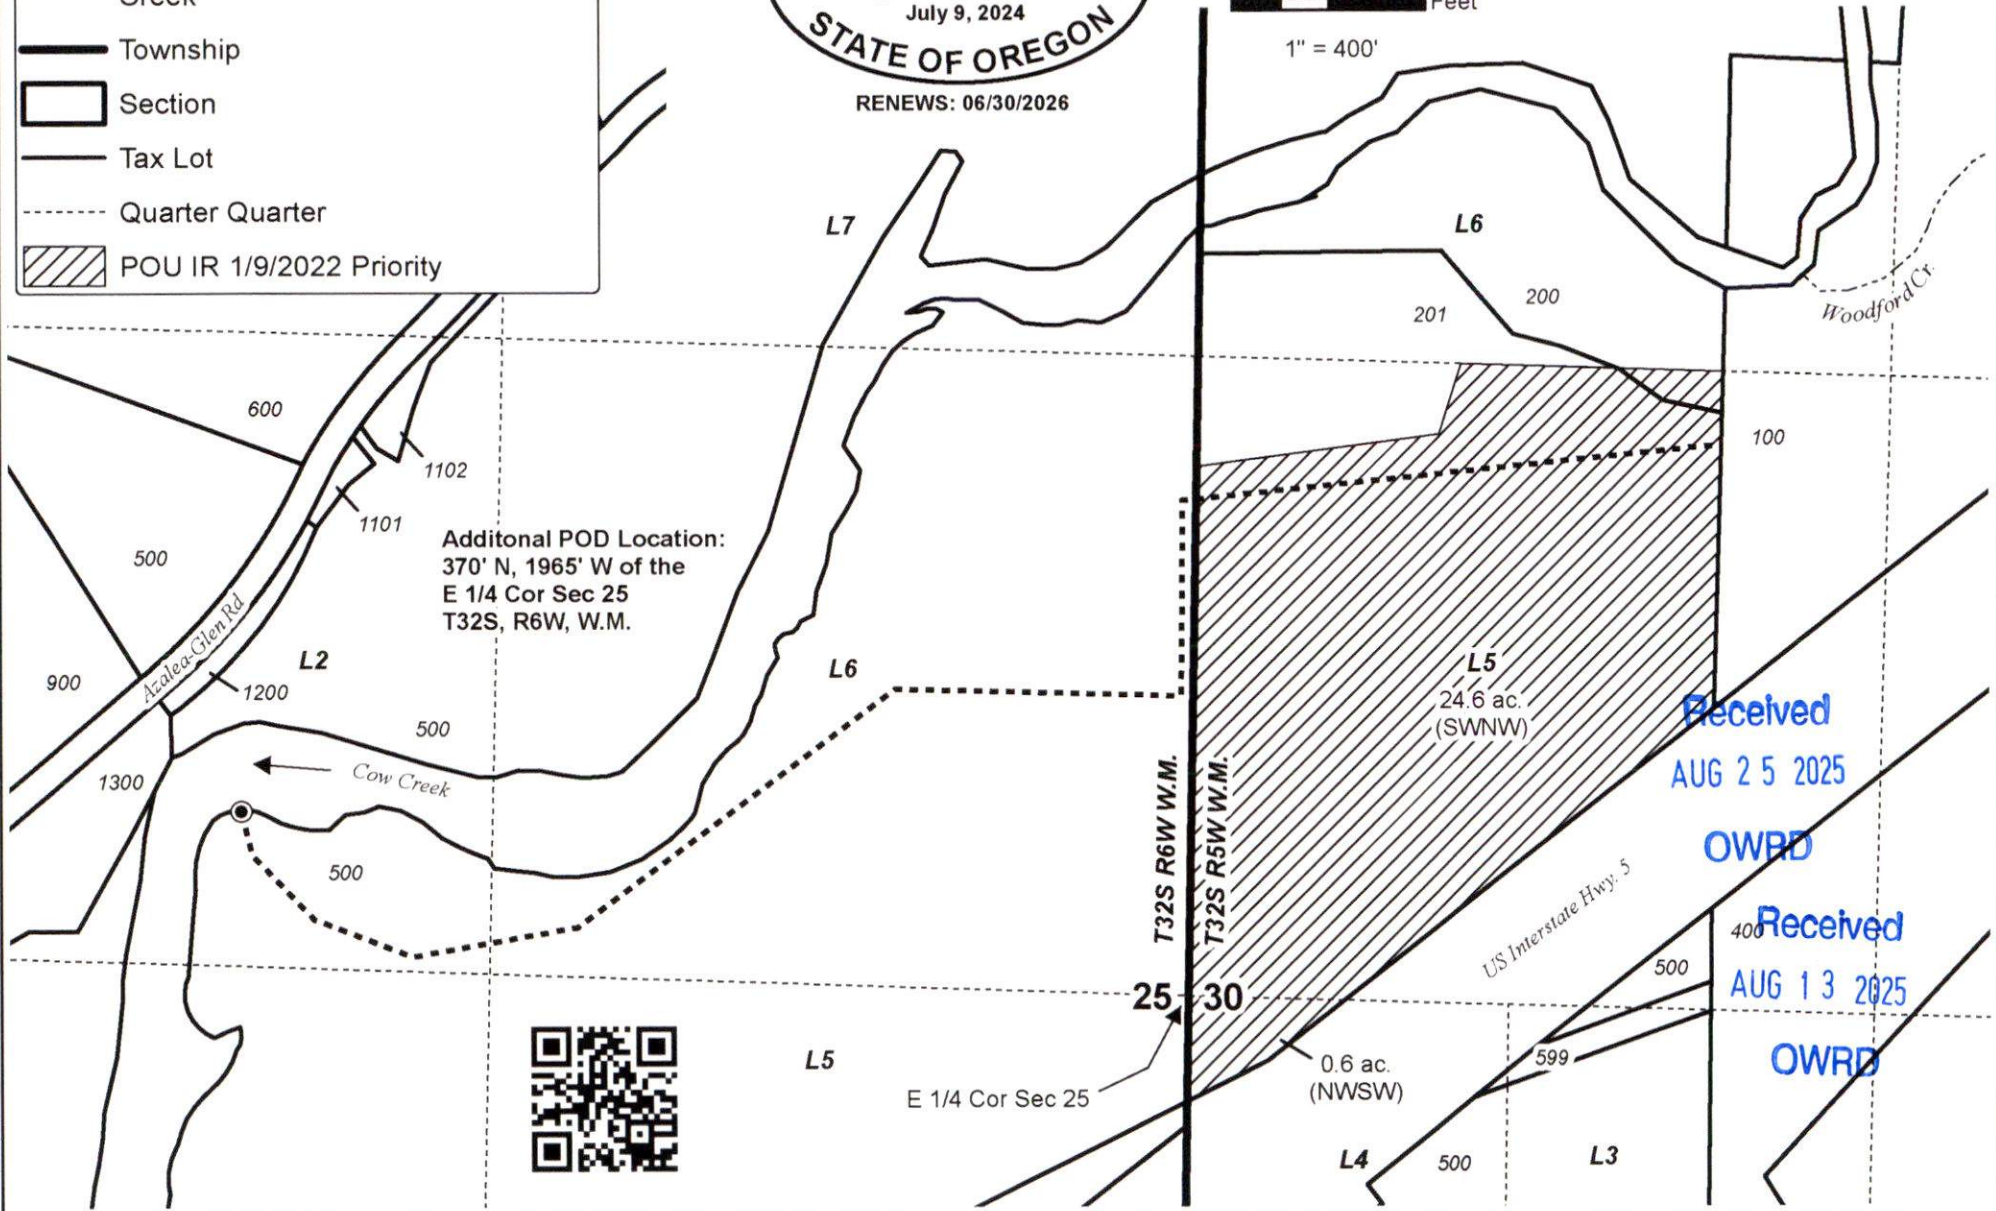

**T32S R5W &
T32S R6W, WM
DOUGLAS COUNTY, OR**

- Additional POD, Fish Screen, Meter
- Pipeline
- - - - - Creek
- Township
- Section
- Tax Lot
- - - - - Quarter Quarter
- ▨ POU IR 1/9/2022 Priority

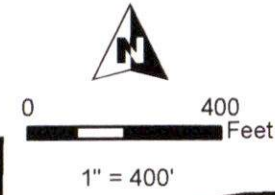

Received
AUG 25 2025
OWRD
Received
AUG 13 2025
OWRD



**CLAIM OF BENEFICIAL USE MAP
Owens**

Date: 7/29/2025 T-11627 (Additional Point of Diversion Transfer)

This map is not intended to provide legal dimensions or locations of property ownership lines.

WATER RIGHT SERVICES, LLC
PO BOX 1830, BEND, OR 97709
WWW.OREGONWATER.US CCB # 197121
brycewrs@gmail.com 541-389-2837