



# T.3S. R.3W. Sec. 22 & 27, W.M.

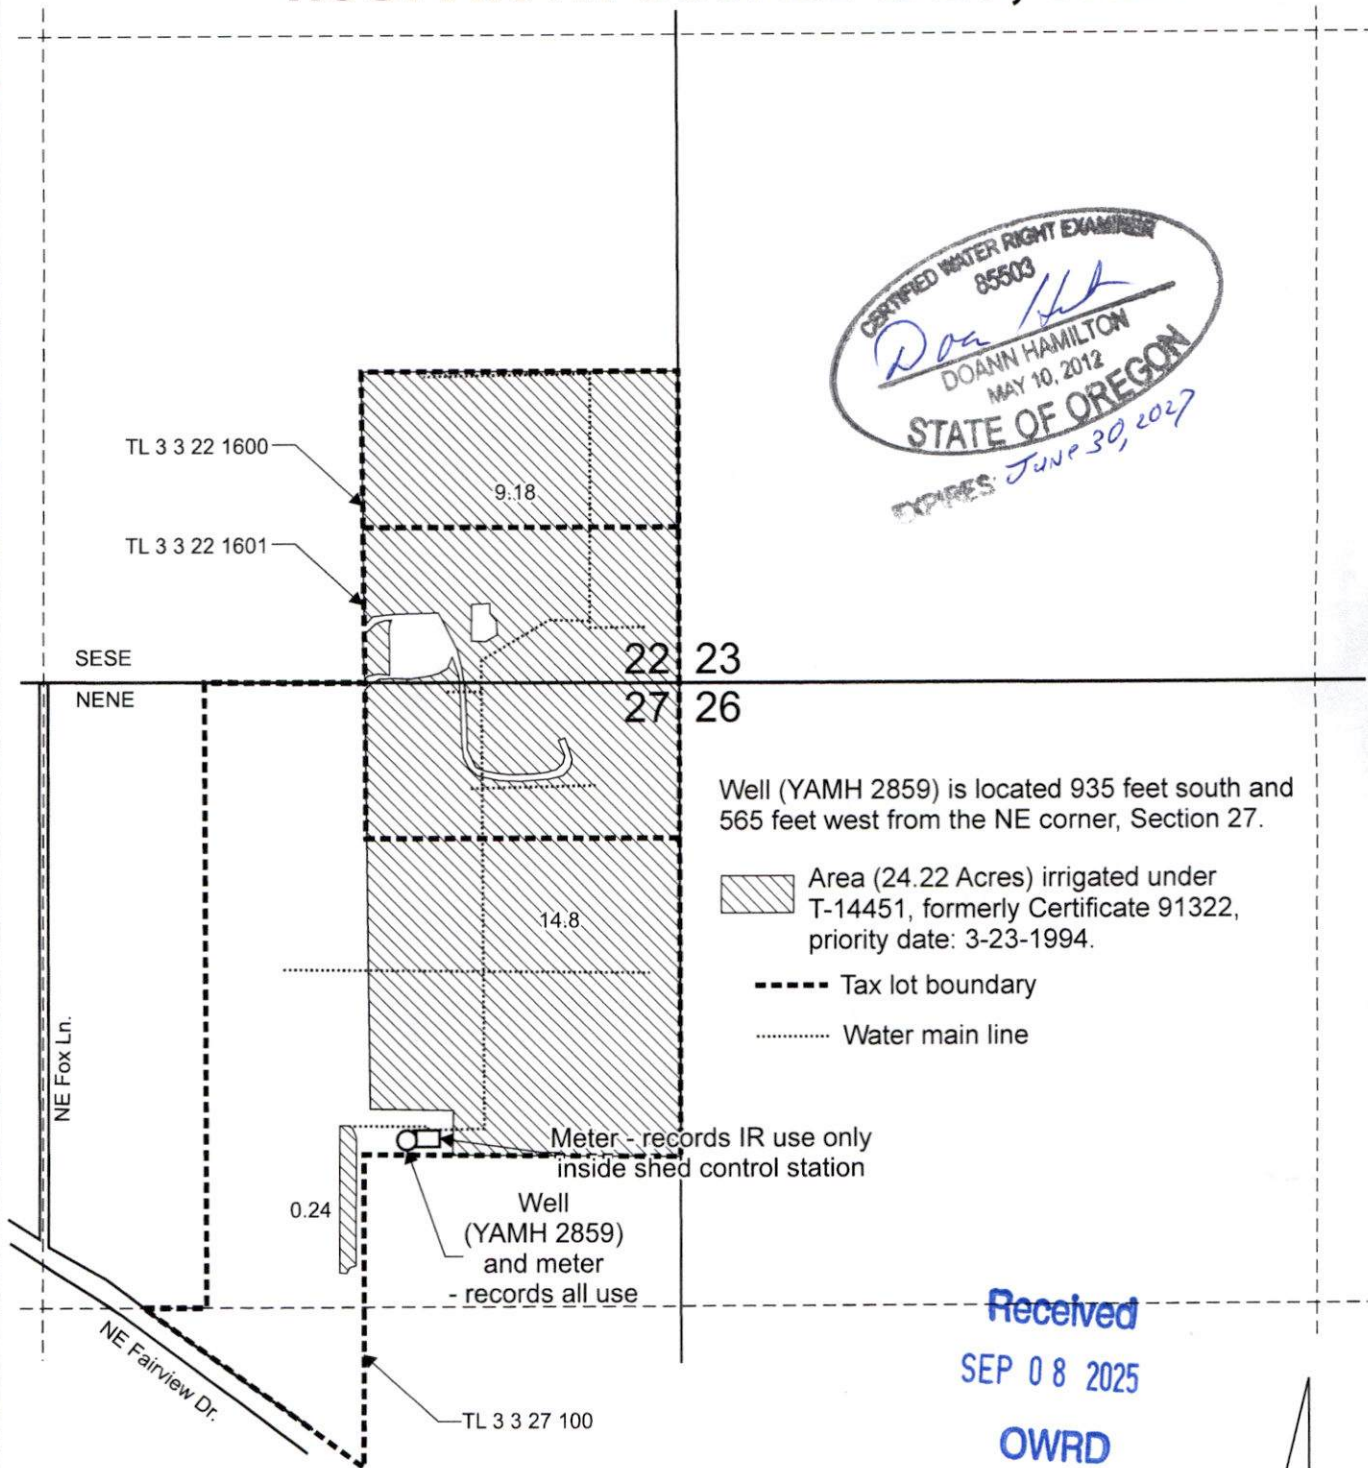

Received  
SEP 08 2025  
OWRD

Scale: 1" = 400'

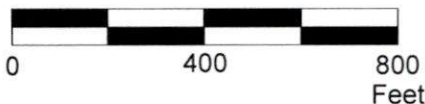

This map was prepared for the purpose of identifying the location of a water right only and is not intended to provide legal dimensions or location of property ownership lines.

Claim of Beneficial Use Map  
T-14451, formerly Certificate 91322

Pine Ridge Associates  
T.3S. R.3W. Sec. 22 & 27, W.M.

Pacific Hydro-Geology Inc.

09/2025