


# T.3S. R.3W. Section 34 and T.4S. R.3W. Section 3, W.M.

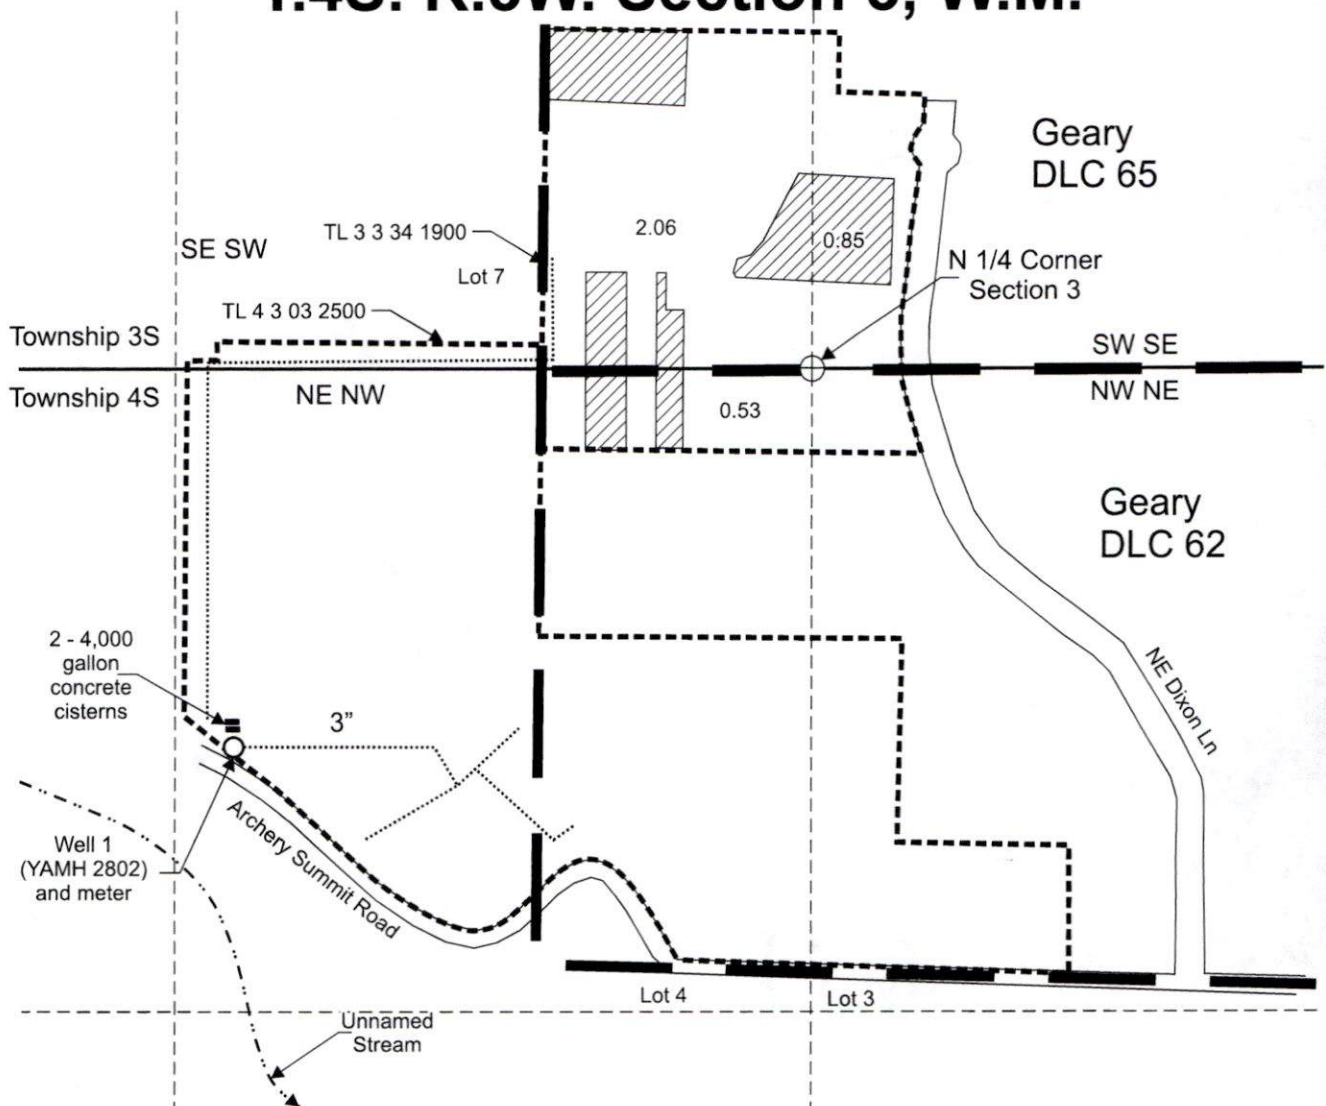

Well 1 (YAMH 2802) is located 770 feet south and 1,200 feet west from the north 1/4 corner, Section 3.

 Area (3.44 acres) irrigated by T-14452, formerly Certificate 91321, priority date: 3-23-1994.

----- Tax lot boundary

— Donation Land Claim Boundary

Received


SEP 08 2025

OWRD



This map was prepared for the purpose of identifying the location of a water right only and is not intended to provide legal dimensions or location of property ownership lines.

Scale: 1" = 400'

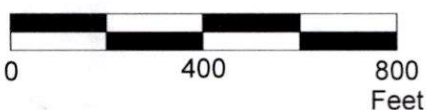

Pacific Hydro-Geology Inc.

09/2025

Claim of Beneficial Use Map  
T-14452, formerly Certificate 91321

Pine Ridge Associates  
T.3S R.3W. Section 34 and  
T.4S. R.3W. Section 3, W.M.