


T.6S. R.2W. Section 7, W.M.

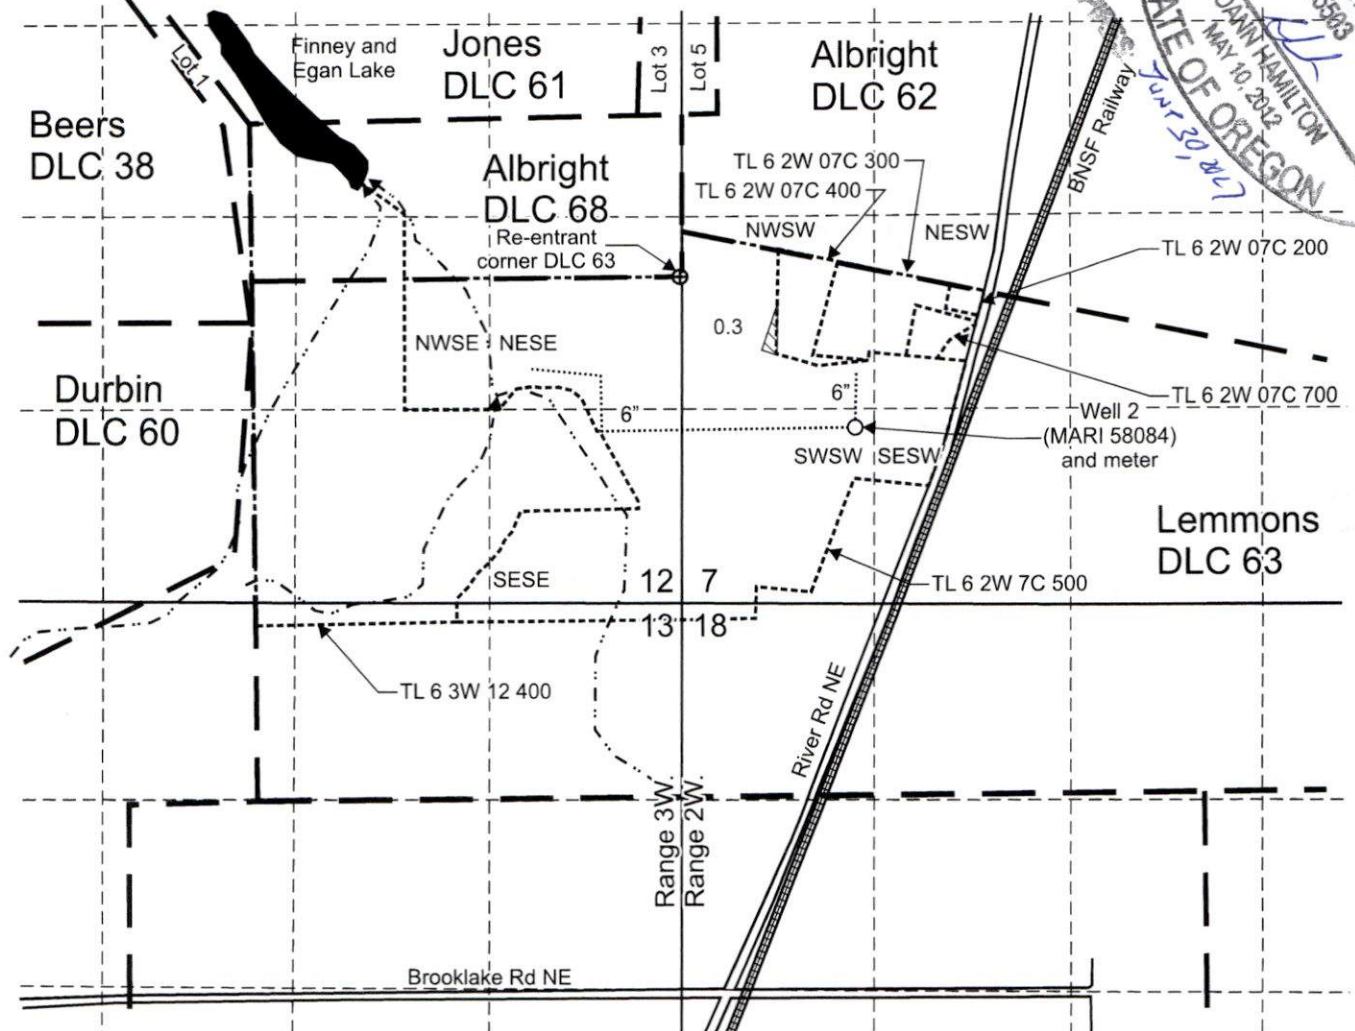

Well 2 (MARI 58084) is located 1,025 feet south and 1,205 feet east from the S re-entrant corner, DLC 68.

 Area (0.3 Acres) irrigated under T-14058, formerly Certificate 95408, priority date: 12-13-1965.

----- Tax lot boundary

— • — Donation Land Claim boundary

..... Water main line (note: portable lateral hand lines off mainline to POU.)

Received
SEP 10 2025
OWRD

Scale: 1" = 1,320'



This map was prepared for the purpose of identifying the location of a water right only and is not intended to provide legal dimensions or location of property ownership lines.

Claim of Beneficial Use Map
T-14058, formerly Certificate 95408

Chapin Investments, LLC,
T.6S. R.2W. Section 7, W.M.

Pacific Hydro-Geology Inc.

09/2025