


Received
SEP 12 2025
OWRD

CLAIM of BENEFICIAL USE

FOR: GARY WRIGHT, TRUSTEE
GARY A. & MONICA K. WRIGHT LIVING TRUST
BY: NATHAN REED, PE, CWRE
T27S, R4W, W.M. SECTION 22
TRANSFER No.: T-12995

DATE OF SURVEY: AUGUST 26, 2025


SCALE: 1" = 400'

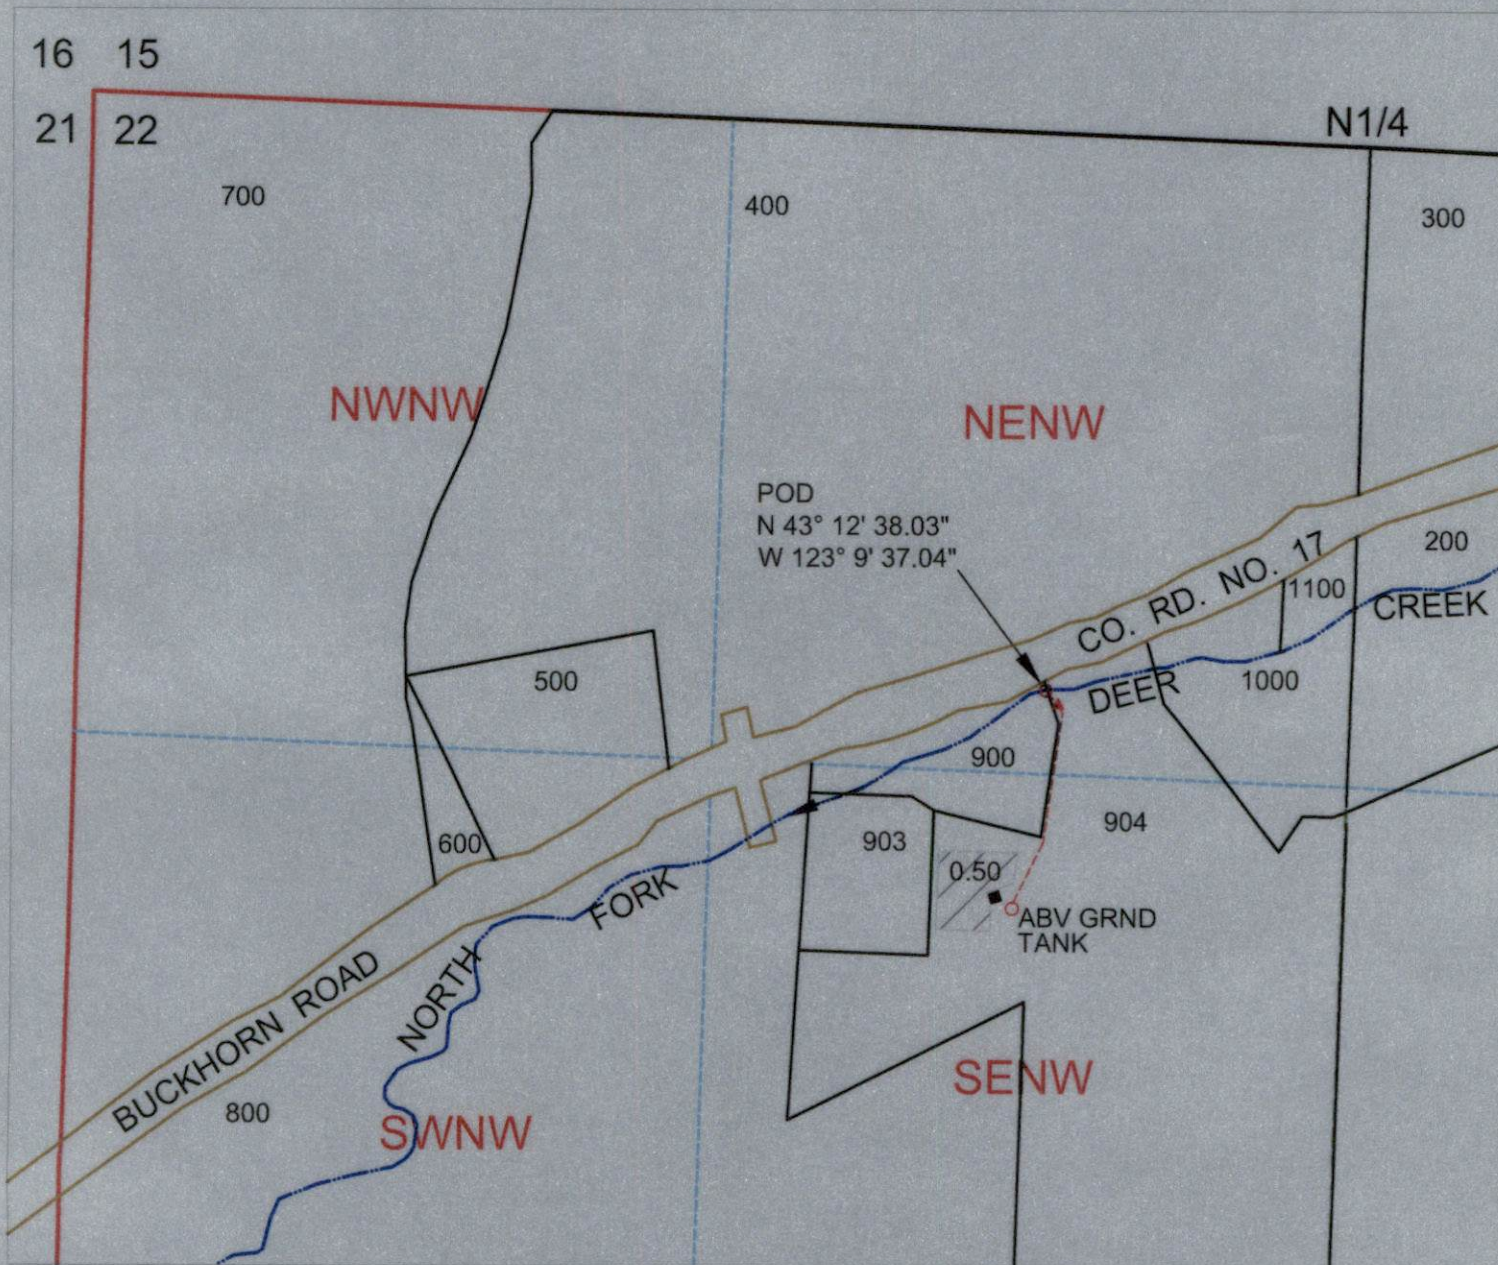

POD IS LOCATED 1220 FEET SOUTH & 700 FEET WEST OF N1/4 CORNER OF SECTION 22.

LEGEND

- | | | | |
|--|--------|--|-----------------|
| | WATER | | SECTION |
| | POD | | QUARTER |
| | PUMP | | SIXTEENTH |
| | TANK | | DLC |
| | PIPE | | GLOT |
| | PARCEL | | IRRIGATION AREA |

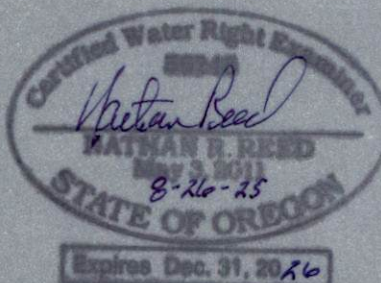

MAP PREPARED FOR:
MARK WRIGHT, TRUSTEE
6856 CASUAL COURT
SAN JOSE, CA 95120
95120 myw

MAP PREPARED BY:
NATHAN REED PE, CWRE
157 WEST BODIE STREET
ROSEBURG, OR 97471

THE PURPOSE OF THIS MAP IS TO IDENTIFY THE LOCATION OF THE WATER RIGHT. IT IS NOT INTENDED TO PROVIDE INFORMATION RELATIVE TO THE LOCATION OF PROPERTY OWNERSHIP BOUNDARY LINES.