Wintersogn Farms, LLC - Claim of Beneficial Use
Application G-18586, Permit G-18863

Township 29S, Range 14W, W.M.

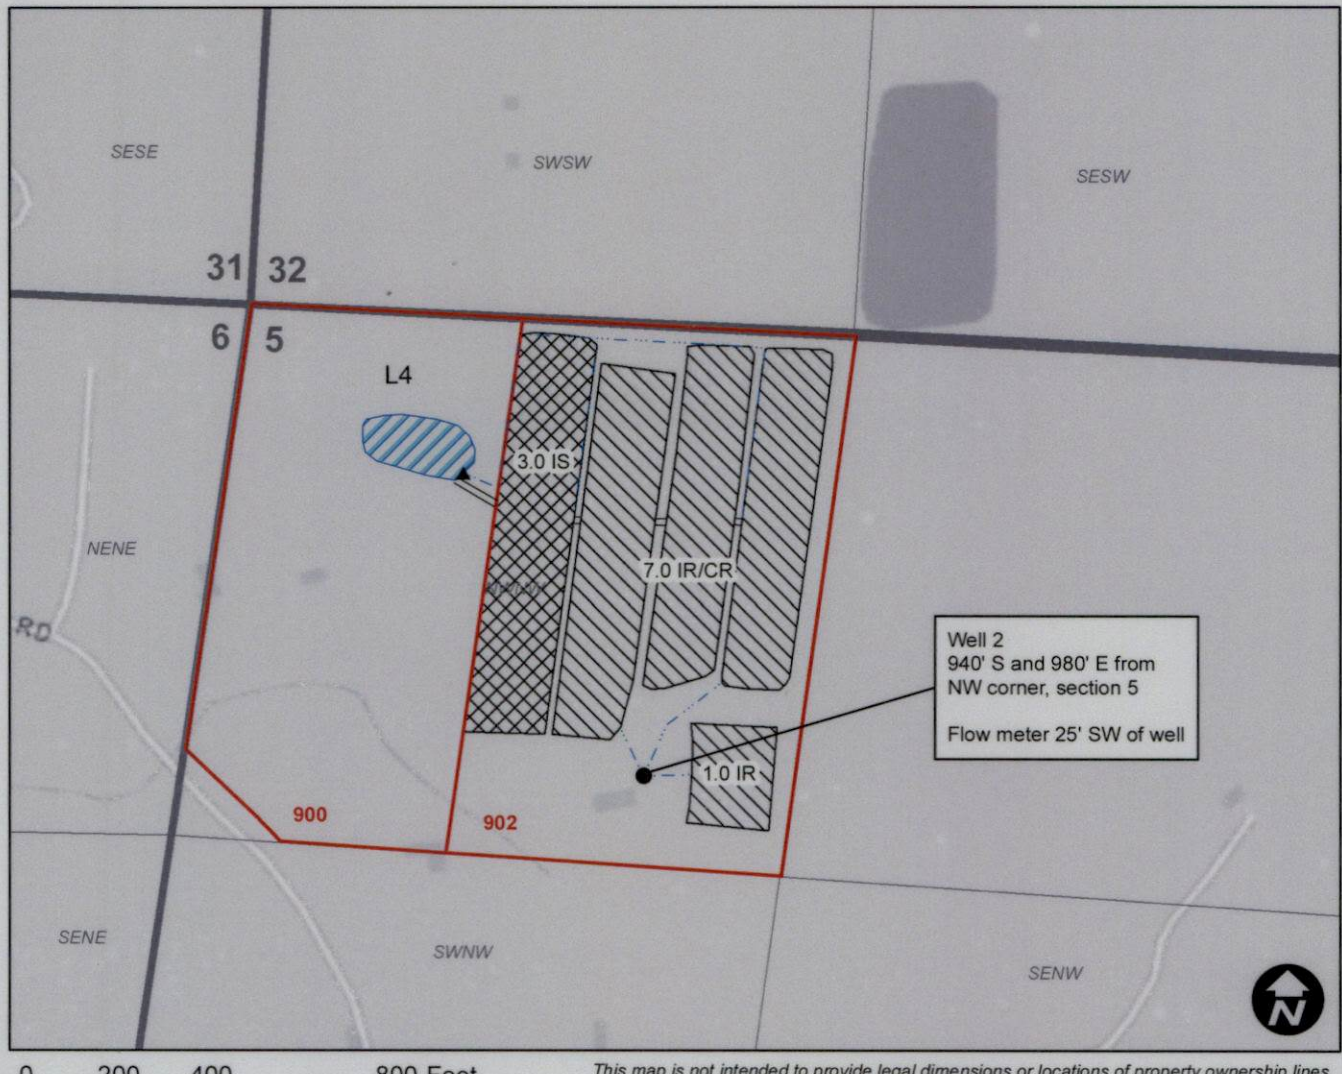

0 200 400 800 Feet

This map is not intended to provide legal dimensions or locations of property ownership lines.

Domestic use all within TL 900 & 902, NWNW, sec. 5

Legend

- IR POU
- IS POU
- Mainline
- Bulge
- Bulge Pump Site
- Bog Drain
- Taxlot

CERTIFIED WATER RIGHT EXAMINER
46315
GALEN McGILL
MAY 11, 2021
STATE OF OREGON

EXPIRES:

Received by OWRD
AUG 26 2025
Salem, OR

WILL MCGILL SURVEYING LLC