


Claim of Beneficial Use

Transfer T-14097

A Water Right held by Brewster Road LLC
Linn County

Received
SEP 17 2025

OWRD

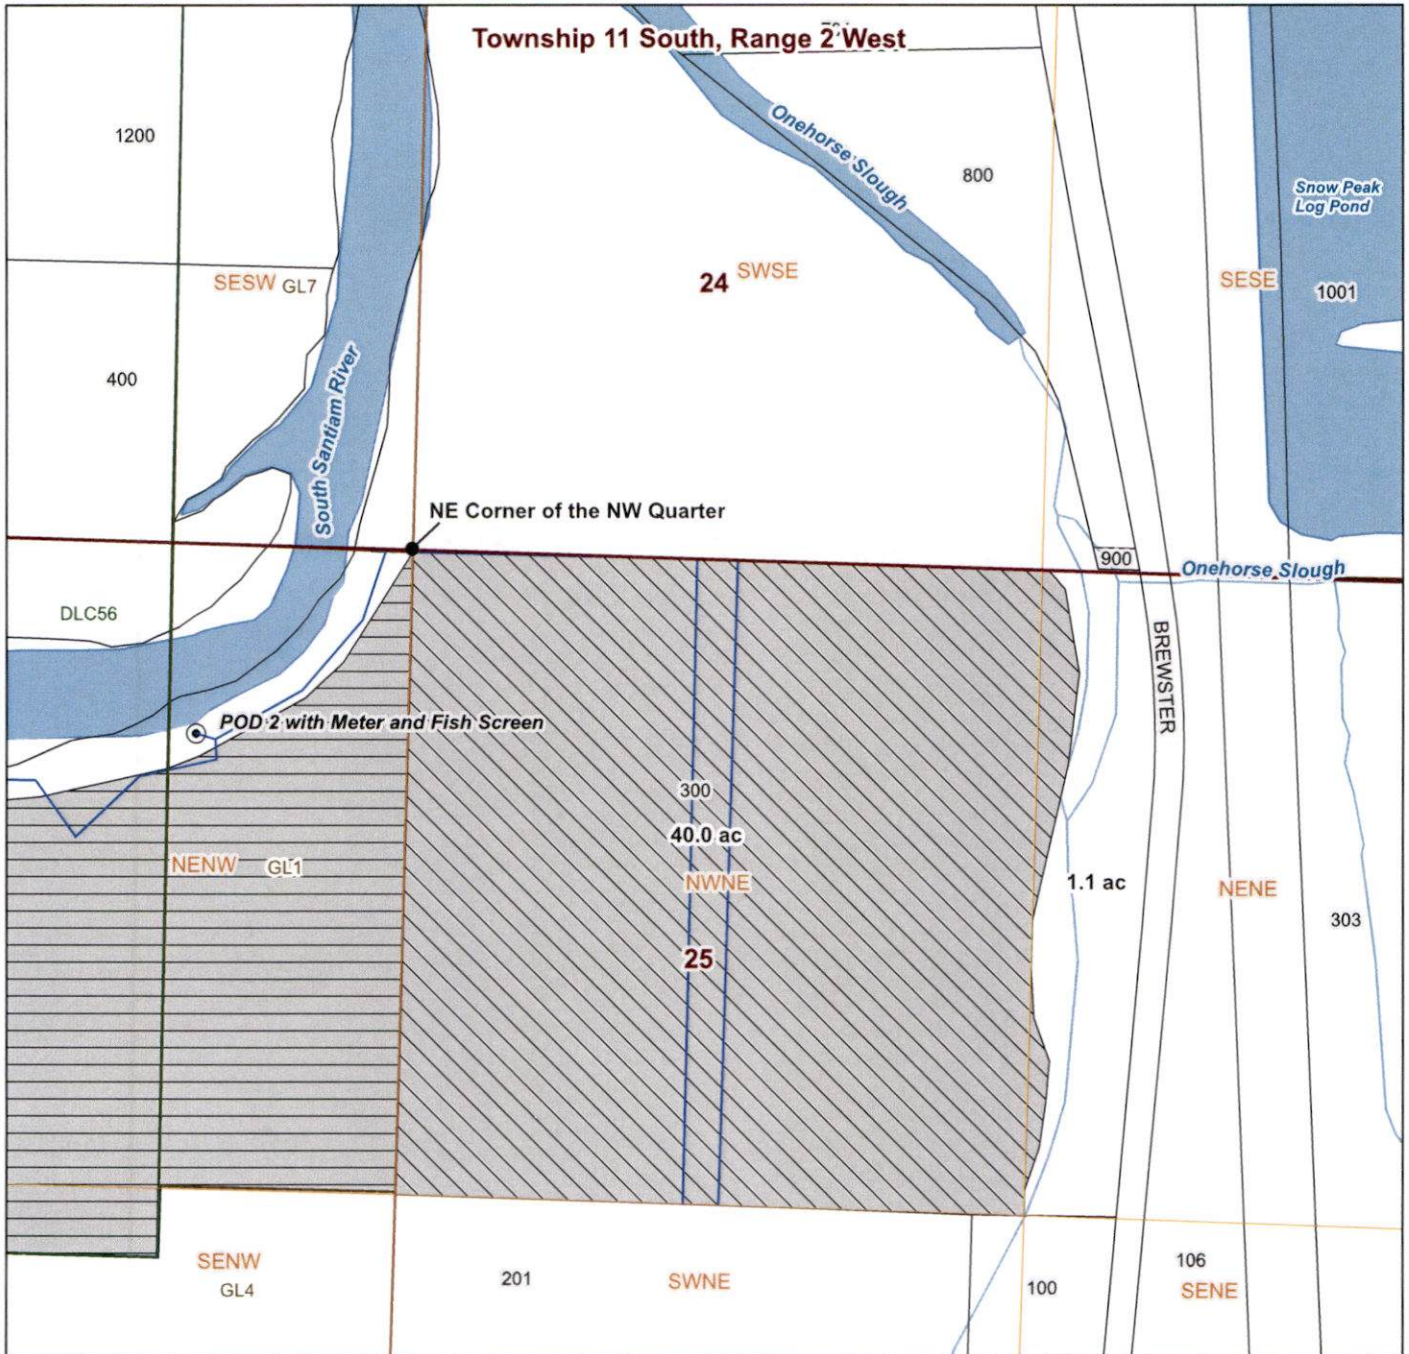


LEGEND

- Point of Diversion (POD)
- Mainlines
- ▨ T-14097 Place of Use (POU), 41.1 ac IR
- ▨ Certificate 86665 Place Of Use (POU)
- Tax Lots
- Watercourse
- Waterbody

POD Location Description

POD 2

350 feet west, 390 feet south from the NE corner of the NW Quarter of Section 25 (NENW), Township 11 South, Range 2 West, W.M.

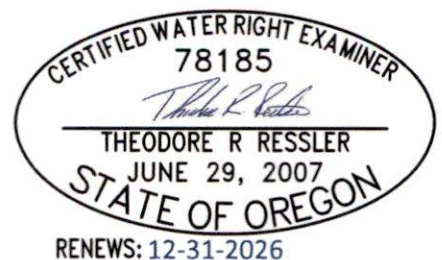

Scale
0 200 400 ft
1-inch = 400 feet

Date: 8/18/2025
Data Sources: BLM, ESRI, OWRD, USGS, Linn County
Disclaimer: This map is not intended to provide legal dimensions or property ownership lines.

