



Claim of Beneficial Use
Transfer T-14274 (Portion of Certificate 83682)

A Water Right held by City of Brookings
Curry County

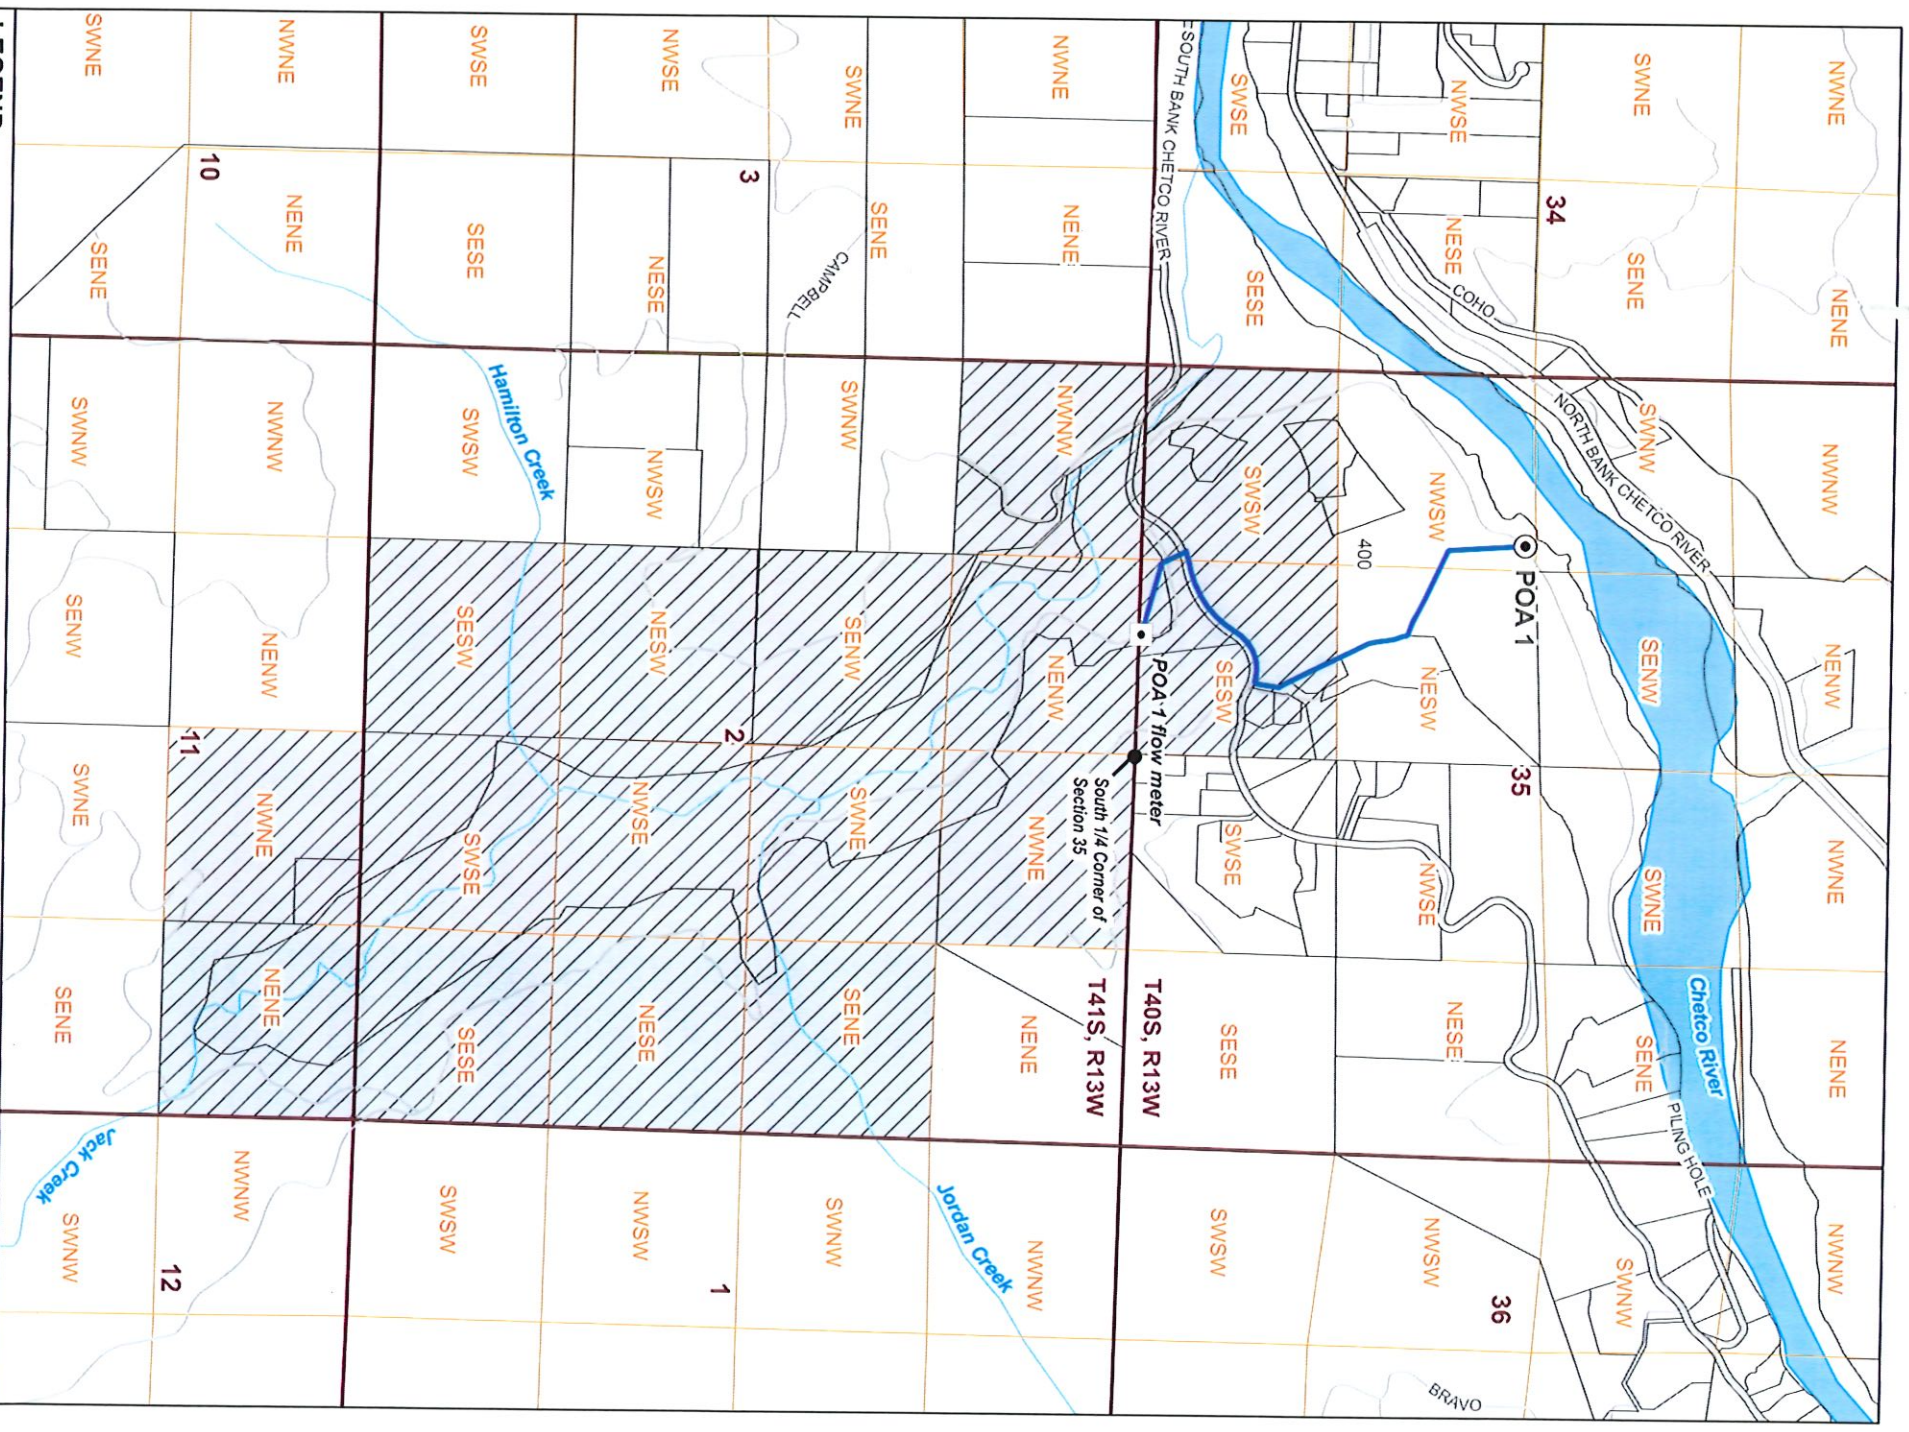

LEGEND

- Point of Appropriation (POA)
- Place of Use (POU)
- Water Mainline
- Watercourse
- Roads
- Taxlots
- Remote Flow Meter

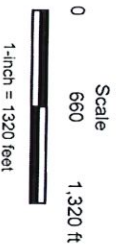

POD Location Description

POA 1
Located 2,570 feet North and 1,380 feet West from
the S1/4 corner of Section 35 (NWSW), Township 40
South, Range 13 West, W.M.

Received

SEP 19 2025

OWRD

RENEWS: 12-31-2026

