


# T.6S. R.2W. Section 35 T.7S. R.2W. Section 2, W.M.

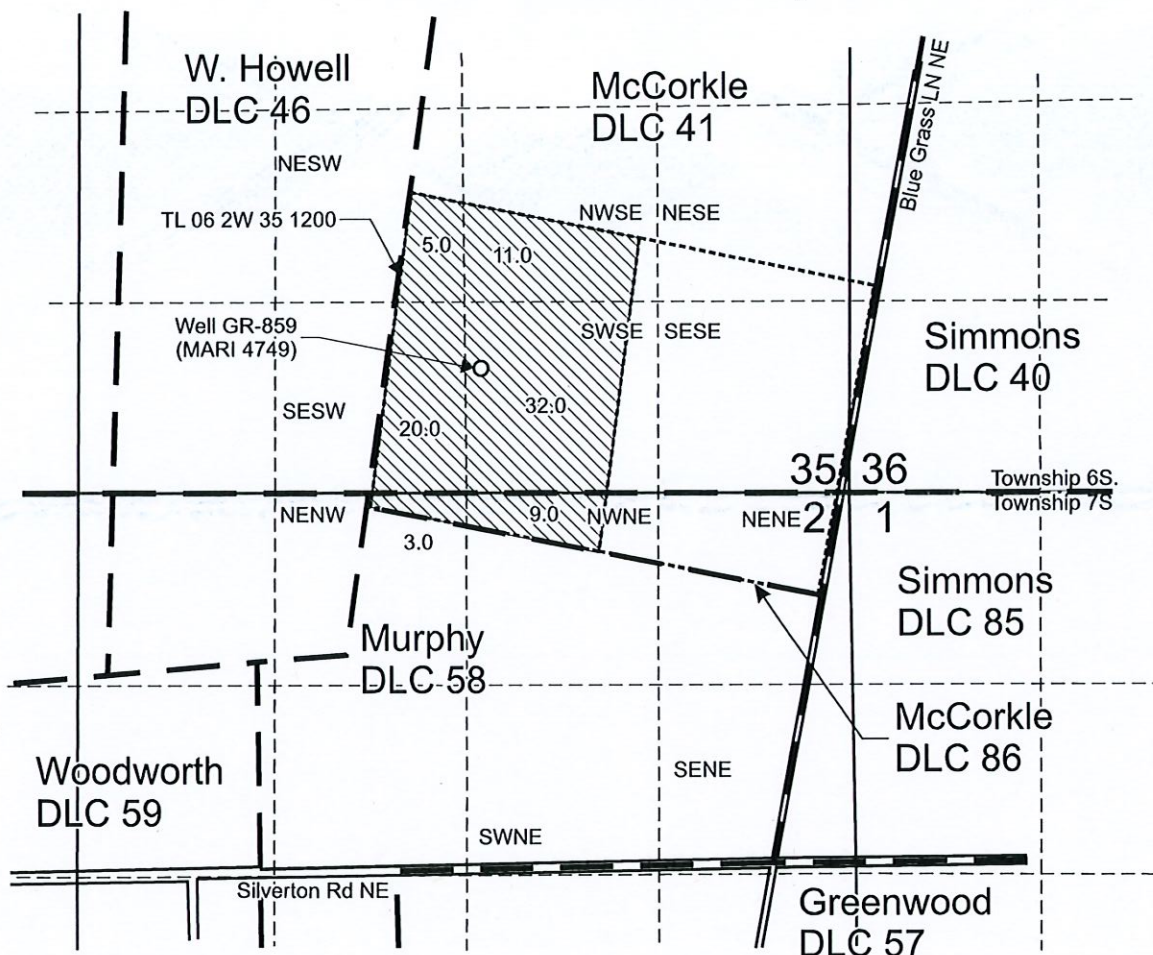

GR-859 Well (MARI 4749) west 17 degrees north 2,640 feet from SE corner, Section 35.

Area (80.0 Acres) irrigated under GR-859, priority date 2-10-1954 to be assigned to Jensen Family LLC.

----- Tax lot boundary

— • Donation Land Claim boundary



Scale: 1" = 1,320'



This map was prepared for the purpose of identifying the location of a water right only and is not intended to provide legal dimensions or location of property ownership lines.



Pacific Hydro-Geology Inc.

12/2024

Assignment Map  
GR-859  
Jensen Family LLC.  
T.6S. R.2W. Section 35,  
T.7S. R.2W. Section 2, W.M.

Received

DEC 18 2024

OWRD

J:\InstantLawn\GR-859ModMap.cdr