


# Claim of Beneficial Use - Tarrillo

## Application R-87767, Permit R-14983

Township 9S, Range 3W, W.M.

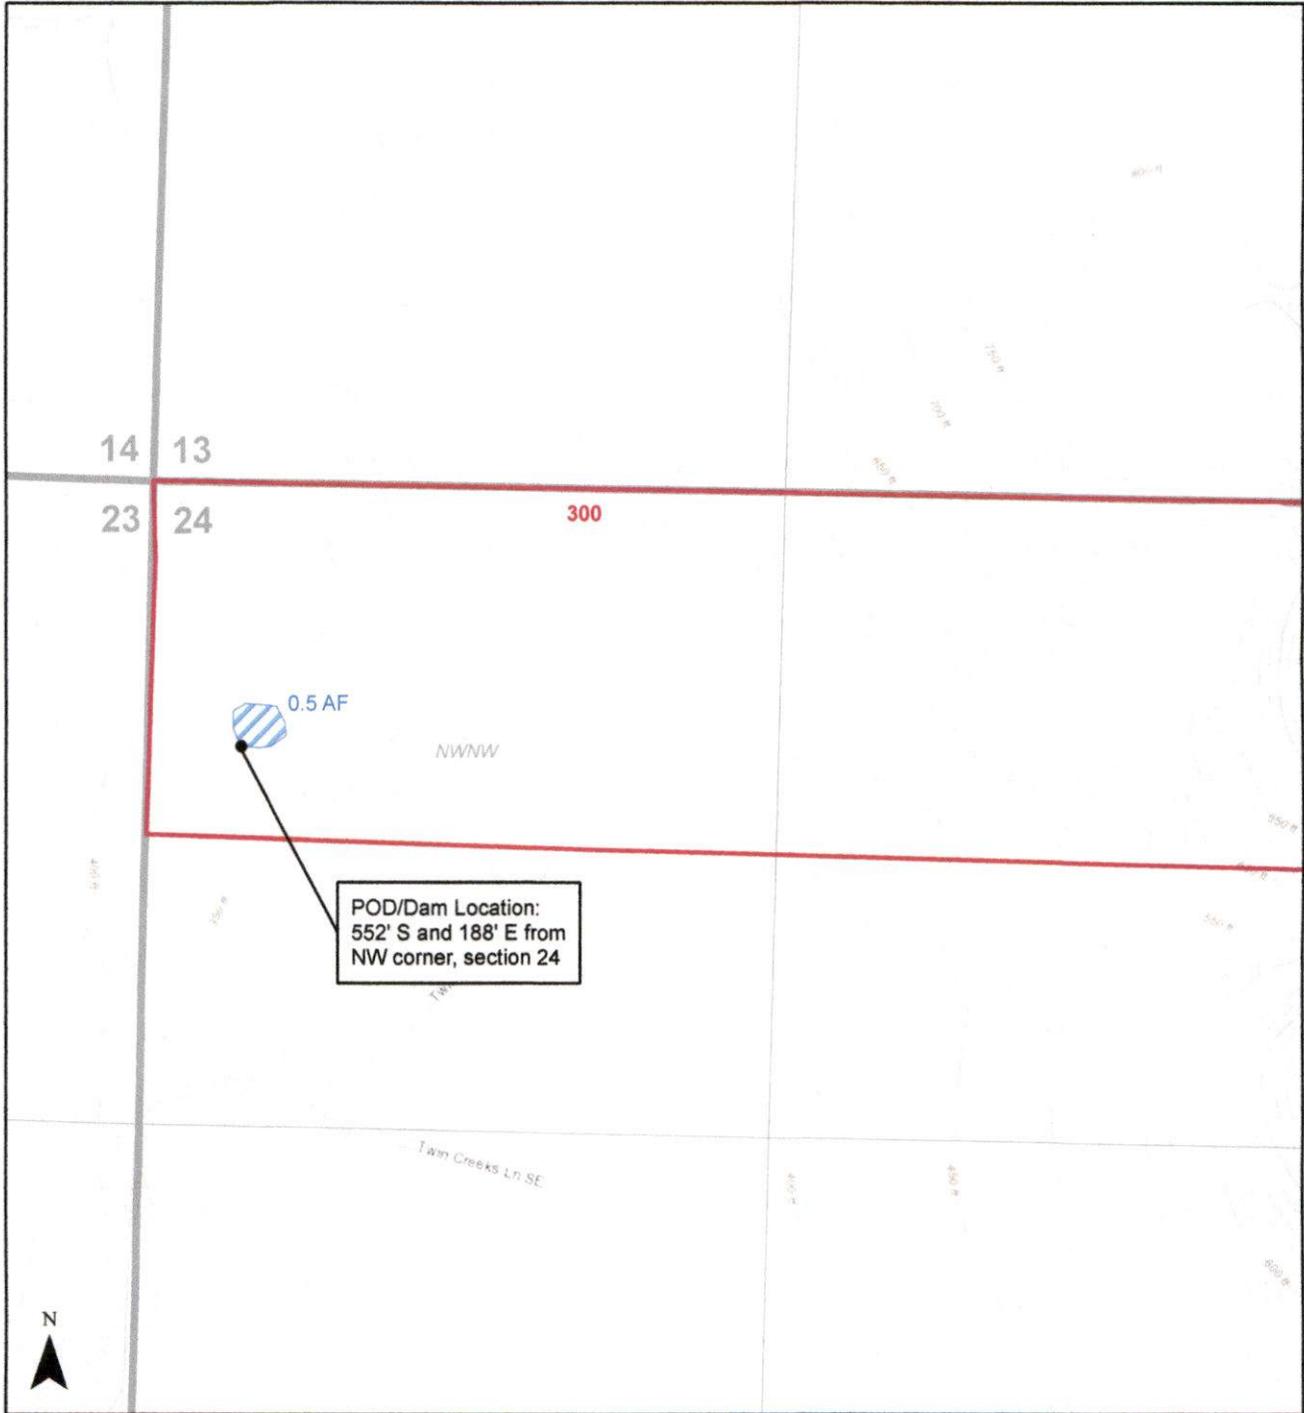

### Legend

 Reservoir  Taxlot

1 inch = 400 feet

Received by OWRD

SEP 19 2025

Salem, OR