


Claim of Beneficial Use - Turtle Pond Farm, LLC Transfer T-13832

Township 16S, Range 5W, W.M.

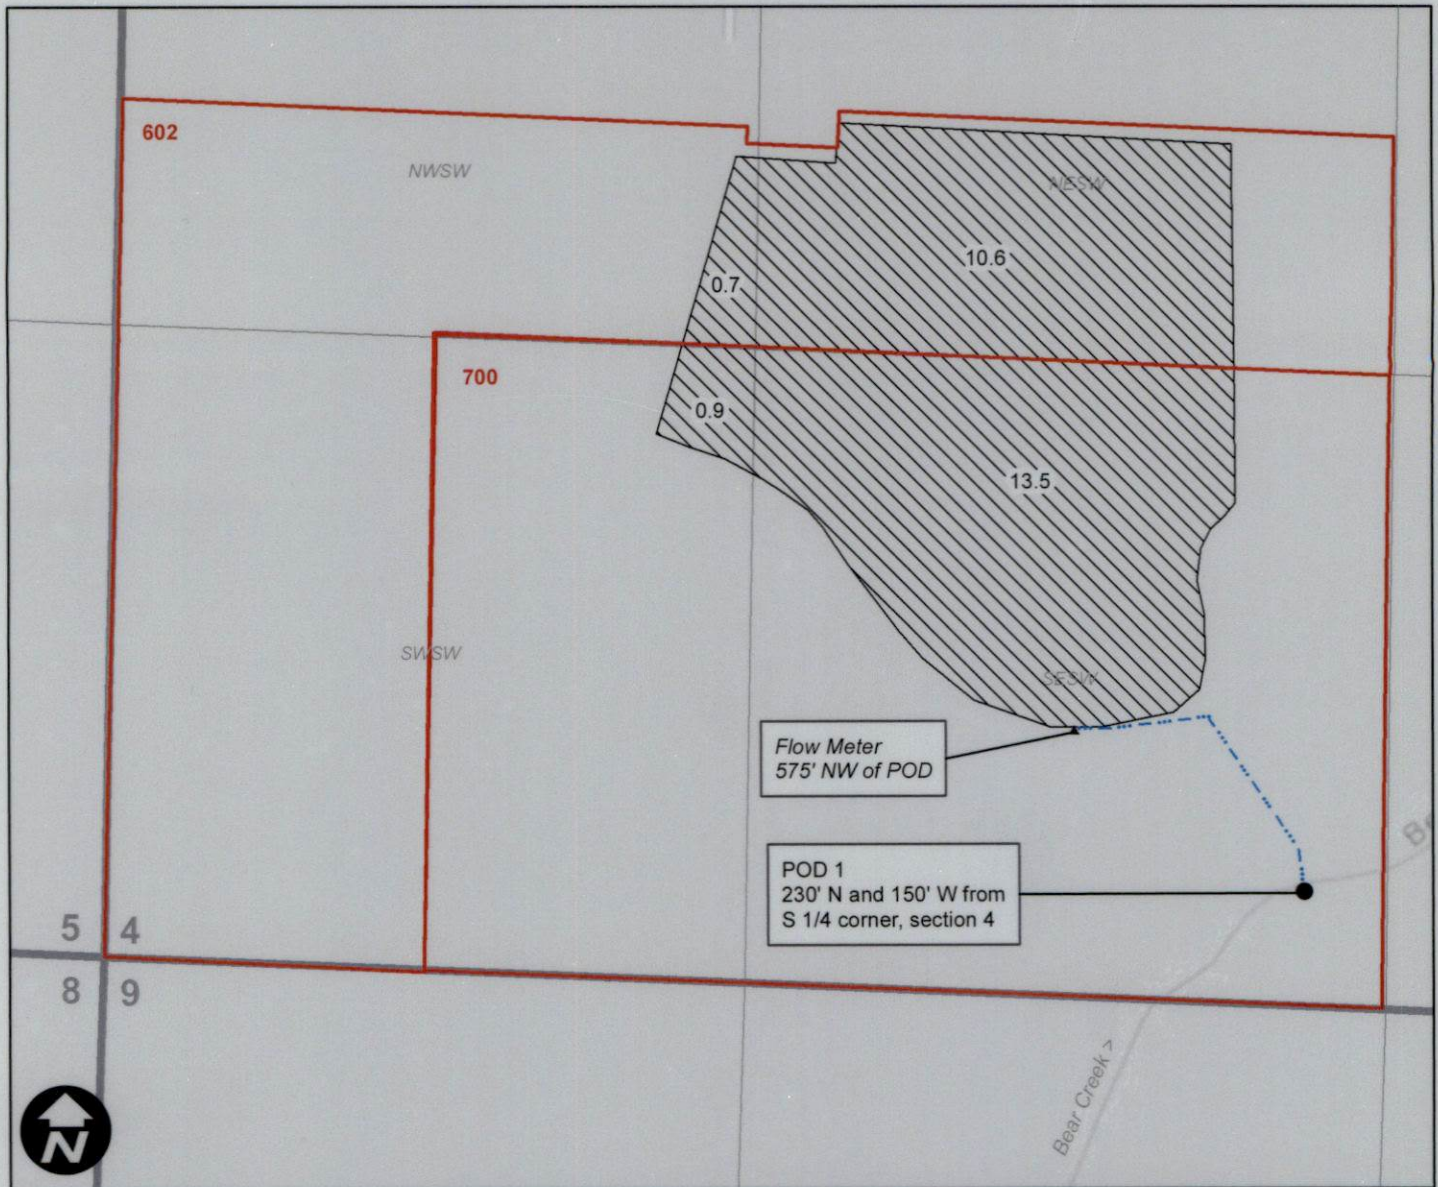

0 200 400 800 Feet

This map is not intended to provide legal dimensions or locations of property ownership lines.

Legend

IR POU Mainline Taxlot

Received by OWRD

SEP 23 2025

Salem, OR



EXPIRES: 12-31-2026