


S.E.1/4 SEC. 14 T.19S. R.12W. W.M.
Lane County
1" = 200'

19121440
DUNES CITY

LCATD TO - 2023-06-20 09:43

CANCELLED
2500
2000
215
210
209
207
204
203
201

Received
JUN 20 2025
OWRD

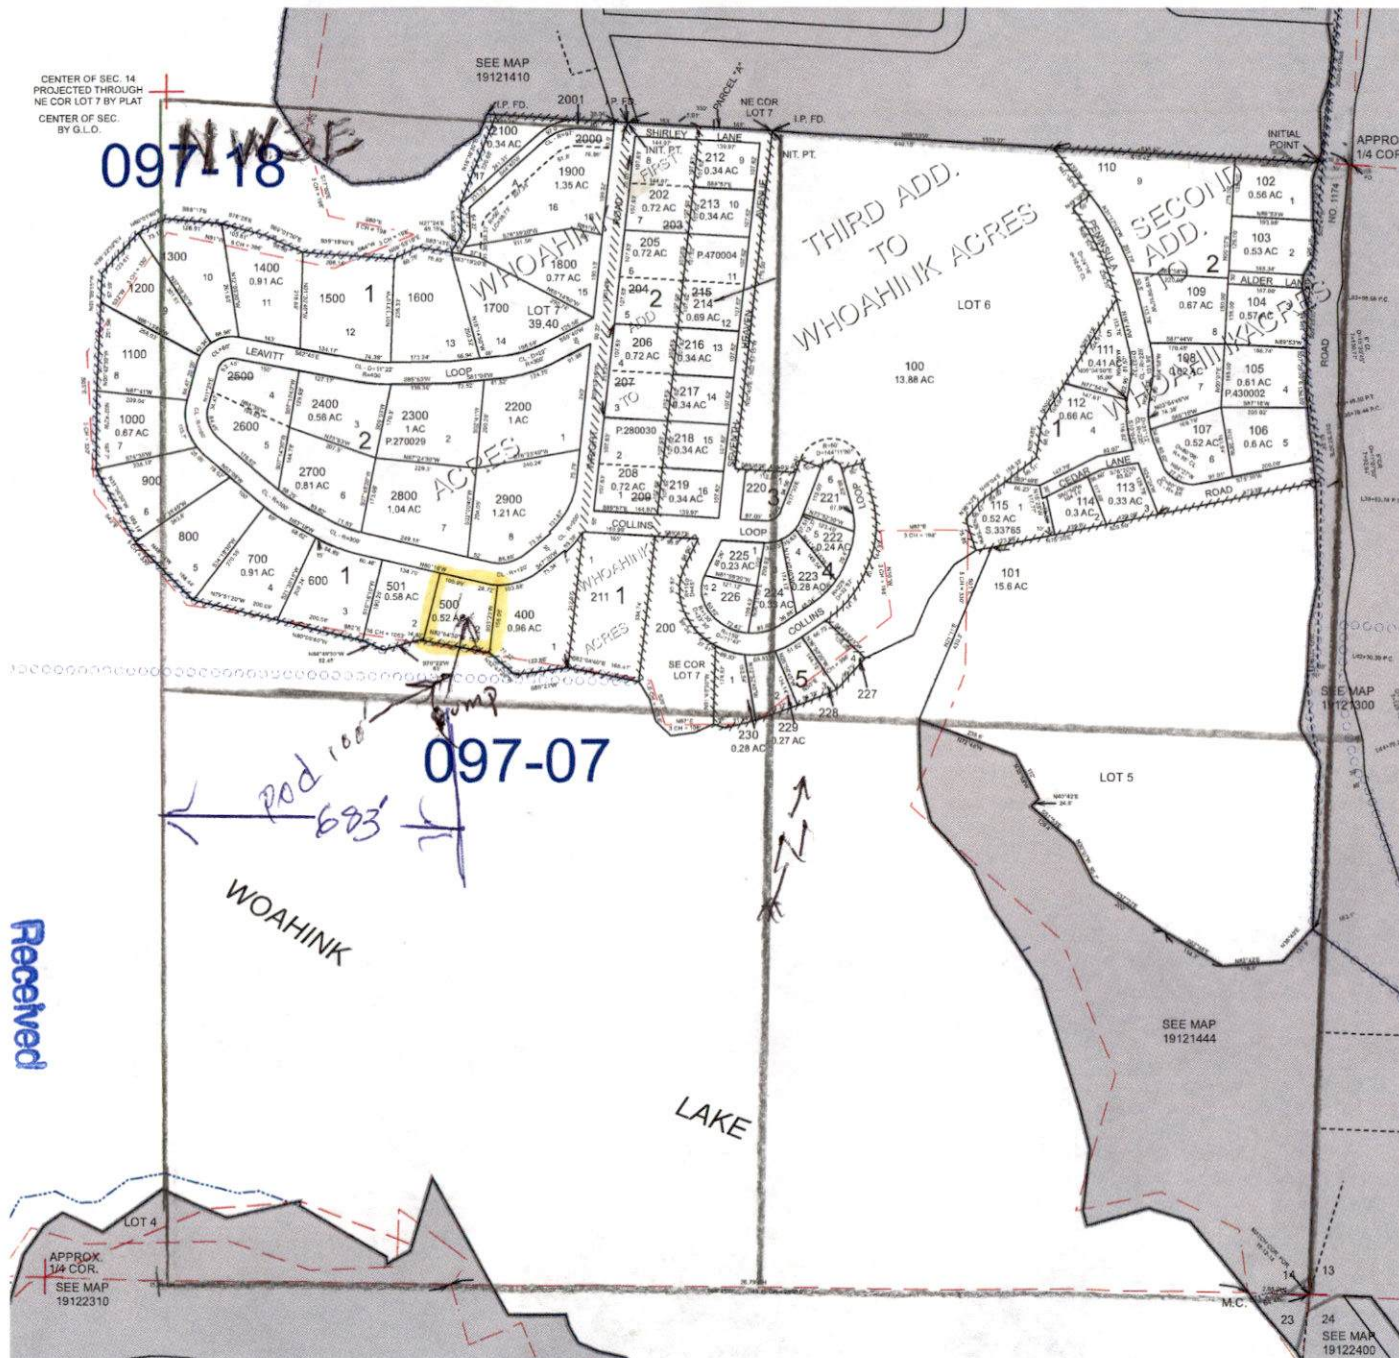

REVISIONS
 960312004 - LCAT130 - UPGRADE CODES TO 1999 STATUS GIS
 960329005 - LCAT130 - CONVERT MAP TO GIS
 960329005 - LCAT130 - LESS ROAD (L1) 181.1006
 072429007 - LCAT110 - ADD LOT & BLOCK #S TO WHCAHAK ACRES
 082229007 - LCAT113 - AC CORR LT 180.1006, 2100
 021629009 - LCAT113 - CORR LOT NUMS IN 151AD WHCAHAK
 030429010 - LCAT113 - CORR LT, 501
 022729012 - LCAT113 - ADD MISSING LOT NUMBERS
 062929023 - LCAT187 - MISC MAP ANNOTATION CORRECTION

DUNES CITY
19121440

Received

JUL 24 2025

OWRD

Received

SEP 23 2025

OWRPD