
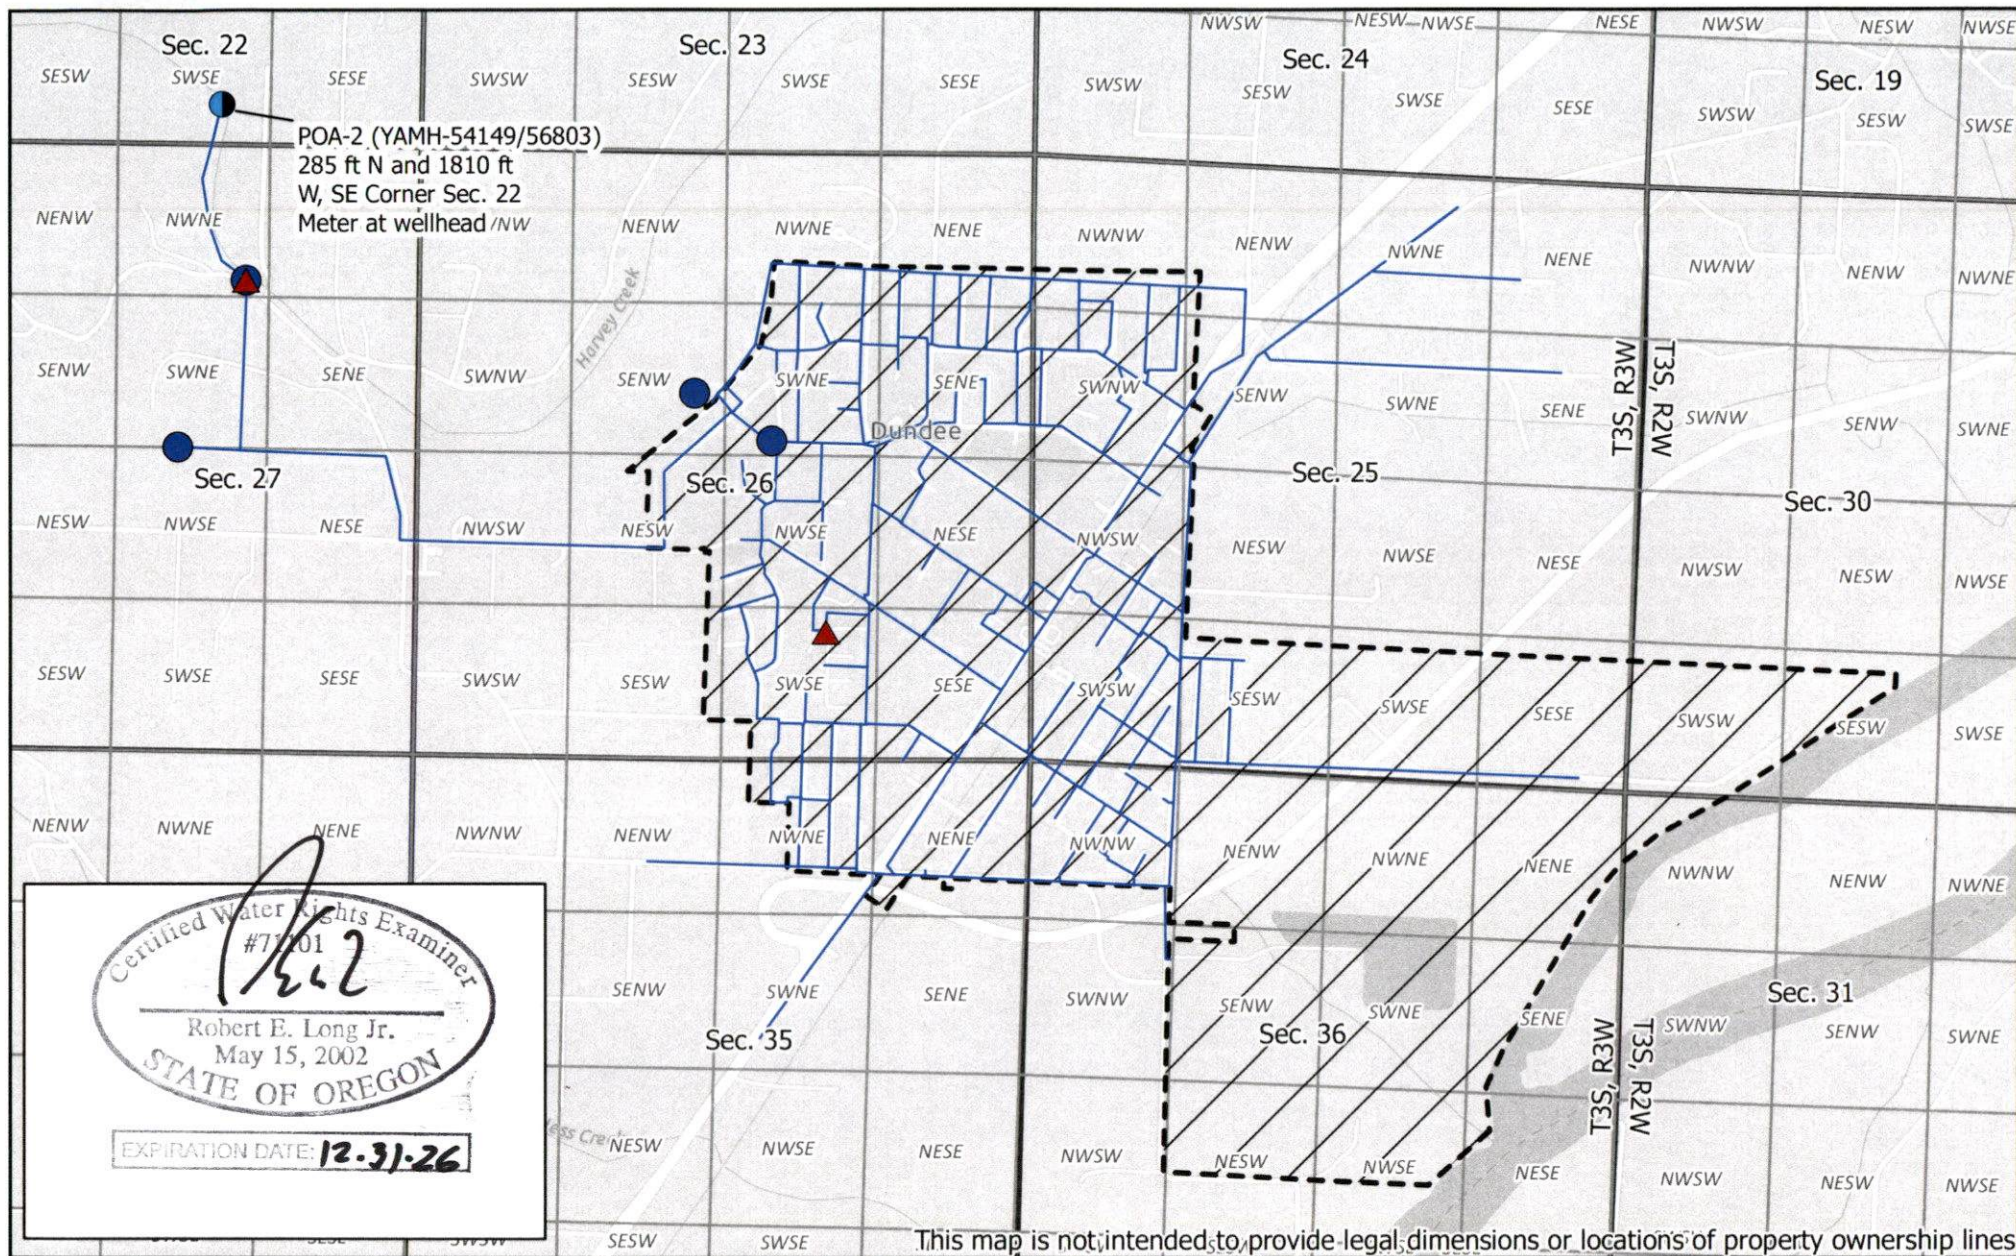


CwM-H2O 
Complete Water Management

311 B Avenue, Suite P
Lake Oswego, Oregon 97034
(503) 954-1326

Claim of Beneficial Use Map
Permit G-17484
Transfer T-11928
Application G-14066

1	DATE	AUTH	DRAFT
No.	Date	By	Revisions

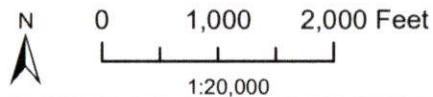

Proj#: 2434001
City of Dundee
City of Dundee
PO Box 220
Dundee, OR 97115

 Dundee UGB (POU)

 G-17484 POA

 Distribution Lines

 Storage Tanks

 Pump Stations

Received
SEP 24 2025
OWRD