


CLAIM OF BENEFICIAL USE MAP

TO ADD A POINT OF APPROPRIATION
PER TRANSFER, T-14231
FOR SCOTT & JOSE TOBIASSON

TOWNSHIP 25 SOUTH, RANGE 15 EAST, SECTION 33, W.M.
TAX LOT: 1800

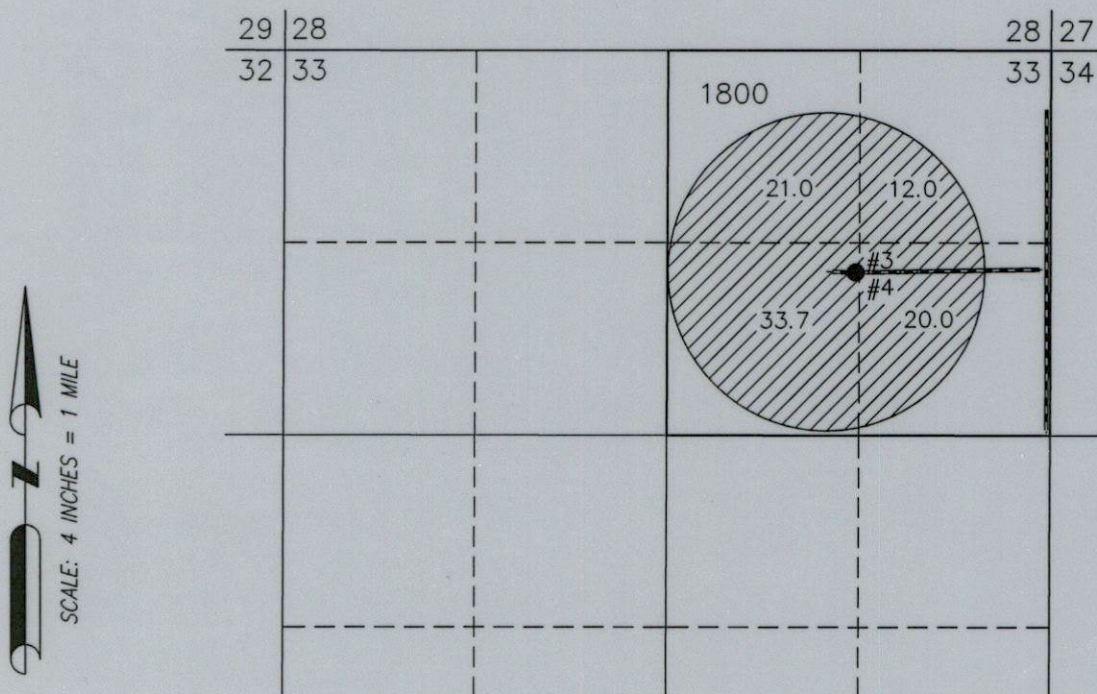

Received
SEP 26 2025
OWRD

BURIED CONVEYANCE

● #3 (LAKE 188)

LOCATED IN THE SW 1/4 NE 1/4 SECTION 33, T25S R15E,
W.M. AND 1120 FEET NORTH AND 1350 FEET WEST FROM THE
E 1/4 CORNER OF SECTION 33.

FLOW METER IS LOCATED ON THE DELIVERY PIPE 5 FEET EAST
FROM THE WELL.


● #4 (LAKE 53360)

LOCATED IN THE SW 1/4 NE 1/4 SECTION 33, T25S R15E,
W.M. AND 1108 FEET NORTH AND 1350 FEET WEST FROM THE
E 1/4 CORNER OF SECTION 33.

FLOW METER IS LOCATED ON THE CENTER PIVOT SPRINKLER &
200 FEET WEST FROM THE WELL.



86.7 ACRES IR AUTHORIZED
FROM #3 & #4 BY T-14231.

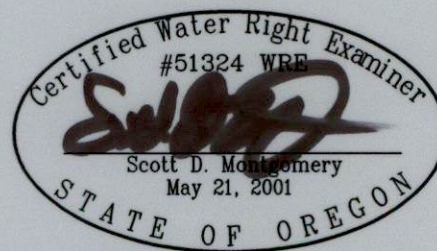

RENEWAL DATE: 12/31/2026

THIS MAP IS FOR THE PURPOSE OF LOCATING A WATER
RIGHT ONLY AND HAS NO INTENT TO PROVIDE LEGAL
DIMENSIONS OR THE LOCATION OF PROPERTY LINES.

PREPARED FOR:

SCOTT TOBIASSON
P.O. BOX 93
FT. ROCK, OR 97735

PREPARED BY:



ALL POINTS ENGINEERING AND SURVEYING, INC.
P.O. BOX 767
(541) 548-5833
TERREBONNE, OR 97760
www.APEandS.com