
CLAIM OF BENEFICIAL USE MAP

TO ADD A POINT OF APPROPRIATION
PER TRANSFER, T-14279
FOR SCOTT & JOSE TOBIASSON

TOWNSHIP 25 SOUTH, RANGE 15 EAST, SECTION 33, W.M. TAX LOT: 1800

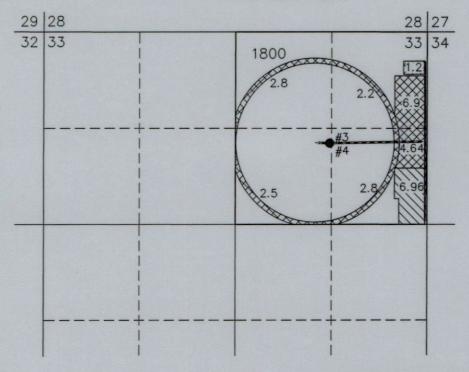

Received SEP 2.6 2025 OWRD

BURIED CONVEYANCE

• #3 (LAKE 188)

LOCATED IN THE SW 1/4 NE 1/4 SECTION 33, T25S R15E, W.M. AND 1120 FEET NORTH AND 1350 FEET WEST FROM THE E 1/4 CORNER OF SECTION 33.

FLOW METER IS LOCATED ON THE DELIVERY PIPE 5 FEET EAST FROM THE WELL.

• #4 (LAKE 53360)

LOCATED IN THE SW 1/4 NE 1/4 SECTION 33, T25S R15E, W.M. AND 1108 FEET NORTH AND 1350 FEET WEST FROM THE E 1/4 CORNER OF SECTION 33.

FLOW METER IS LOCATED ON THE CENTER PIVOT SPRINKLER & 200 FEET WEST FROM THE WELL.



23.04 ACRES IR AUTHORIZED FROM #3 & #4 BY T-14279.



6.96 ACRES IR AUTHORIZED FROM #3 & #4 BY T-14279.



RENEWAL DATE: 12/31/2026

THIS MAP IS FOR THE PURPOSE OF LOCATING A WATER RIGHT ONLY AND HAS NO INTENT TO PROVIDE LEGAL DIMENSIONS OR THE LOCATION OF PROPERTY LINES.

PREPARED FOR:

SCOTT TOBIASSON P.O. BOX 93 FT. ROCK, OR 97735 PREPARED BY:



ALL POINTS ENGINEERING AND SURVEYING, INC. P.O. BOX 767 TERREBONNE, OR 97760 (541) 548-5833 www.APEandS.com