



CLAIM OF BENEFICIAL USE MAP FOR TRANSFER T-14259
IN THE NAME OF SKYE & PENNY KREBS
T2N & T3N, R22E, W.M. GILLIAM COUNTY
SHEET 1 OF 2

ORIGINATING CERTS 67246 & 95946

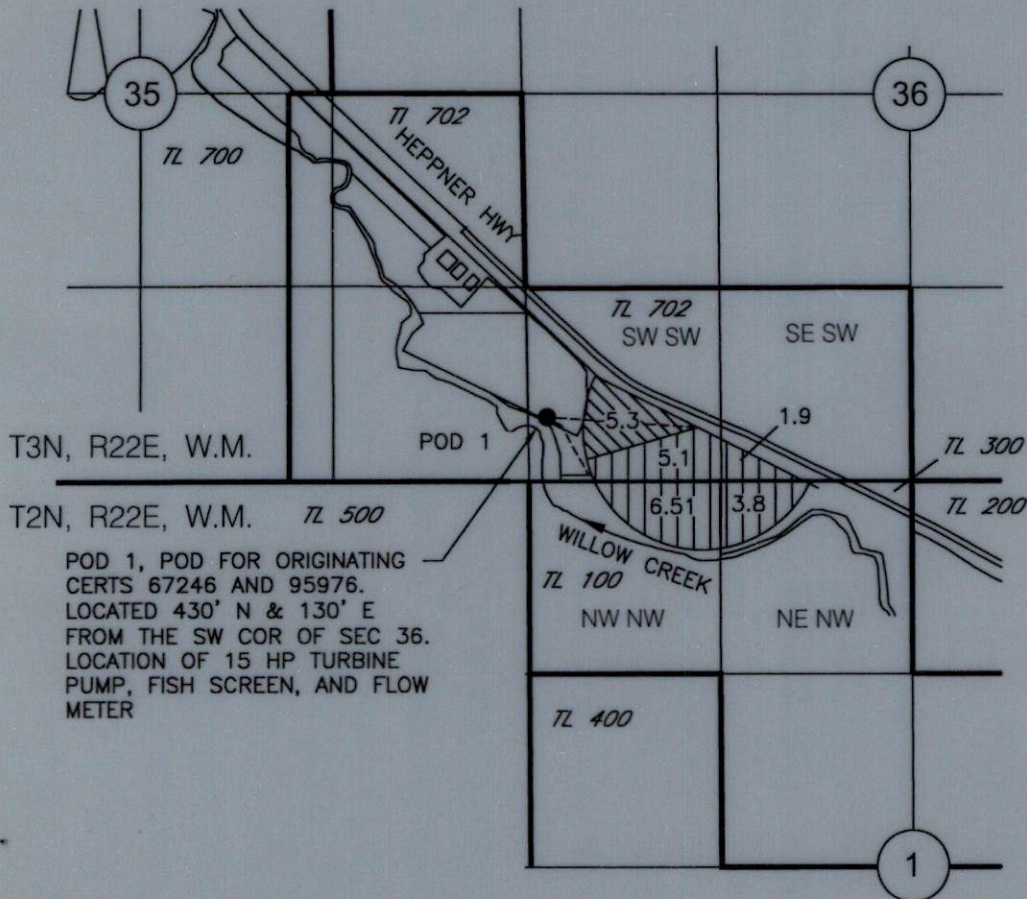

Received
SEP 29 2025

OWRD

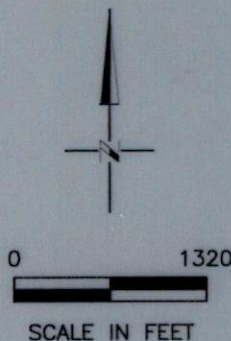

LEGEND
AREA IRRIGATED (ACRES)



ORIGINATING CERT
95976




ORIGINATING CERT
67246



BURIED PIPELINE



TAX LOT BOUNDARY

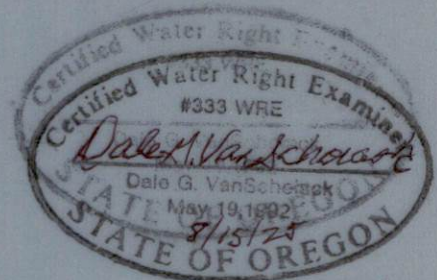


Renewal 6/30/26

NOTE: THE PURPOSE OF THIS MAP IS TO IDENTIFY THE APPROXIMATE LOCATION OF THE WATER RIGHT. IT IS NOT INTENDED TO PROVIDE INFORMATION RELATIVE TO THE LOCATION OF PROPERTY OWNERSHIP BOUNDARY LINES, PIPELINE LOCATIONS AND SIZES WERE PROVIDED BY THE WATER USER AND HAVE NOT BEEN VERIFIED.


DGV Consulting, PLLC
PHONE (509) 627-8717
dalevconsulting@gmail.com
Date: Aug 11, 2025

CLAIM OF BENEFICIAL USE MAP FOR TRANSFER T-14259
IN THE NAME OF SKYE & PENNY KREBS
T2N & T3N, R22E, W.M. GILLIAM COUNTY
SHEET 2 OF 2

ORIGINATING CERTS 88208 AND 91444

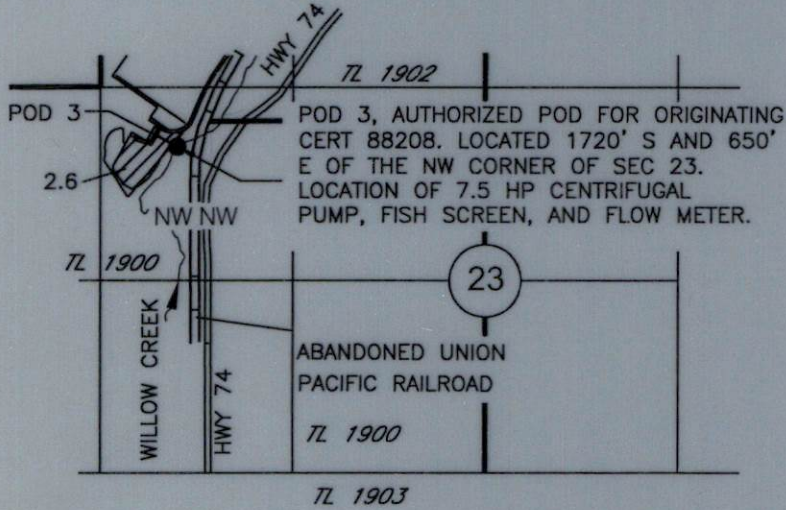

T3N, R22E, W.M.

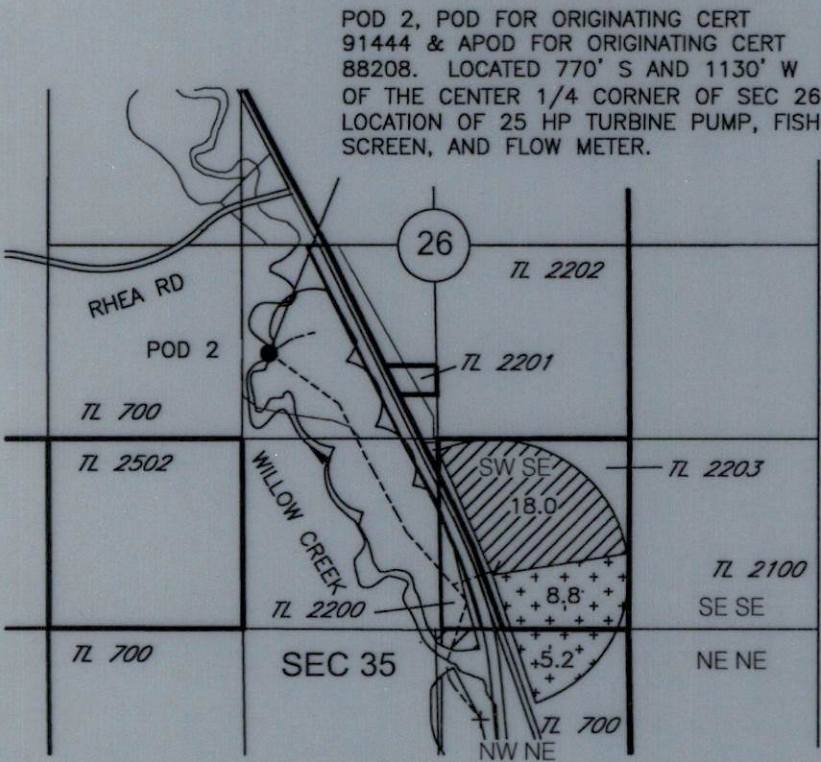

T3N, R22E, W.M.



0 1320
SCALE IN FEET

LEGEND

AREA IRRIGATED (ACRES)



ORIGINATING CERT
88208




ORIGINATING CERT
91444



BURIED PIPELINE



TAX LOT BOUNDARY

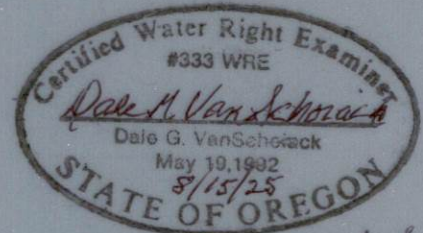

Received

SEP 29 2025

OWRD

Renew 6/30/26

NOTE: THE PURPOSE OF THIS MAP IS TO IDENTIFY THE APPROXIMATE LOCATION OF THE WATER RIGHT. IT IS NOT INTENDED TO PROVIDE INFORMATION RELATIVE TO THE LOCATION OF PROPERTY OWNERSHIP BOUNDARY LINES. PIPELINE LOCATIONS AND SIZES WERE PROVIDED BY THE WATER USER AND HAVE NOT BEEN VERIFIED.

DGV Consulting, PLLC
PHONE (509) 627-8717
dalevconsulting@gmail.com
Date: Aug 11, 2025