

Application No. **R-59585**Permit No. **R 8031**Certificate No. **59271**

SEE 59360 for correspondence

Stream Index, Page No. **12-20**Name Bureau of Land Management

By

Address 74 S. AlvordBurns, OR 97720Date filed December 21, 1979Priority December 21, 1979Action suspended until OK Cert.

Return to applicant

Date of approval APR 9 1980**CONSTRUCTION**Date for beginning APR 9 1981Date for completion OCT 1 1982

Extended to

Date for application of water

Extended to

PROSECUTION OF WORK

Form "A" filed

Form "B" filed completed

Form "C" filed

FINAL PROOFBlank mailed DEC 15 1980Proof received JAN 19 1989

Date certificate issued

FEEES PAID

Date	Amount	Receipt No.
3/14/80	30 ⁰⁰	16579

Cert. Fee

FEEES REFUNDED

Date	Amount	Check No.

ASSIGNMENTS

Date	To Whom	Address	Volume	Page

REMARKS

Form A1-187
March 1961

UNITED STATES
DEPARTMENT OF THE INTERIOR
BUREAU OF LAND MANAGEMENT

SECTION 36
SW 1/4 NW 1/4


Oregon State Water Filings

TOWNSHIP 39 S, RANGE 33 E, W. M.

4" = 1 MILE

↑
North

RYE GRASS RES. 11-4650

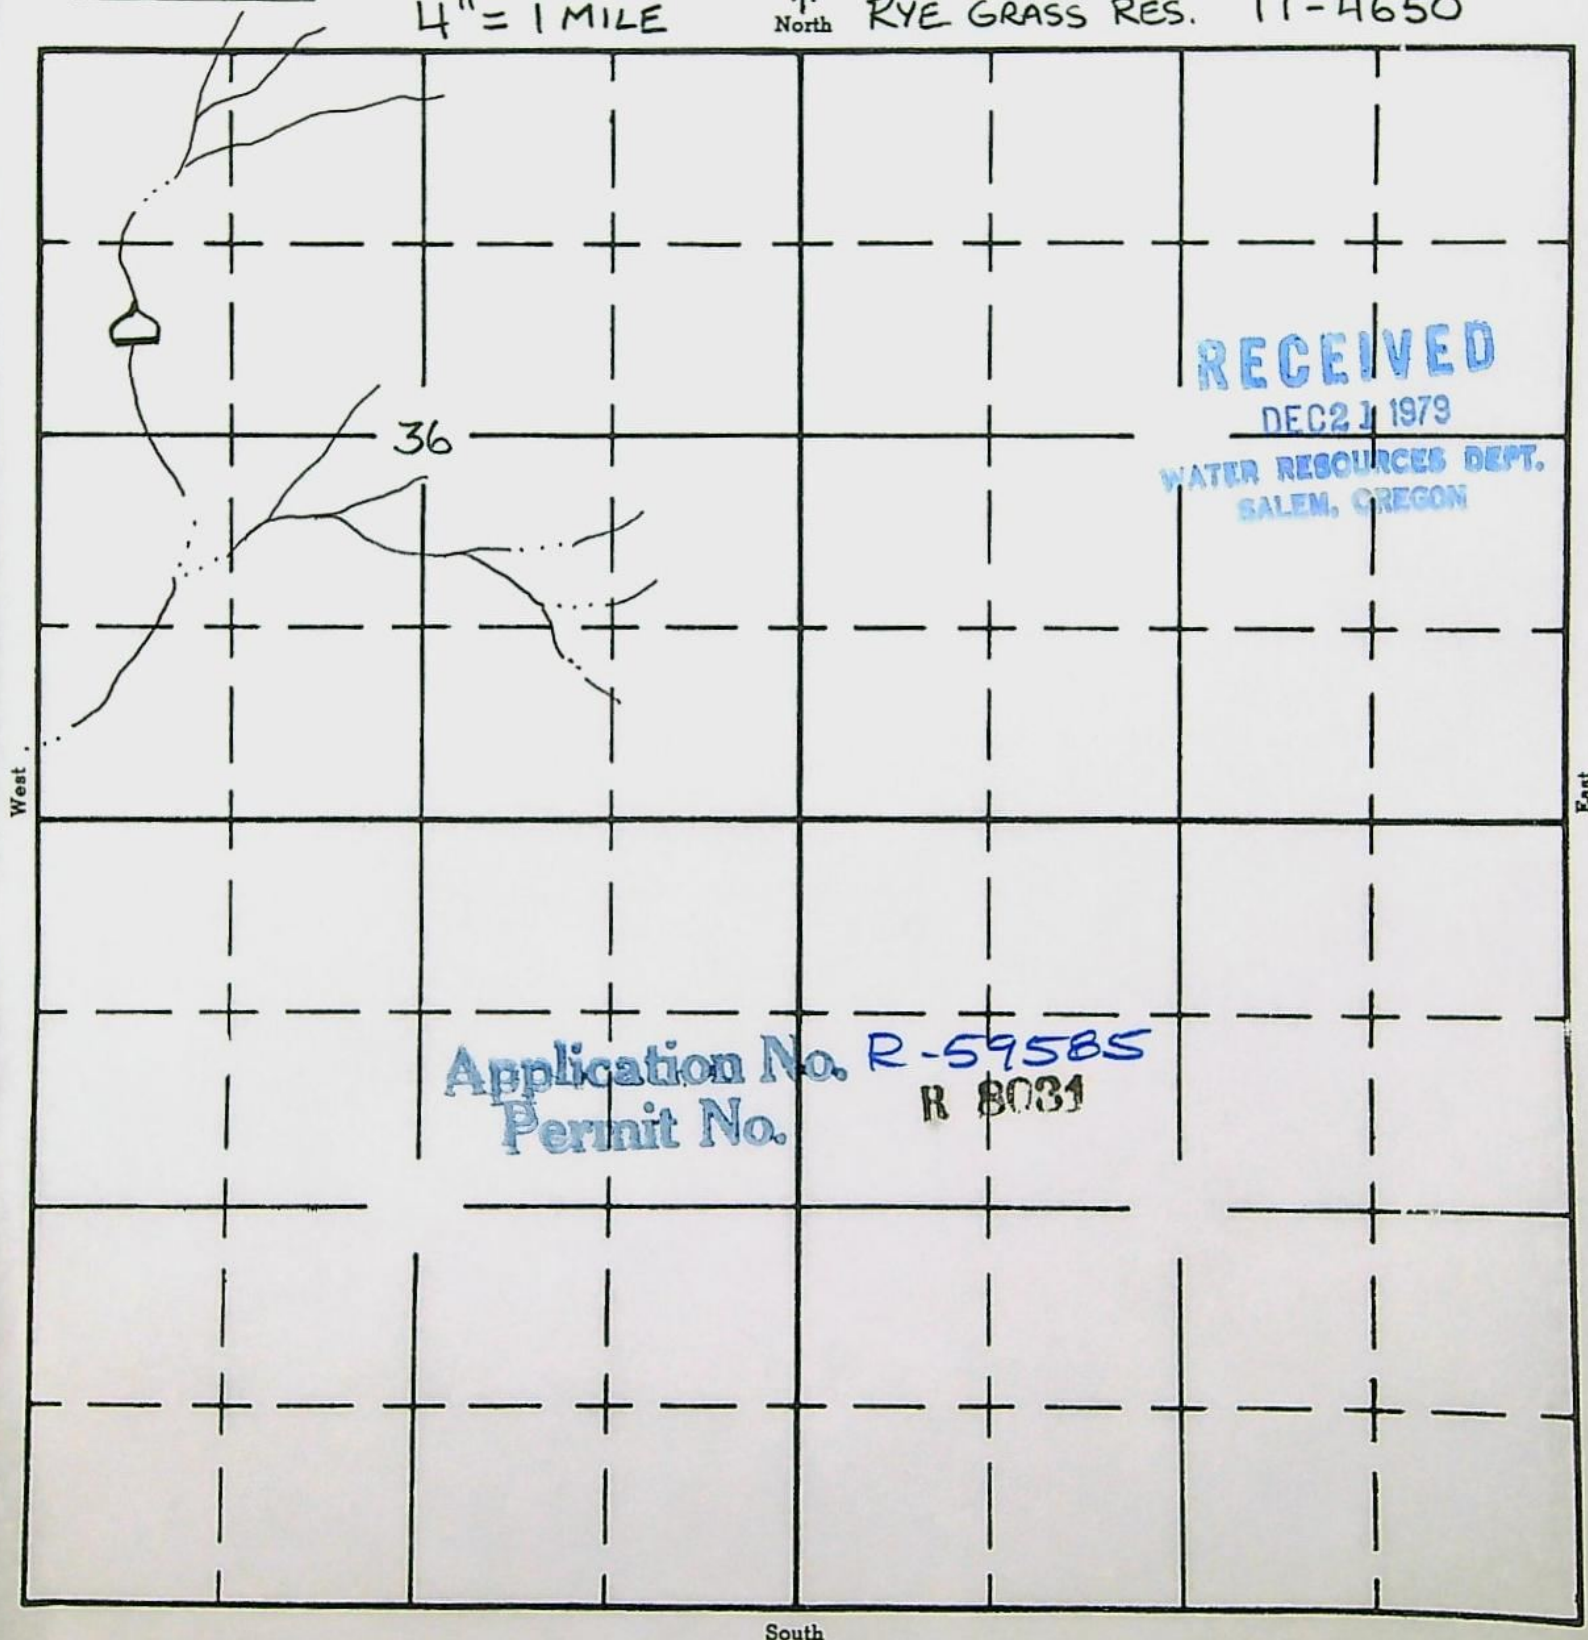

APPLICATION No.
PERMIT No.

COUNTY OF

RYE GRASS RESERVOIR**PROOF OF APPROPRIATION OF WATER**

This is to show evidence that

UNITED STATES BUREAU OF LAND MANAGEMENT acting by and through its BURNS DISTRICT
 office of 74 So. ALVORD Burns OR 97420 has
Address City State Zip
 perfected a right to the use of waters within the terms of Application R-59585, Permit R-8031,

1. Sources of water supply UNNAMED STREAM
2. Use LIVESTOCK / WILDLIFE 3. Priority date 12-21-79
4. Amount stored 1.7 ACRE FT.
5. Location SW 1/4, NW 1/4, Section 36, T. 39 S, R. 32 E W.M.
6. Does application map show correct location of reservoir? NO
 If not, please redraft location.

RECEIVED

APR 4 1984

**WATER RESOURCES DEPT.
SALEM, OREGON****AFFIDAVIT OF APPROPRIATOR**

STATE OF OREGON)

County of HARNEY) ss.

I, THOMAS R. THOMPSON JR., being first duly sworn, depose and say that I have read the above and foregoing proof of appropriation of water; that I know the contents thereof, and that facts therein stated are true.

IN WITNESS WHEREOF, I have hereunto set my hand this 16th day of MARCH, 1984.

Thomas R. Thompson Jr.

Subscribed and sworn to before me this 16th day of March, 1984.

Michael S. Matzie
 Notary Public for Oregon

My commission expires 5/84

STRUCTURAL DETAILS

7. If not in channel of a stream, state how it is filled _____


8. The maximum height is 10 feet above stream bed or ground surface at the center-line. The top width is 8 feet, slope of upstream face 3:1, slope of downstream face 2:1, and height of dam above water line when full 1 feet.

9. The dam is (check one) ☒ earthfill, ☐ concrete, ☐ flashboard, ☐ other. If "other," give description: _____

10. Give the location, description, and dimensions of the outlet conduit: NONE

(All dams across natural stream channels must be provided with an outlet conduit, of such capacity and location to pass the normal flow of the stream at any time.)

11. Give the location and dimensions of the spillway _____ (State whether over or around dam)

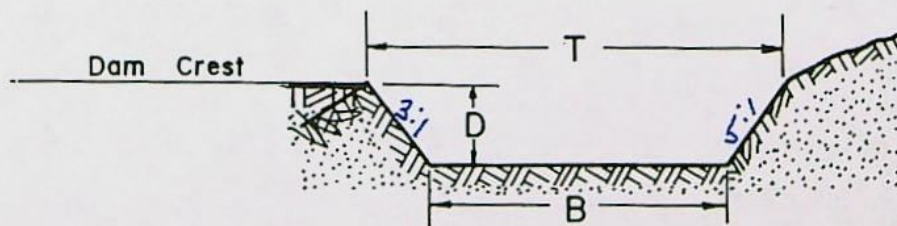

The bottom width of the spillway, B, is 10 feet.

The top width of the spillway, T, is 18 feet.

The distance between the crest of the dam and the crest of the spillway, D, is 1 feet. (Must be at least 2 1/2 feet)

If any other type of spillway, describe and give dimensions:

Mtee. to 3' D spillway recommended. Raise Dam 2.5'

Application No. R-59585

Permit No. R 8031

STATE OF OREGON WATER RESOURCES DEPARTMENT

Application for a Permit to Construct a Reservoir

RECEIVED

DEC 21 1979

WATER RESOURCES DEPT.
SALEM, OREGON

I, BUREAU OF LAND MANAGEMENT

(Name of Applicant)

of 74 S. ALVORD

(Mailing Address)

BURNS

(City)

State of OREGON, 97720, Phone No. 503-573-2071

(Zip Code)

do hereby make application for a permit to construct the RYE GRASS 11-4650 reservoir

and to store the unappropriated waters of the State of Oregon, subject to existing rights.

1. The name of the stream from which the reservoir is to be filled is Unnamed

tributary to RINLOX CREEK BOX CANYON CREEK

2. If not in channel of a stream, state how it is to be filled.

3. The dam will be located in the SW $\frac{1}{4}$ of the NW $\frac{1}{4}$ of Section 36,
Township 39 S, Range 35 E, W. M.

4. The maximum height will be 10 feet above stream bed or ground surface at the
centerline. The top width will be 8 feet, slope of upstream face 3:1,
slope of downstream face 2:1, and height of dam above water line when full
4 feet.

5. The dam will be (check one) ☒ earthfill, ☐ concrete, ☐ flashboard, ☐ other.

If "other", give description:

6. Give the location, description, and dimensions of the outlet conduit: N/A

(All dams across natural stream channels must be provided with an outlet conduit, of such capacity and location to pass the normal flow of the stream at any time)

Application No. R-59585

Permit No. R 8031

**Permit to Construct a Reservoir
and Store for Beneficial Use the Public Waters
of the State of Oregon**


This is to certify that I have examined the foregoing application and do hereby grant the same subject to the following limitations and conditions. The right herein granted is limited to the construction of Rye Grass Reservoir and storage of water from an unnamed stream for livestock, and is subject to the installation and maintenance of an outlet pipe, or to provide other means to evacuate the stored water when determined by the Water Resources Director to be necessary to satisfy prior downstream rights

The right hereunder shall be limited to the storage of 1.0 acre feet.

The priority date of this permit is December 21, 1979

Actual construction work shall begin on or before April 9, 1981 and shall thereafter be prosecuted with reasonable diligence and be completed on or before October 1, 1982

WITNESS my hand this 9th day of April, 1980

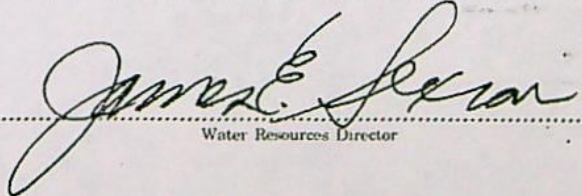
Water Resources Director

UNITED STATES
DEPARTMENT OF THE INTERIOR
BUREAU OF LAND MANAGEMENT

11-6020-4650

SECTION 36

Oregon State Water Filings

SW 1/4 NW 1/4

TOWNSHIP 39 S, RANGE 33 E, W. M.

4" = 1 MILE

North

RYE GRASS RES. 11-4650

BACKWARDS

36
35

RECEIVED

DEC 21 1979

36
WATER RESOURCES DEPT.
SALEM, OREGON

Application No. R-59585
Permit No. R 8031

South

APPLICATION No.

PERMIT No.

FORM AI-107
March 1961

UNITED STATES
DEPARTMENT OF THE INTERIOR
BUREAU OF LAND MANAGEMENT

SECTION

36

SW 1/4 NW 1/4


Oregon State Water Filings

TOWNSHIP 39 S, RANGE 33 E, W. M.

4" = 1 MILE

↑
North

RYE GRASS RES. 11-4650

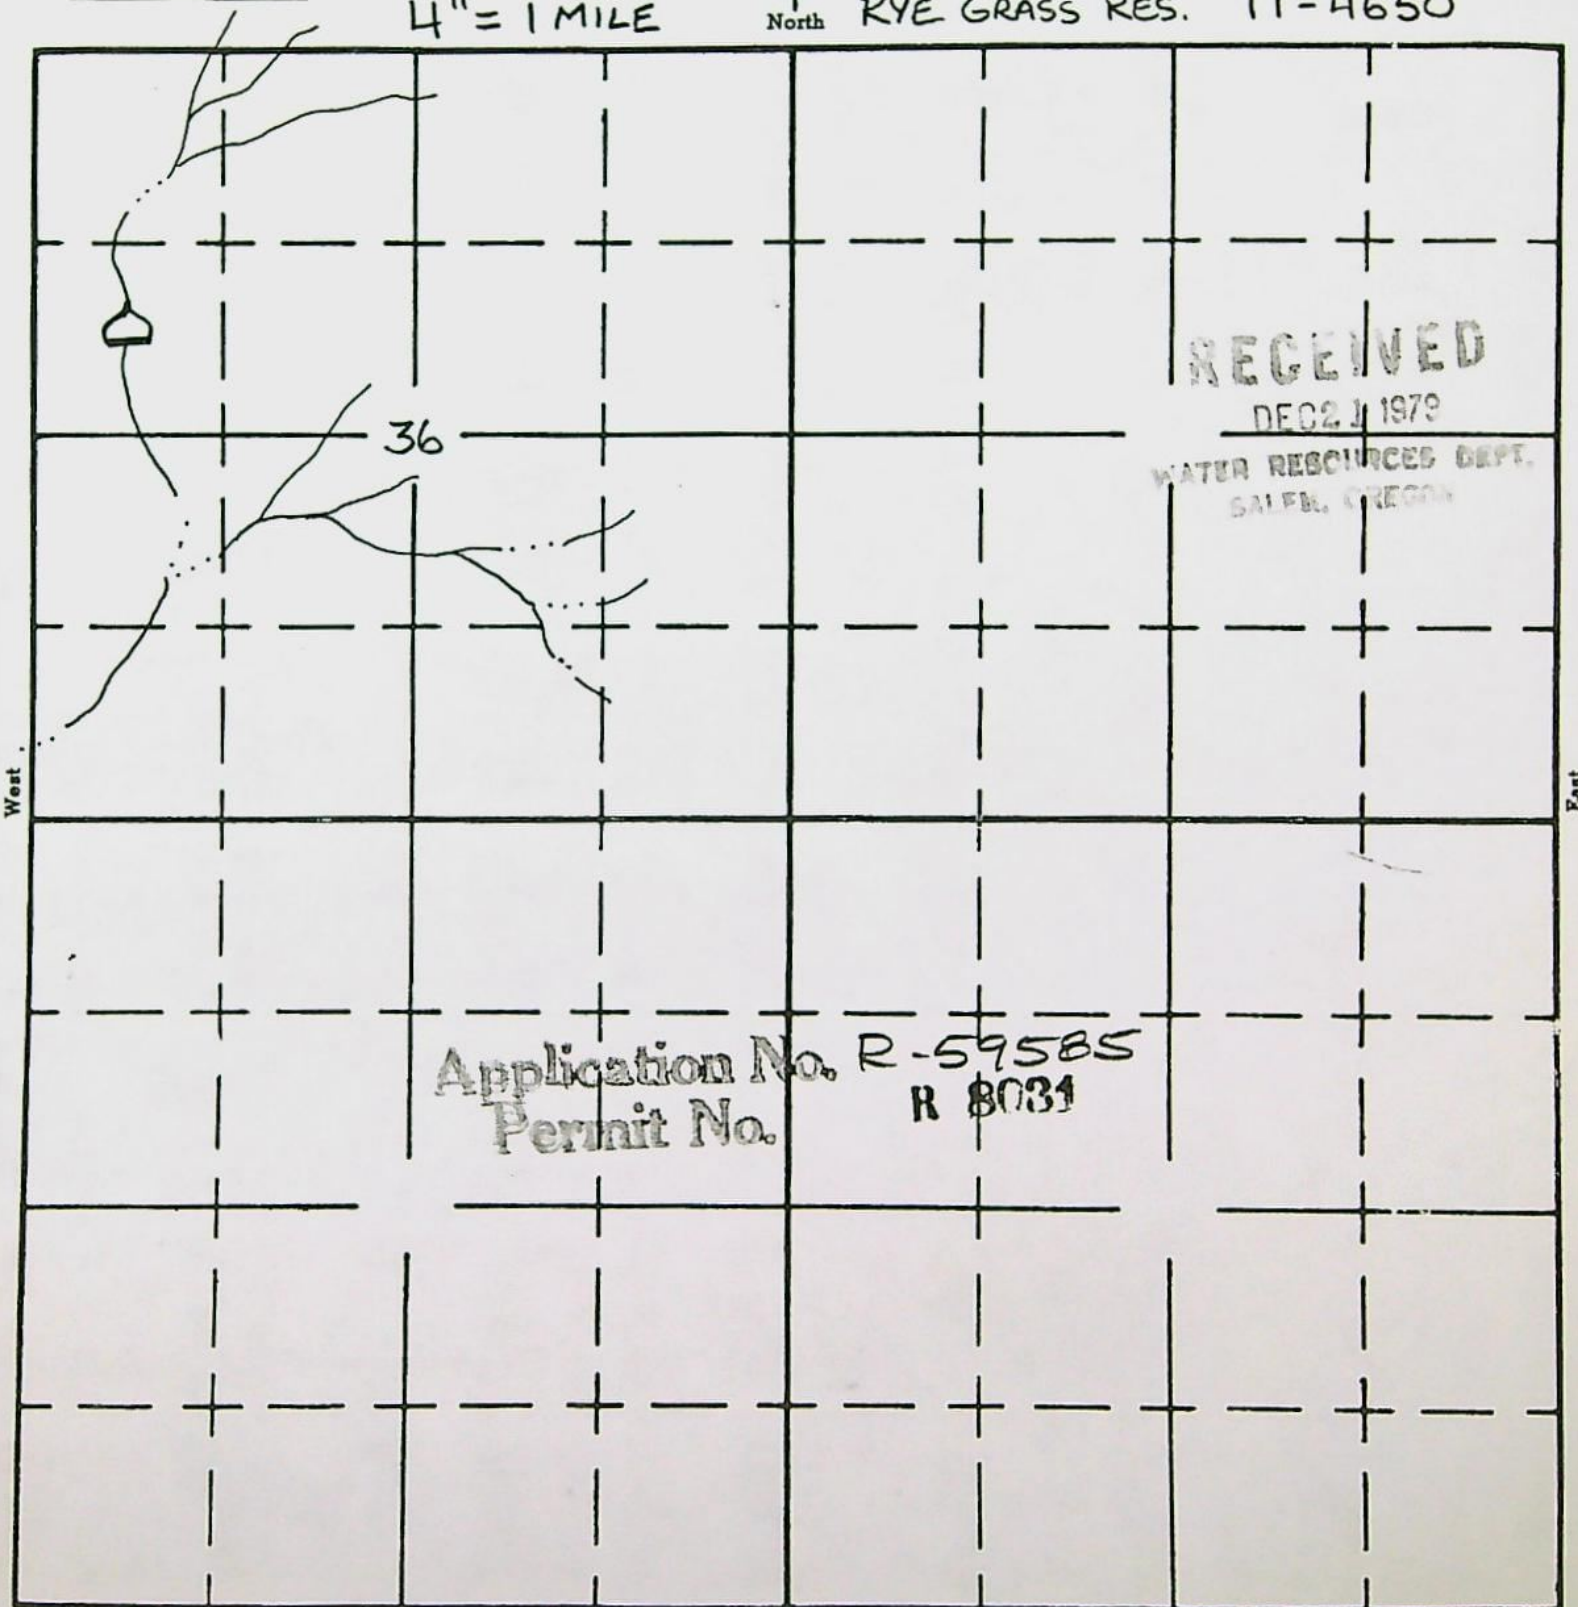

South

APPLICATION No.

PERMIT No.