


SECTION 32 SE.45., R.1E., W.M.5, R.E. 17.

CLACKAMAS COUNTY, OREGON

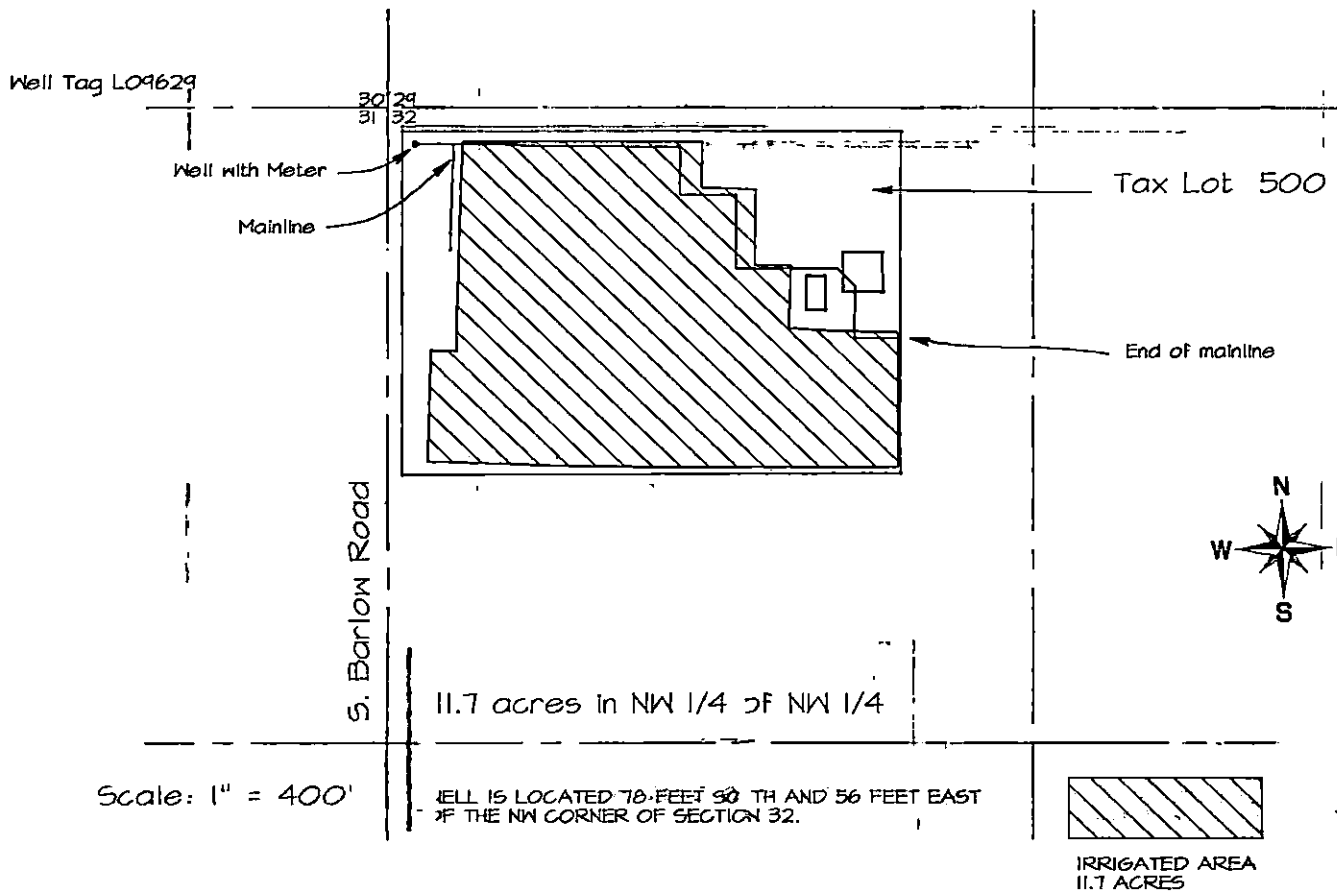


CLAIM OF BENEFICIAL USE MAP
FOR
ANATOLI MARTISHEV

APPLICATION NO. G-14490 PERMIT NO. G-13347

RECEIVED MAY 22 1990

CLACKAMAS COUNTY

Salem, OR

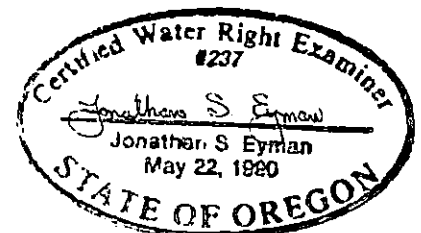

THE PREPARATION OF THIS MAP IS FOR THE PURPOSE OF IDENTIFYING THE LOCATION OF THE PROPOSED WATER RIGHT ONLY AND HAS NO INTENT TO PROVIDE DIMENSIONS OR LOCATION OF PROPERTY OWNERSHIP LINES.