


Tax Lot 1901, T31S R15W, Section 12, NE1/4 NE1/4

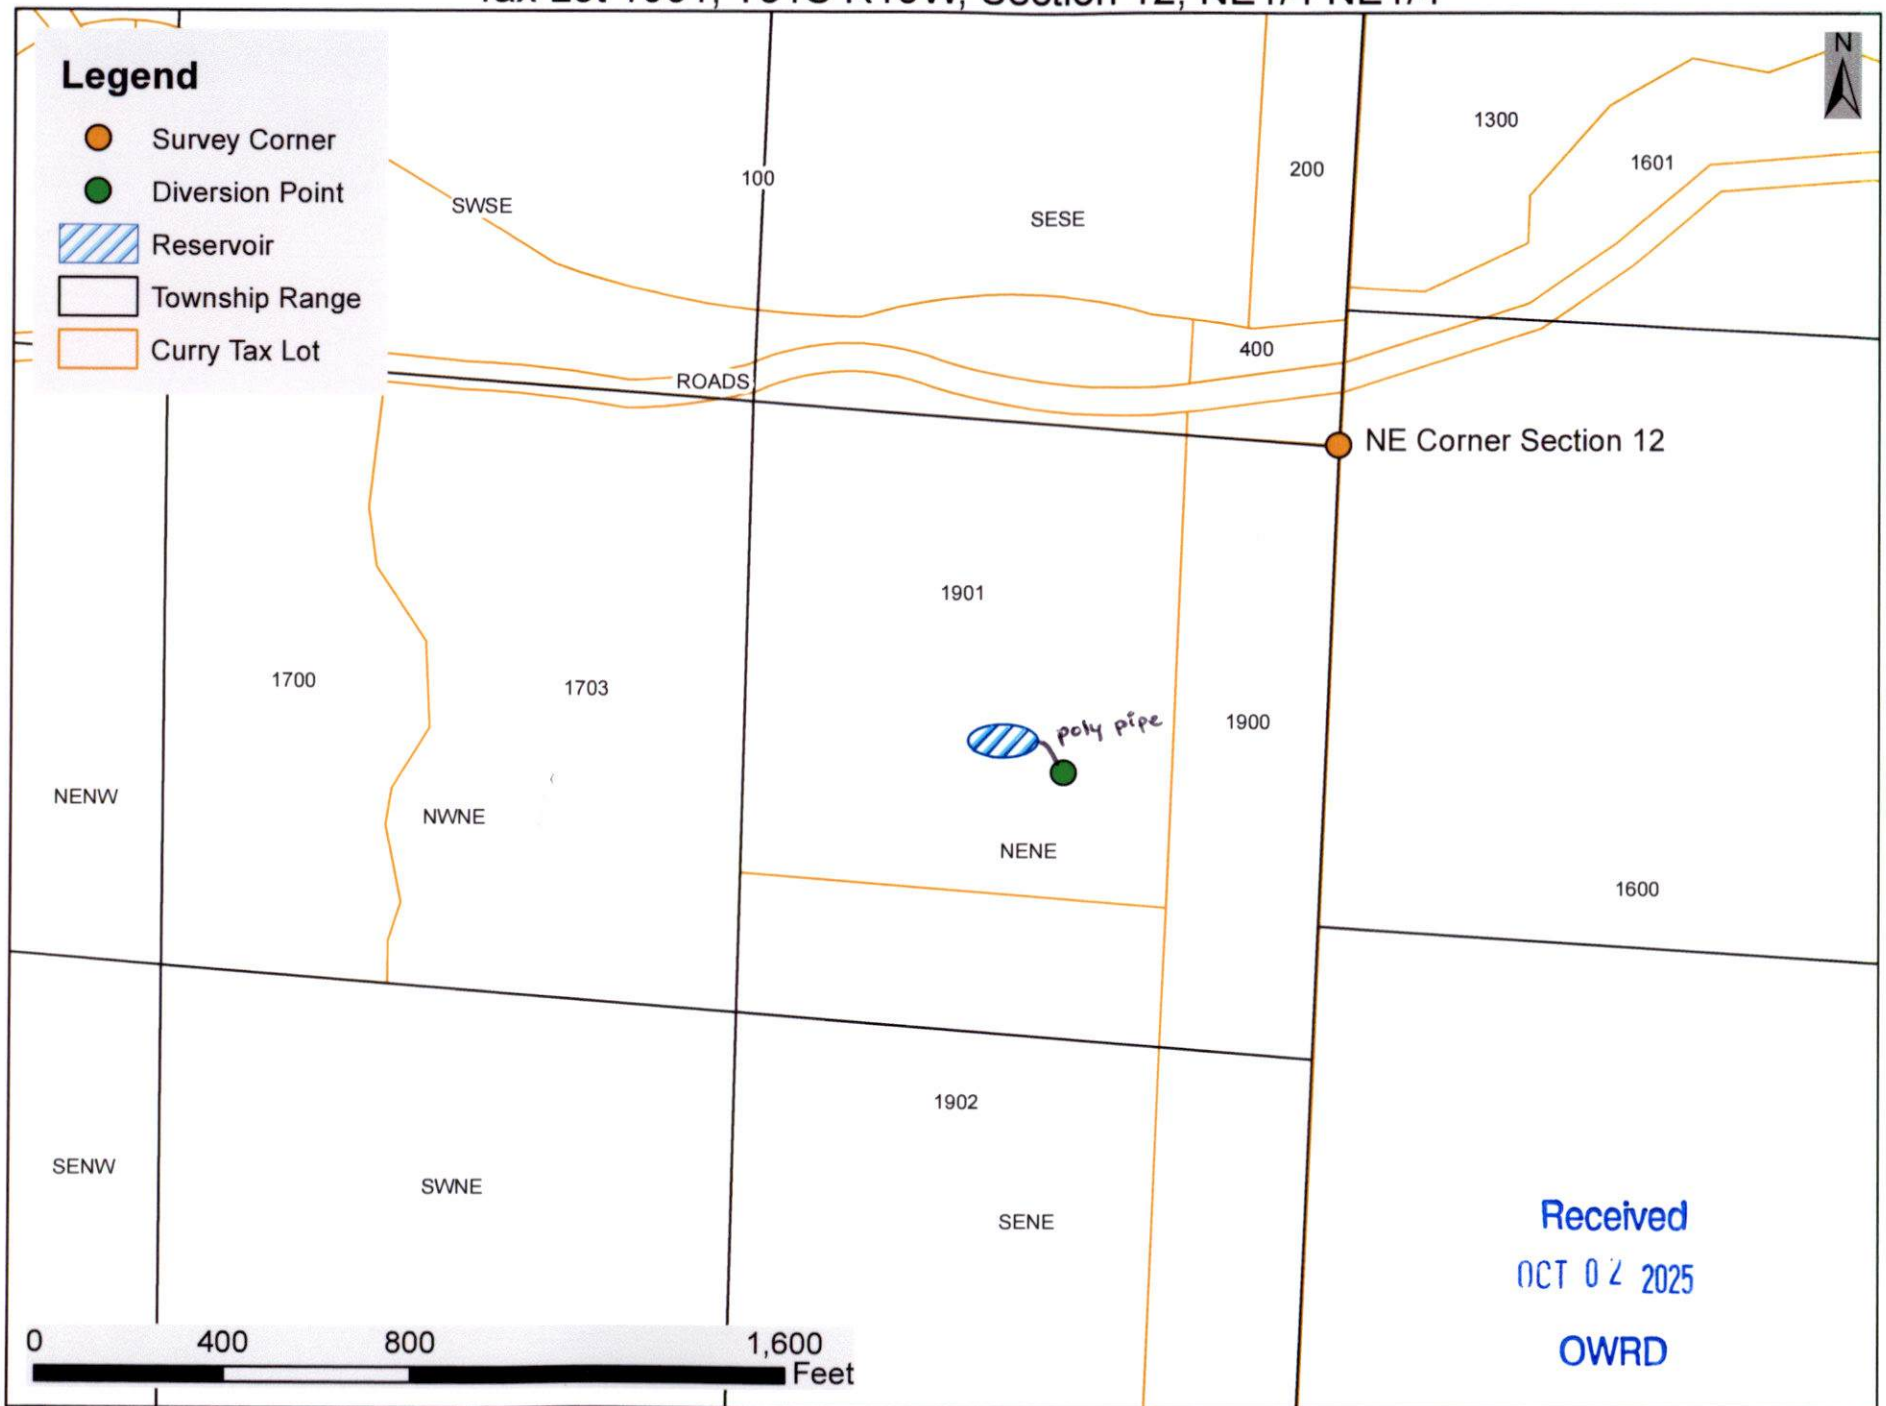

Proposed diversion point located 740' south and 550' west of survey corner.

Proposed reservoir located 680' south and 700' west of survey corner.

Received
OCT 02 2025
OWRD