


3W.W.M.

RF

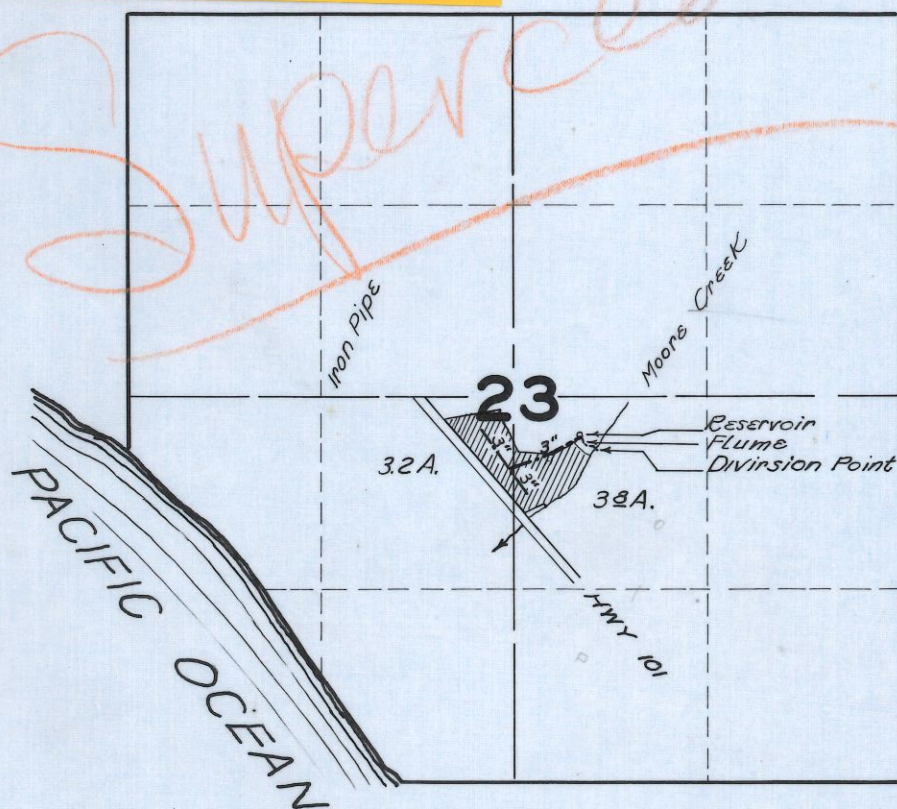

UNDER

IN NAME OF

GRANT M. & MAY POWELL

Surveyed AUG. 10, 1949, by H. L. COFFMAN