


("40" Lines off.)

Should be here

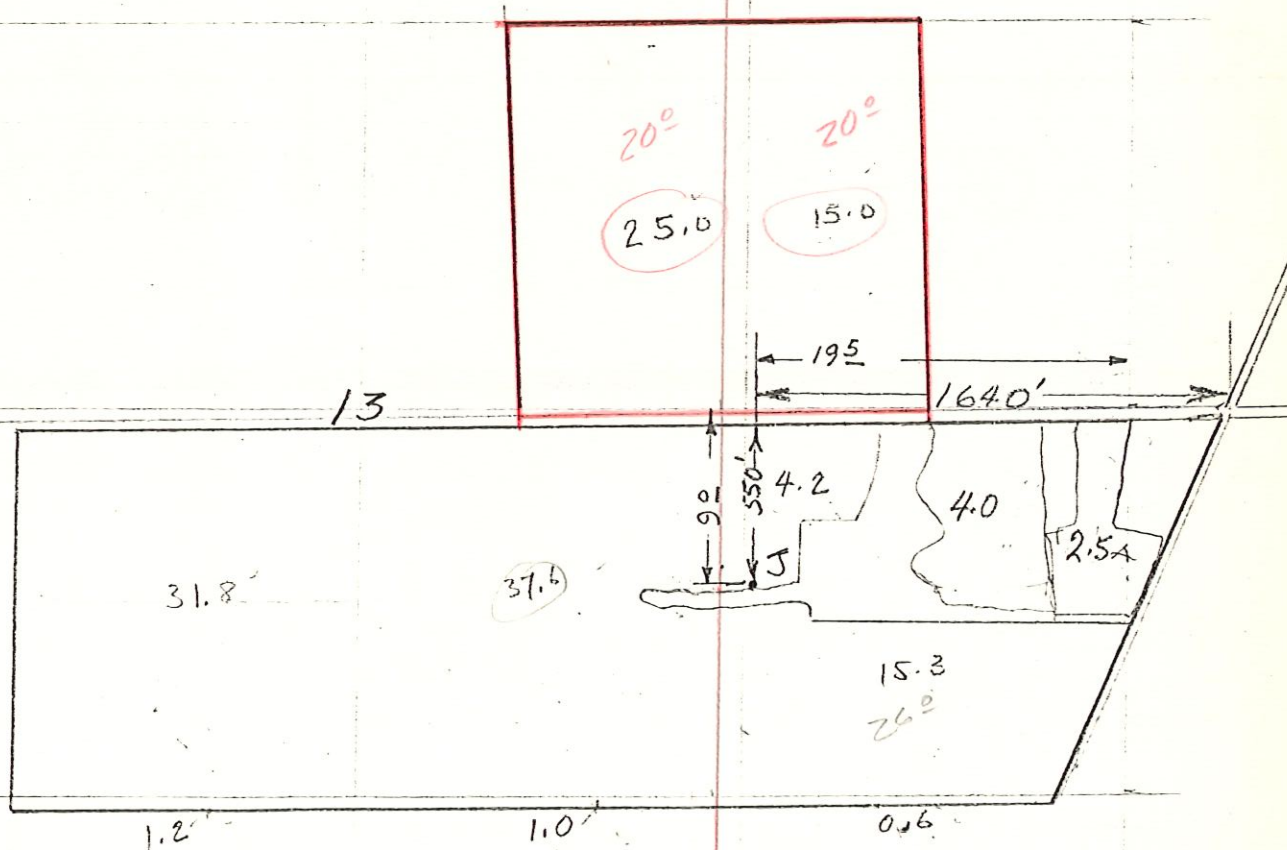

13	18
----	----