



Oregon Water Resources Department
725 Summer Street NE, Suite A
Salem, Oregon 97301
(503) 986-0900
www.oregon.gov/OWRD

Ownership Update for Certificated Rights Only

NO FEES ARE REQUIRED TO SUBMIT THIS FORM

NOTICE: A certificate of water right typically stays with the land. To track water right ownership, the Department requests that this form be submitted to the Department. **To update multiple rights, a separate form is required for each right.** If you have any questions about this form, please contact your local watermaster, or call the Water Resources Department at (503) 986-0900.

Note: Use the assignment form to change ownership on pending applications, permits, transfers, groundwater registrations, or limited licenses.

Current Landowner Information				
Name:	Elliott Ranches, Inc.			
Mailing Address:	22047 Pioneer Lane			
City:	Bridgeport	State:	OR	Zip: 97819
Phone:		Email:		

Property Information				
County:	BAKER	Township:	12S	Range: 41 Section: 27
Tax Lot #:	2800	(SE 1/4 SE 1/2)		
Street Address of Water Right:	23992 Clarks Creek Rd Bridgeport, OR 97819			

Water Right Information	
Application:	Danny & Elizabeth Murrell
Permit:	46634
Certificate:	82509
Are all the lands associated with this water right owned by the requestor? ☒ Yes ☒ No	
(If no, include a map showing the portion of the water right involved) N/A	

Signature and Date	
Name of individual completing form:	Elizabeth Murrell
Phone or email:	emurrell@conl.com Date: 09/21/2025
Signature of requestor:	

The Department does not change names on water right certificates. This form will be placed in the file for future reference only. If mailed, the Department will not provide acknowledgment of receipt.

This form can be mailed to the address above or sent by email to wrd_dl_customerservice@water.oregon.gov

This is a final order in other than a contested case. This order is subject to judicial review under ORS 183.484. Any petition for judicial review must be filed within the 60 day time period specified by ORS 183.484(2). Pursuant to ORS 536.075 and OAR 137-004-0080 you may either petition for judicial review or petition the Director for reconsideration of this order. A petition for reconsideration may be granted or denied by the Director, and if no action is taken within 60 days following the date the petition was filed, the petition shall be deemed denied. In addition, under ORS 537.260 any person with an application, permit or water right certificate subsequent in priority may jointly or severally contest the issuance of the certificate at any time before it has issued, and after the time has expired for the completion of the appropriation under the permit, or within three months after issuance of the certificate.

STATE OF OREGON

COUNTY OF BAKER

CERTIFICATE OF WATER RIGHT

THIS CERTIFICATE ISSUED TO

DONNY & ELIZABETH MURRELL
PO BOX 141
BAKER CITY, OREGON 97814

confirms the right to use the waters of CLARKS CREEK, a tributary of BURNT RIVER, for DOMESTIC USE FOR ONE HOUSEHOLD AND MINING.

This right was perfected under Permit 46634. The date of priority is OCTOBER 26, 1981. This right is limited to 0.417 CUBIC FOOT PER SECOND (CFS), BEING 0.005 CFS FOR DOMESTIC USE AND 0.412 CFS FOR MINING or its equivalent in case of rotation, measured at the point of diversion from the source.

The point of diversion is located as follows:

SE 1/4 SE 1/4, SECTION 27, T 12 S, R 41 E, W.M.; 750 FEET NORTH AND 270 FEET WEST FROM SE CORNER, SECTION 27.

A description of the place of use to which this right is appurtenant is as follows:

SE 1/4 SE 1/4 DOMESTIC USE ONE HOUSEHOLD AND MINING
SECTION 27
TOWNSHIP 12 SOUTH, RANGE 41 EAST, W.M.

Received
SEP 29 2025

OWRD

S-62999.JWG

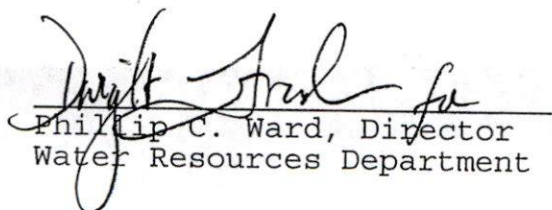
Certificate Number 82509

The water user shall maintain and use adequate treatment facilities to remove the sediment before returning the water to the stream.

The right to the use of the water for the above purpose is restricted to beneficial use on the lands or place of use described. The use confirmed herein may be made only at times when sufficient water is available to satisfy all prior rights, including rights for maintaining instream flows.

WITNESS the signature of the Water Resources Director, affixed

OCT 27 2006

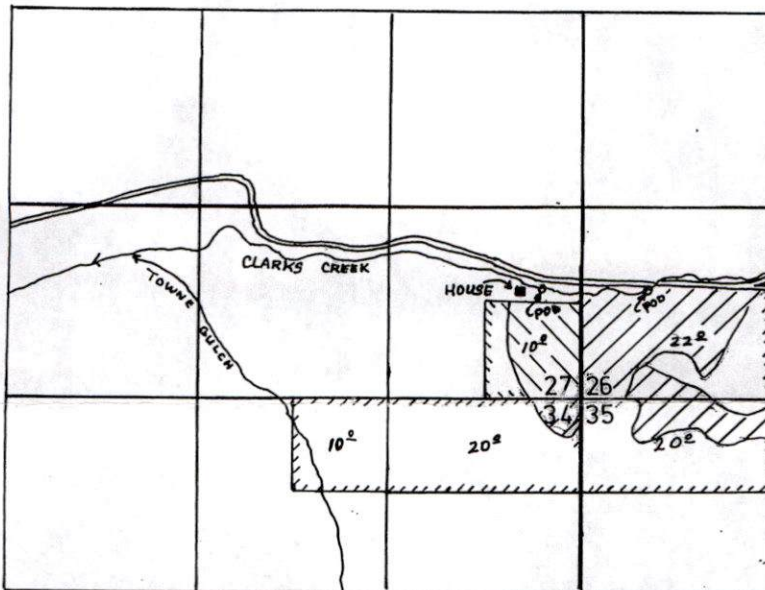

Phillip C. Ward, Director
Water Resources Department

Received
SEP 29 2025
OWRD

Recorded in State Record of Water Right Certificates numbered 82509.

S-62999.JWG

T. 12 S., R. 41 E., W.M.



POD 750' N. AND 550' E. FROM SW COR. SEC. 26.

POD 750' N. AND 270' W. FROM SE COR. SEC. 27



1" = 1320'

P# 46510
BOUNDARY

  APPROXIMATE
AREA MINED

P# 46634
BOUNDARY

  APPROXIMATE
AREA MINED

FINAL PROOF SURVEY

UNDER

Application No. 62999 Permit No. 46634
62352 46510
IN NAME OF

JOHN K. AND WINIFRED E. KYGAR

Surveyed 6-26, 1992, by J. MILLER

Received
SEP 29 2025

OWRD